


O.D.O.T. DISTRICT 2 SURVEY OFFICE (USE ONLY)

PERSONNEL _____ REFERENCE NO. 46 SHEET 53 OF 54
 NOTES ROUSOS DATE 4/15/02 ROUTE SR 105
 H.C. HOMAN WEATHER SUNNY COUNTY WOOD
 R.C. BROWN TEMP. 76° TOWNSHIP WEBSTER
 _____ SECTION 7
 _____ T 5 N R 11 E


TYPE MONUMENT R.R.SPIKE
~~ON SURFACE~~ - BELOW 2 1/2"
~~LEFT~~ - Q PAV'T - RIGHT 13'
3.2' RT TO RT EDGE PAVEMENT
 S.L.M. 302+01

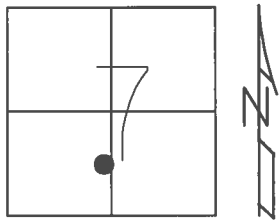

GRID: NORTHING: 633766.791 EASTING: 1687346.260

RECORD: P.I.
 STA. 303+35.64
 $\Delta = 36^\circ 12' 20''$ LT
 FD R.R.SPIKE
 2 1/2" DOWN
 4/15/02, DCH
 FD LG.R.R.SPIKE
 6" DOWN
 REF 46
 9/13/16, JFO
 FD UNDER NEW GRAVEL
 12/20/16, JFO


CURVE DATA:
 $\Delta = 36^\circ 12' 20''$ LT
 D = 25'
 T = 74.92
 R = 229.18'
 E = 11.94
 L = 144.82'

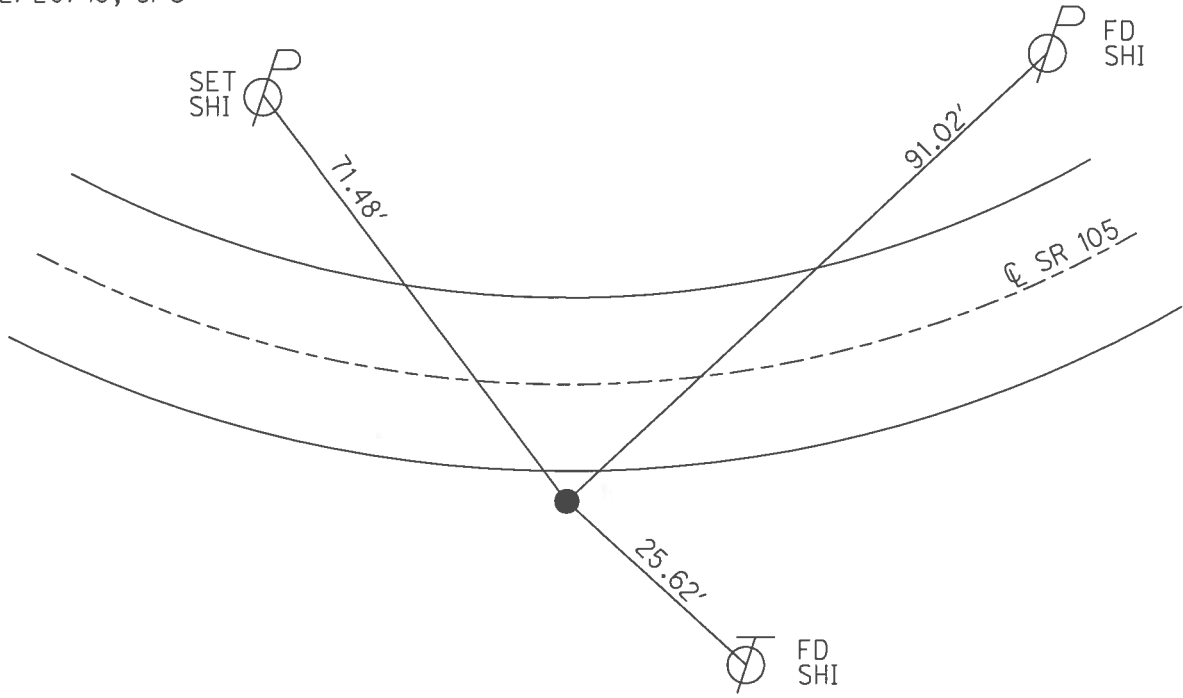

O.D.O.T. DISTRICT 2 SURVEY OFFICE (USE ONLY)

PERSONNEL	REFERENCE NO.	46	SHEET	53	OF	54
NOTES	ROUSOS	DATE	4/15/02	ROUTE	SR 105	
H.C.	HOMAN	WEATHER	SUNNY	COUNTY	WOOD	
R.C.	BROWN	TEMP.	76°	TOWNSHIP	WEBSTER	
				SECTION	7	
				T	5	N
				R	11	E


TYPE MONUMENT R.R.SPIKE
~~ON SURFACE~~ - BELOW 0.2'
~~LEFT~~ - CL PAV'T - RIGHT 13'
3.2' RT TO RT EDGE PAVEMENT
 S.L.M. 302+01

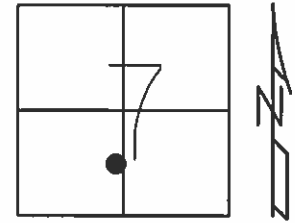

GRID: NORTHING: _____ EASTING: _____

RECORD: P.I.
 STA. 303+35.64
 $\Delta = 36^\circ 12' 20''$ LT

CURVE DATA:
 $\Delta = 36^\circ 12' 20''$ LT
 D = 25°
 T = 74.92
 R = 229.18'
 E = 11.94
 L = 144.82'

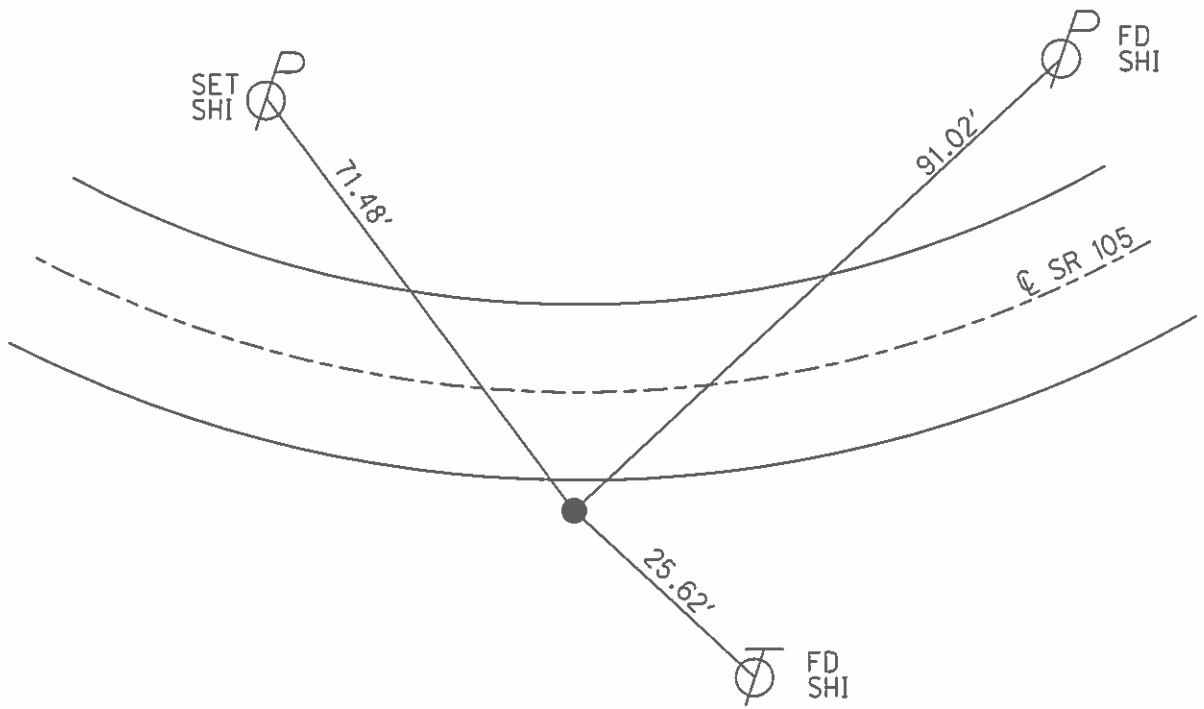

O.D.O.T. DISTRICT 2 SURVEY OFFICE

PERSONNEL

REFERENCE NO. 46

SHEET 56 OF 57

NOTES LONG

H.C. VANDUSEN

R.C. BARNHISEL

DATE 8-27-91

WEATHER SUNNY

TEMP. 92°

ROUTE 105

COUNTY WOODS

TOWNSHIP WEBSTER

SECTION 7

T 5 N R 11 E



TYPE MONUMENT R.R. SPK.

~~ON SURFACE~~ - BELOW 0.23

~~LEFT - C~~ PAV'T. - RIGHT 130'

32 TO 5 EDGE PAVEMENT

S.L.M. 302+01

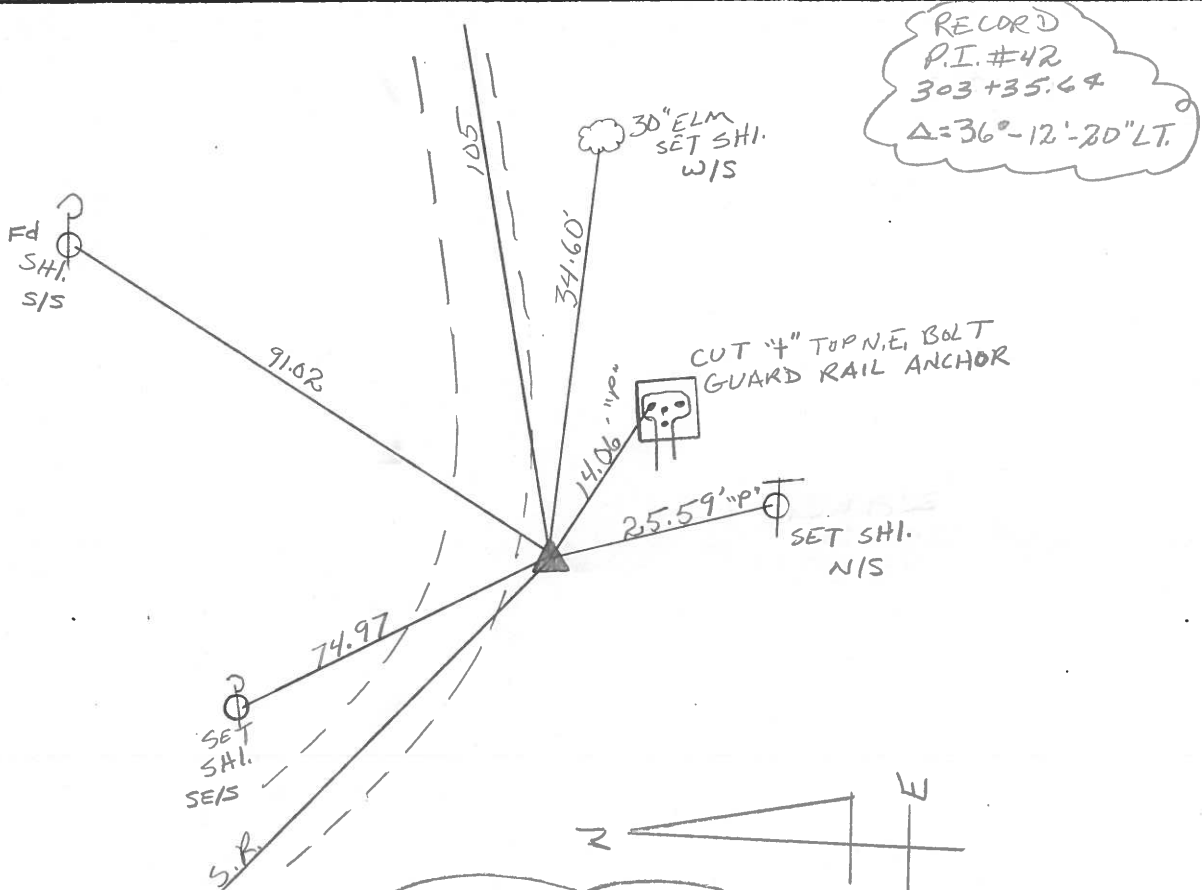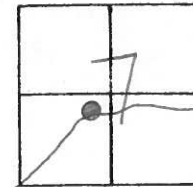


RECORD
 P.I. #42
 303+35.64
 $\Delta = 36^\circ - 12' - 20''$ LT.

CURVE DATA:
 CALC. 4-25-88
 $A = 36^\circ - 12' - 20''$ LT.
 $D = 25^\circ$
 $T = 74.92$
 $R = 229.18$
 $E = 11.94$
 ARC LENGTH = 144.82

PERSONNEL	TITLE	PERSONNEL	TITLE	COUNTY	DATE	WEATHER	TEMP.
Stone		Brannen		Wood	16 July 73	Mild	
Michalak				S. R. #105			
Denn				Webster Twp.			79°
Curtis							

DESCRIPTION References to Control Points JOB NO.

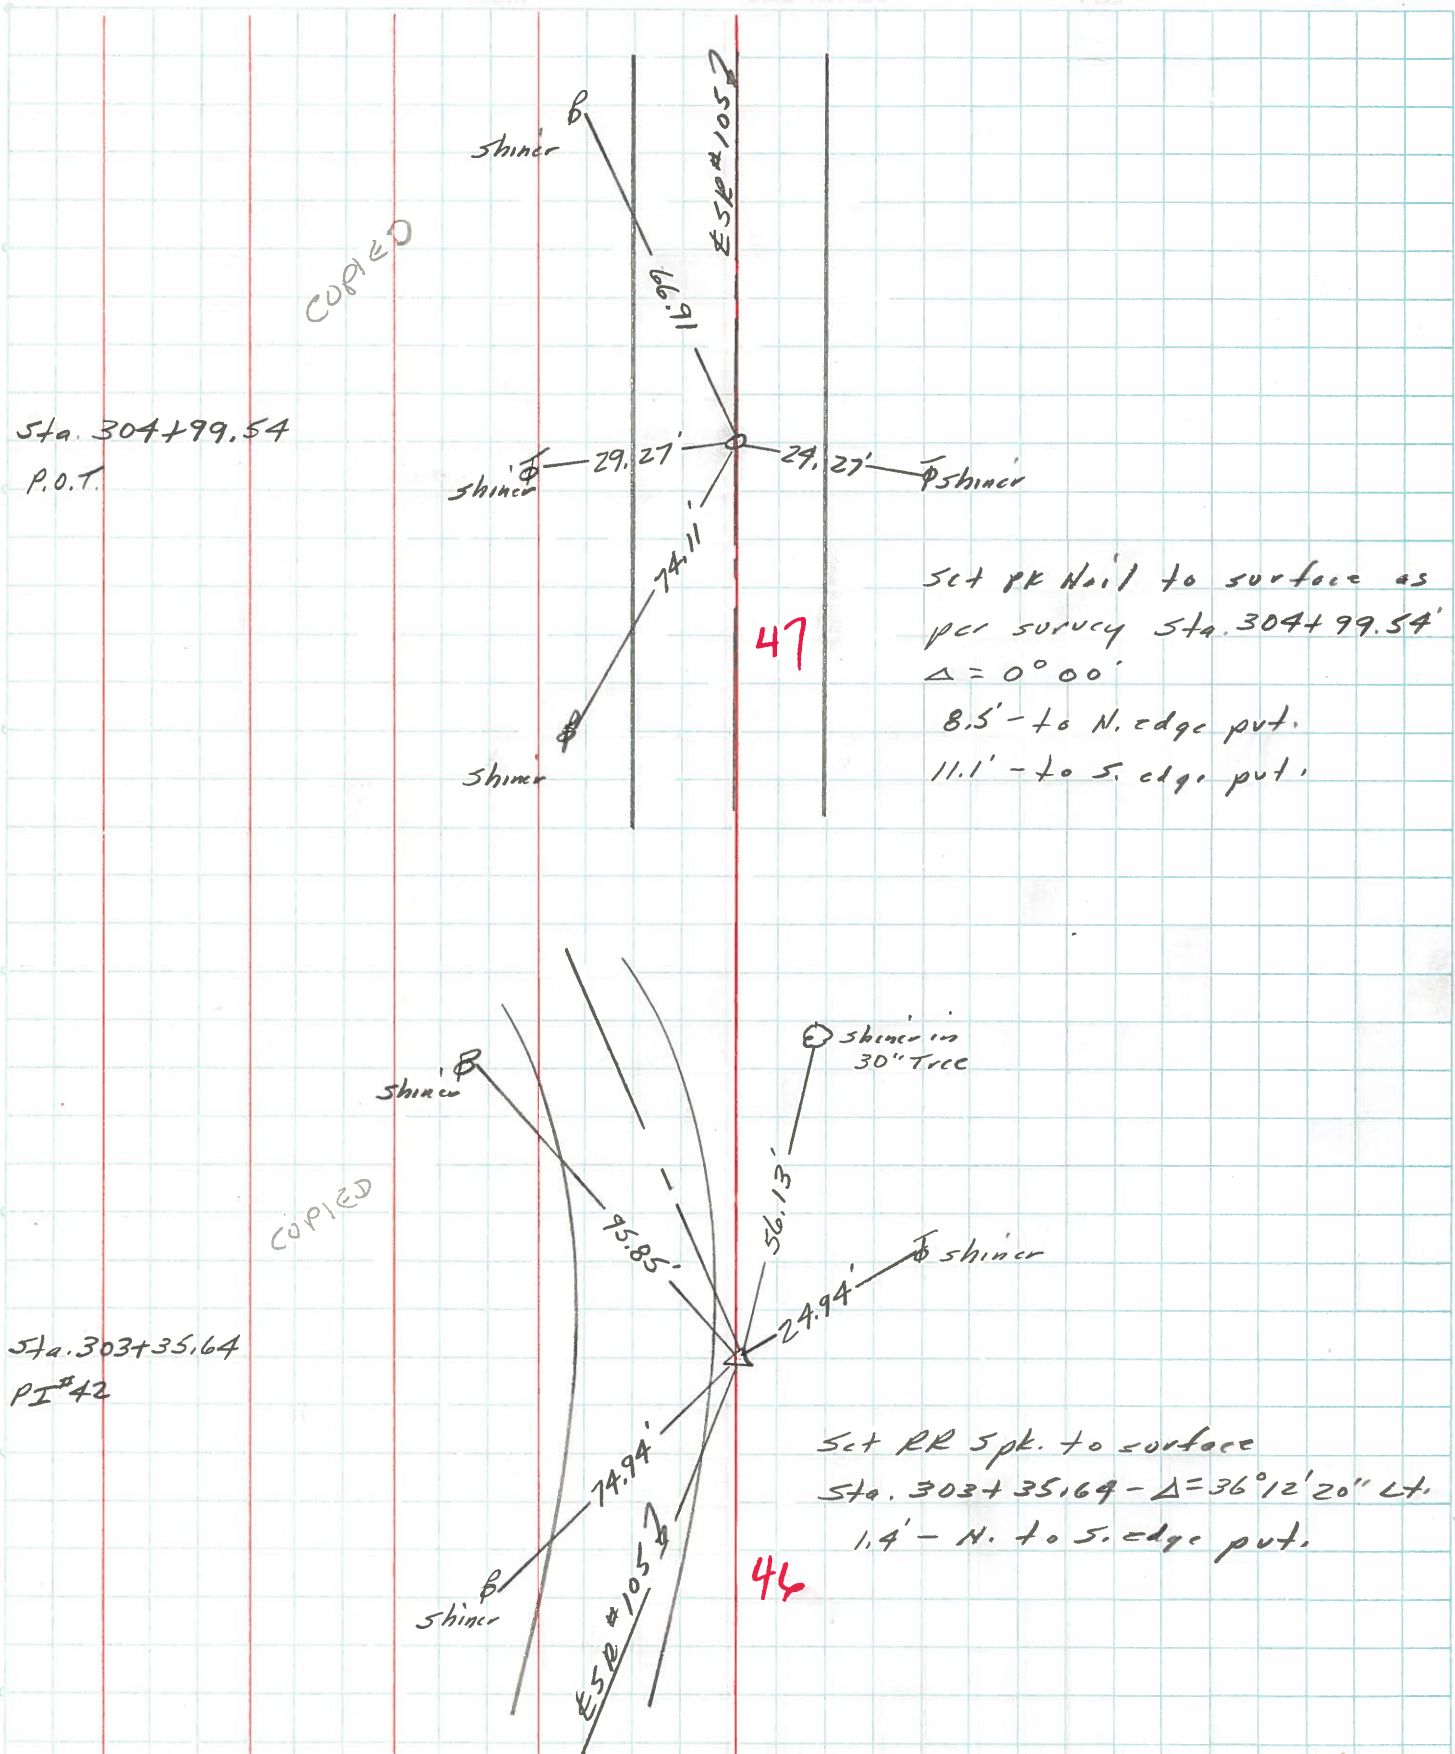

Set RR Nail to surface as per survey Sta. 304+99.54' $\Delta = 0^{\circ}00'$
 8.5' - to N. edge pt.
 11.1' - to S. edge pt.

Set RR Spk. to surface Sta. 303+35.64 - $\Delta = 36^{\circ}12'20''$ Lt.
 1.4' - N. to S. edge pt.