


O.D.O.T. DISTRICT 2 SURVEY OFFICE (USE ONLY)


PERSONNEL	REFERENCE NO.	<u>47</u>	SHEET	<u>54</u>	OF	<u>54</u>
NOTES	POORE	DATE	<u>8/2/17</u>	ROUTE	<u>SR 105</u>	
H.C.	HOMAN	WEATHER	<u>SUNNY</u>	COUNTY	<u>WOOD</u>	
R.C.	CARSON	TEMP.	<u>83°</u>	TOWNSHIP	<u>WEBSTER</u>	
	RHOADES			SECTION	<u>7</u>	
				<u>T 5 N R 11 E</u>		

TYPE MONUMENT 1" MAG/WASHER
 ON SURFACE - ~~BELOW~~ ON
 LEFT - ☉ PAV'T - ~~RIGHT~~ 1.2'
8.9' TO LT EDGE PAVEMENT
 S.L.M. 303+61

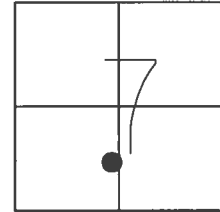

GRID: NORTHING: 633854.965 EASTING: 1687484.384


RECORD: P.O.T.
 STA. 304+99.54
 FD P.K./WASHER
 4/15/02, DCH
 SET P.K./WASHER
 6/13/02, DCH
 SET MAG/WASHER
 REF47
 6/10/16, JFO
 SET 1" MAG/WASHER
 8/2/17, DCH

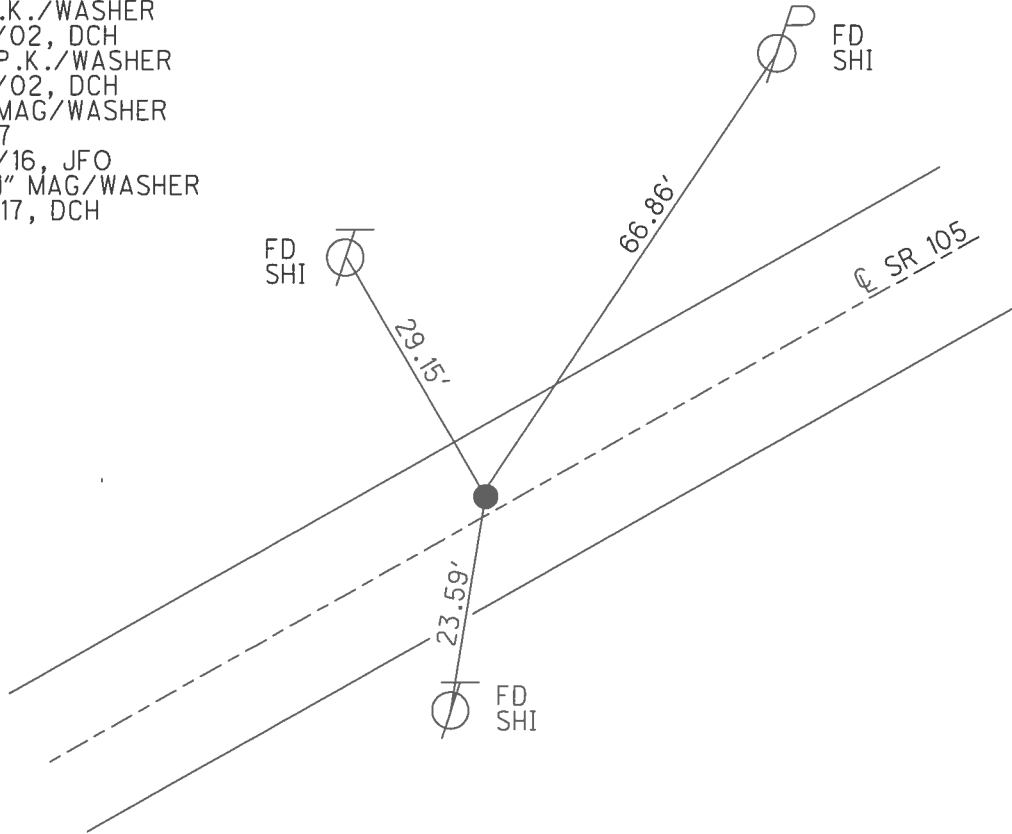

O.D.O.T. DISTRICT 2 SURVEY OFFICE (USE ONLY)


PERSONNEL _____ REFERENCE NO. 47 SHEET 54 OF 54
 NOTES ROUSOS DATE 4/15/02 ROUTE SR 105
 H.C. HOMAN WEATHER SUNNY COUNTY WOOD
 R.C. BROWN TEMP. 76° TOWNSHIP WEBSTER
 SECTION 7
T 5 N R 11 E

TYPE MONUMENT P.K./WASHER
 ON SURFACE - ~~BELOW~~ ON _____
 LEFT - ☉ PAV'T - ~~RIGHT~~ 1.2'
8.9' TO LT EDGE PAVEMENT
 S.L.M. 303+61

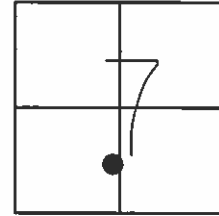

GRID: NORTHING: _____ EASTING: _____

RECORD: P.O.T.
 STA. 304+99.54
 SET P.K./WASHER
 6/13/02, DCH

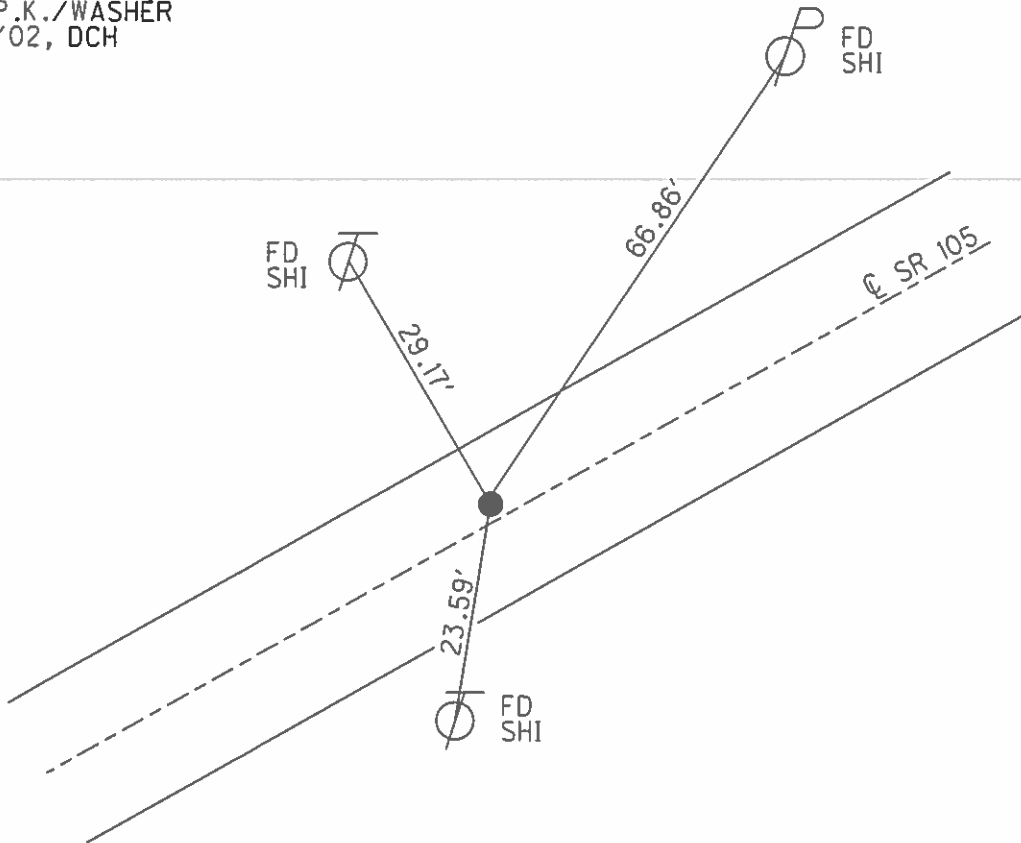

O.D.O.T. DISTRICT 2 SURVEY OFFICE

PERSONNEL

REFERENCE NO. 47

SHEET 57 OF 57

NOTES LONG

H.C. YANDUSEN

R.C. BARNHISEL

DATE 8-27-91

WEATHER SUNNY

TEMP. 92°

ROUTE 105

COUNTY WOOD

TOWNSHIP WEBSSTER

SECTION 7

T 5 N R 11 E



TYPE MONUMENT P.K. / WASHER

ON SURFACE - BELOW YES

LEFT- & PAV'T. - RIGHT 1.2'

8.9' TO LT. EDGE PAVEMENT

S.L.M. 303+61

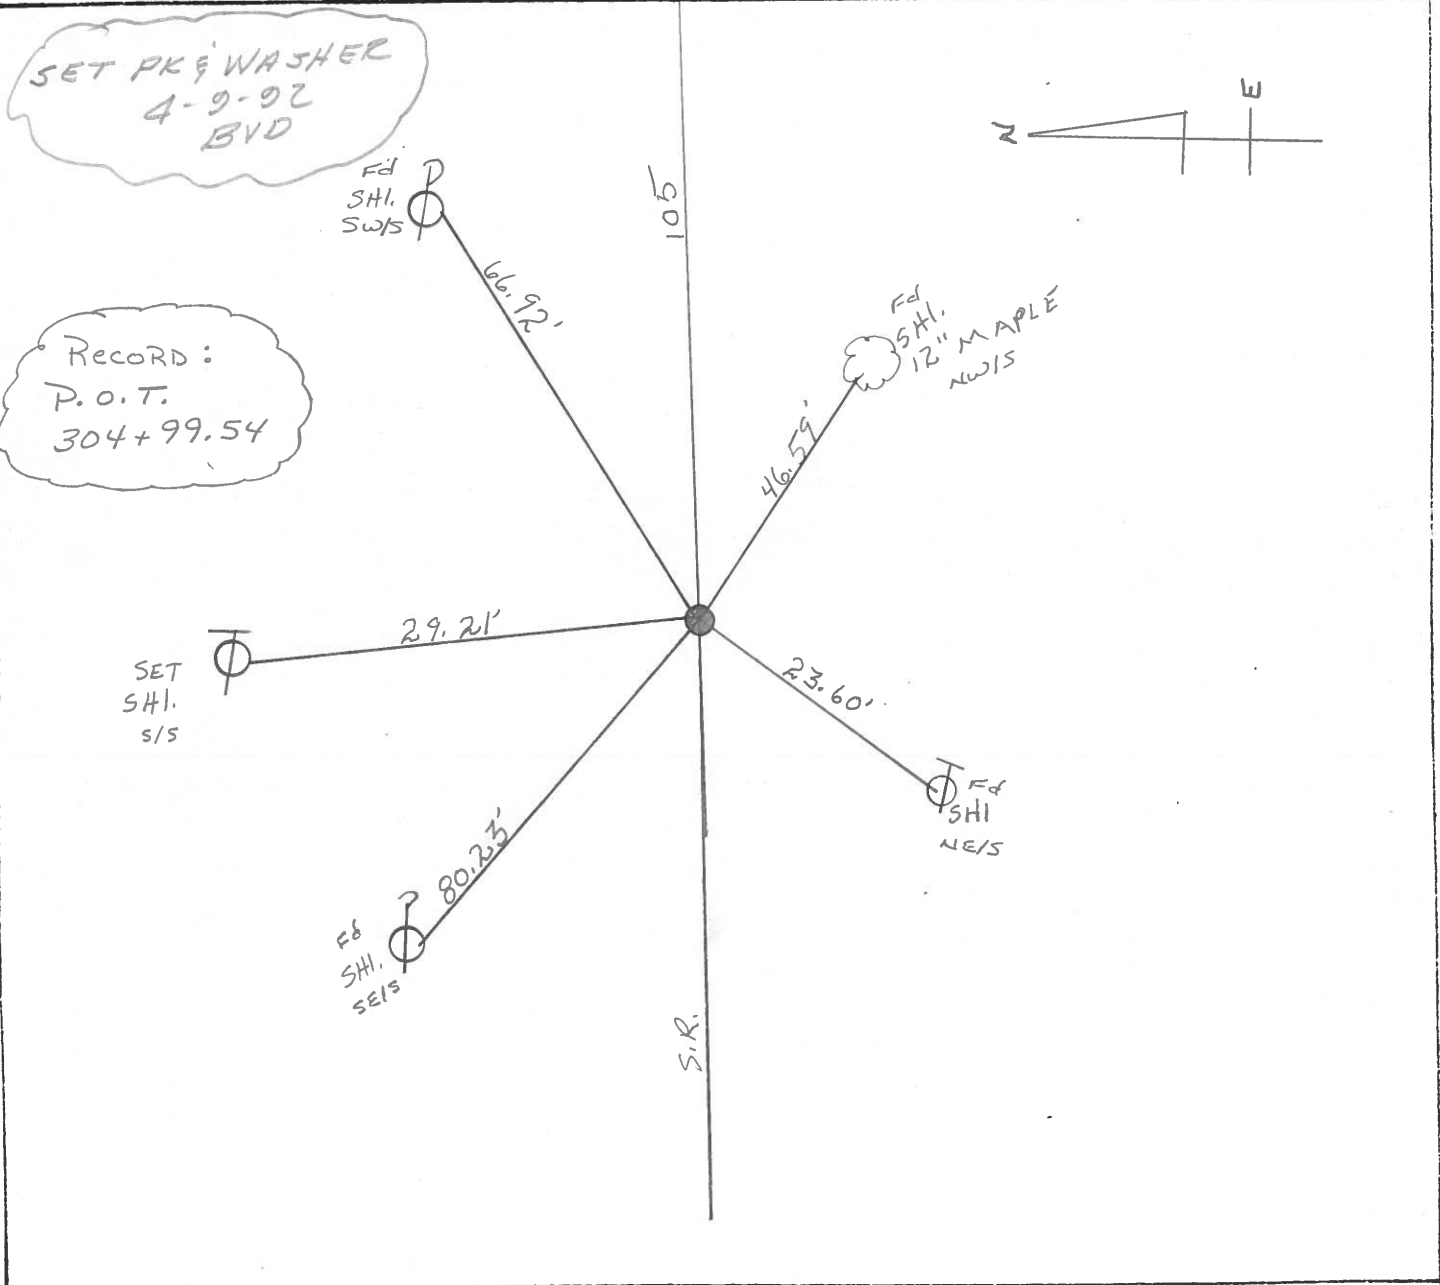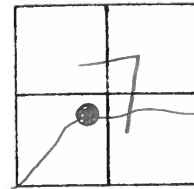

SET PK & WASHER
4-9-92
BVD

RECORD:
P.O.T.
304+99.54

SET
SHI.
S/S

Fd
SHI.
SE1/4

Fd
SHI
NE1/4

S.R.

QD.O.T. DISTRICT 2 SURVEY OFFICE

SHEET _____ OF _____

County WOOD S.R. 105

Date 4-23-82

Township 7

Weather CLOUDY

Section _____

Temp. +45°


T N, R E

Personnel HOFFMAN

HOUSEHOLDER


LOEHRKE

#47

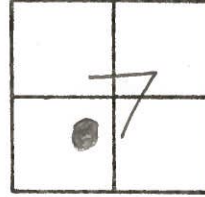

P.O.T.
304+99.54

SET P.K./WASHER
5-27-82 S.W.H.

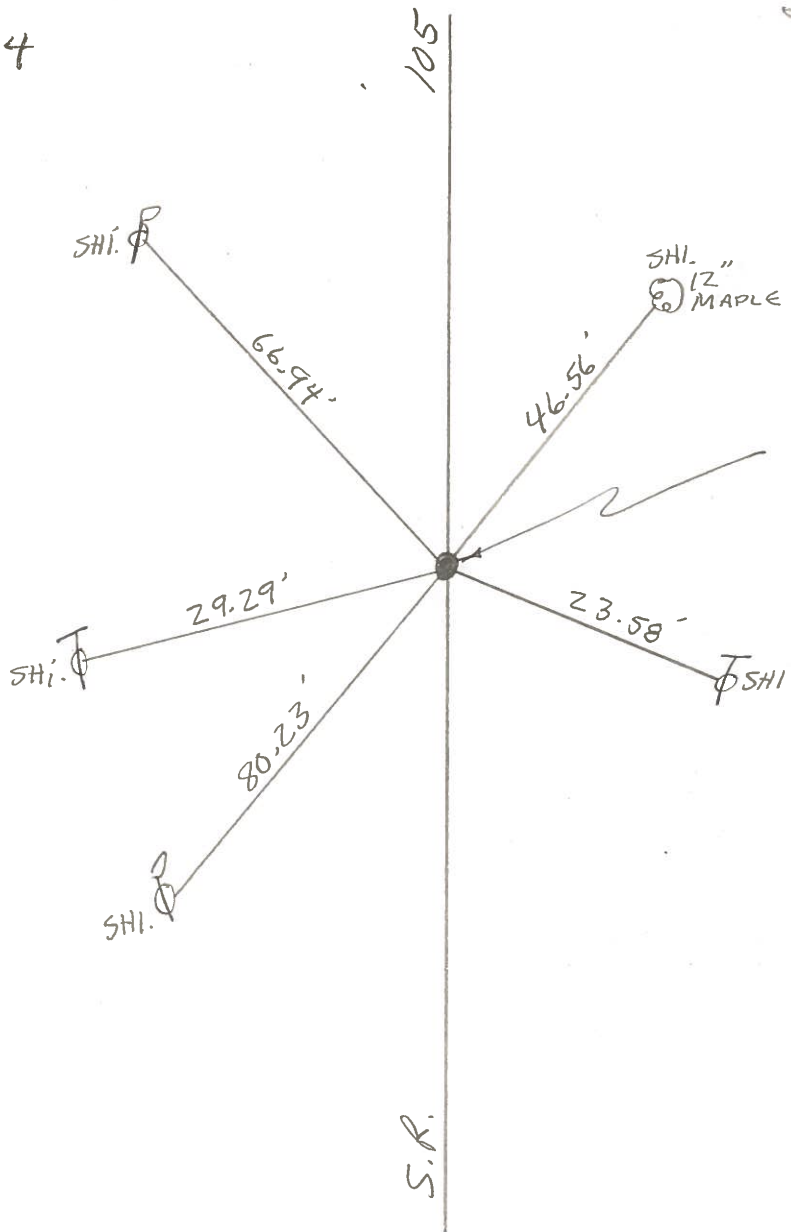

PERSONNEL	TITLE	PERSONNEL	TITLE	COUNTY	DATE	WEATHER	TEMP.
Stone		Brannen		Wood	16 July 73	Mild	
Michalak				S. R. #105			
Denn				Webster Twp.			79°
Curtis							

DESCRIPTION References to Control Points JOB NO.

