


O.D.O.T. DISTRICT 2 SURVEY OFFICE (USE ONLY)


PERSONNEL \_\_\_\_\_ REFERENCE NO. 69 SHEET 27 OF 33  
 NOTES RHOADES DATE 8/18/22 ROUTE SR 105  
 H.C. AUBLE WEATHER SUNNY COUNTY WOOD  
 R.C. NIESE TEMP. 74° TOWNSHIP FREEDOM  
 DWG BY RHOADES PID PAVETRAIN SECTION 9  
 T 5 N R 12 E

TYPE MONUMENT MAG/WASHER  
 ON SURFACE - ~~BELOW~~ ON  
 OFFSET  $\phi$  PAVEMENT 3.6' ~~±~~ : RT  
6.8' TO RT EDGE PAVEMENT  
 STATION: 419+47.60

HORZ.DATUM: NAD83 2011 GEOID: NAVD88 2018  
 GRID: NORTHING: 634180.712 EASTING: 1698071.851

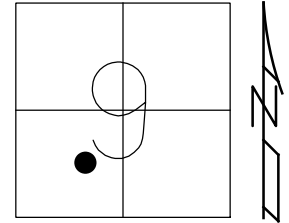


RECORD: P.I.  
 STA. = 422+61.15  
 $\Delta = 4^{\circ}14'20''$  LT  
 SET P.K./WASHER  
 11/8/94, CL  
 FD P.K./WASHER  
 REF69  
 10/11/11, RJL  
 6/10/13, SDC  
 SET MAG/WASHER  
 FINREF69  
 10/3/13, SDC  
 FD MAG/WASHER  
 8/18/22, DSA  
 REF69  
 3/2/23, DSA

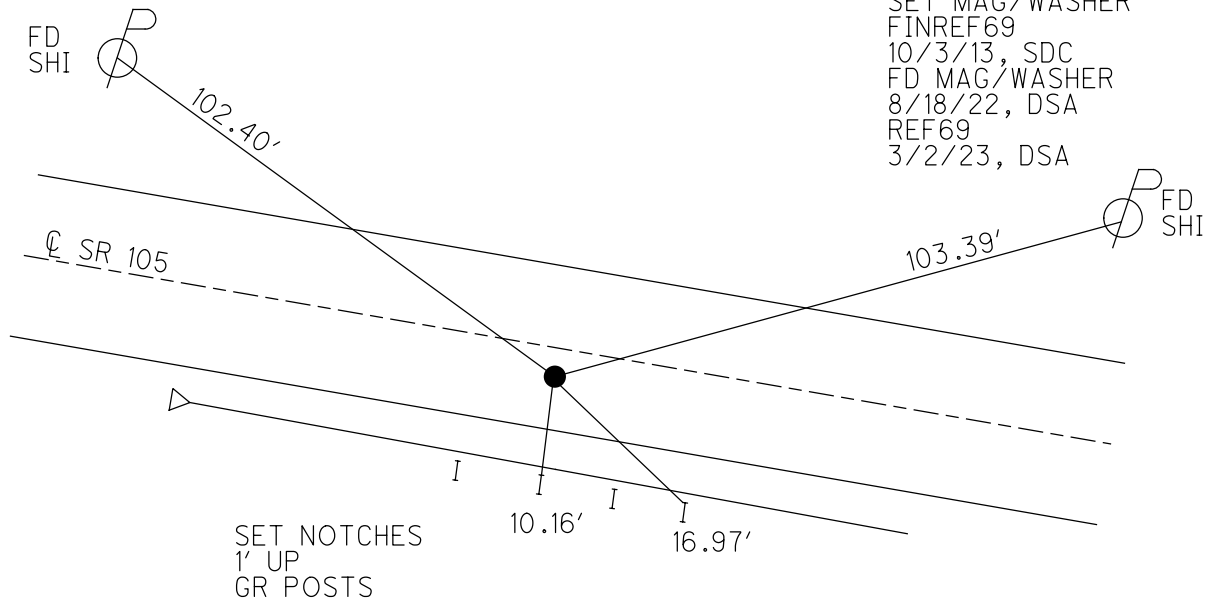

O.D.O.T. DISTRICT 2 SURVEY OFFICE (USE ONLY)

PERSONNEL	REFERENCE NO. <u>69</u>	SHEET <u>27</u> OF <u>33</u>
NOTES <u>RHOADES</u>	DATE <u>6/10/13</u>	ROUTE <u>SR 105</u>
H.C. <u>CODER</u>	WEATHER <u>CLOUDY</u>	COUNTY <u>WOOD</u>
R.C. <u>RHOADES</u>	TEMP. <u>72°</u>	TOWNSHIP <u>FREEDOM</u>
		SECTION <u>9</u>
		T <u>5</u> N R <u>12</u> E


TYPE MONUMENT P.K./WASHER  
 ON SURFACE - ~~BELOW~~ ON  
~~LEFT~~ - Q PAV'T - RIGHT 3.0'  
6.8' TO RT EDGE PAVEMENT  
 S.L.M. 420+96  
 Grid: Northing: 634180.789 Easting: 1698071.736

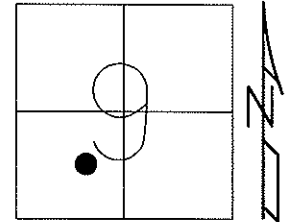

RECORD: P.I. #62  
 STA. = 422+61.15  
 $\Delta = 4^{\circ} 14' 20''$  LT  
 RESET P.K./WASHER  
 11/8/94, C.L.

FD P.K./WASHER  
 GPS, REF69  
 10/11/11, RJL

SET WITH GPS,  
 2 TIES REMAIN.  
 SET MAG/WASHER  
 GPS, FINREF69  
 10/3/13, SDC

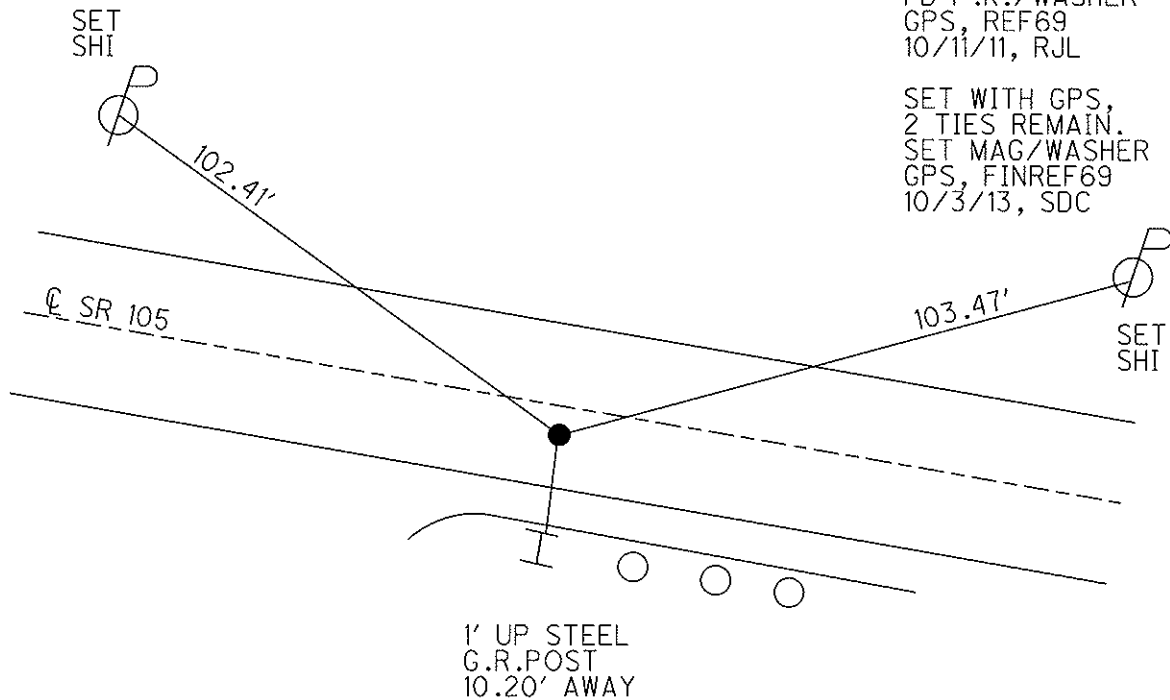

# O.D.O.T. DISTRICT 2 SURVEY OFFICE

PERSONNEL \_\_\_\_\_

REFERENCE NO. 69

SHEET 21 OF 49

NOTES RIPPLE

H.C. BARBOUR

R.C. GEYMAN

DATE 8-4-94

WEATHER CLOUDY

TEMP. +80°

ROUTE S.R. 105

COUNTY WOOD

TOWNSHIP FREEDOM

SECTION 9

T 5 N R 12 E

Reset  
11-8-94


TYPE MONUMENT PK/WASHER

ON SURFACE - BELOW YES


LEFT-~~Q~~ PAVT. - RIGHT YES 3.0' RT Q

6.8' TO RT EDGE PAVEMENT

S.L.M. 420 + 96

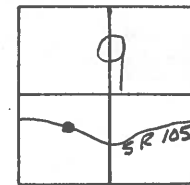

RECORD: P.I. # 62  
 STA - 422 + 61.15  
 $\Delta = 4^\circ - 14' - 20''$  Lt.

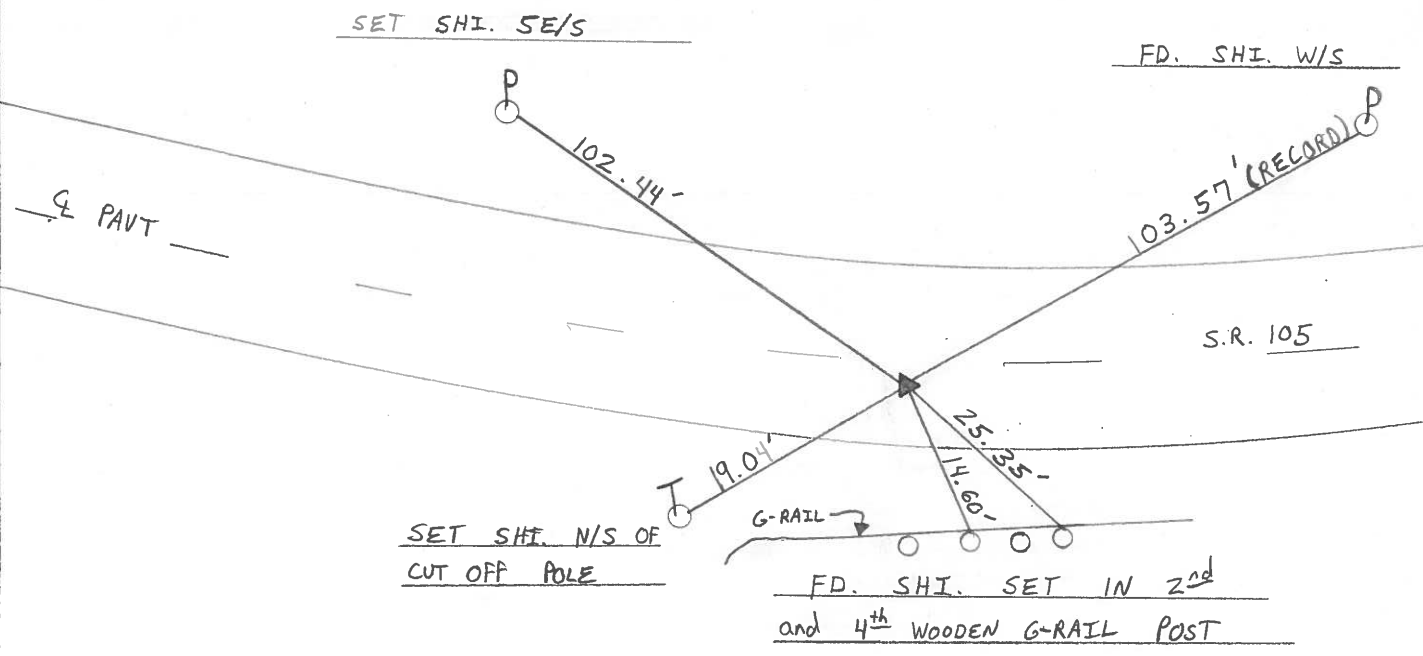

County WOOD S.R. 105

Township FREEDOM

Section 9

T<sub>5</sub>N, R<sub>12</sub>E

Personnel BARNHISEZ HC

HOUSEHOLDER RC


LOEHRKE

Hoffman P

Date 2-8-84

Weather PT CLOUDY

Temp. + 83

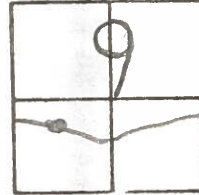

# 69

RECORDED  
P.I. # 62

422+61.15

$\Delta = 4^{\circ} - 14' - 20''$  Lt.

Fd: RR SPIKE @ SURFACE

7.3 REP

13.1 LEP


2.3 Rt of C

SLM 419+27

SET PK.

10-3-84

C.L.

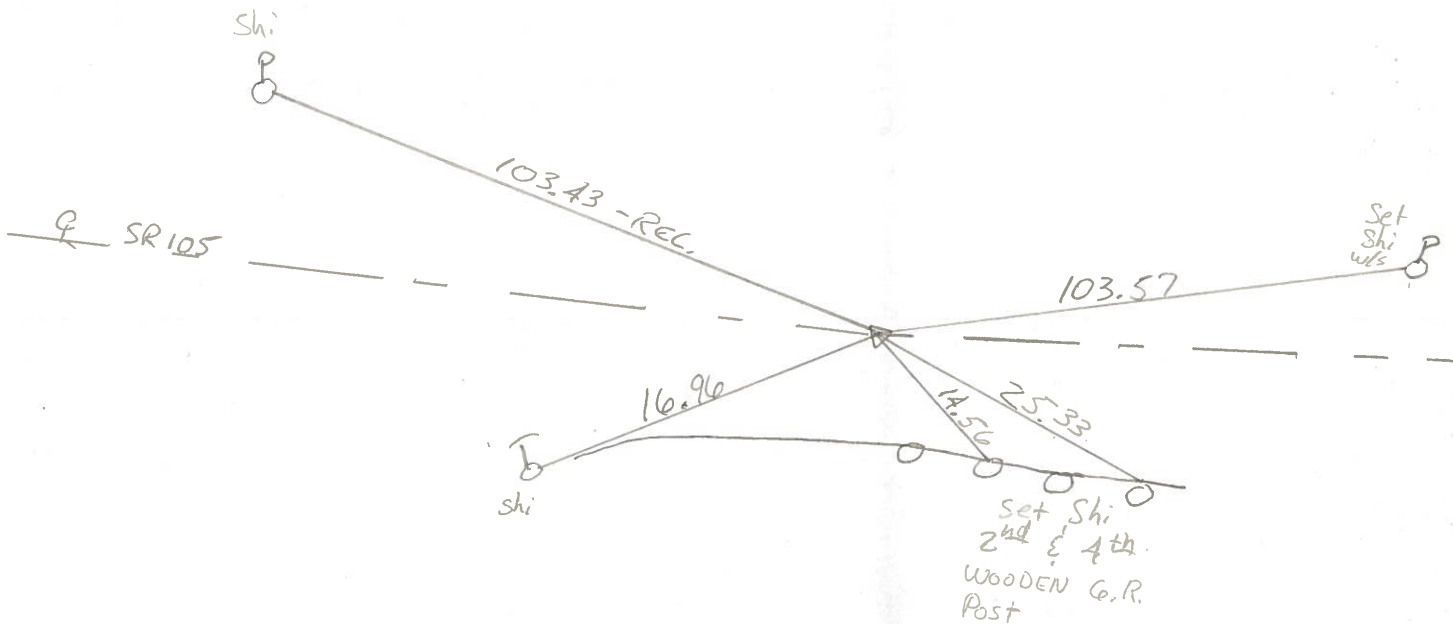

County WOOD S.R. 105

Date 10-31-73

Township FREEDOM

Weather CLOUDY

Section 9

Temp. 50°


TSN, RIZE

Personnel STONE

MICHALAK

DENNO

CURTIS

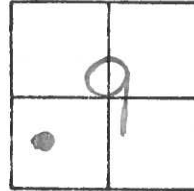

#69

P.I. STA. 422+61.15  
 $\Delta = 4^{\circ} 14' 20''$  LT.  
 11.8' TO N. EDGE PVT.  
 7.3' TO S. EDGE PVT.

SET. R.R. SPK.

