


O.D.O.T. DISTRICT 2 SURVEY OFFICE (USE ONLY)


PERSONNEL _____ REFERENCE NO. 75 SHEET 1 OF 17
 NOTES LEU DATE 04-25-16 ROUTE SR 105
 H.C. HOMAN WEATHER PARTLY CLDY COUNTY WOOD
 R.C. LEU TEMP. 52°F TOWNSHIP FREEDOM
 SECTION 10
 T 5 N R 12 E

TYPE MONUMENT IPIN
 ON SURFACE - ~~BELOW~~ ON
~~LEFT~~ - C PAV'T - RIGHT 1'
8.6' TO RT EDGE PAVEMENT
 S.L.M. 468+92
 GRID: NORTHING: 635228.0025 EASTING: 1702665.651

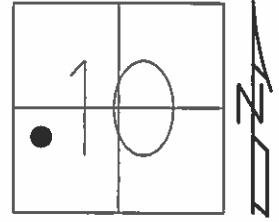

RECORD:
 P.O.T. STA 362+32.80

SET MAG/WASHER
 GPS, NEWREF 75
 09-22-2016, DCH

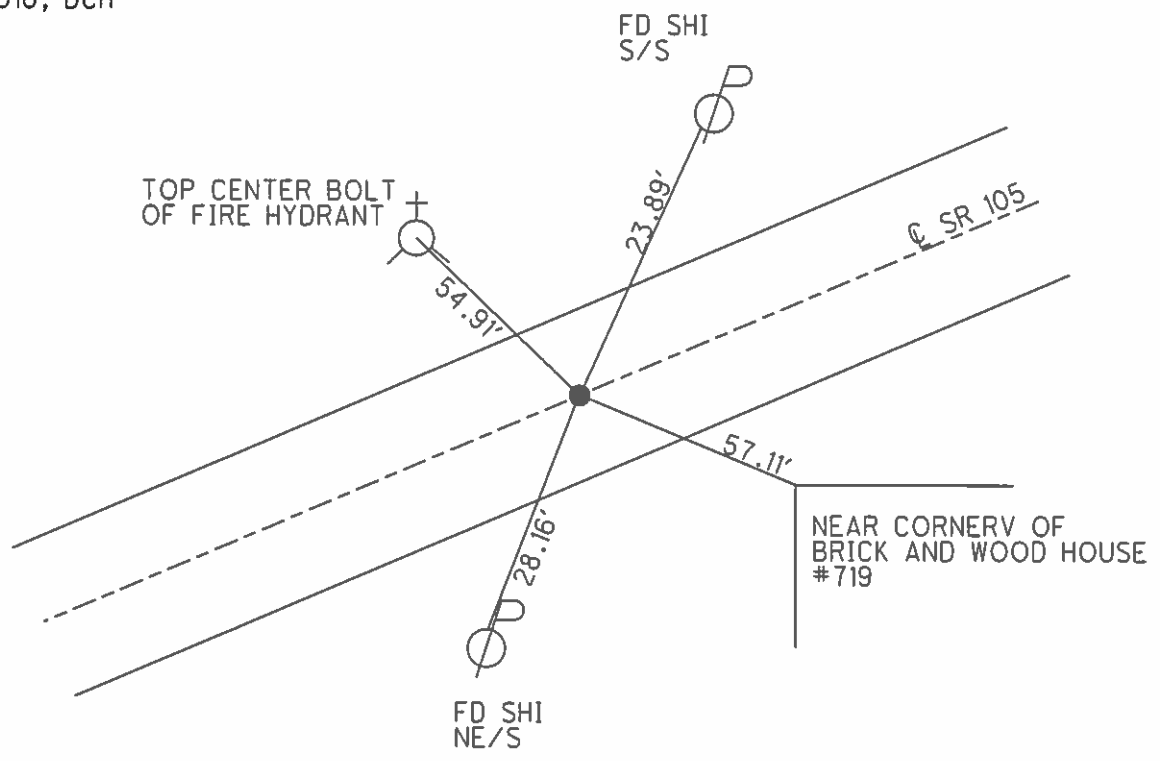

O.D.O.T. DISTRICT 2 SURVEY OFFICE

PERSONNEL _____

REFERENCE NO. 75

SHEET 27 OF 49

NOTES CHANEY

H.C. RIPPLE

R.C. BARBOUR

DATE 8-4-94

WEATHER CLOUDY

TEMP. +80°

ROUTE S.R. 105

COUNTY WOOD

TOWNSHIP FREEDOM

SECTION 10

T 5 N R 12 E

TYPE MONUMENT IRON PIN


SET PK/WASHER
11/14/94
MRC

ON SURFACE - ~~BELOW~~ YES


~~LEFT - & PAV'T.~~ - RIGHT YES 1.0' RT &

8.6' TO RT. EDGE PAVEMENT

S.L.M. 468 + 92

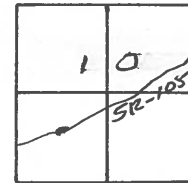

RECORD: P.O.T. STA 362 + 32.80

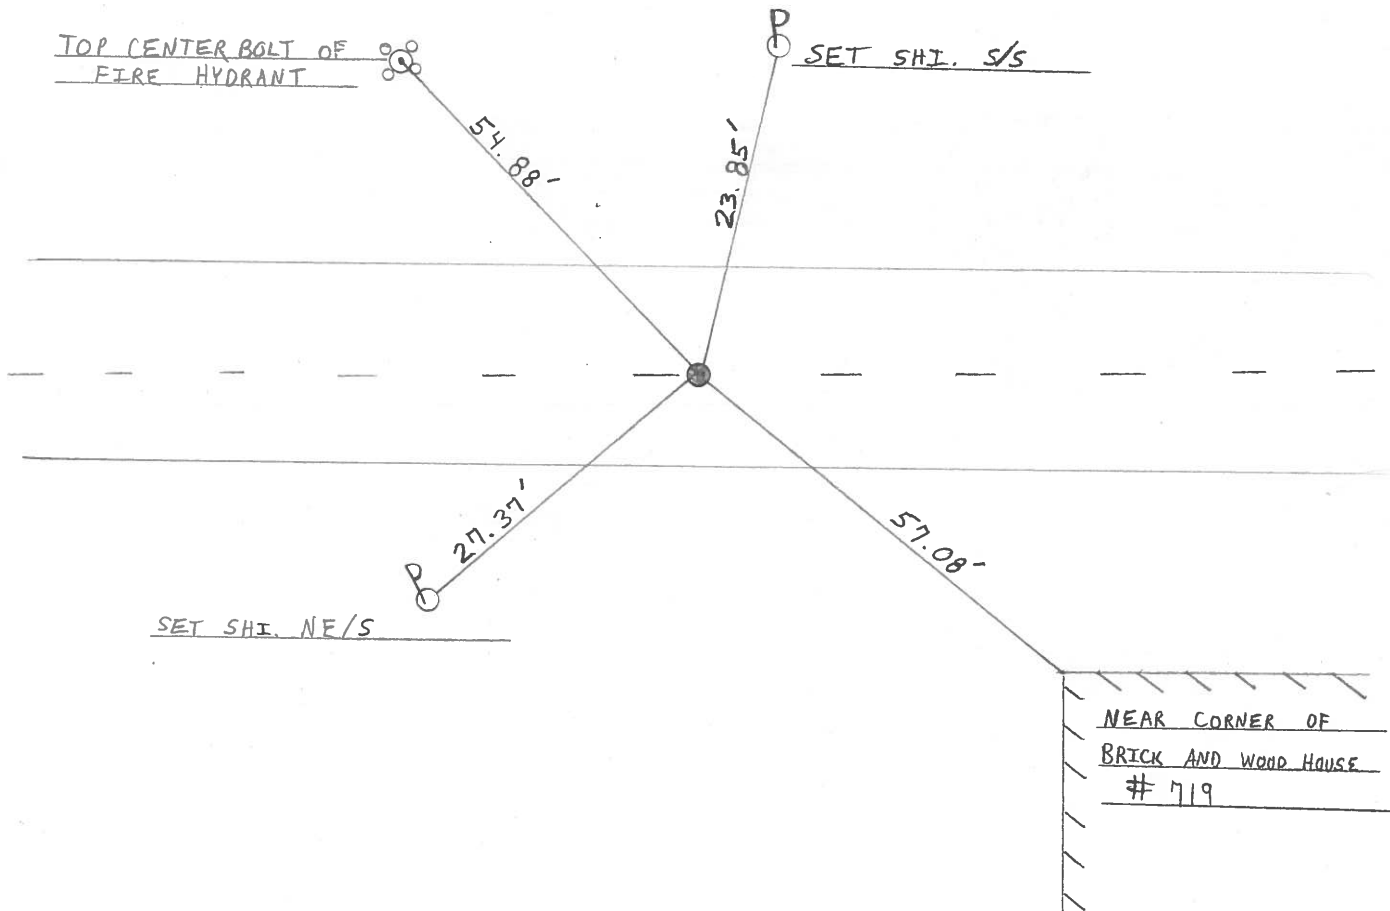

County WOOD S.R. 105

Township FREEDOM - PEMBERVILLE

Section 10

T5N, R12E

Personnel BARNHISEL HC

HOUSE HOLDER RC


LOEHIRKE TL

Hoffman P

Date 8-8-84

Weather CLEAR HUMID

Temp. 86

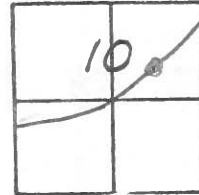

75

RECORDED

P.I. # 67


470+53.03

$\Delta = 0^\circ - 44' - 20''$ Lt.


SET PK + WASHER

10-3-84

C.L.

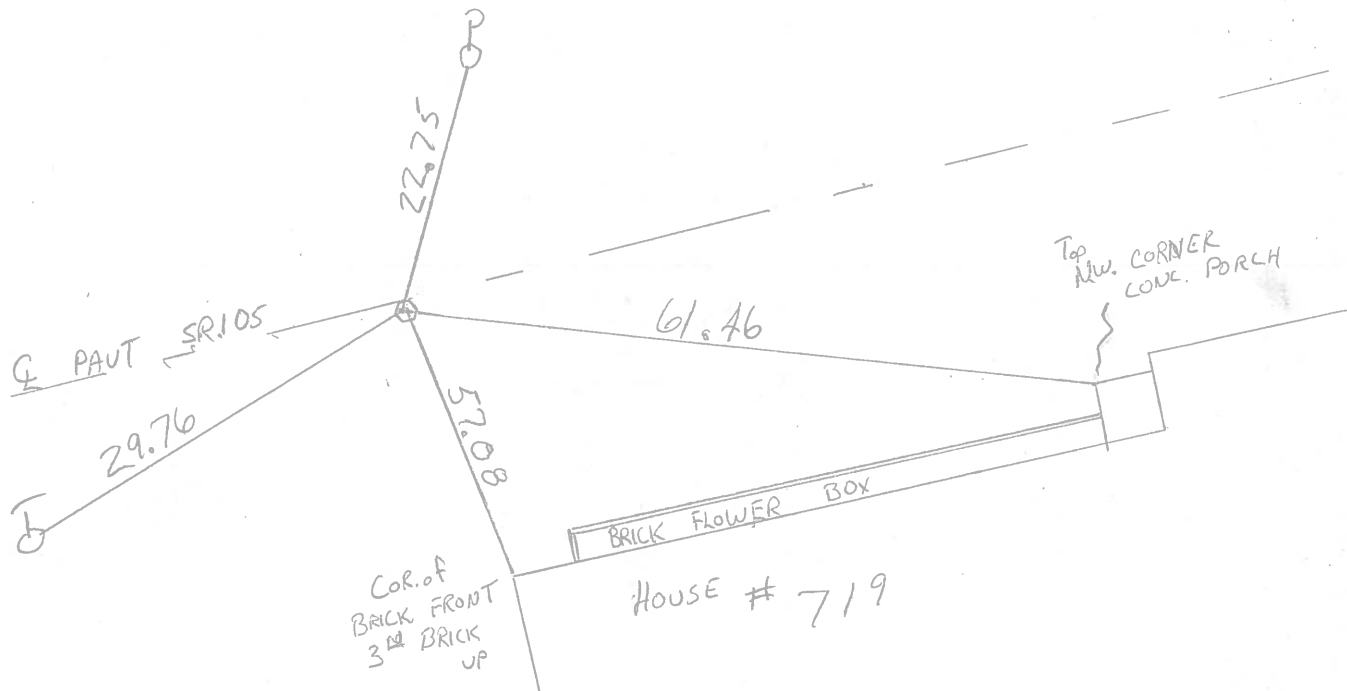


PERSONNEL	TITLE	PERSONNEL	TITLE	COUNTY	<u>Wood</u>	DATE	<u>31 Oct 73</u>
<u>Stone</u>				S. R.	<u>105</u>	WEATHER	<u>Cloudy</u>
<u>Michalak</u>				SEC.	<u>Pemberville</u>	TEMP.	<u>55°</u>
<u>Danno</u>				DESCRIPTION	<u>References to Control points</u>		JOB NO.
<u>Curtis</u>				LEFT	CENTER LINE	RIGHT	

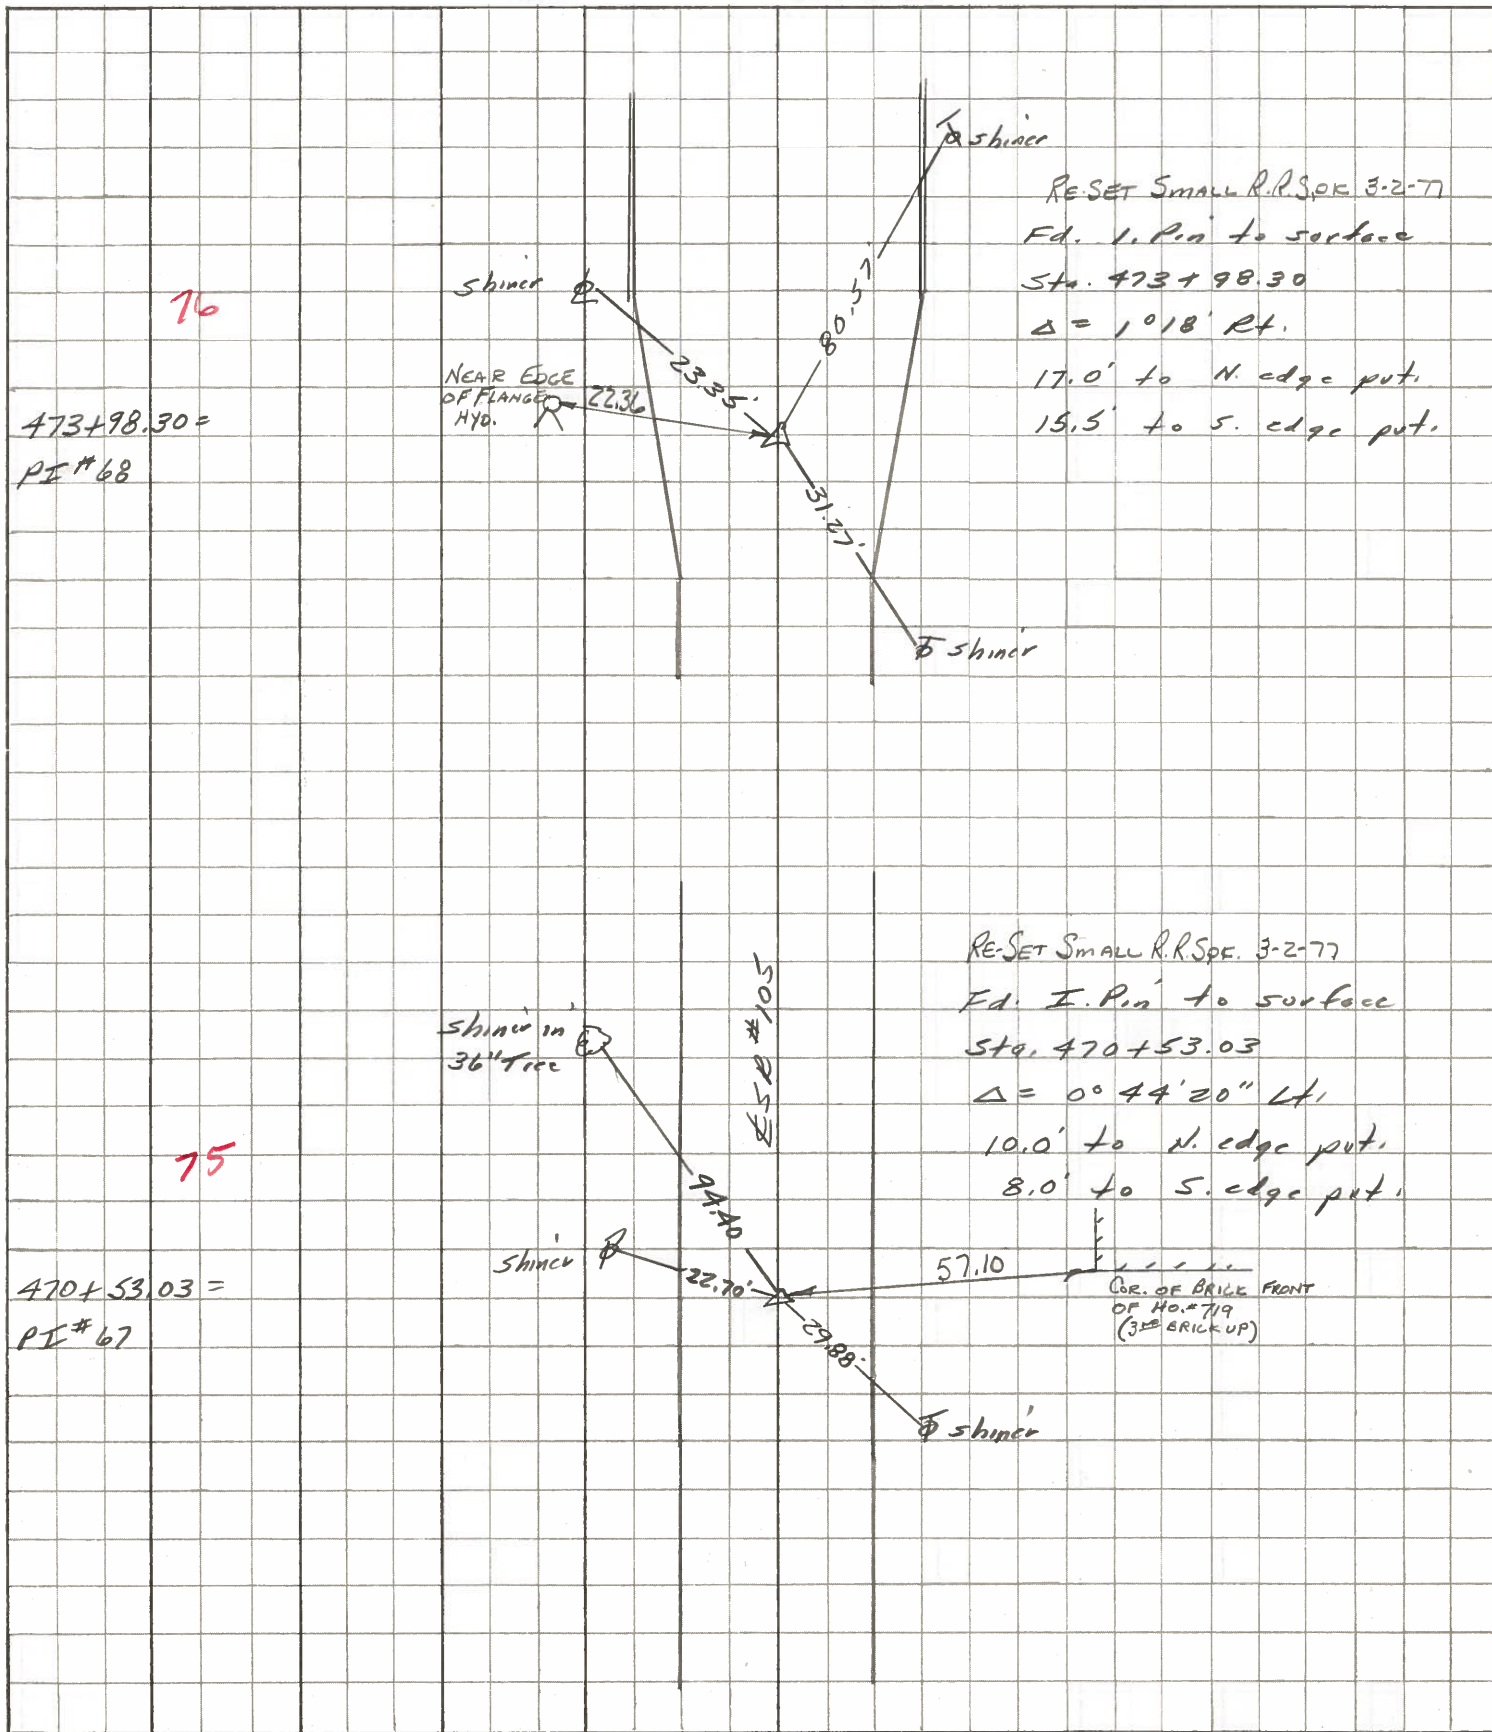

1-27-71

PERSONNEL	TITLE	PERSONNEL	TITLE	COUNTY	DATE
CK. BY				Wood	OK-9-15-70
BURNSIDE				S. R. #105	WEATHER
MORRISON				SEC. PEMBERVILLE	TEMP.
SMITH					

DESCRIPTION CONTROL POINTS (CORP. TO CORP.) JOB NO. _____

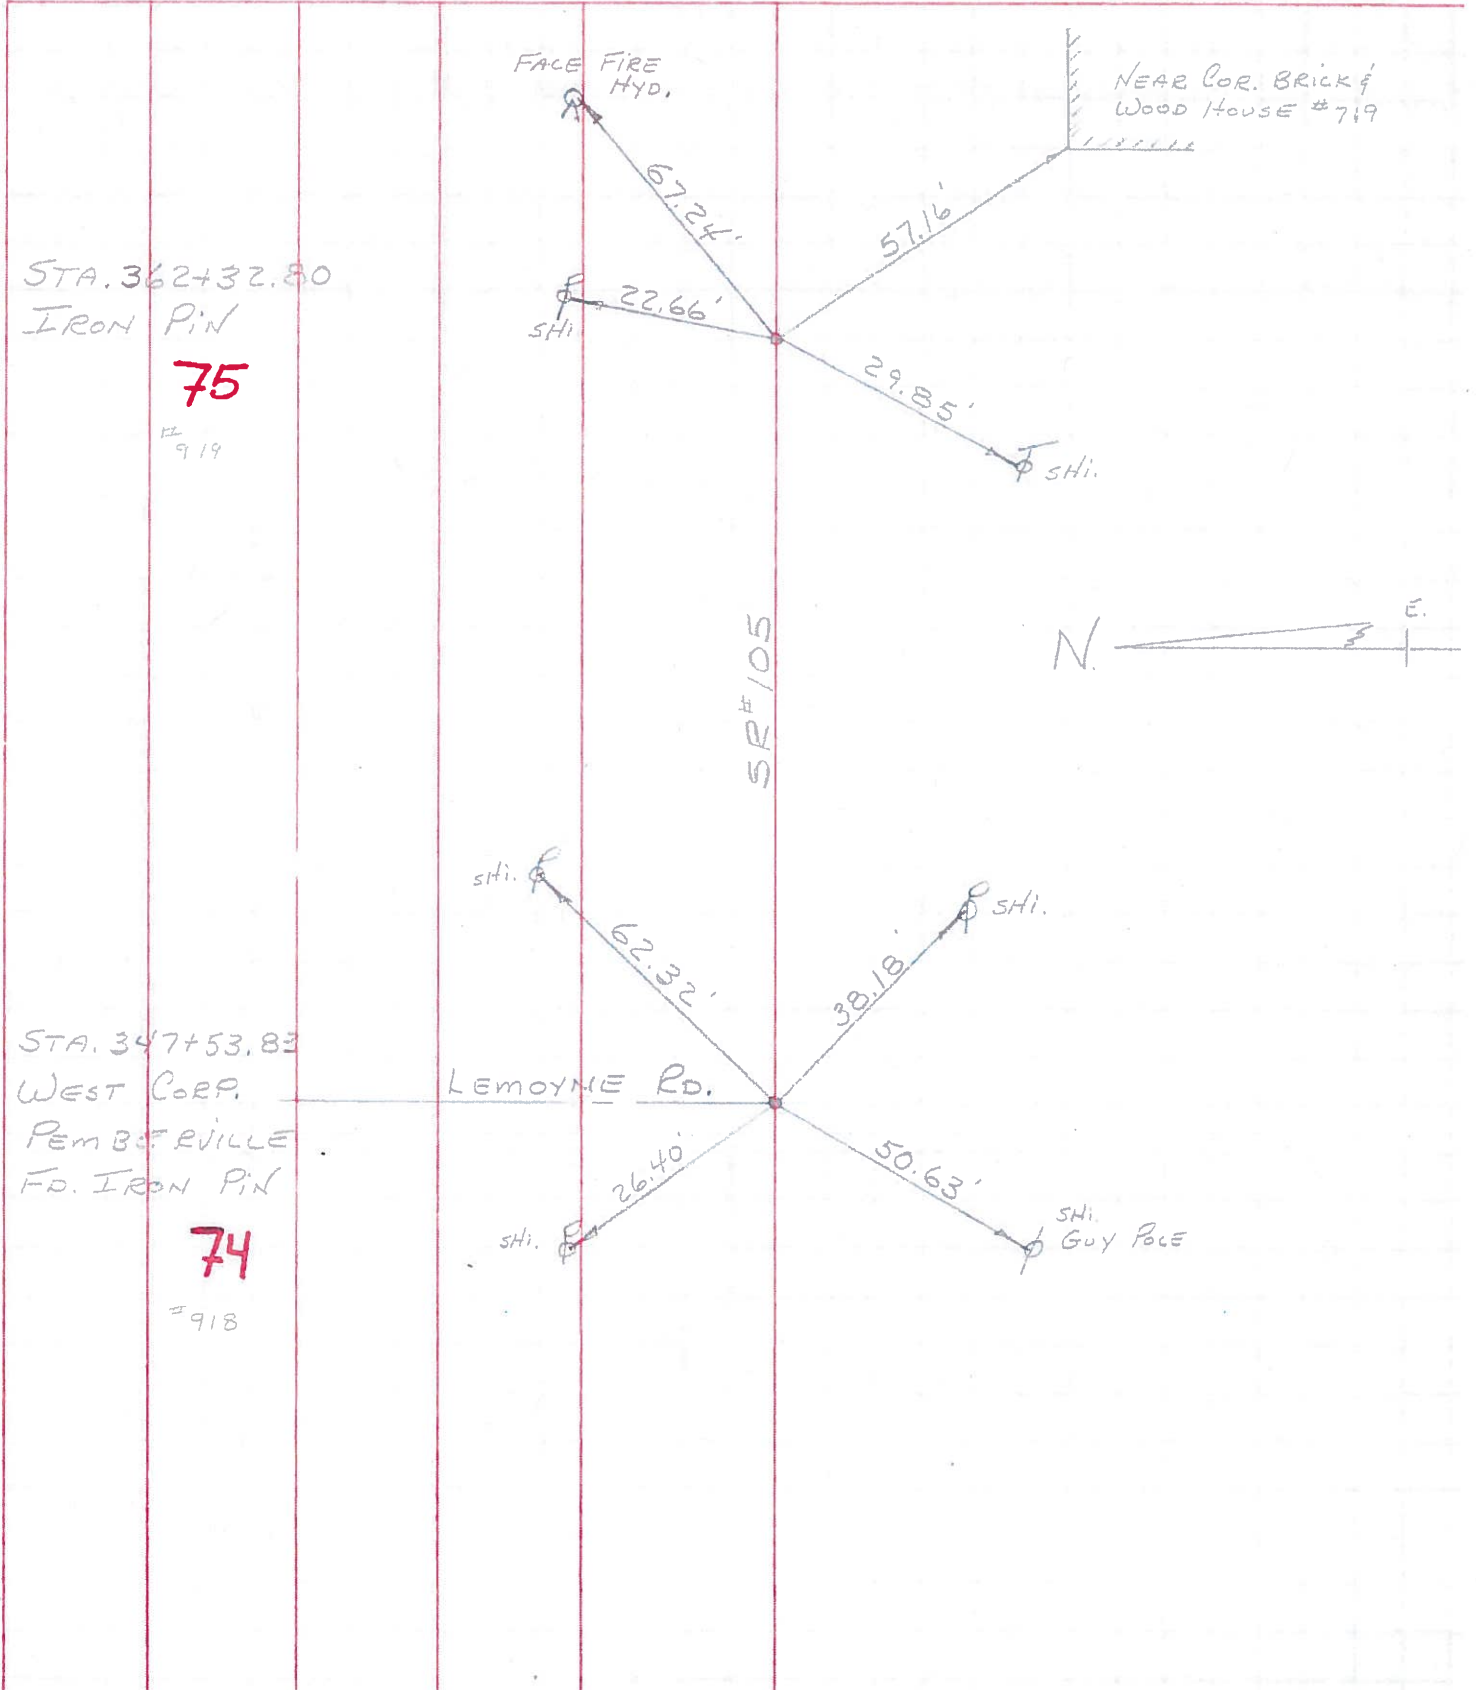

PERSONNEL TITLE PERSONNEL TITLE

COUNTY Wood

DATE OK 12-24-57
OK. 9-15-70 R

S. R. #105

WEATHER

SEC. Pemberville

TEMP.

DESCRIPTION

Corp. to Corp.

LEFT


CENTER LINE

RIGHT

JOB NO.


Sta. 347+53.83
Inter. S.R. 105 & Keymane
Rd. Iron pin
#918

74

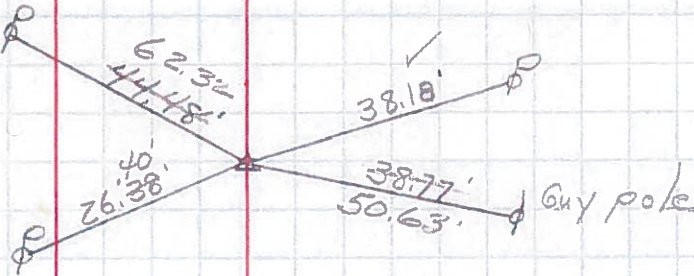


Sta. 362+32.80
Iron pin
#919

75

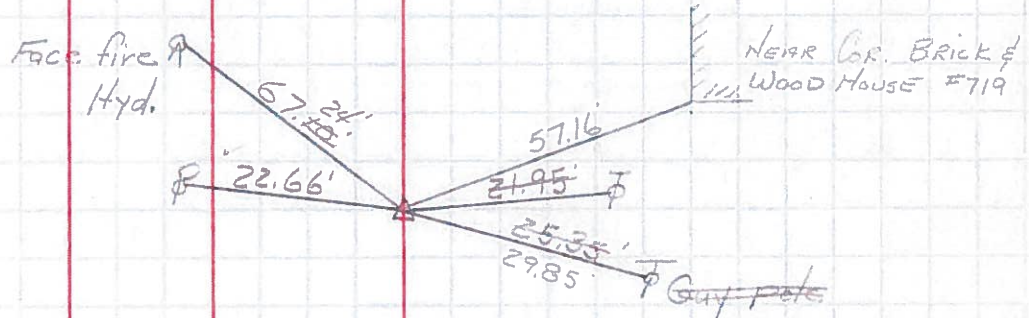

Sta. 365+77.96
Iron pin
#920

76

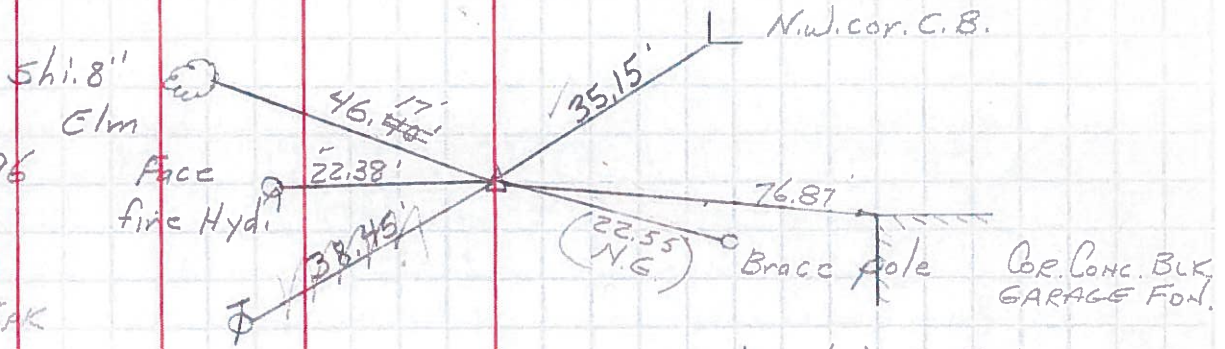


FD. SMALL P.R.SAK
@ SURFACE

s.w. cor. brick
Porch

Sta. 372+73.68
Sherman Ave.
Iron pin
#921

77

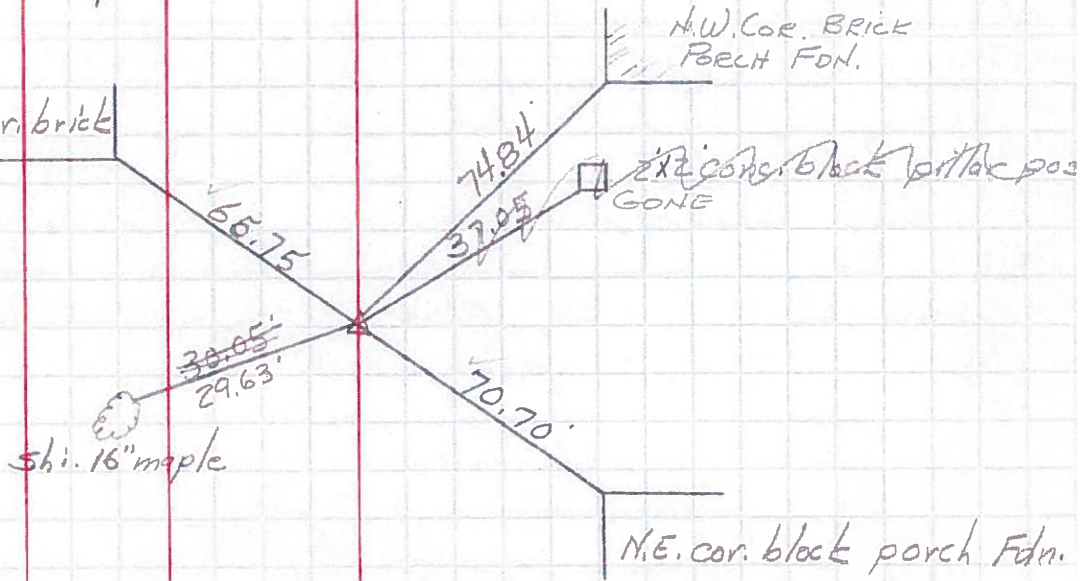

N.E. cor. block porch Fdn.