


O.D.O.T. DISTRICT 2 SURVEY OFFICE (USE ONLY)


PERSONNEL	REFERENCE NO. <u>A3</u>	SHEET <u>6</u> OF <u>24</u>
NOTES <u>RHOADES</u>	DATE <u>5-6-13</u>	ROUTE <u>SR 199</u>
H.C. <u>CODER</u>	WEATHER <u>CLOUDY</u>	COUNTY <u>WOOD</u>
R.C. <u>ROUSOS</u>	TEMP. <u>55°</u>	TOWNSHIP <u>PERRY</u>
		SECTION <u>36</u>
		T <u>3</u> N R <u>12</u> E

TYPE MONUMENT LG.R.R.SPIKE
 ON SURFACE - BELOW 3"
 LEFT - C PAV'T - ~~RIGHT~~ 64.8'
 - TO - EDGE PAVEMENT
 S.L.M. 62+87.90

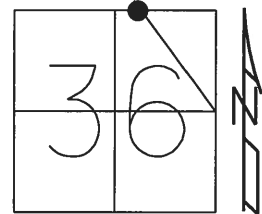

Grid: Northing: 553170.732 Easting: 1712383.738

RECORD:
 FD SM.R.R.SPIKE
 7/14/88, CL
 SET P.K./WASHER
 7/30/90, CL
 FD LG.R.R.SPIKE
 3" DOWN
 REFA3
 10/12/11, MC
 SET MAG/WASHER
 FINREFA3
 4/28/14, TMR

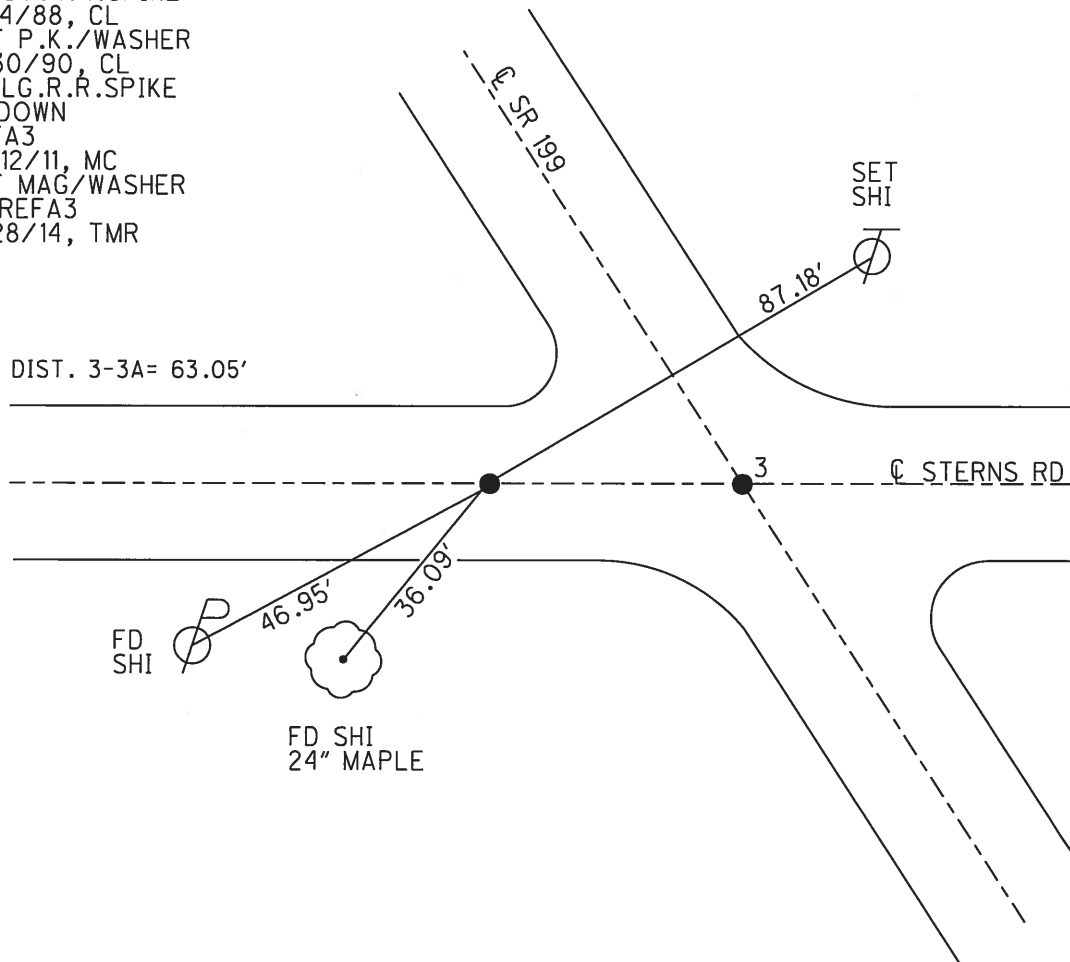

O.D.O.T. DISTRICT 2 SURVEY OFFICE

PERSONNEL

REFERENCE NO. 3

SHEET OF

NOTES LOEHRKE

H.C. BARNDHISEL

R.C. Reed

DATE 7-14-88

WEATHER Cloudy Hazy

TEMP. +86

ROUTE 199

COUNTY Wagon

TOWNSHIP PERRY

SECTION 36

T. 3 N. R. 12 E.

Set P.K. 1 WASHER
7-30-90



TYPE MONUMENT Log RR Spike Sm RR Spike

ON SURFACE - BELOW 1" Behw

LEFT- & PAV'T. - RIGHT "A" 2' S. of Stearns, 1' W of 199

TO EDGE PAVEMENT

S.L.M. 60+88

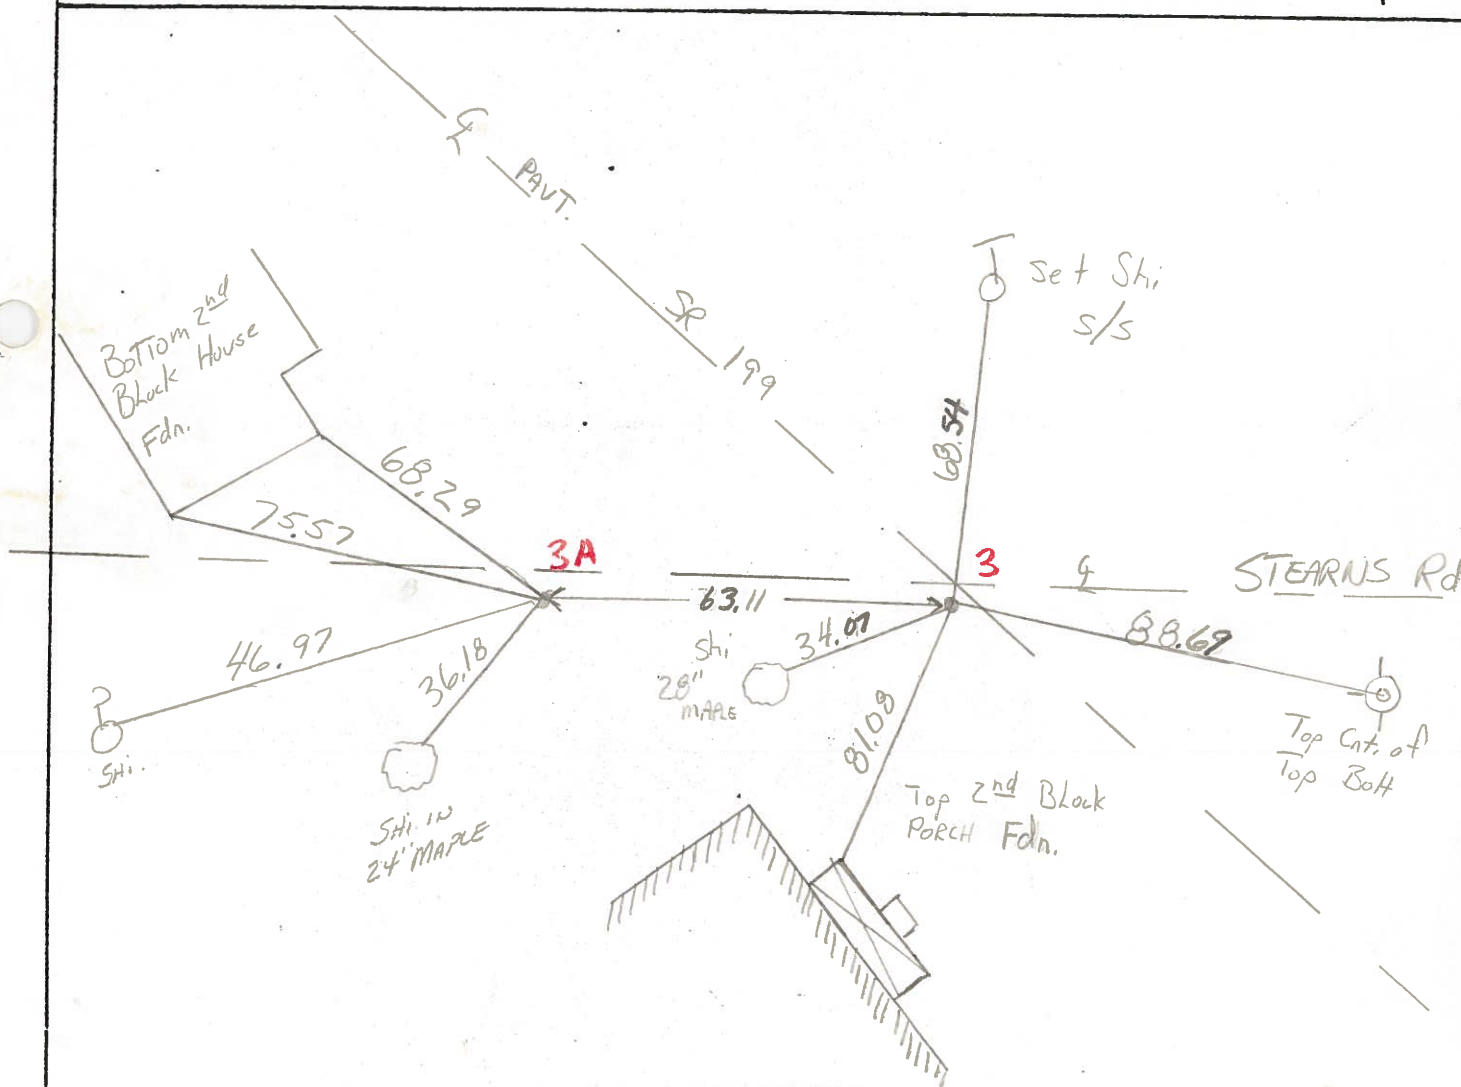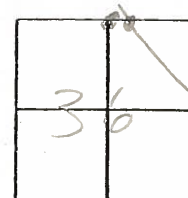

O.D.O.T. DISTRICT 2 SURVEY OFFICE

Sht. 4 of 4

County WOOD

Date 7-21-78 (OK 5-9-80)

Township PERRY

Weather RAIN STARTING

Section 36

Temp. +90°


T3N, R12E

Personnel BURNSIDE

BOWERS


KNAPP

CURTIS

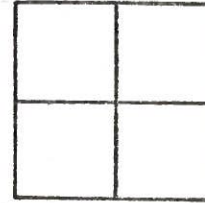

END POINT CHECK

#3

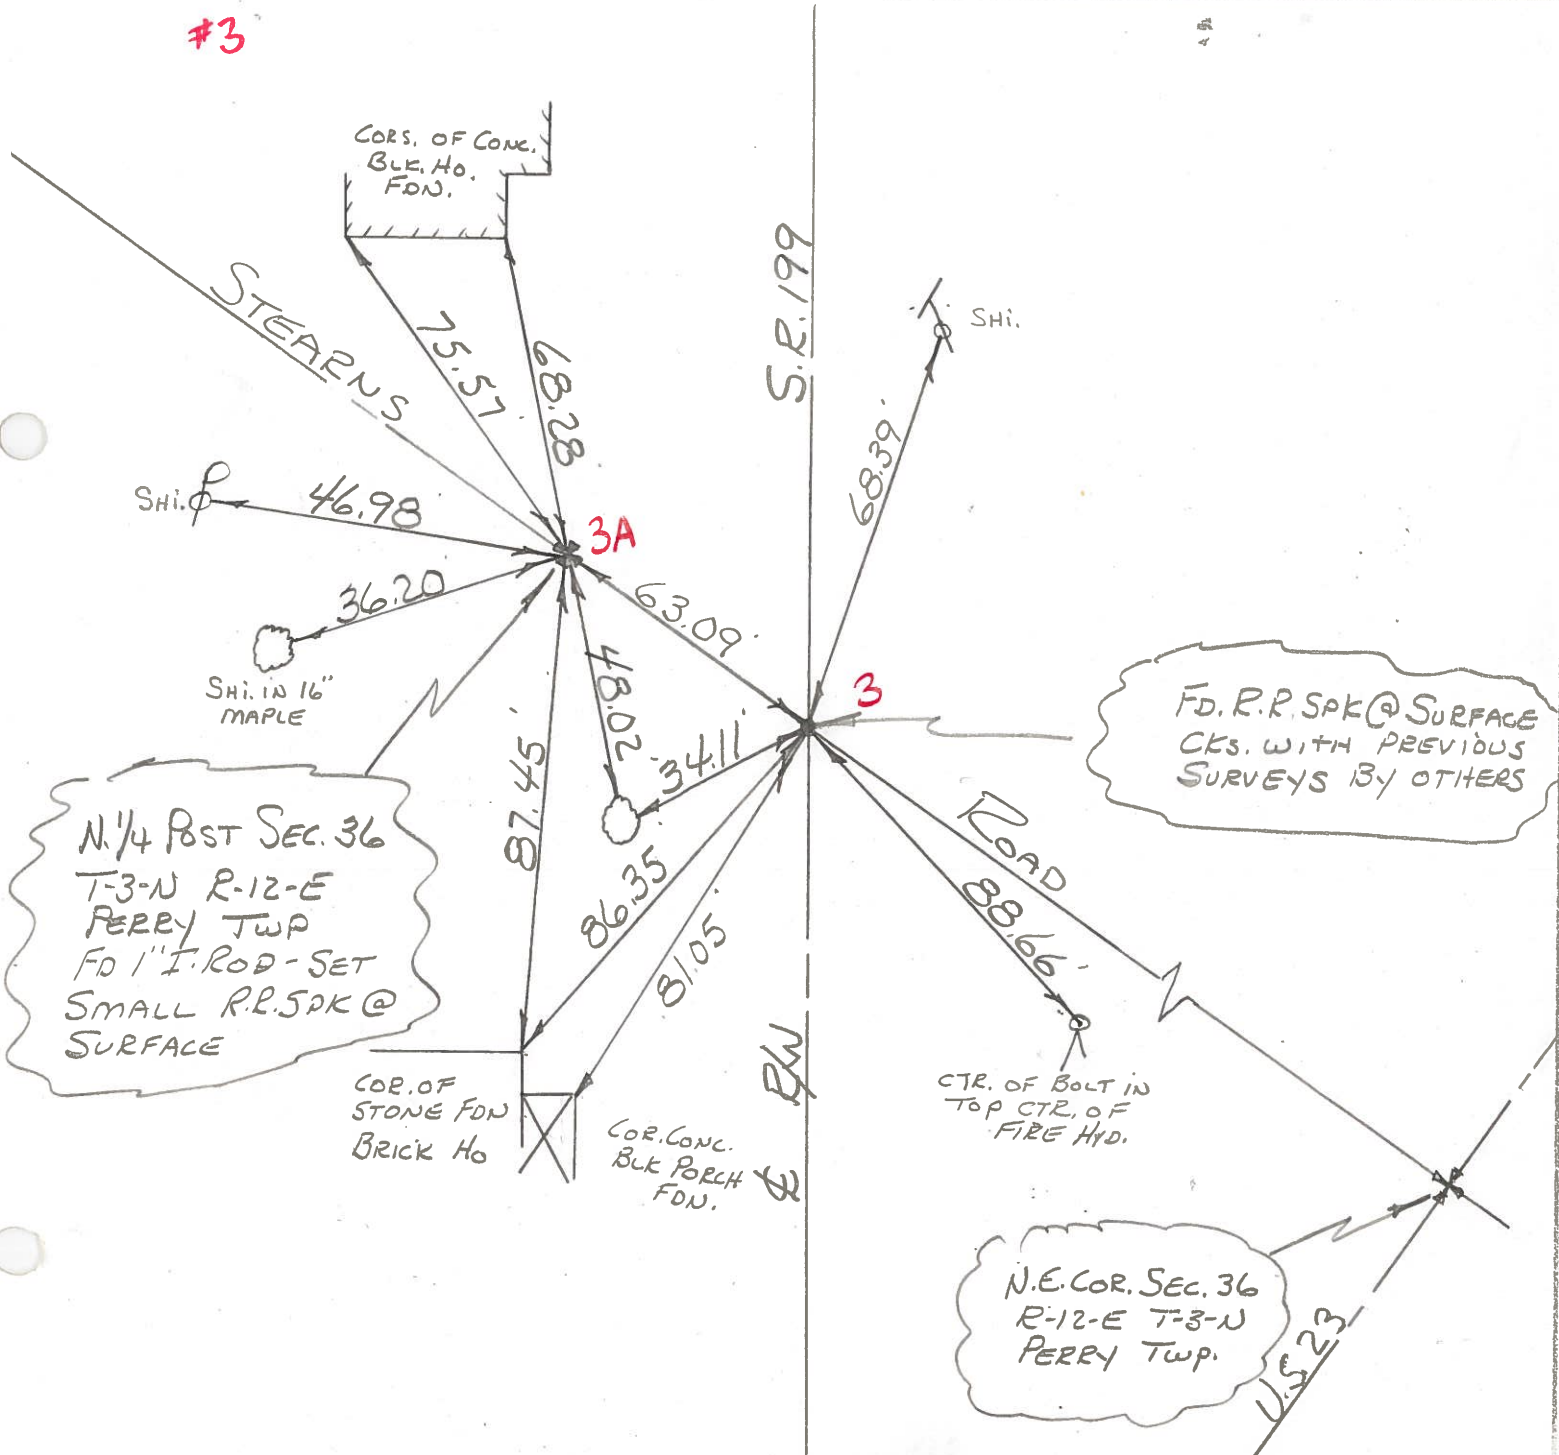

O.D.O.T. DISTRICT 2 SURVEY OFFICE

Sht. 4 of 4

S.R. 199

County WOOD

Date 7-21-78 (OK 5-9-80)

Township PERRY

Weather RAIN STARTING

Section 36

Temp. +90°


T3N, R12E

Personnel BURNSIDE

BOWERS


KNAPPE

CURTIS

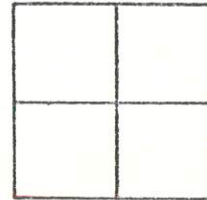

END POINT CHECK

#3

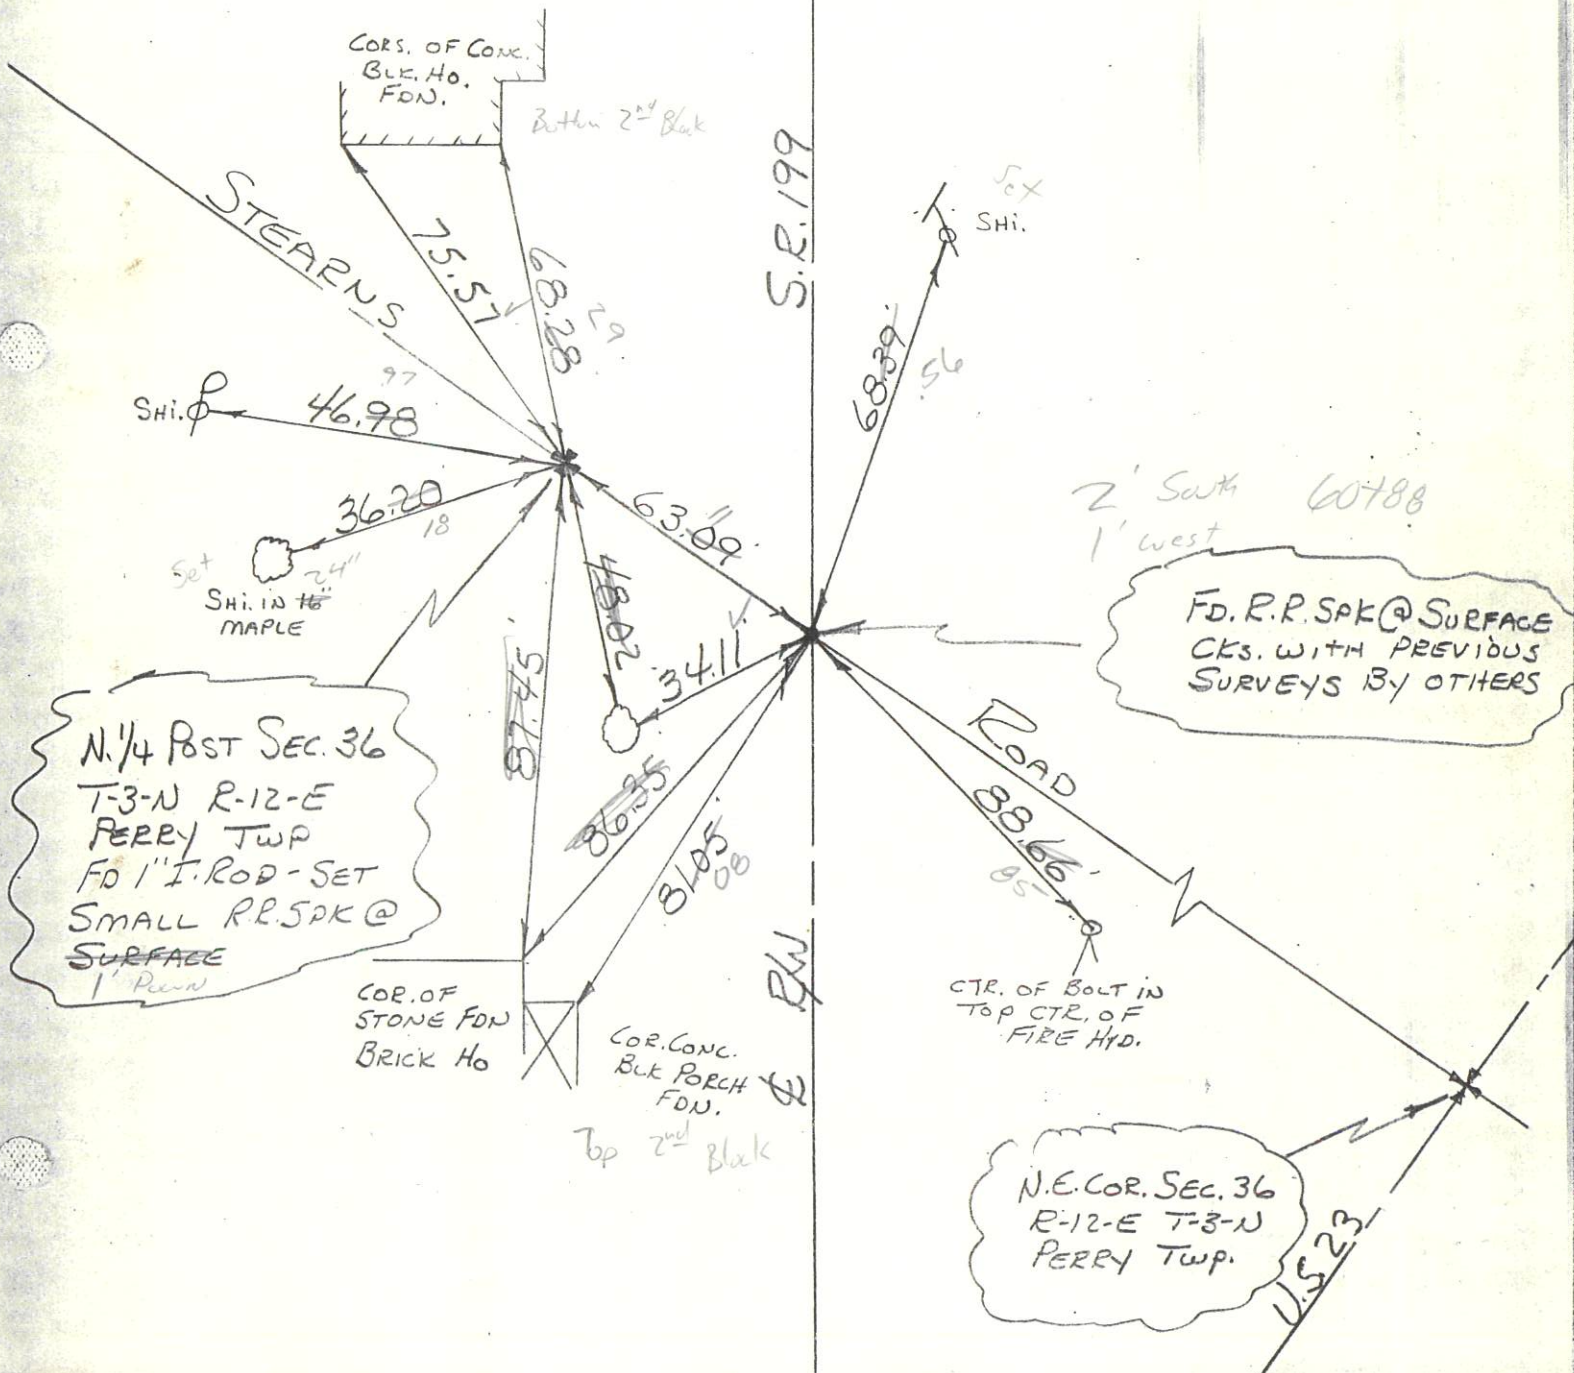

PERSONNEL	TITLE	PERSONNEL	TITLE
BURNSIDE			
SMITH			
BOWERS			

COUNTY Wood DATE 11-23-71
S. R. 199 WEATHER CLEAR
SEC. 36 PERRY Twp. TEMP. +20°

DESCRIPTION	JOB NO.

