



O.D.O.T. DISTRICT 2 SURVEY OFFICE (USE ONLY)

PERSONNEL _____ REFERENCE NO. 4 SHEET 7 OF 24

NOTES RHOADES DATE 5-6-13 ROUTE SR 199
H.C. CODER WEATHER CLOUDY COUNTY WOOD
R.C. ROUSOS TEMP. 55° TOWNSHIP PERRY
SECTION 25
T 3 N R 12 E

TYPE MONUMENT P.K./WASHER
ON SURFACE - ~~BELOW~~ ON
LEFT - CL PAV'T - ~~RIGHT~~ 1.5', 1' N OF CL W
- TO - EDGE PAVEMENT
S.L.M. 94+85.31

Grid: Northing: 555822.929 Easting: 1710661.491

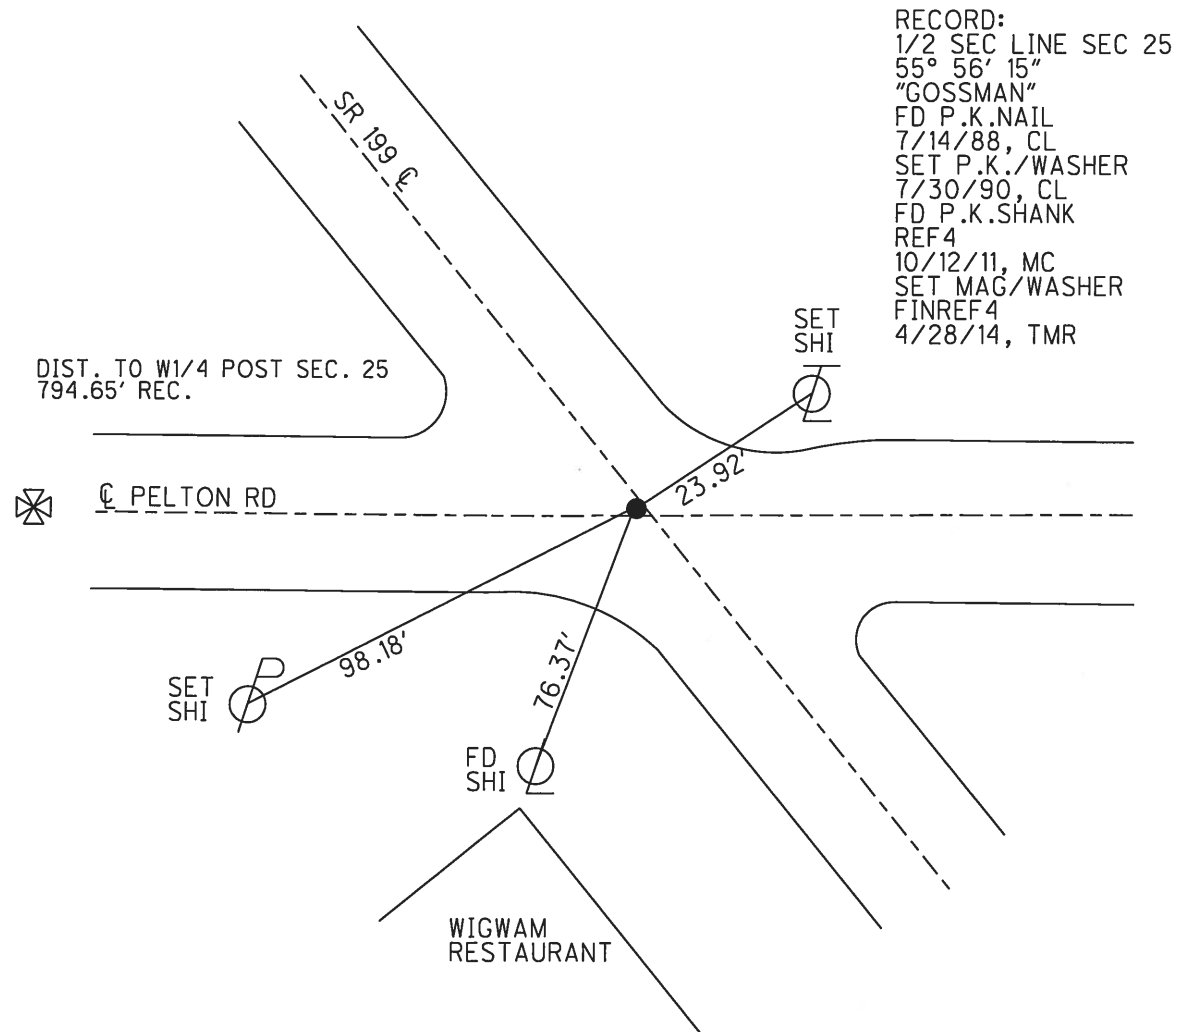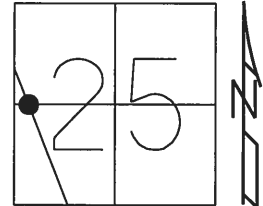

O.D.O.T. DISTRICT 2 SURVEY OFFICE

PERSONNEL

REFERENCE NO. 4

SHEET OF

NOTES LOEHKE

H.C. BARNHISEL

R.C. Reed

DATE 7-14-88

WEATHER Cloudy Hazy

TEMP. 85

ROUTE 199

COUNTY Wagon

TOWNSHIP Perry

SECTION 25

T 3 N R 12 E

TYPE MONUMENT PK NAIL

ON SURFACE - BELOW



LEFT - & PAV'T. - RIGHT LS

TO EDGE PAVEMENT

S.L.M. 9289

Set P.K. / WASHER
7-30-90
C.L.

1' N. of Pelton West

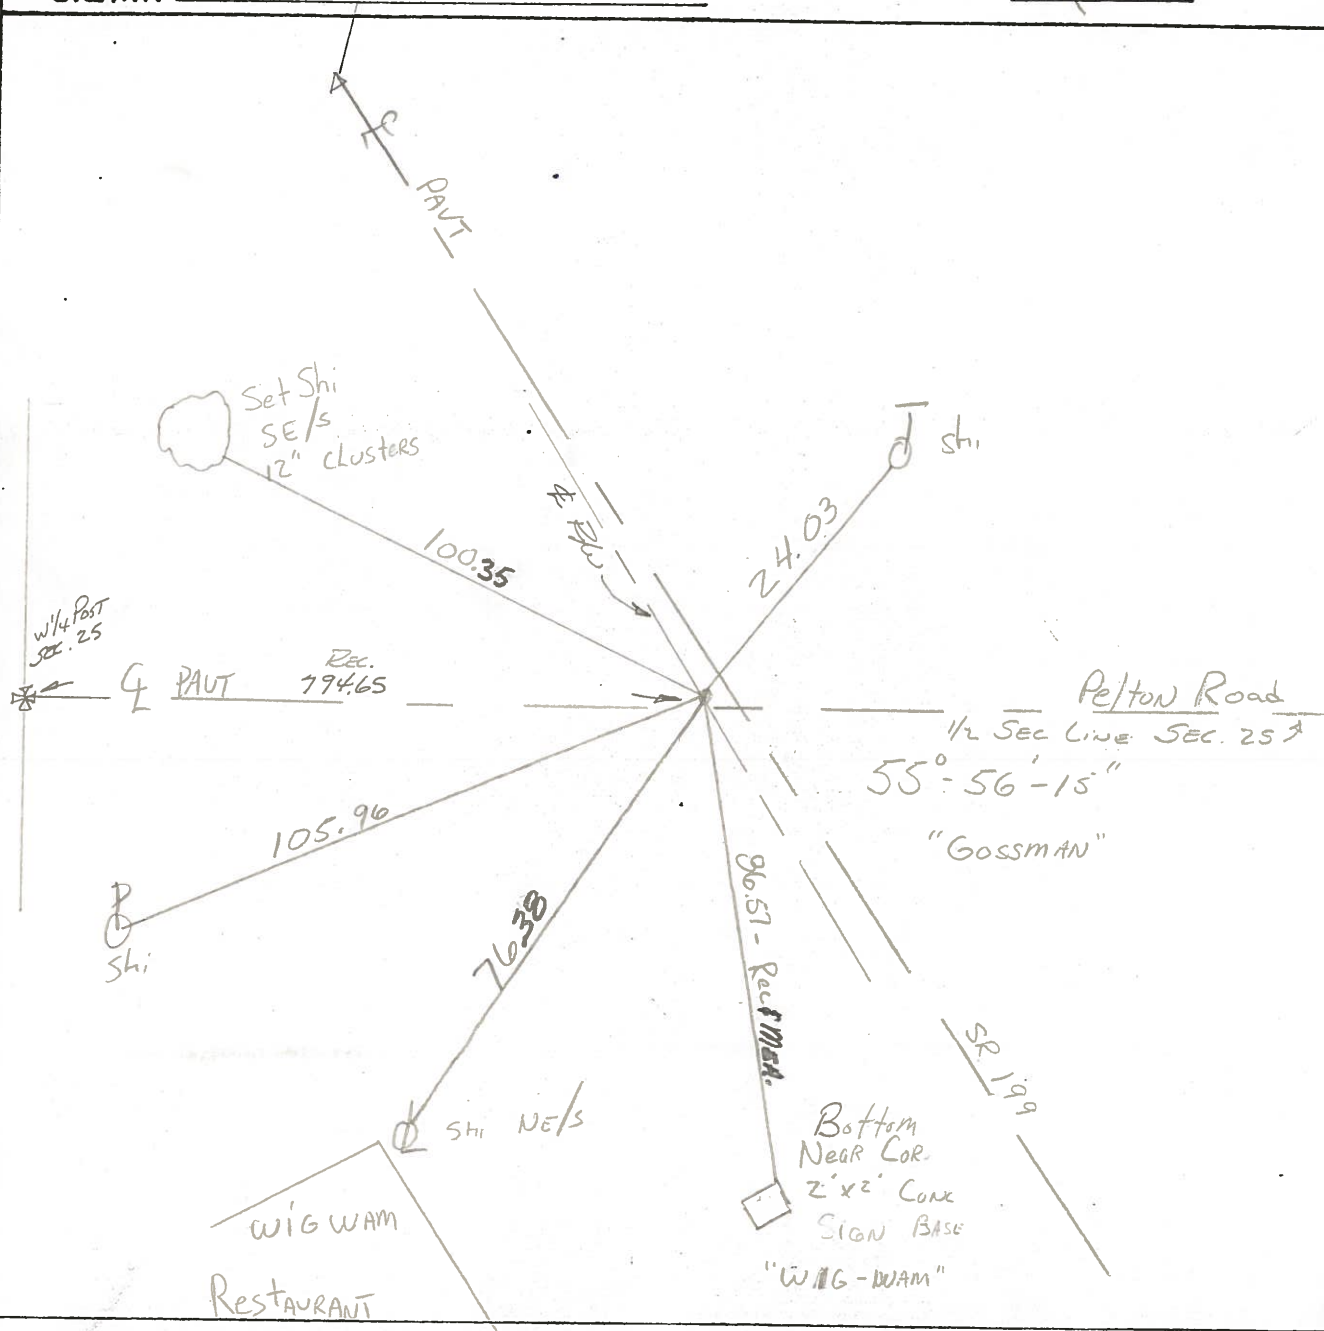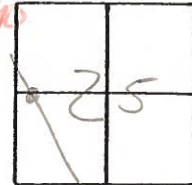

O.D.O.T. DISTRICT 2 SURVEY OFFICE

SHEET 5 OF

County WOOD S.R. 199

Township PERRY

Section 25

T N, R E

Personnel BURNSIDE

SMITH

BOWERS

HOLCOMBE

Date 10-6-71 (5-9-80) ^{CHKD.}

Weather CLEAR

Temp. +70°

23	24
26	25



4
FD I. Pipe
FOR P.I.

#4
NOTE:
BY USING SURVEYS OF GILBERT
TESAR 8-1944 & FRED GOSSMAN
3-1952 DUG & FOUND R.R. SPK.
6" DEEP SET R.R. SPK. @
SURFACE.

FOUND R.R. SPK.
S. LINE DUDING
PROPERTY

W. 1/4 Post
SEC. 25

794.65 REC.

794.56 Meas.

Shi. B.

106.00'

78.04'

91.51'

86.57'

24.11' SHI.

PELTON RD.

1/2 SEC. LINE SEC. 25

55°-56'-15"
"GOSSMAN"

NORTH COR.
CONC. BLK.
REST. (2'-UP)
WIG-WAM

NORTH COR.
CONC. BLK.
PILLAR
(2'-UP)

NEAR COR. 2x2
SIGN BASE
(NO SIGN)

30'

558.00'

FOUND IRON PIPE
SET BY F. GOSSMAN
MARCH-1-1952

30'

SHEET 5 OF

Date 10-6-71 (5-9-80) ^{CHKD.}

Weather CLEAR

Temp. +70°


23	24
26	25

24

BOWERS

BOWERS

HOLCOMBE

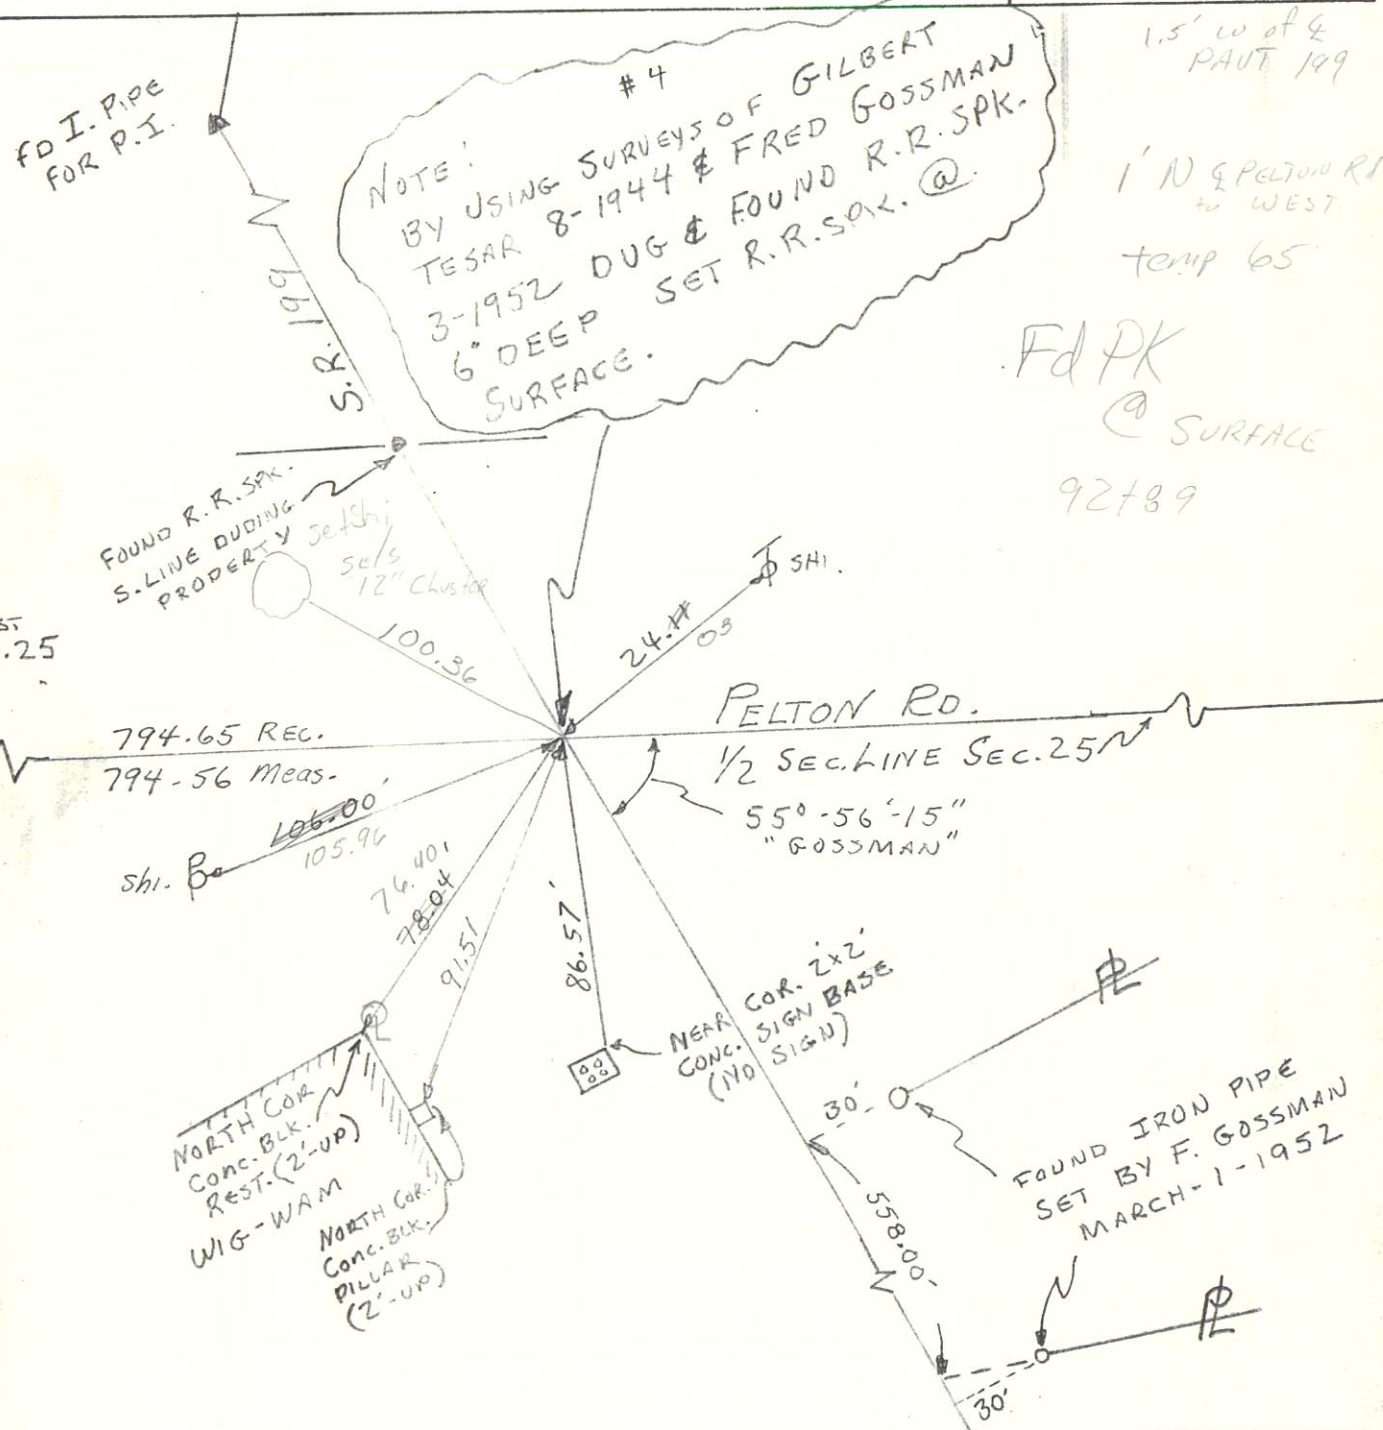

COPIED

SHEET NO. 5

OK-5-9-80

DATE 10-6-71

PERSONNEL TITLE PERSONNEL TITLE

BURNSIDE

SMITH

BOWERS

HOLCOMBE

COUNTY WOODS. R. 199WEATHER CLEARSEC. PELTON RD.TEMP. +70°

DESCRIPTION

LEFT

CENTER LINE

RIGHT

JOB NO.

(4)

W 1/4 Post
Sec. 25794.65 REC.
794.56 MEA.

SHI. P. 106.00

NORTH COR.
CONC. BLK.
REST. (2' UP)
"WIG-WAM"NORTH COR.
CONC. BLK.
PILLAR
(2' UP)FOUND R.R. SPK.
S. LINE DURING
PROPERTYFD. I. PIPE
FOR P.I.

NOTE:

#4

BY USING SURVEYS OF GILBERT
TESAR 8-1944 & FRED GOSSMAN
3-1952, DUG & FOUND R.R. SPK.
6" DEEP. SET R.R. SPK. @
SURFACE

S.R. 199

24.11' SHI.

78.04'
91.51'86.57'
(289.00')
(REC. MEA.)NEAR COR. 2x2'
CONC. SIGN BASE
(NO SIGN)

30'

558.00'

30'

PELTON RD.
1/2 SEC. LINE SEC. 2555°-56'-15"
"GOSSMAN"FOUND IRON PIPE
SET BY F. GOSSMAN
MARCH 1, 1952