

O.D.O.T. DISTRICT 2 SURVEY OFFICE (USE ONLY)

PERSONNEL

REFERENCE NO. 7

SHEET 10 OF 24

NOTES RHOADES

DATE 5-6-13

ROUTE SR 199

H.C. CODER

WEATHER FAIR

COUNTY WOOD

R.C. ROUSOS

TEMP. 65°

TOWNSHIP PERRY

SECTION 23

T 3 N R 12 E

TYPE MONUMENT P.K./WASHER


ON SURFACE - ~~BELOW~~ ON

LEFT - CL PAV'T - ~~RIGHT~~ 0.8'


- TO - EDGE PAVEMENT

S.L.M. 154+54.22

Grid: Northing: 561134.193 Easting: 1708141.238

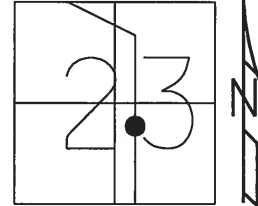

RECORD: P.I.  
STA 136+13  
 $\Delta = 0^\circ 34' \text{ LT}$   
INFO FROM FIELD  
BOOK & OLD PLAN  
DATED 1920  
FD P.K.NAIL  
6/30/88, CL  
SET P.K./WASHER  
7/30/90, CL  
FD P.K./WASHER  
REF7  
10/12/11, MC  
SET MAG/WASHER  
FINREF7  
4/29/14, TMR

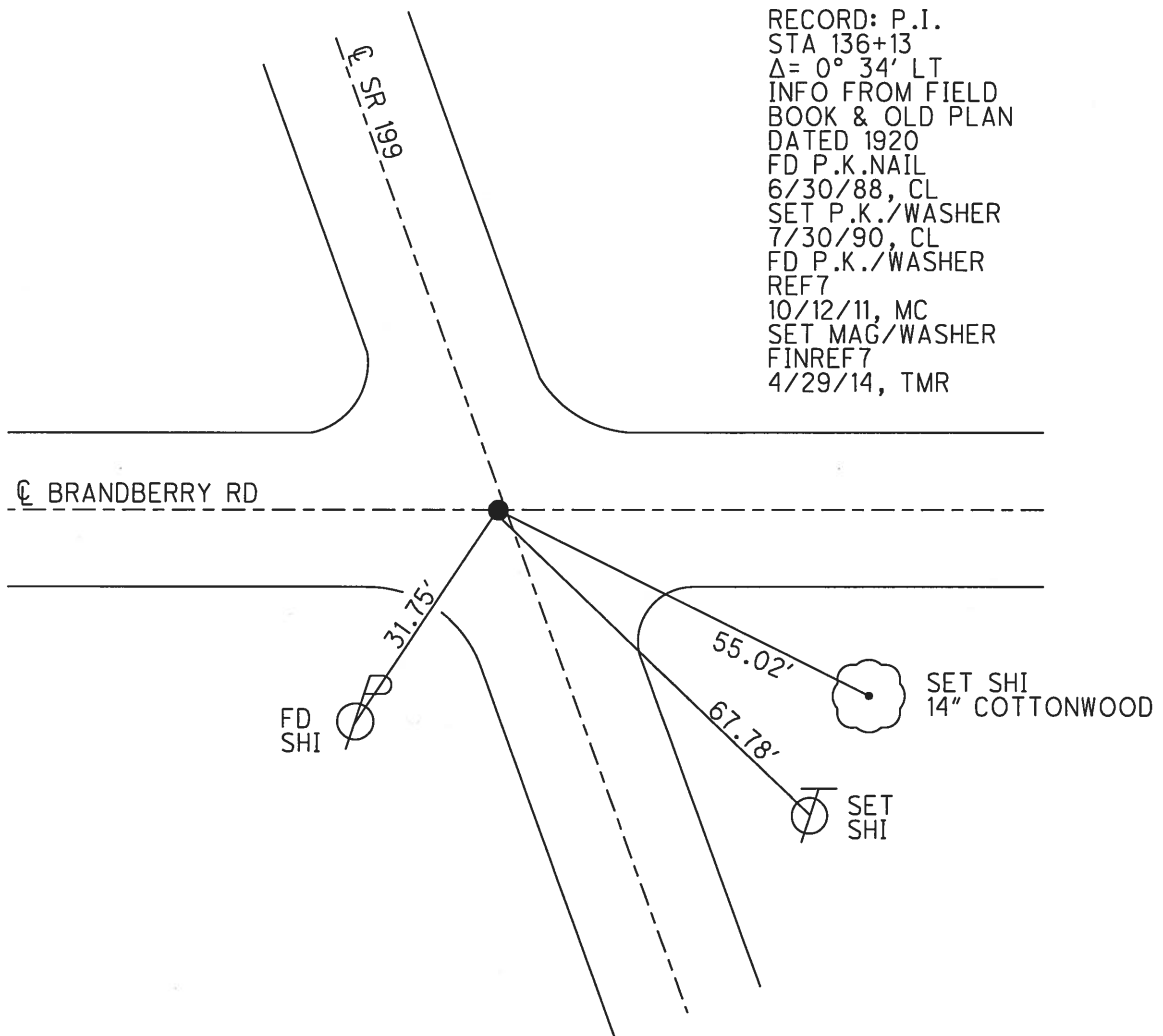

# O.D.O.T. DISTRICT 2 SURVEY OFFICE

PERSONNEL

REFERENCE NO. 7

SHEET      OF     

NOTES LOHRKE

H.C. BARNHISEL

R.C. REED

DATE 6-30-88

WEATHER Clear

TEMP. 66.5

ROUTE 199

COUNTY WOOD

TOWNSHIP PERRY

SECTION 23

T 3 N R 12 E

TYPE MONUMENT P.K. NAIL



ON SURFACE - BELOW

LEFT- & PAV'T. RIGHT 0.8

TO EDGE PAVEMENT

S.L.M. 152+59

Set PK & WASHER  
7-30-90  
C.H.

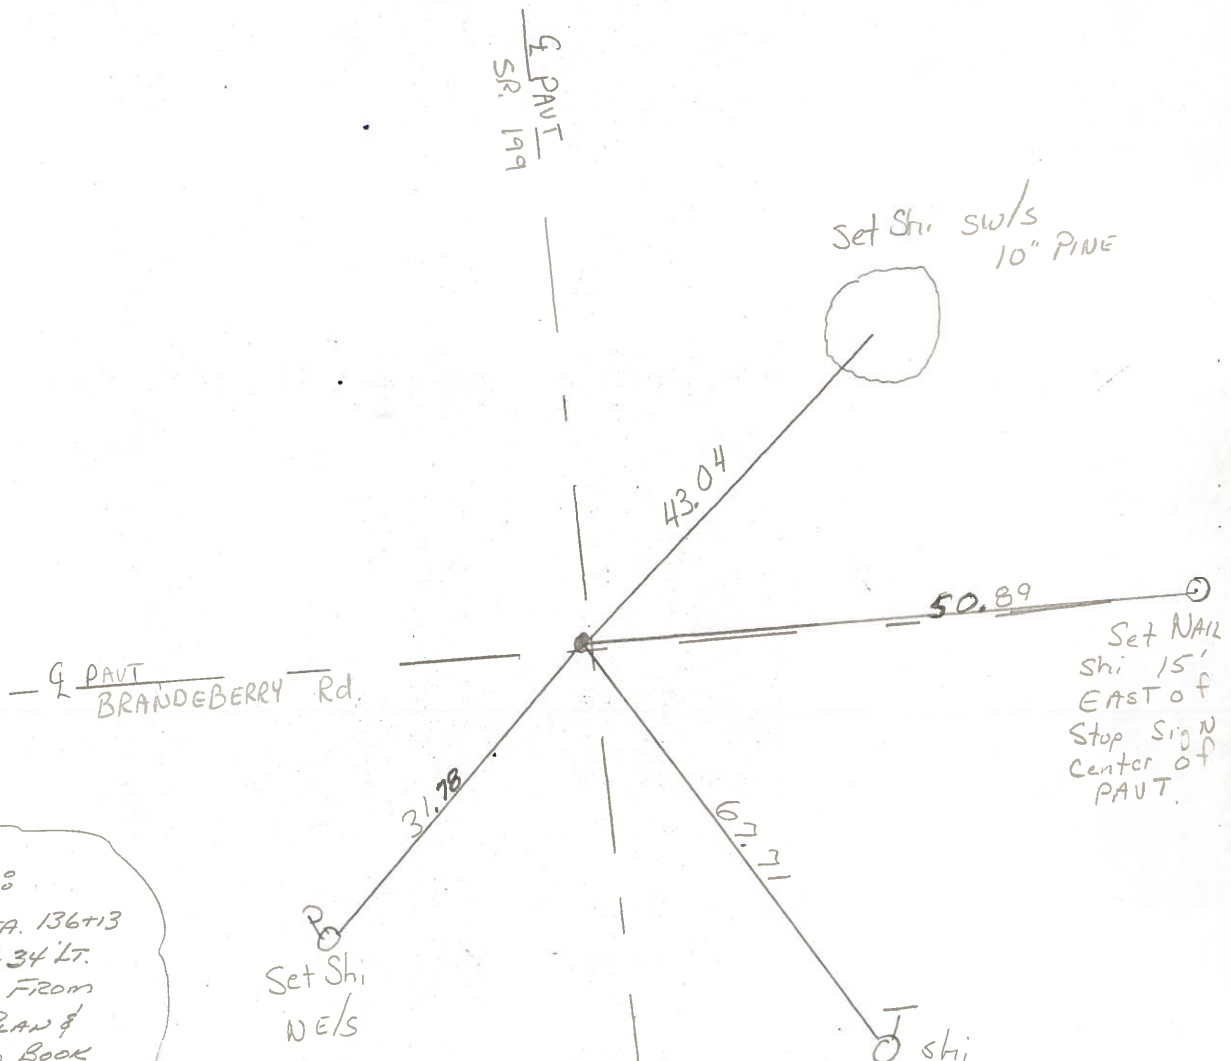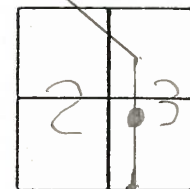

NOTE:  
P.I. STA. 136+13  
Δ = 0° 34' LT.  
INFO. FROM  
OLD PLAN &  
FIELD BOOK  
DATED 1920

SHEET 8 OF

Date 3-27-72 <sup>CHRO.</sup> (5-9-80)

Weather\_\_\_\_\_

Temp. \_\_\_\_\_

|    |    |
|----|----|
| 15 | 14 |
| 22 | 23 |

4

|    |    |
|----|----|
| 22 | 23 |
|----|----|

#7 0.8' Lt ♀ 199  
0.8' Nof ♀ part pike to east surface

P.I. STA. 152 + 55.28  
 $\Delta = 0^{\circ}-30'$  LT { meas. by J. CRONIN  
 Fd. P.K. NAIL

## PAVEMENT

BRANDEBERRY ROAD

NAZL Shi  
Q PAUT  
15' E. of Stop  
sign

NOTE:  
P.I. STA 136+1.3  
 $\Delta = 0^{\circ}-34$  LT.  
OLD PLAN & FIELD  
BOOK DATA,  
DATED 1920

# O.D.O.T. DISTRICT 2 SURVEY OFFICE

SHEET 8 OF

County WOOD S.R. 199

Township PERRY

Section 23

T N, R E

Personnel BURNSIDE

SMITH

BOWER

Date 3-27-72 <sup>CHKD.</sup> (5-9-80)

Weather                     


Temp.                     

|    |    |
|----|----|
| 15 | 14 |
| 22 | 23 |



#7

P.I. STA 152+55.28  
 $\Delta = 0^\circ - 30'$  LT {meas. by  
 J. CRONIN  
 Fd. P.K. NAIL

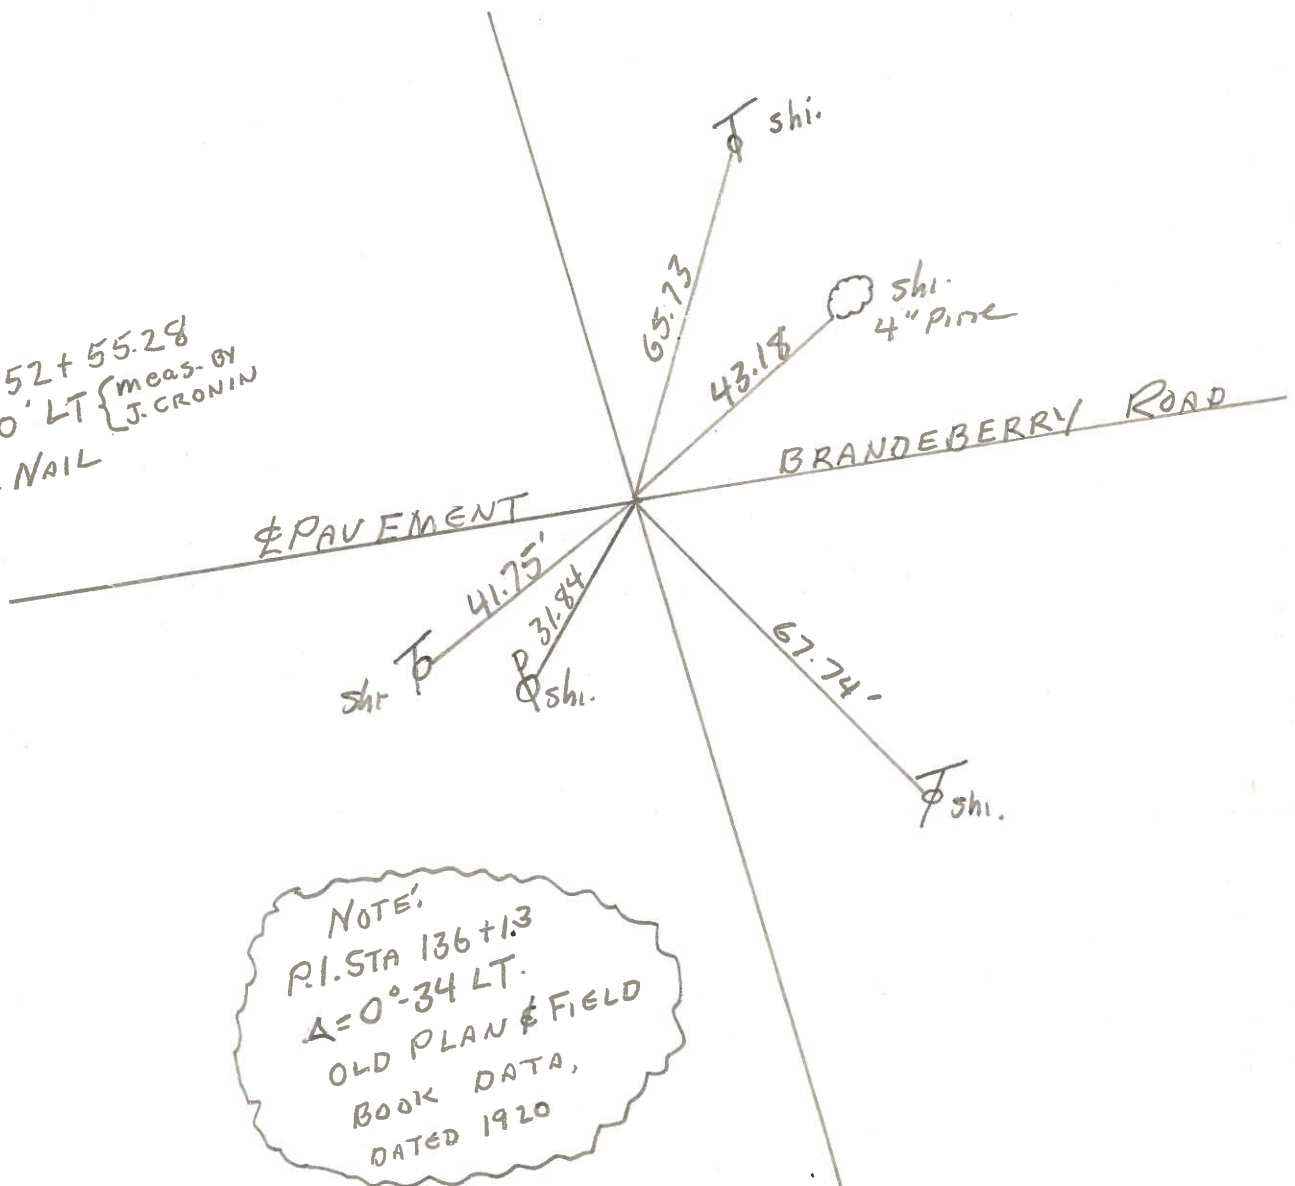

COPIED

SHEET NO. 8

OK-5-9-80

DATE 3-27-72

PERSONNEL

TITLE

PERSONNEL

TITLE

COUNTY WOODBURNSIDESMITHS. R. 199WEATHER CLEAR

SEC. \_\_\_\_\_

TEMP. 50°

DESCRIPTION

P.I. @ BRANDEBERRY ROAD


JOB NO. \_\_\_\_\_

LEFT

CENTER LINE

RIGHT

#1  
 P.I. STA. 152+55.23  
 $\Delta = 0^\circ 30' \text{ LT.}$  {MEAS. BY  
 CRONINI  
 FO. P.K. NAIL

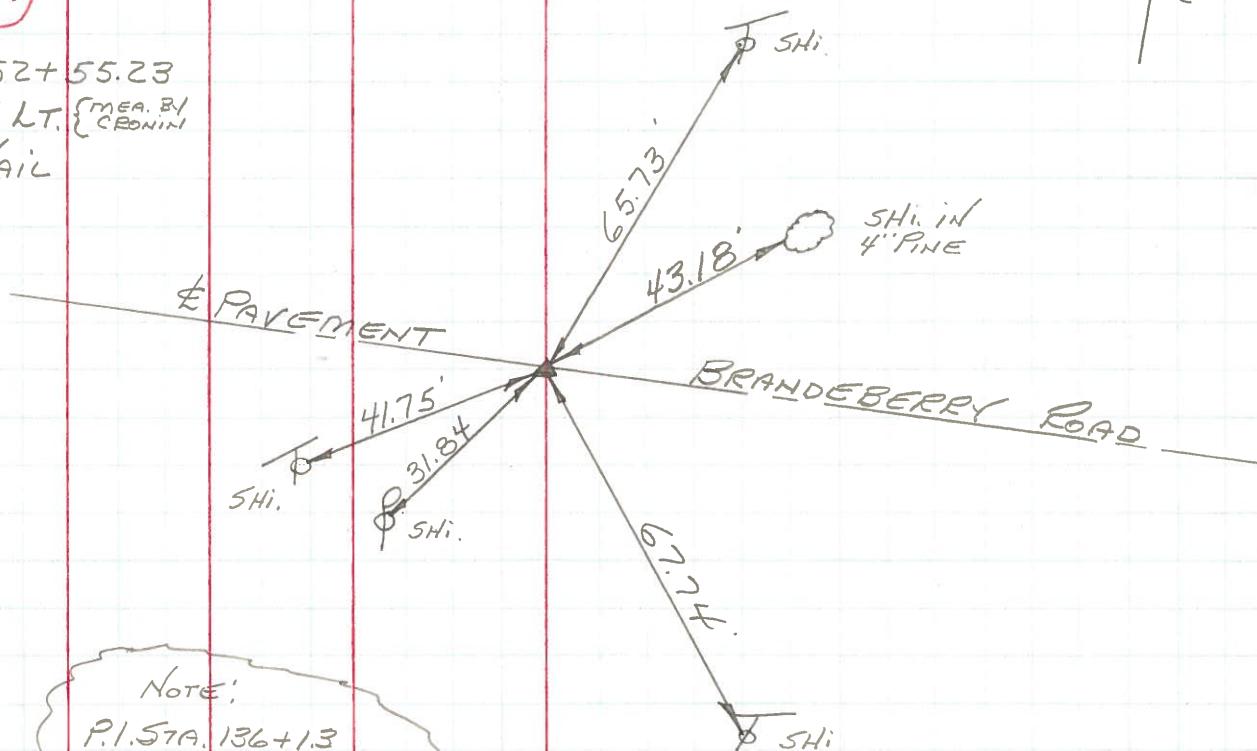

NOTE:  
 P.I. STA. 136+13  
 $\Delta = 0^\circ 24' \text{ LT.}$   
 OLD PLAN & FIELD  
 BOOK DATA;  
 DATED 1920

