

O.D.O.T. DISTRICT 2 SURVEY OFFICE (USE ONLY)

PERSONNEL

REFERENCE NO. 8

SHEET 11 OF 24

NOTES RHOADES

DATE 5-6-13

ROUTE SR 199

H.C. CODER

WEATHER FAIR

COUNTY WOOD

R.C. ROUSOS

TEMP. 65°

TOWNSHIP PERRY

SECTION 23

T 3 N R 12 E

TYPE MONUMENT 3/4" IPIN



~~ON SURFACE~~ - BELOW 4"

~~LEFT~~ - CL PAV'T - RIGHT 5'

7.4' RT TO RT EDGE PAVEMENT

S.L.M. 165+56.25

Grid: Northing: 562209.641 Easting: 1707898.411

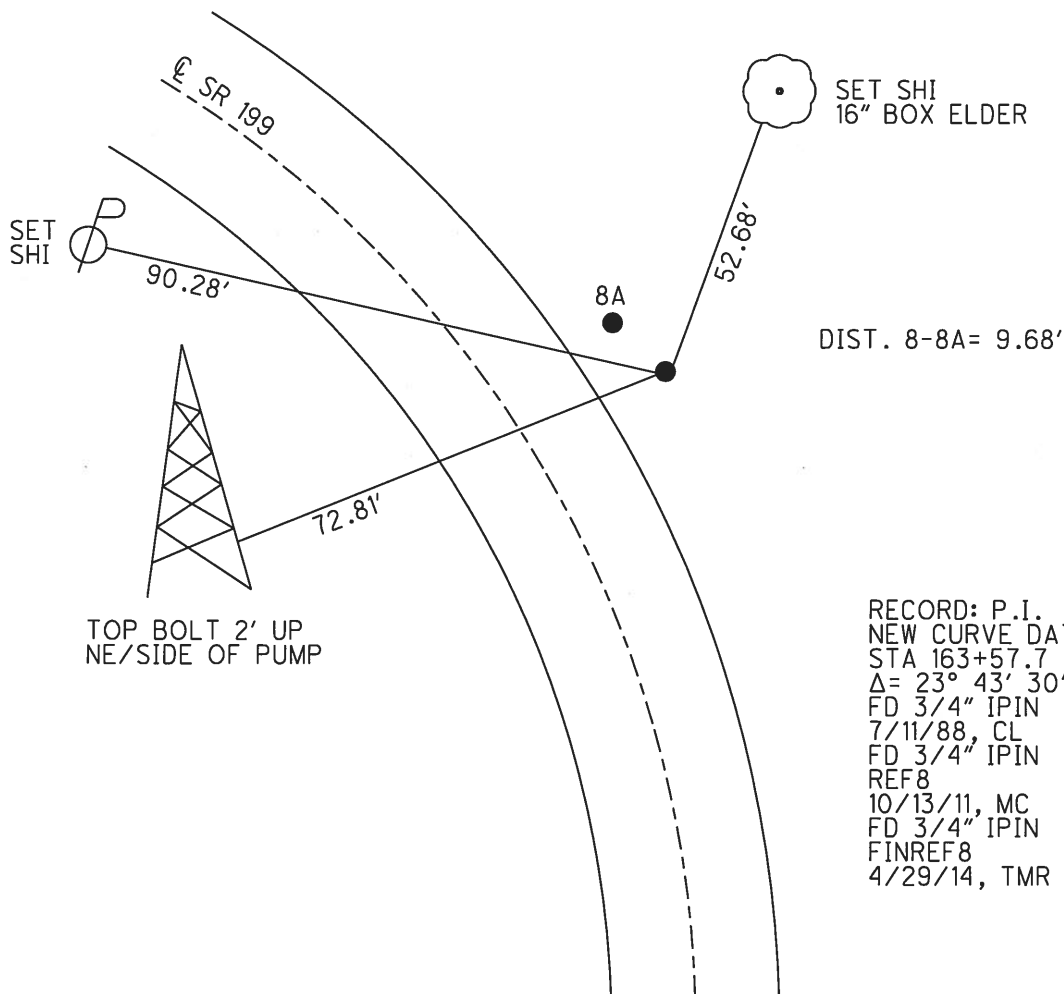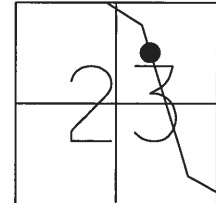

O.D.O.T. DISTRICT 2 SURVEY OFFICE

PERSONNEL

REFERENCE NO. 8

SHEET OF

NOTES LOEHRKE

H.C. BARNHISEL

R.C. Reed

DATE 7-11-88

WEATHER Cloudy

TEMP. +80

ROUTE 199

COUNTY WOOD

TOWNSHIP Perry

SECTION 23

T 3 N R 12 E

TYPE MONUMENT 3/4 IRON Rods



ON SURFACE - BELOW 1" Below

LEFT - CL PAV'T. - RIGHT

TO EDGE PAVEMENT

S.L.M.

OK
7-30-90
CL

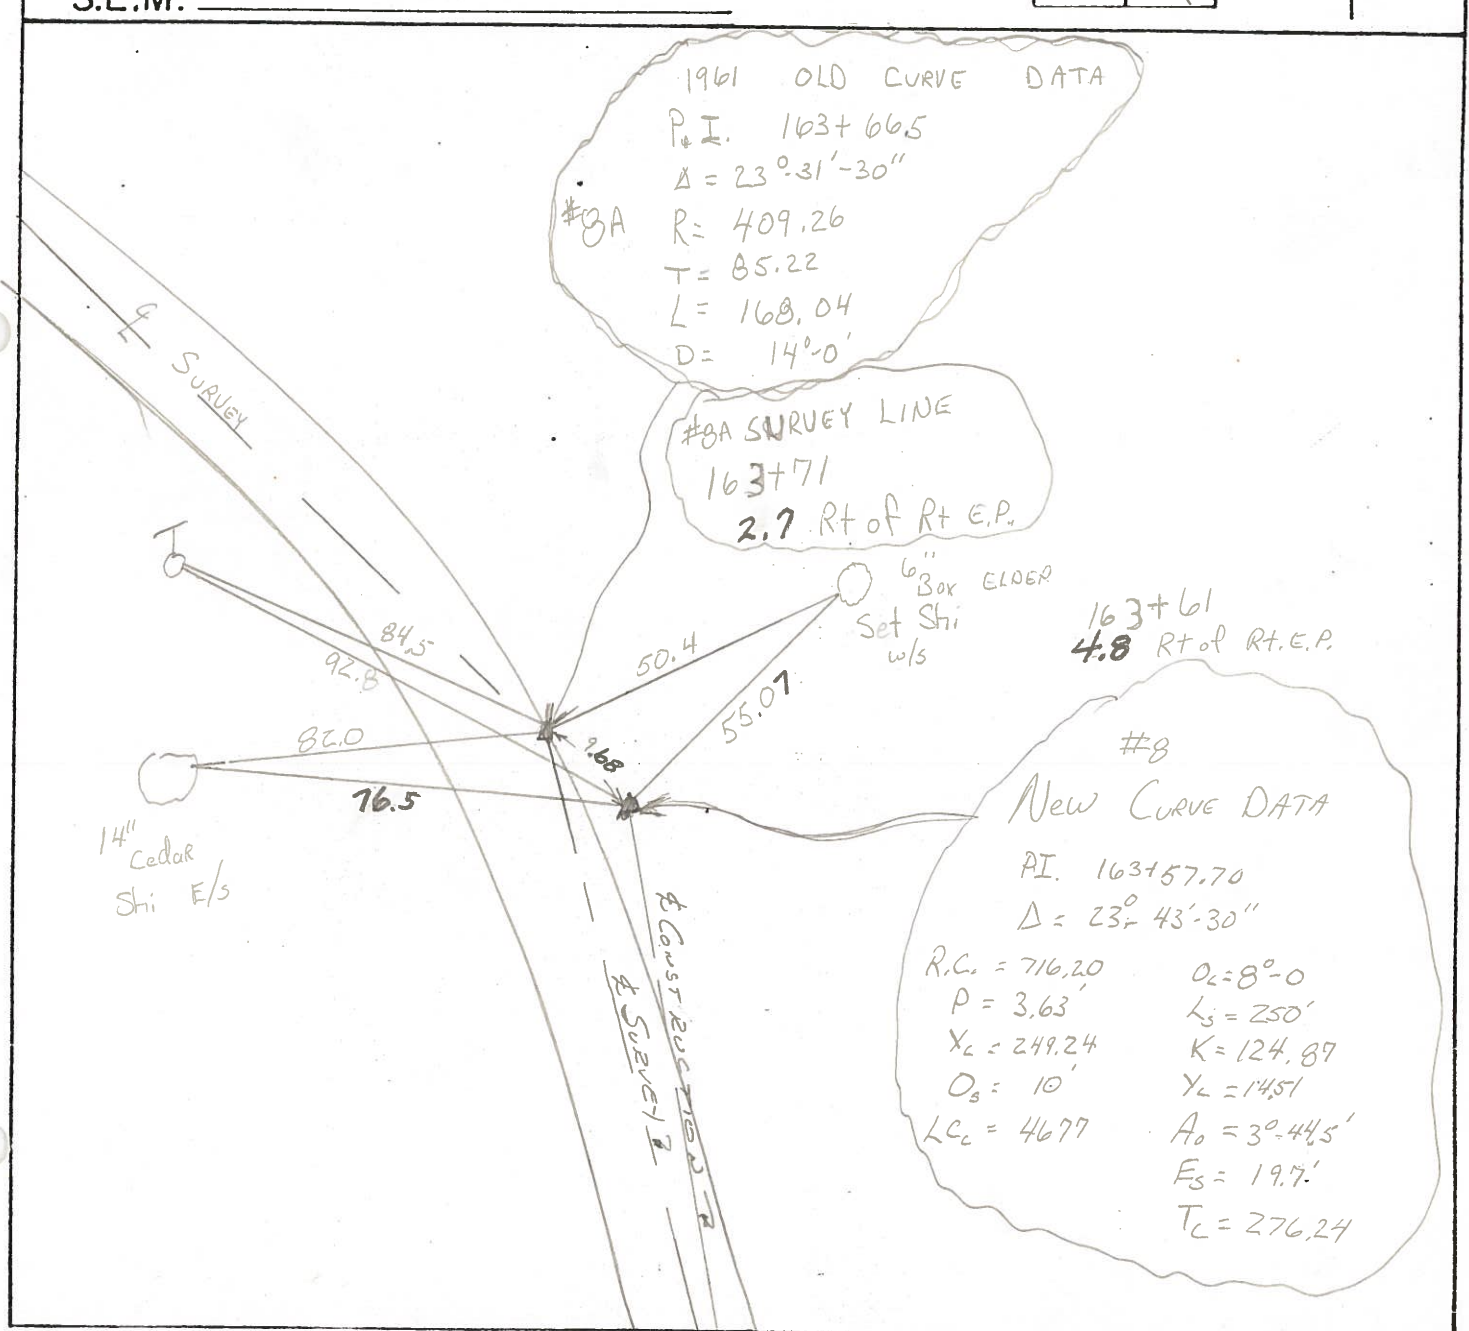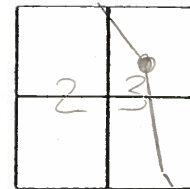

County WOOD S.R. 199Township PERRYSection 23T N, R EPersonnel BURNSIDESMITHMEADBOWERSDate 1-19-72 (5-9-80)^{CRD.}


Weather _____

Temp. _____

15	14
22	23



#8

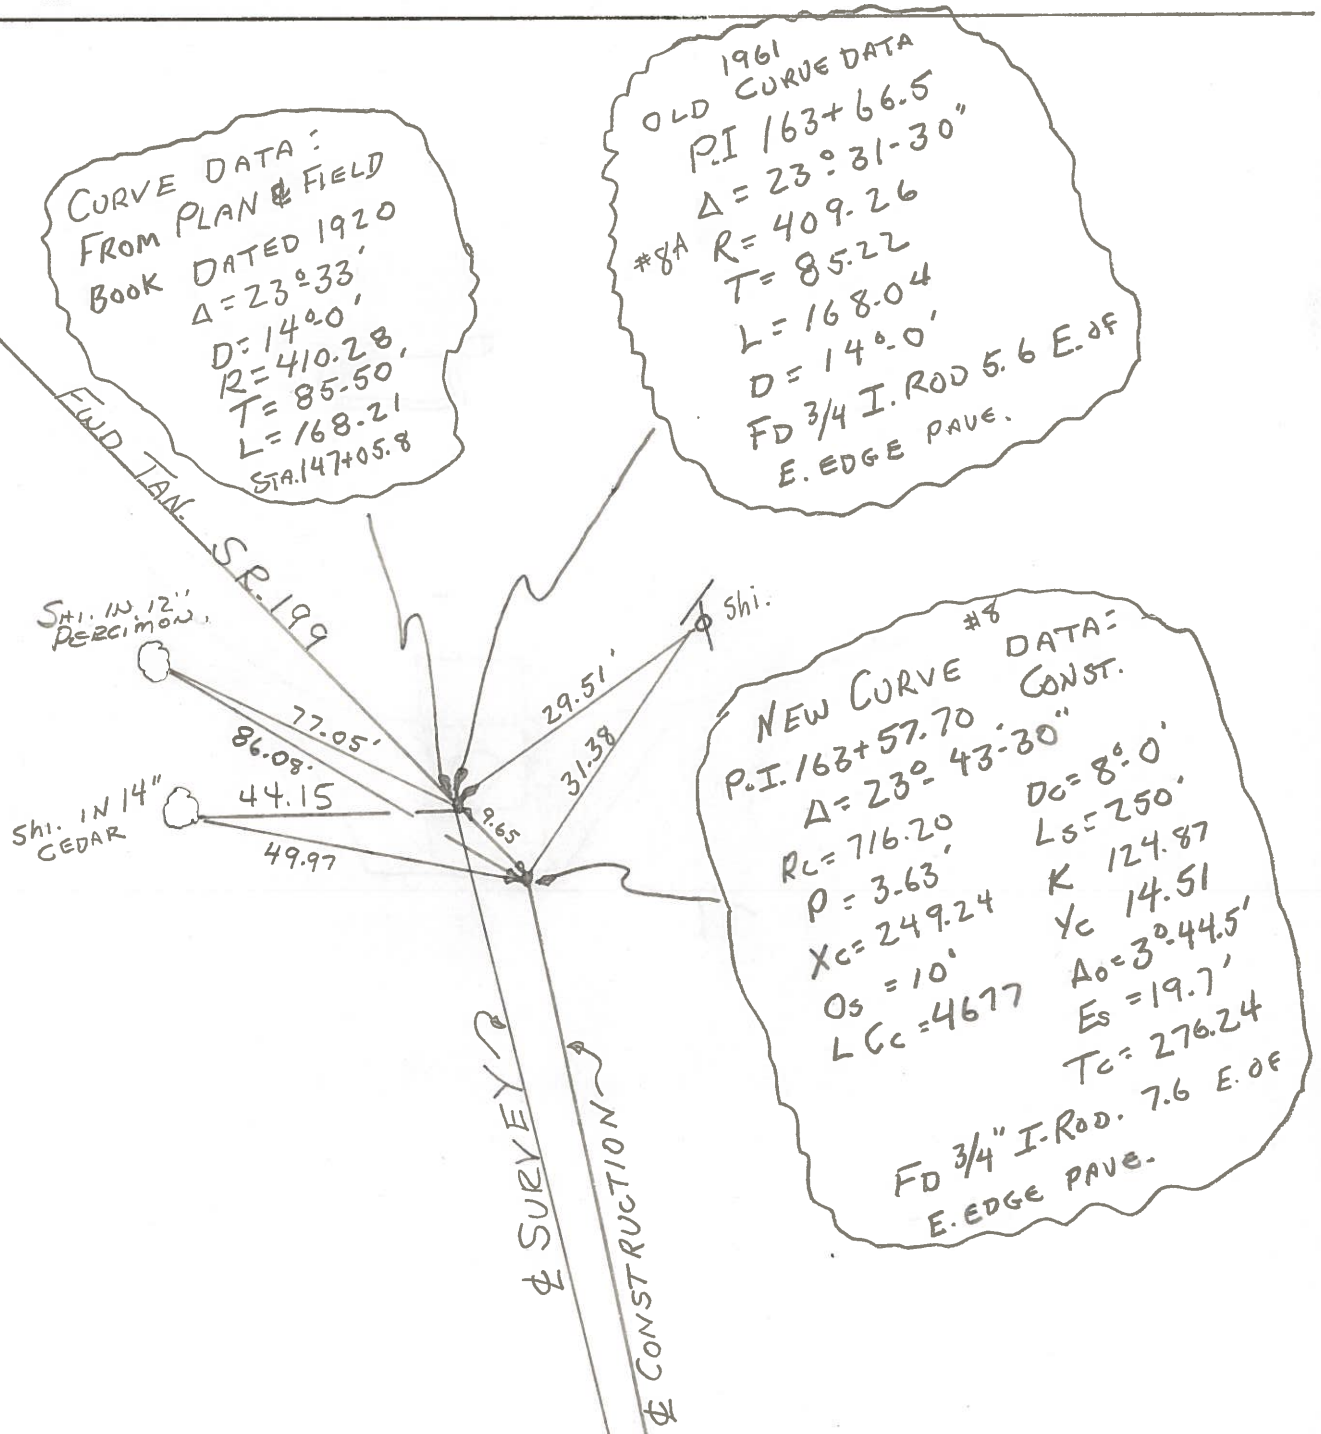

County WOOD S.R. 199

Township PERRY

Section 23

T N, R E

Personnel BURNSIDE

SMITH

MEAD

BOWERS

Date 1-19-72 (5-9-80) ^{CKD.}

Weather _____

Temp. _____

15	14
22	23




#8

4.7 R/L

CURVE DATA:
FROM PLAN & FIELD
BOOK DATED 1920
 $\Delta = 23^\circ 33'$
 $D = 140.0'$
 $R = 410.28'$
 $T = 85.50'$
 $L = 168.21'$
STA. 147+05.8

OLD 1961
CURVE DATA
P.I. 163+66.5
 $\Delta = 23^\circ 31'-30''$
#8A $R = 409.26'$
 $T = 85.22'$
 $L = 168.04'$
 $D = 140.0'$
FD 3/4 I. ROD 5.6 E. OF
E. EDGE PAVE.

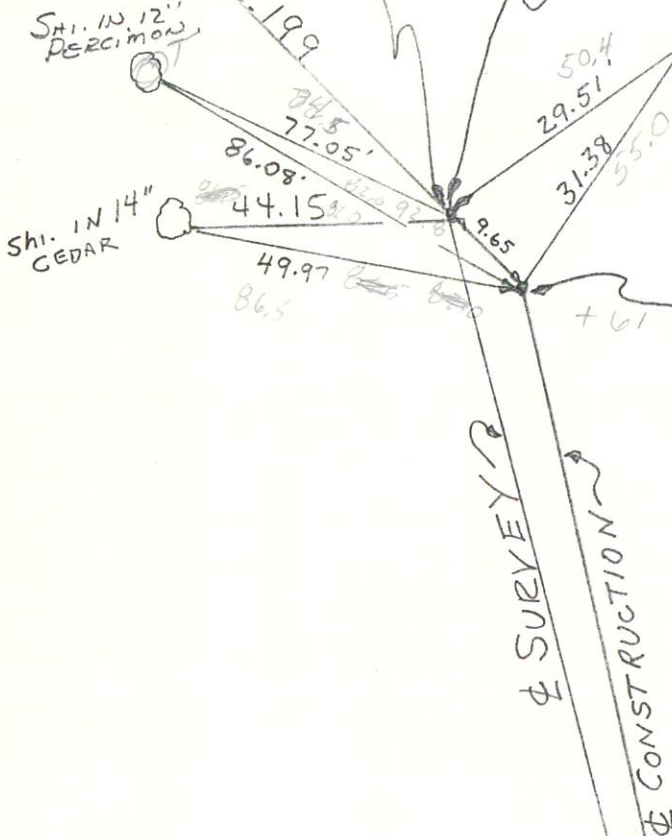

NEW CURVE DATA:
CONST.
P.I. 163+57.70
 $\Delta = 23^\circ 43'-30''$
 $R_c = 716.20'$
 $P = 3.63'$
 $X_c = 249.24'$
 $O_s = 10'$
 $L C_c = 4677'$
 $D_c = 8^\circ 0'$
 $L_s = 250'$
 $K = 124.87$
 $Y_c = 14.51'$
 $A_o = 3^\circ 44.5'$
 $E_s = 19.7'$
 $T_c = 276.24'$
FD 3/4 I. ROD. 7.6 E. OF
E. EDGE PAVE.

COPIED

SHEET NO.

OK - 5-9-80

DATE 7-19-72

PERSONNEL

TITLE

PERSONNEL

TITLE

COUNTY Wood

WEATHER Pt. Cloudy

S. R. 199

TEMP. $+40^{\circ}$

SEC.

DESCRIPTION

1ST CURVE NORTH OF BRANDEBERRY ROAD

JOB NO

LEFT

CENTER LINE

RIGHT

