

O.D.O.T. DISTRICT 2 SURVEY OFFICE (USE ONLY)

PERSONNEL _____ REFERENCE NO. 12 SHEET 17 OF 24

NOTES ROUSOS DATE 5-6-13 ROUTE SR 199

H.C. HOMAN WEATHER CLOUDY COUNTY WOOD

R.C. GABLE TEMP. 65° TOWNSHIP PERRY

SECTION 15

T 3 N R 12 E

TYPE MONUMENT P.K./WASHER


ON SURFACE - ~~BELOW~~ ON

LEFT - Q PAV'T - ~~RIGHT~~ 2.0'


- TO - EDGE PAVEMENT

S.L.M. 217+85.2

Grid: Northing: 566419.373 Easting: 1704792.590

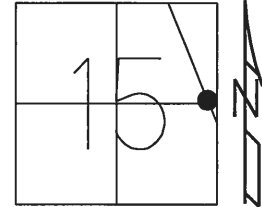

RECORD:
FD P.K.NAIL
7/11/88, CL
SET P.K./WASHER
7/30/90, CL
FD P.K./WASHER
REF12
10/13/11, MC
SET MAG/WASHER
FINREF12
4/29/14, TMR

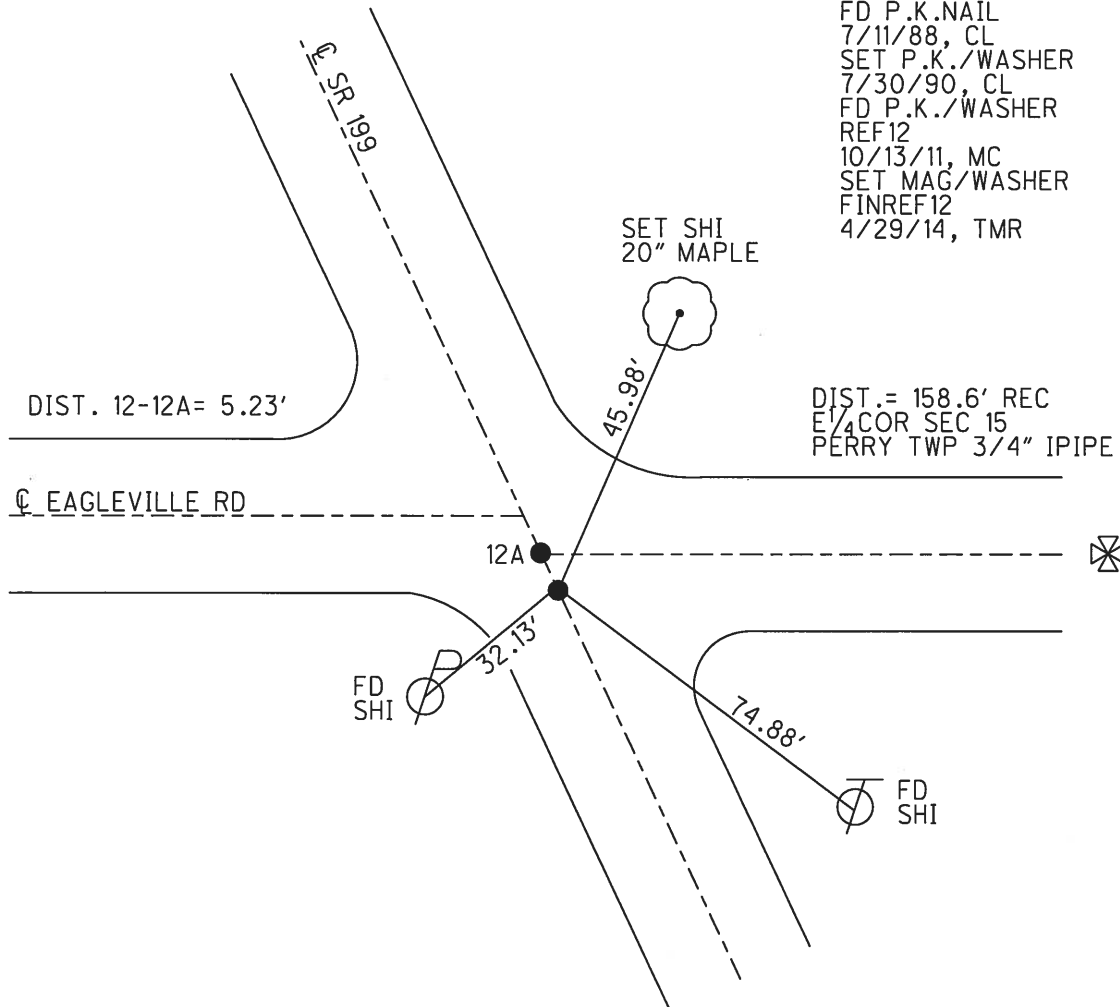

O.D.O.T. DISTRICT 2 SURVEY OFFICE

PERSONNEL

REFERENCE NO. 12

SHEET OF

NOTES LOHRKE

H.C. BARNHISEL

R.C. Reed

DATE 7-11-88

WEATHER Pt Cloudy

TEMP. +80

ROUTE SR 19

COUNTY WOOD

TOWNSHIP Perry

SECTION 15

T 3 N R 12 E

TYPE MONUMENT PK NAILS

ON SURFACE - BELOW Yes

LEFT-~~C~~ PAV'T - RIGHT Yes 2.4'


TO EDGE PAVEMENT

S.L.M. 215+98

Set P.K. & WASHERS

7-30-90


C.L.

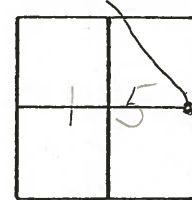

5.21 Between Pts

P.I. Sta 199+42.1
 $\Delta = 0^\circ - 37' R$

$E \frac{1}{4}$ cor. Sec 15
Perry Twp.
 $\frac{3}{4}$ " Iron Pipe

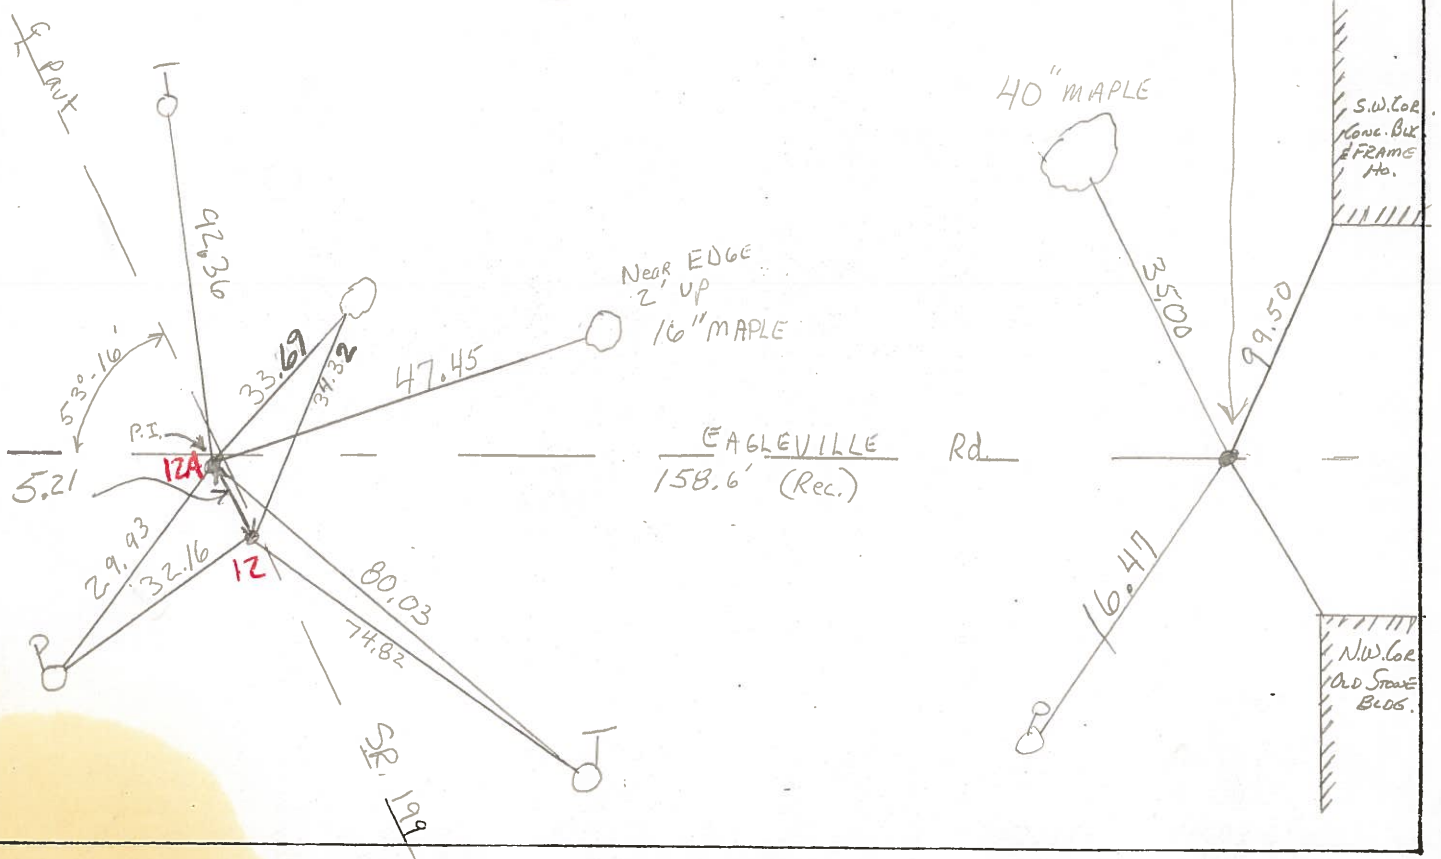


County WOOD S.R. 199Township PERRYSection 15T N, R EPersonnel BURNSIDESMITHBOWERSMEADDate 1-19-72 (^{CHKD} 5-9-80)Weather PT. CLOUDYTemp. +40°

9	10
16	15



#12

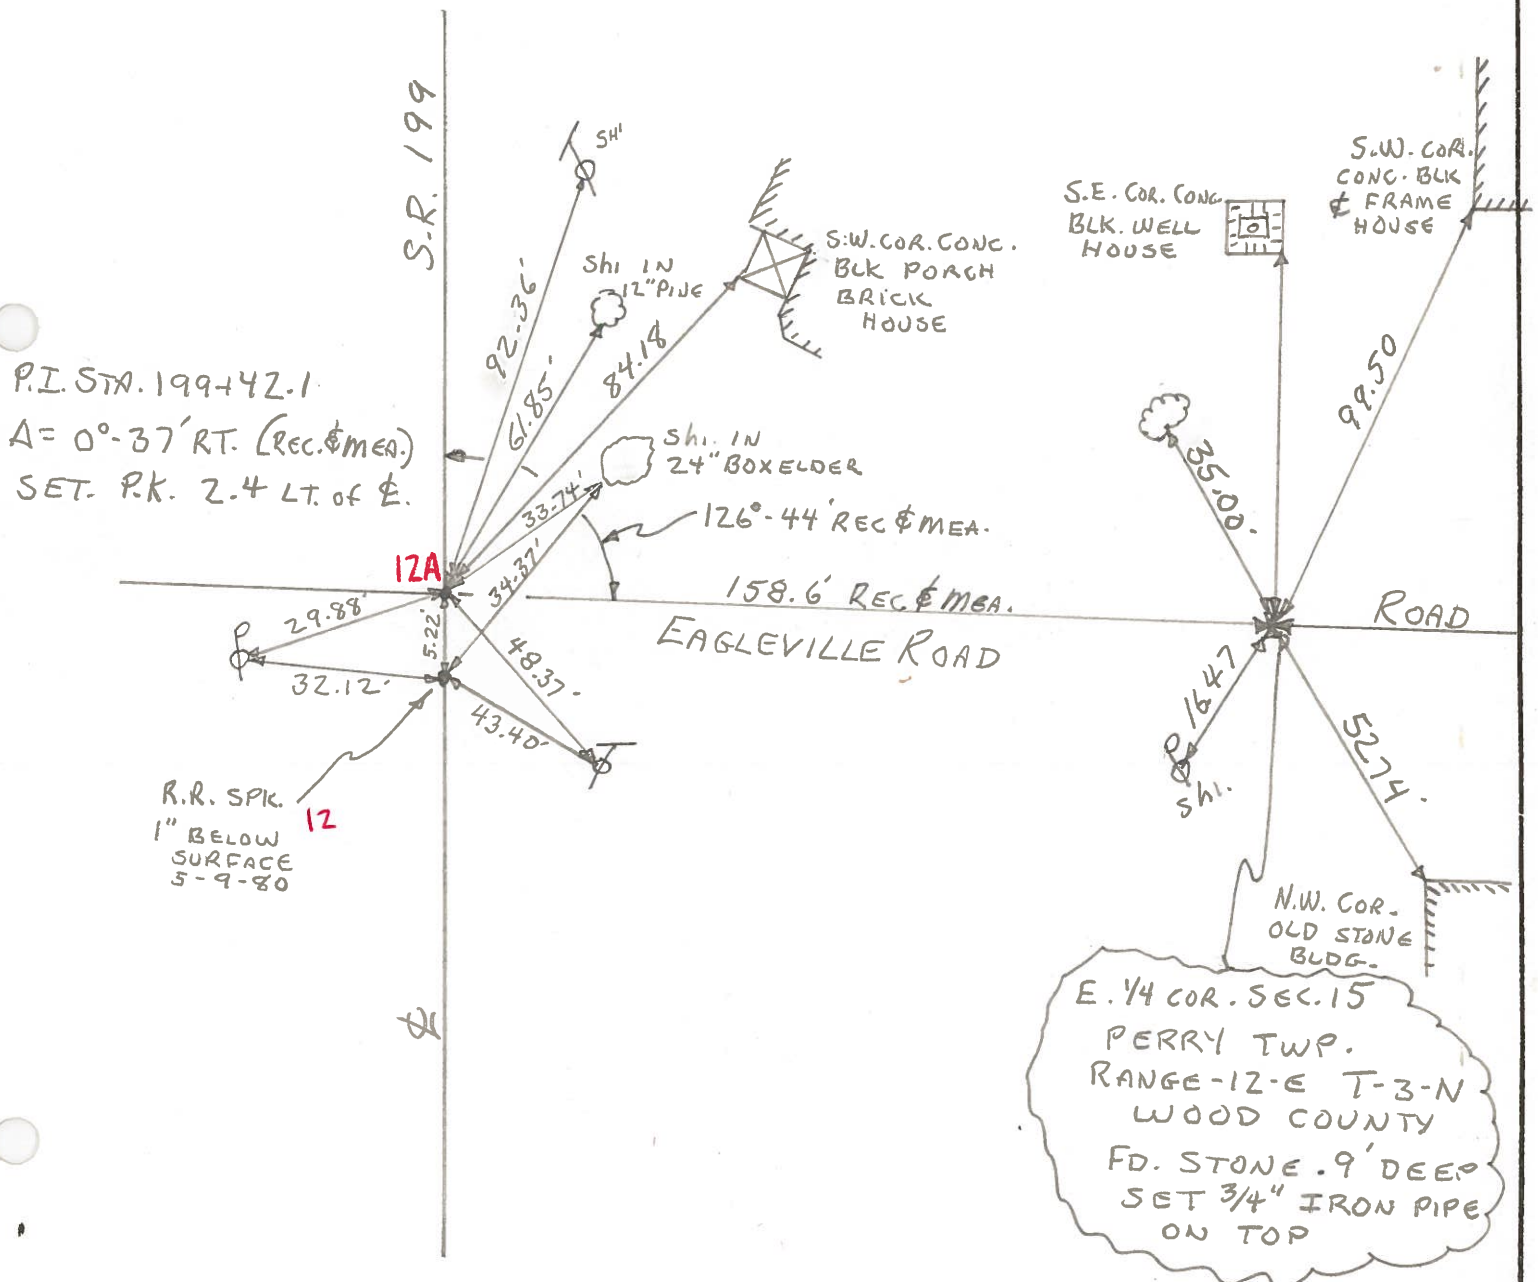

Date 1-19-72 (^{CHKD}5-9-80)

Weather PT. CLOUDY

Temp. +40°

9	10
16	15

2

BOWERS

MEAD

E. 1/4 COR. SEC. 15
PERRY TWP.
RANGE-12-E T-3-N
WOOD COUNTY
FD. STONE .9' DEEP
SET 3/4" IRON PIPE
ON TOP

COPIED

SHEET NO. 13

OK-5-9-80

DATE 1-19-72

PERSONNEL TITLE PERSONNEL TITLE

BURNSIDE

COUNTY Wood

SMITH

S. R. 199

WEATHER Pt. Cloudy

BOWERS

SEC. 15

TEMP. +40°

DESCRIPTION

EAGLEVILLE ROAD & S.R. 199

JOB NO.

LEFT

CENTER LINE

RIGHT

