


O.D.O.T. DISTRICT 2 SURVEY OFFICE (USE ONLY)


PERSONNEL _____ REFERENCE NO. 17 SHEET 22 OF 24
NOTES ROUSOS DATE 5-6-13 ROUTE SR 199
H.C. HOMAN WEATHER CLOUDY COUNTY WOOD
R.C. GABLE TEMP. 73° TOWNSHIP PERRY
SECTION 10
T 3 N R 12 E

TYPE MONUMENT P.K.NAIL
ON SURFACE - ~~BELOW~~ ON _____
LEFT - C PAV'T - ~~RIGHT~~ 0.3'
10.8 TO LT EDGE PAVEMENT
S.L.M. 275+77.04

Grid: Northing: 570677.417 Easting: 1700989.326

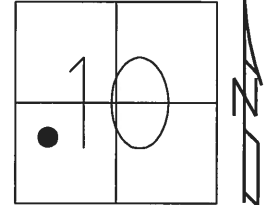

RECORD: P.O.T.
FD P.K.NAIL
7/13/88, CL
SET P.K./WASHER
7/30/90, CL
FD P.K.SHANK
REF17
10/13/11, MC
SET MAG/WASHER
FINREF17
4/29/14, TMR

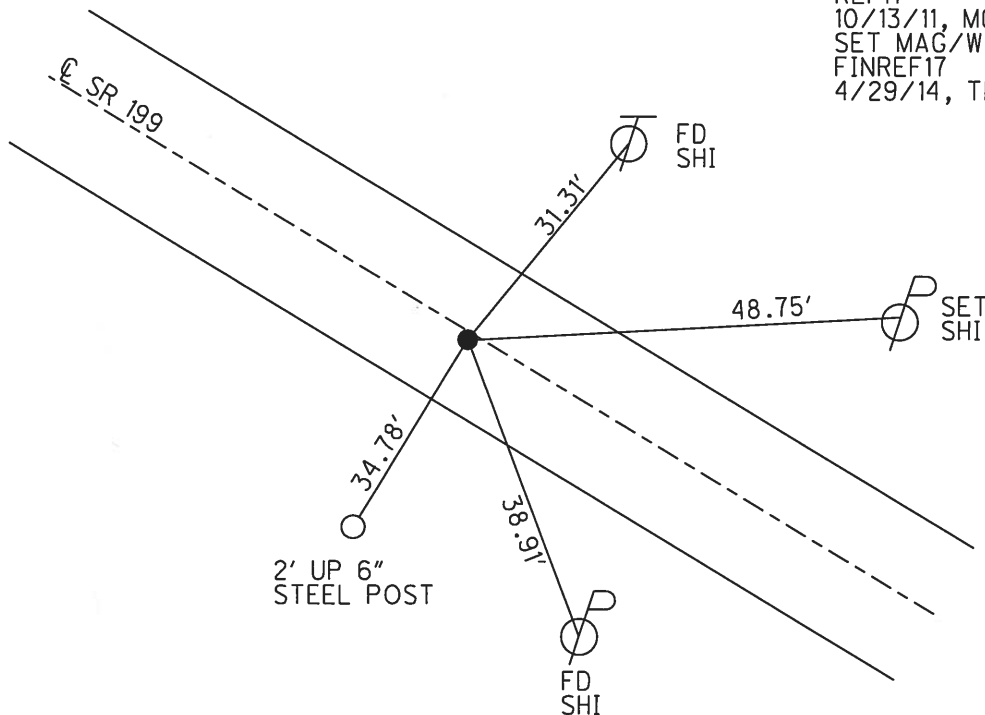

O.D.O.T. DISTRICT 2 SURVEY OFFICE

PERSONNEL

REFERENCE NO. 17

SHEET OF

NOTES LOEHRKE

H.C. BARNHISEL

R.C. Reed

DATE 7-13-88

WEATHER pt Cloudy Humid

TEMP. 79.0

ROUTE 199

COUNTY WOOD

TOWNSHIP Perry

SECTION 10

T. 3 N. R. 12 E.

TYPE MONUMENT P.K.


ON SURFACE - BELOW

LEFT - CL PAV'T. - RIGHT 0.3


10.8 TO Lt EDGE PAVEMENT

S.L.M. 273 + 87

Set P.K. / WASHER
7-30-90

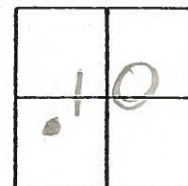

Record:
P.O.T.
Sta 39+45.5

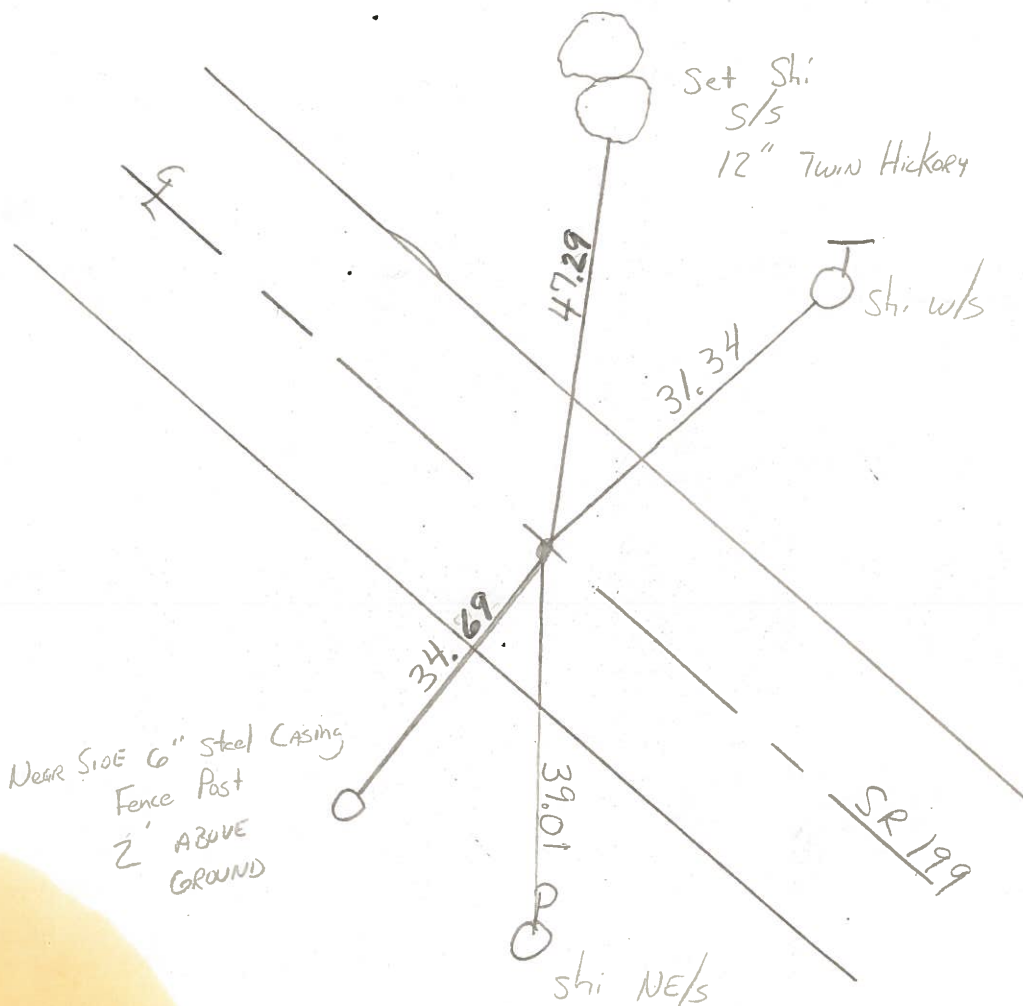

O.D.O.T. DISTRICT 2 SURVEY OFFICE

SHEET 17 OF

County WOOD S.R. 199

Township PERRY

Section 10

T N, R E

Personnel BURNSIDE

SMITH


BOWERS

MEAD

Date 11-15-71 (CKD 5-9-80)

Weather _____


Temp. _____

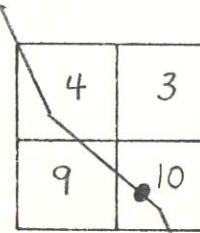

#17 273 187 10.82 EP

0.3 L F

P.O.T.
FD. R.R. SPK. ON LINE
STA 39+45.5

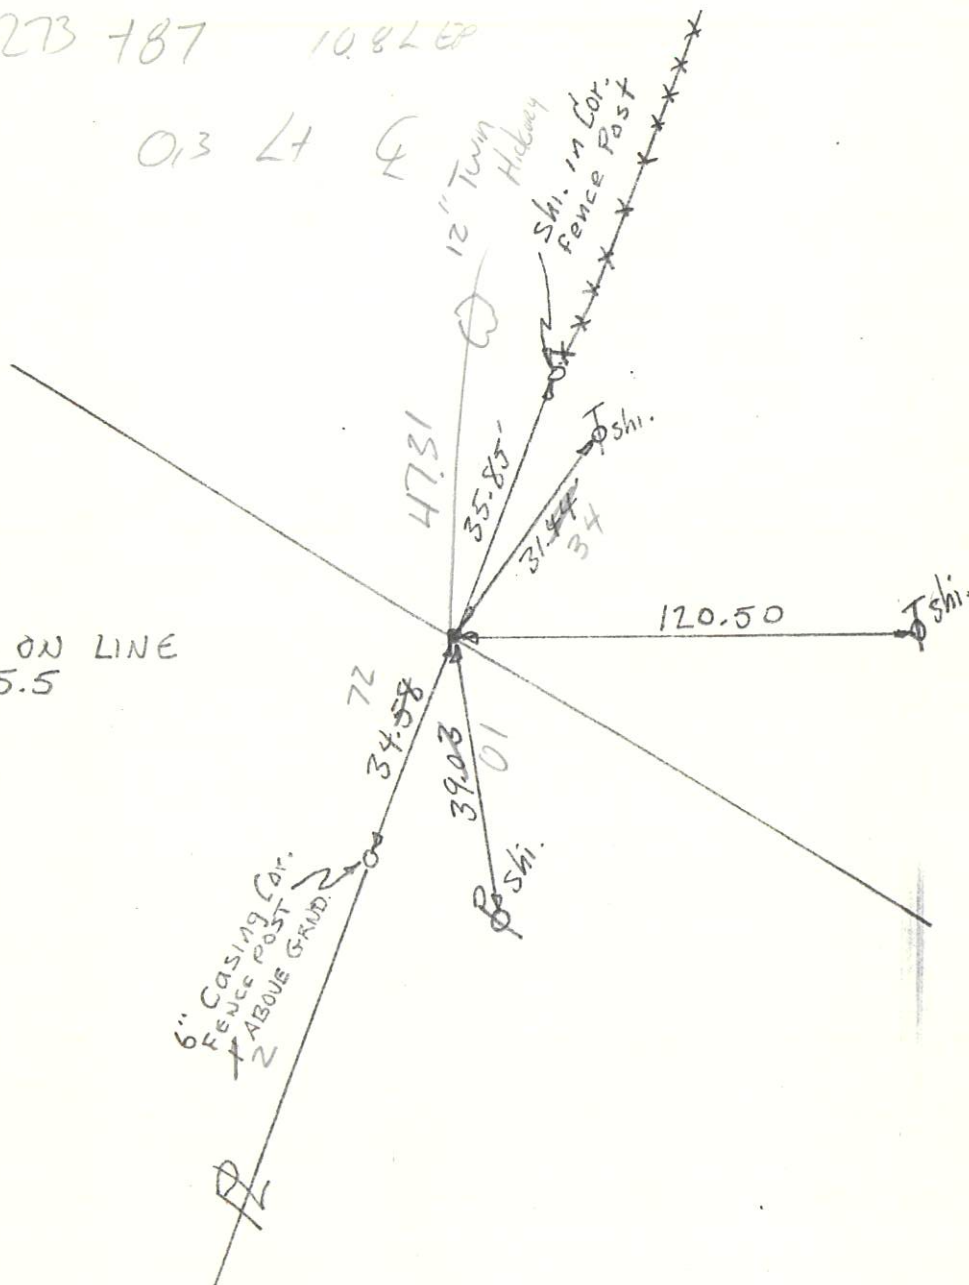

County WOOD S.R. 199Township PERRYSection 10T N, R EPersonnel BURNSIDESMITHBOWERSMEADDate 11-15-71 (^{CKD}5-9-80)

Weather _____


Temp. _____

4	3
9	10



#17

P.O.T.
FD. R.R. SPK. ON LINE
STA 39+45.5

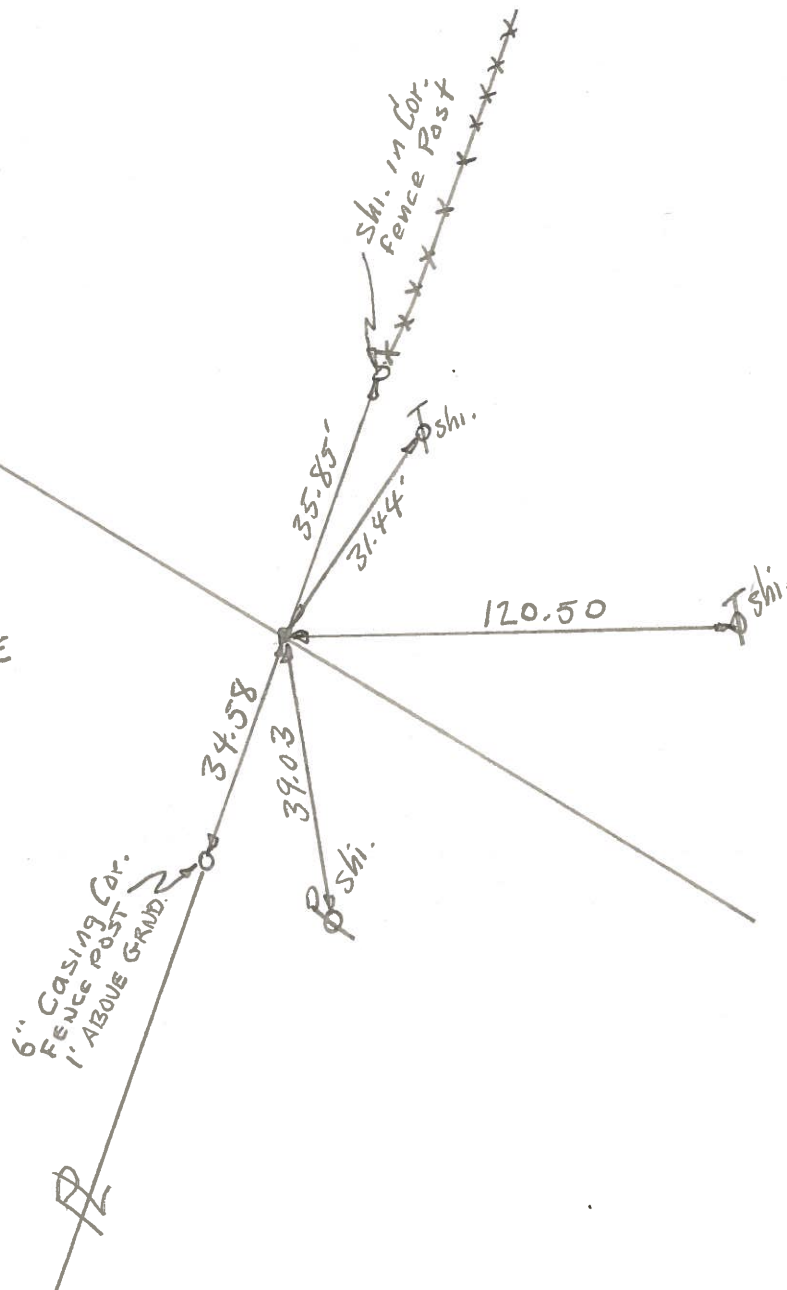

COPIED

SHEET NO. 17

PERSONNEL	TITLE	PERSONNEL	TITLE	COUNTY	DATE	WEATHER	TEMP.
BURNSIDE				Wood	11-26-71	Cloudy	+33°
BOWERS				S. R. 199			
				SEC.			

DESCRIPTION	LEFT	CENTER LINE	RIGHT	JOB NO.
-------------	------	-------------	-------	---------

