

O.D.O.T. DISTRICT 2 SURVEY OFFICE (USE ONLY)

PERSONNEL

REFERENCE NO. 32

SHEET 19 OF 46

NOTES HUSS

DATE 8/20/09

ROUTE SR 199

H.C. CANTERBURY

WEATHER SUNNY

COUNTY WOOD

R.C. BARNHISEL

TEMP. 85°

TOWNSHIP MONTGOMERY

DWG BY RHOADES PID 101286

SECTION 20

T 4 N R 12 E

TYPE MONUMENT SM.R.R.SPIKE

ON SURFACE - ~~BELOW~~ ON

OFFSET Q PAVEMENT ON LT : RT

12.1' TO RT. EDGE PAVEMENT



STATION: 525+86

HORIZ.DATUM: NAD83(2011)

GEOID: 18

GRID: NORTHING: 592932.183

EASTING: 1691017.439

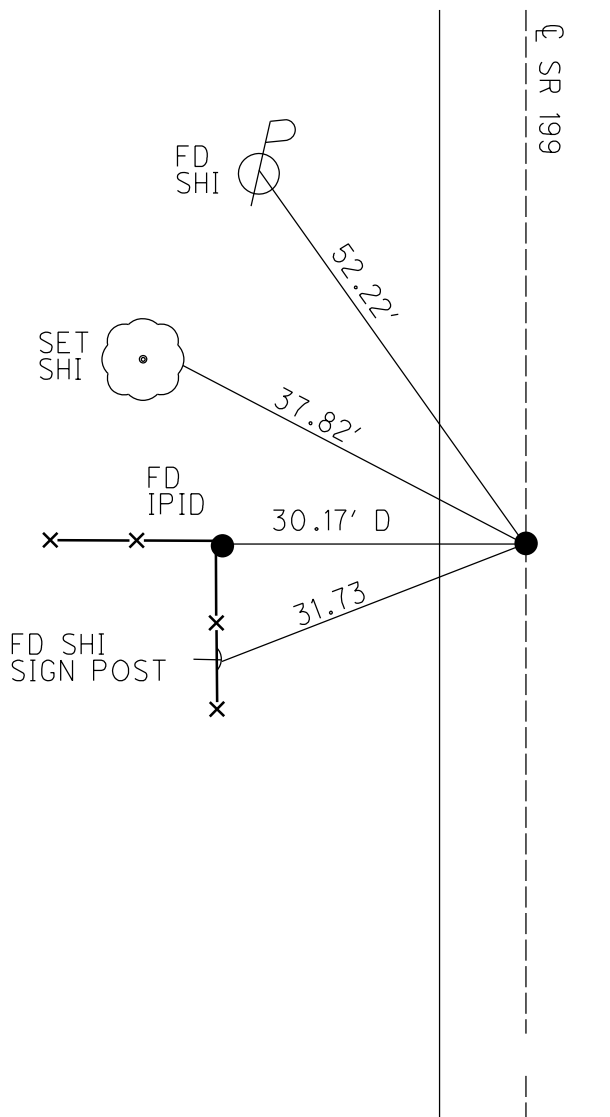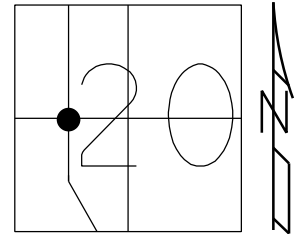

RECORD: P.I.
STA. 291+11.6
 $\Delta = 00^\circ 30'$ RT PLAN
 $\Delta = 00^\circ 02'$ LT MEAS
FD SM.R.R.SPIKE
7/14/87, MDB
SET SM.R.R.SPIKE
8/25/87, MDB
FD SM.R.R.SPIKE
3/16/06, RCN
8/20/09, MDB
SET MAG/WASHER
11/10/09, MC
FD MAG/WASHER
REF32
9/24/21, DSA
FD MAG/WASHER
CKREF32
10/31/24, TDN

O.D.O.T. DISTRICT 2 SURVEY OFFICE (USE ONLY)

PERSONNEL

REFERENCE NO. 32

SHEET 19 OF 45

NOTES HUSS

DATE 08-20-09

ROUTE SR 199

H.C. CANTERBURY

WEATHER SUNNY

COUNTY WOOD

R.C. BARNHISEL

TEMP. 85° F

TOWNSHIP MONTGOMERY

SECTION 20

T 4 N R 12 E

TYPE MONUMENT SM. RRSPK



ON SURFACE - ~~BELOW~~ ON

~~LEFT~~ - C PAV'T - ~~RIGHT~~ ON

12.1' TO RT. EDGE PAVEMENT

S.L.M. 525+86

Grid: Northing: 592921.942 Easting: 1691017.424

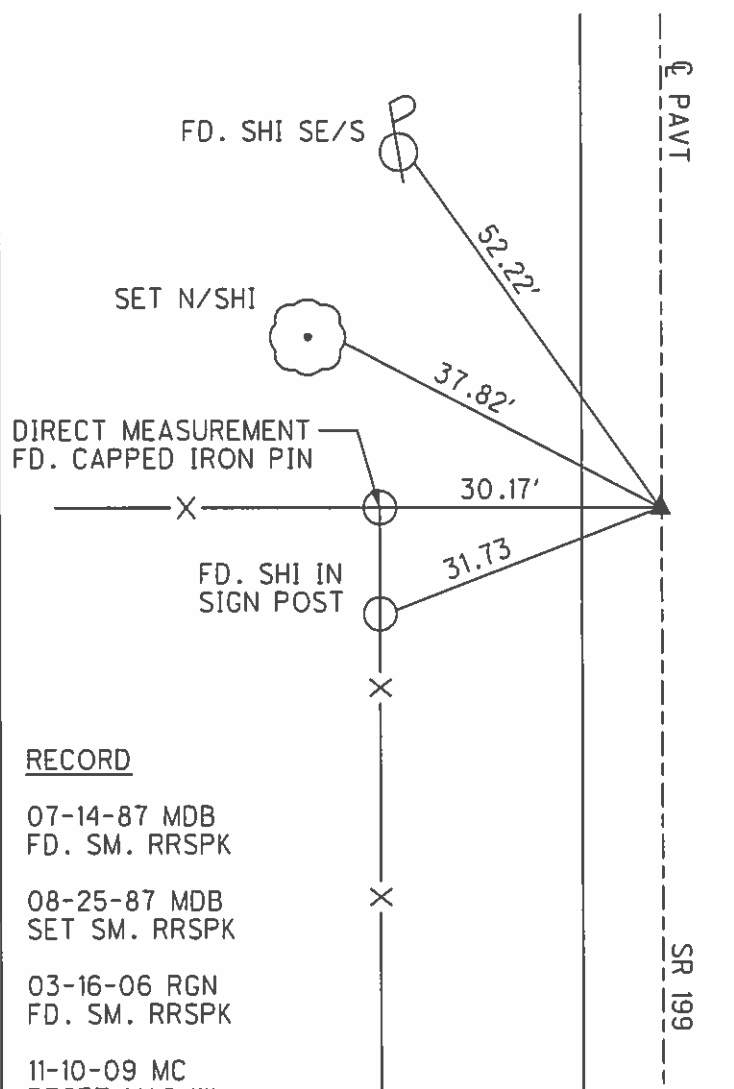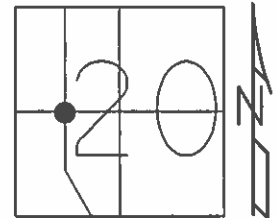

RECORD

PI STA: 291+11.6
 $\Delta = 00^{\circ}-02'$ LT. (MEAS.)
 $\Delta = 00^{\circ}-30'$ RT. (REC.)
 FD. NAIL
 SET RRSPK

RECORD

07-14-87 MDB
 FD. SM. RRSPK

08-25-87 MDB
 SET SM. RRSPK

03-16-06 RGN
 FD. SM. RRSPK

11-10-09 MC
 RESET MAG/W

NOTE:

PERRYSBURG - FOSTORIA
 S.H. (I.C.H.) NO. 273
 1926 PLAN
 SEC. "G" "H" & WEST MILGROVE
 THIS OLD PLAN SHOWS P.I.
 TO ANGLE $00^{\circ}-30'$ RT.

O.D.O.T. DISTRICT 2 SURVEY OFFICE

SHEET 32 OF

County WOOD S.R. 199

Township MONTGOMERY

Section 20

T N, R E

Personnel BURNSIDE

SMITH

HOLCOMBE

Date 11-15-71 (CHKD 5-22-78)

Weather CLEAR


Temp. +70°

17	16
20	21



#32

P.I. STA. 291+11.6
 $\Delta = 0^\circ - 02' \text{ LT. (MEAS.)}$
 $\Delta = 0^\circ - 30' \text{ RT. (REC.)}$ *
 FD. NAIL ON Φ
 SET R.R. SPK.

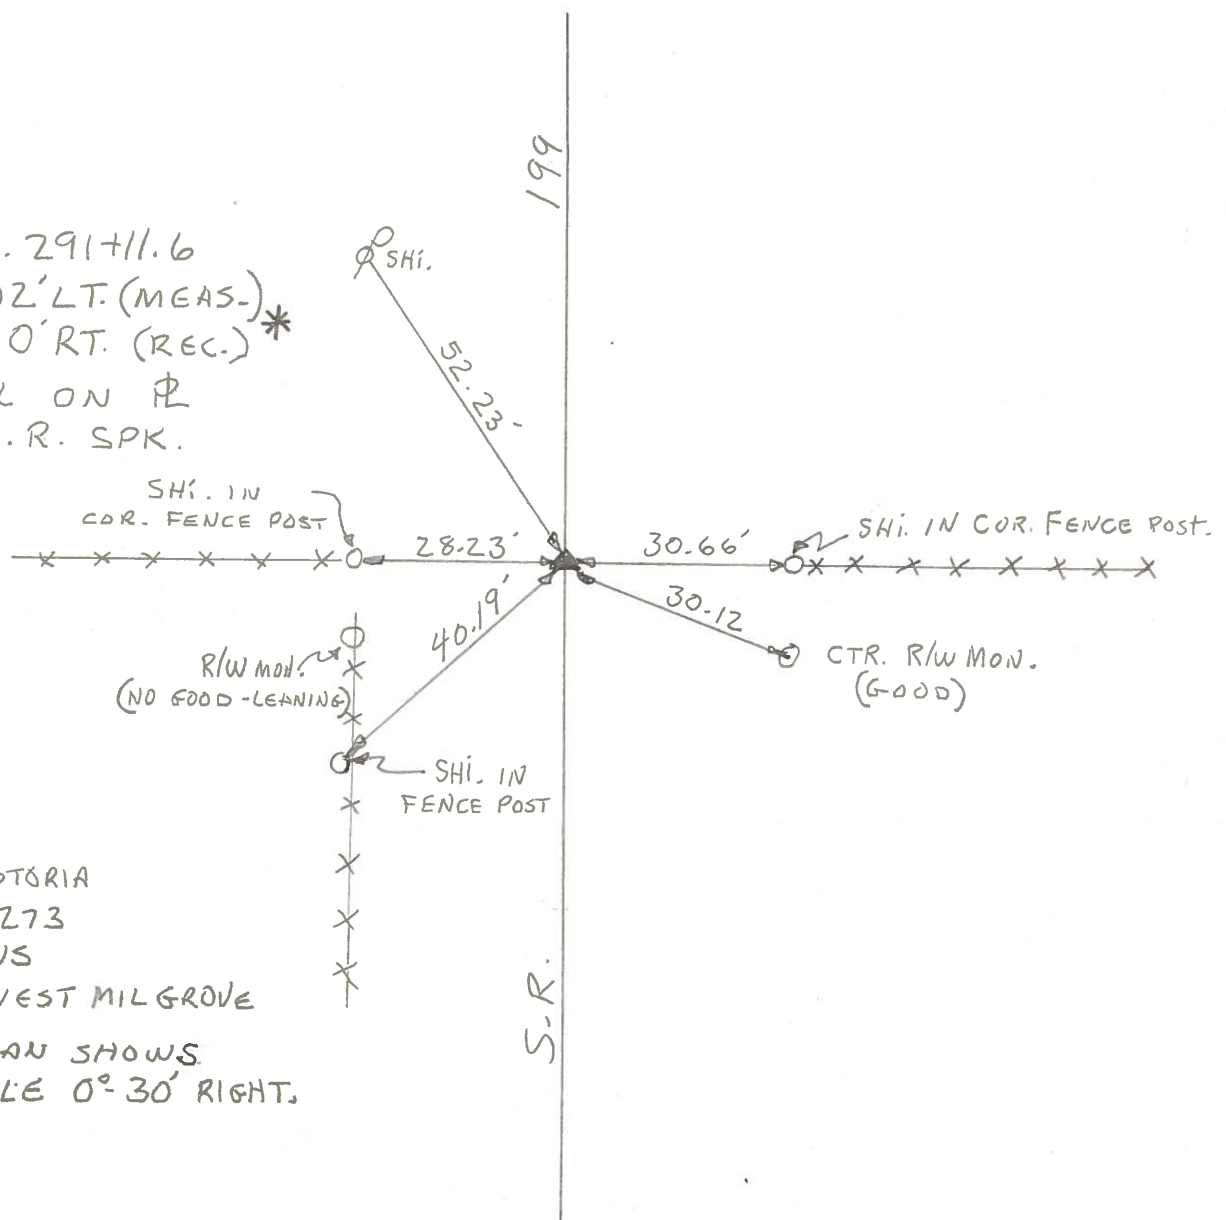

*
 NOTE:
 PERRISBURG-FOSTORIA
 S.H. (L.H.) No. 273
 1926 PLANS
 SEC. "C" "H" & WEST MILGROVE
 THIS OLD PLAN SHOWS
 P.I. TO ANGLE $0^\circ - 30' \text{ RIGHT.}$

COPIED

SHEET NO. 32

PERSONNEL TITLE PERSONNEL TITLE

BURNSIDE

COUNTY Wood

DATE 11-15-71

SMITH

S. R. 199

WEATHER CLEAR

HOLCOMBE

SEC.

TEMP. +70°

DESCRIPTION

~ P.I. 1/2 mile SOUTH OF MERMILL RD.)

JOB NO.

LEFT

CENTER LINE

RIGHT

P.I. STA. 291+11.6
 $\Delta = 0^\circ 02' \text{ LT (MEA.)}$
 $0^\circ 30' \text{ RT (REC.)}$
 FD. NAIL ON FB
 SET R.R. SPK.

PERRYSBURG - FOSTORIA.

S.H. (I.C.H.) NO. 273

1926 PLANS

SEC. G "H" & W. MILGROVE

NOTE: THIS OLD PLAN
 SHOWS P.I. TO ANGLE
 $0^\circ 30' \text{ RT.}$

GHECK

32

32

