

O.D.O.T. DISTRICT 2 SURVEY OFFICE (USE ONLY)

PERSONNEL

REFERENCE NO. 68


NOTES AUBLE
H.C. LEU
R.C. AUBLE

DATE 4/23/18
WEATHER SUNNY
TEMP. 68°

ROUTE SR 199
COUNTY WOO
TOWNSHIP PERRYSBURG
SECTION 21
T 6 N R 11 E

DWG BY BARRIERE PID 101221

TYPE MONUMENT MAG NAIL/WASHER
ON SURFACE - BELOW 1.5" DOWN
OFFSET $\oslash$ PAVEMENT ON

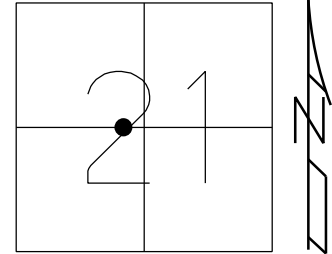


STATION: 1438+50

HORIZ.DATUM: NAD83/OCCS GEOID: 18A

GRID: NORTHING: 675159.457 EASTING: 1667453.196

LDP: NORTHING: 497198.798 EASTING: 177934.788

RECORD:
SET P.K./WASHER
8/9/02, DCH
FD P.K./WASHER
7/21/11, KPM
SET MAG/WASHER
9/9/11, RJL
REFAA68
12/16/11, MC
FD MAG NAIL
REF68
4/23/18, JLL
SET MAG/WASHER
6-4-19, JLL
FD MAG/WASH
REF68
10/23/25, TDN

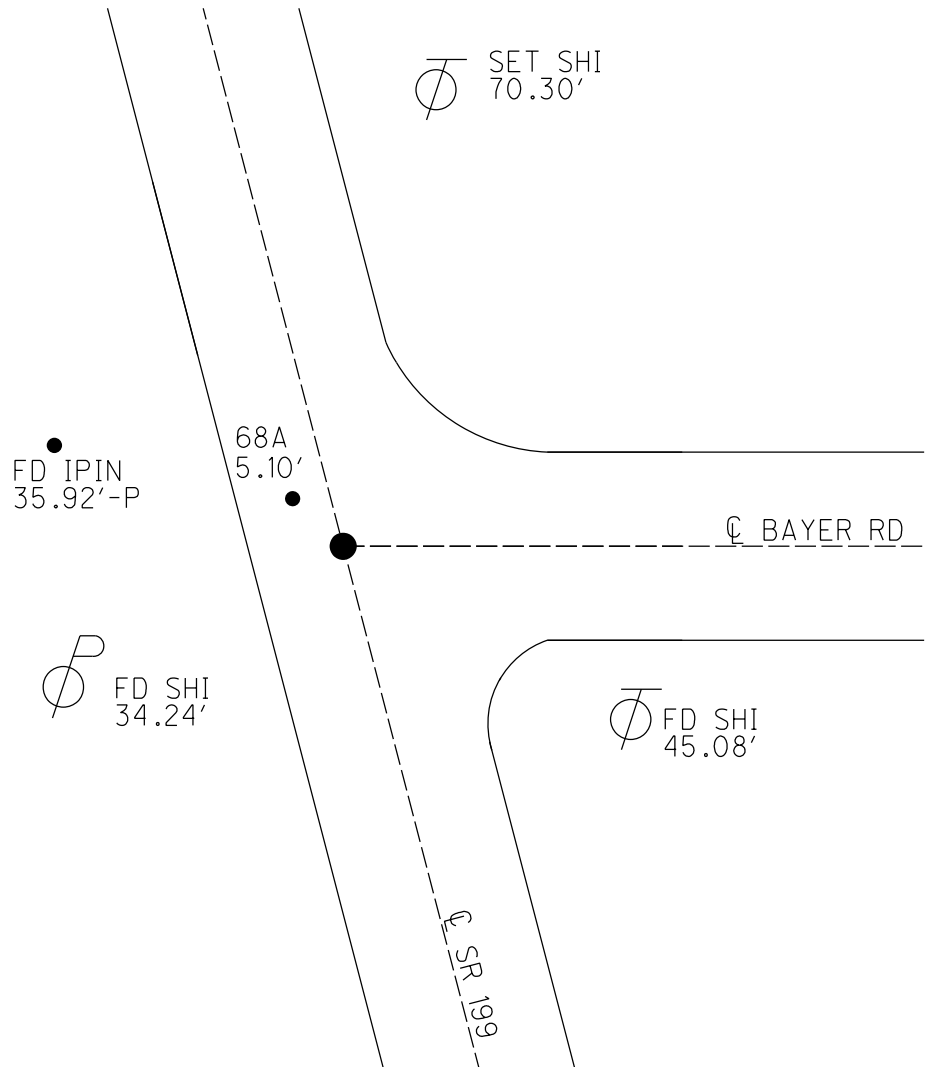

O.D.O.T. DISTRICT 2 SURVEY OFFICE (USE ONLY)

PERSONNEL

REFERENCE NO. 68

SHEET 64 OF 75

NOTES AUBLE

DATE 4-23-18

ROUTE SR 199

H.C. LEU

WEATHER SUNNY

COUNTY WOOD

R.C. AUBLE

TEMP. 68°

TOWNSHIP PERRYSBURG

SECTION 21

DWG BY AUBLE

PID 101221

T 6 N R 11 E

TYPE MONUMENT MAG/WASHER

~~ON SURFACE~~ - BELOW 1.5"

OFFSET CL PAVEMENT ON ~~LT~~ : ~~RT~~

6.2' TO LT EDGE PAVEMENT



STATION: 1438+50

HORZ.DATUM: NAD83 (2011)

GEOID: 2012A

GRID: NORTHING: 675159.468

EASTING: 1667453.176

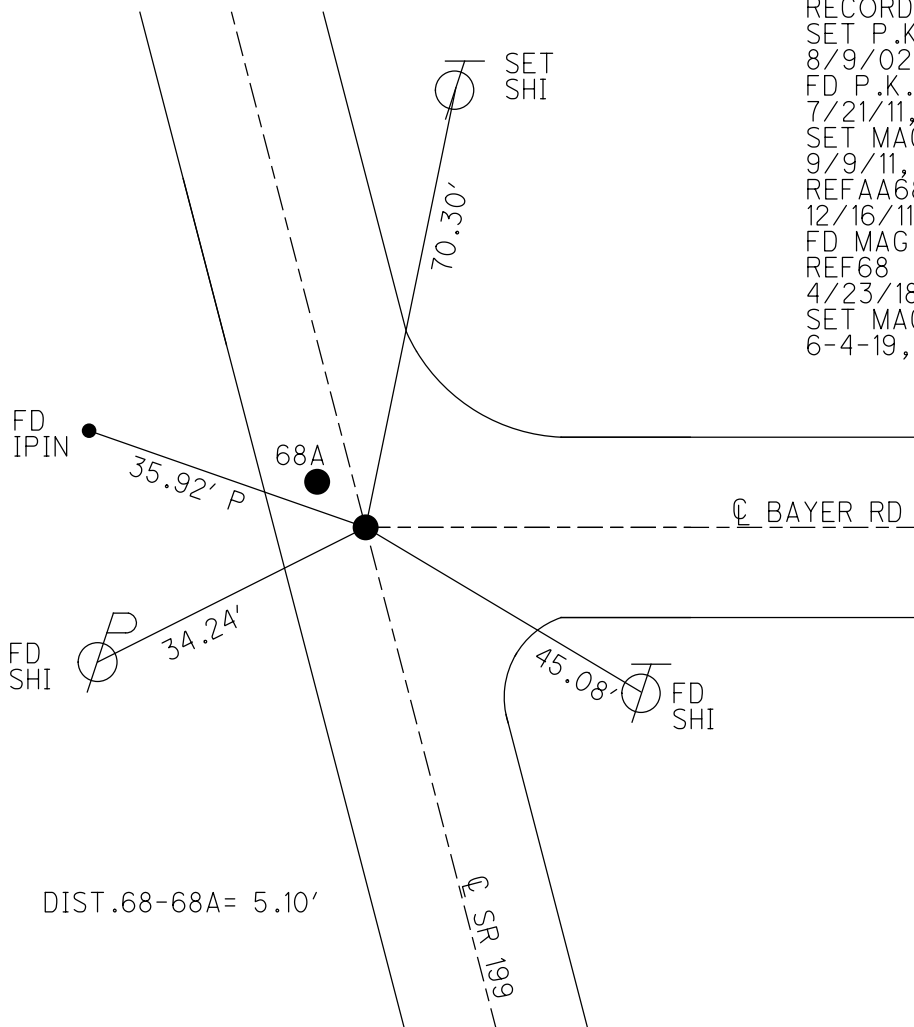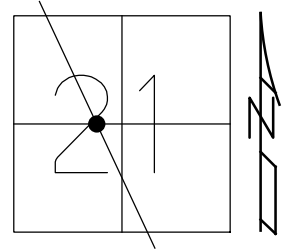


RECORD:
SET P.K./WASHER
8/9/02, DCH
FD P.K./WASHER
7/21/11, KPM
SET MAG/WASHER
9/9/11, RJL
REFAA68
12/16/11, MC
FD MAG NAIL
REF68
4/23/18, JLL
SET MAG/WASHER
6-4-19, JLL


O.D.O.T. DISTRICT 2 SURVEY OFFICE (USE ONLY)

PERSONNEL _____ REFERENCE NO. 68 SHEET 63 OF 72
 NOTES MOSER DATE 7/21/11 ROUTE SR 199
 H.C. MOSER WEATHER SUNNY COUNTY WOOD
 R.C. HARBAUGH TEMP. 85° TOWNSHIP PERRYSBURG
 SECTION 28
 T 6 N R 11 E

TYPE MONUMENT PK/WASHER
 ON SURFACE - ~~BELOW~~ ON
~~LEFT~~ - CL PAV'T - ~~RIGHT~~ ON
9.7' TO LT EDGE PAVEMENT
 S.L.M. 1438+50

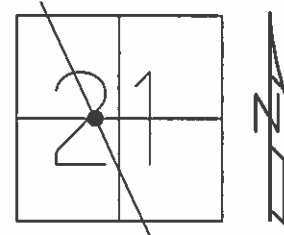

GRID: NORTHING: 675159.443 EASTING: 1667453.100

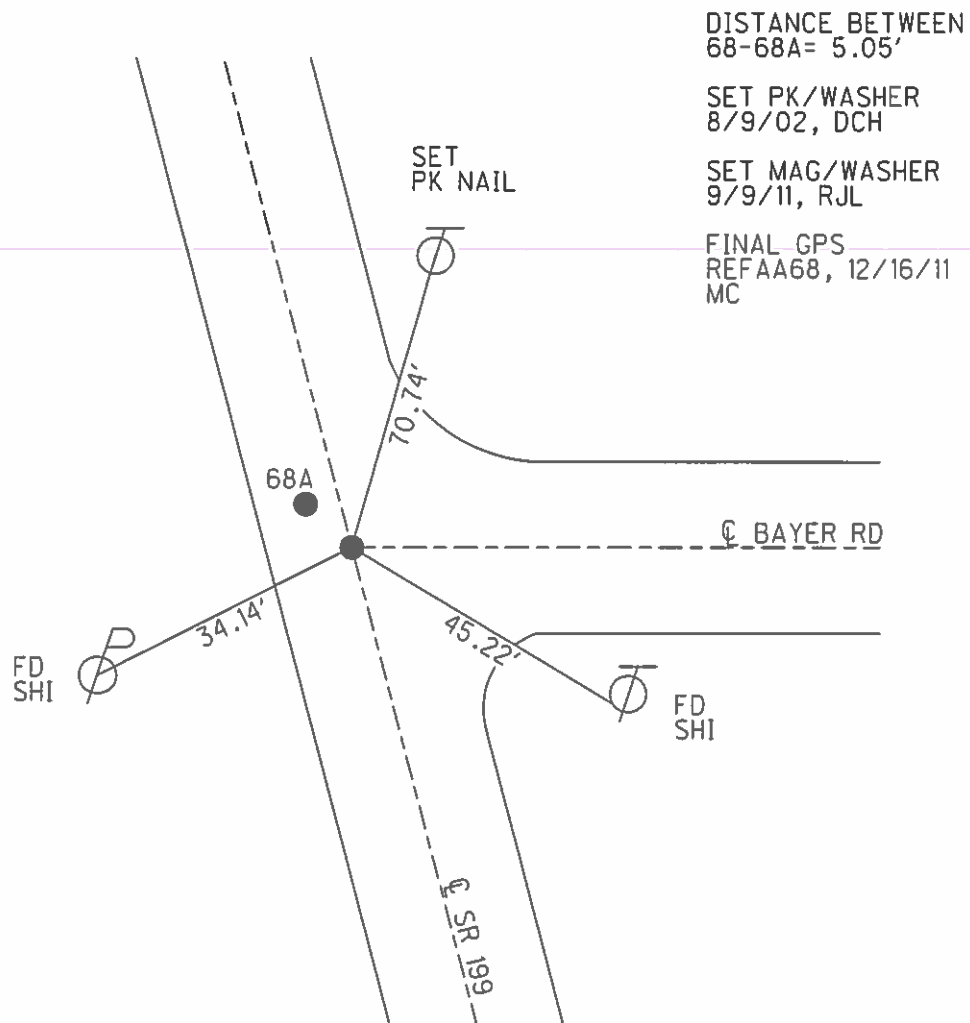

O.D.O.T. DISTRICT 2 SURVEY OFFICE

PERSONNEL

REFERENCE NO. 68

SHEET 40 OF 45

NOTES

MOSER

DATE 4-6-02

ROUTE 199

H.C.

HOMAN

WEATHER SUNNY

COUNTY WOOD

R.C.

ROUSOS

TEMP. +36°

TOWNSHIP PERRYSBURG

CANTERBURY

SECTION 28

T 6 N R 11 E


TYPE MONUMENT PK'S & WASHERS

ON SURFACE - ~~BELOW~~ YES


LEFT - Q PAV'T - RIGHT "A" ON Q'S

TO EDGE PAVEMENT

S.L.M. "A" 1438+50, "B" 1438+54

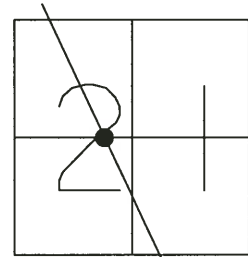

SET MAG NAILS
& WASHERS
8-09-02
D.C.H.

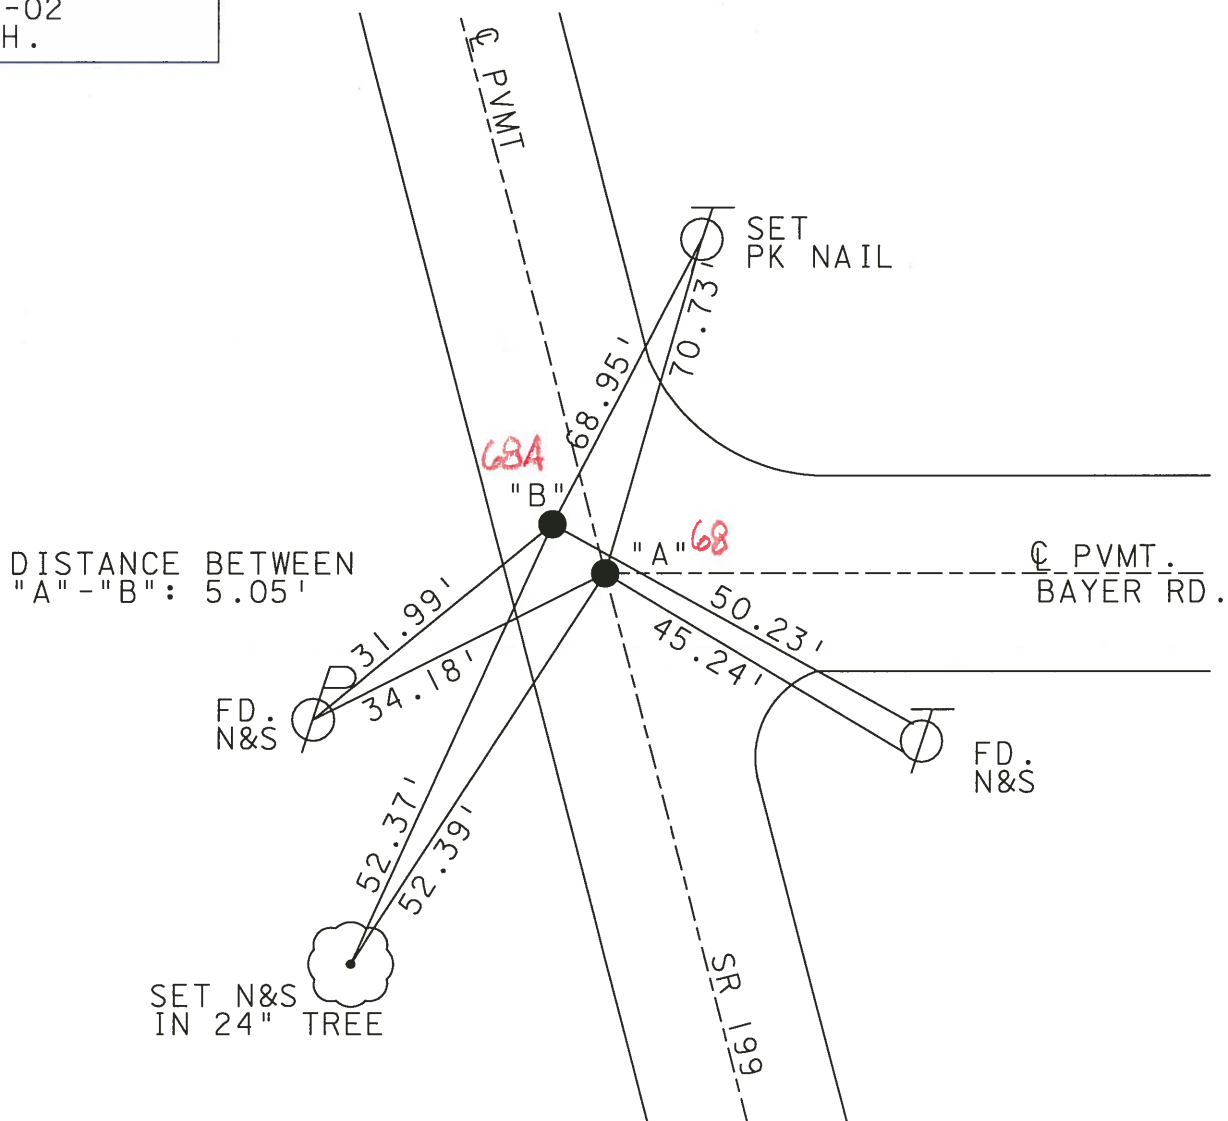

O.D.O.T. DISTRICT 2 SURVEY OFFICE

PERSONNEL

REFERENCE NO. 68

SHEET 13 OF 21

NOTES D. CURTIS

H.C. J. HOUSEHOLDER

DATE 9-8-88

ROUTE S.R. #199

R.C. _____

WEATHER MILD

COUNTY WOOD

TEMP. 75° ±

TOWNSHIP PERRYSAUR

SECTION 21

T _____ R _____


TYPE MONUMENT P.K. NAILS IN WASHERS

ON SURFACE - BELOW SURFACE

LEFT- & PAV'T. - RIGHT _____

TO _____ EDGE PAVEMENT


S.L.M. Ⓐ 1438+50, Ⓑ 1438+54

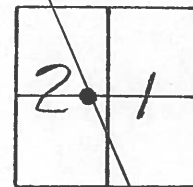

SET P.K. NAILS TO SURFACE AT
PTS. Ⓐ & Ⓑ

5-18-90

D/C.

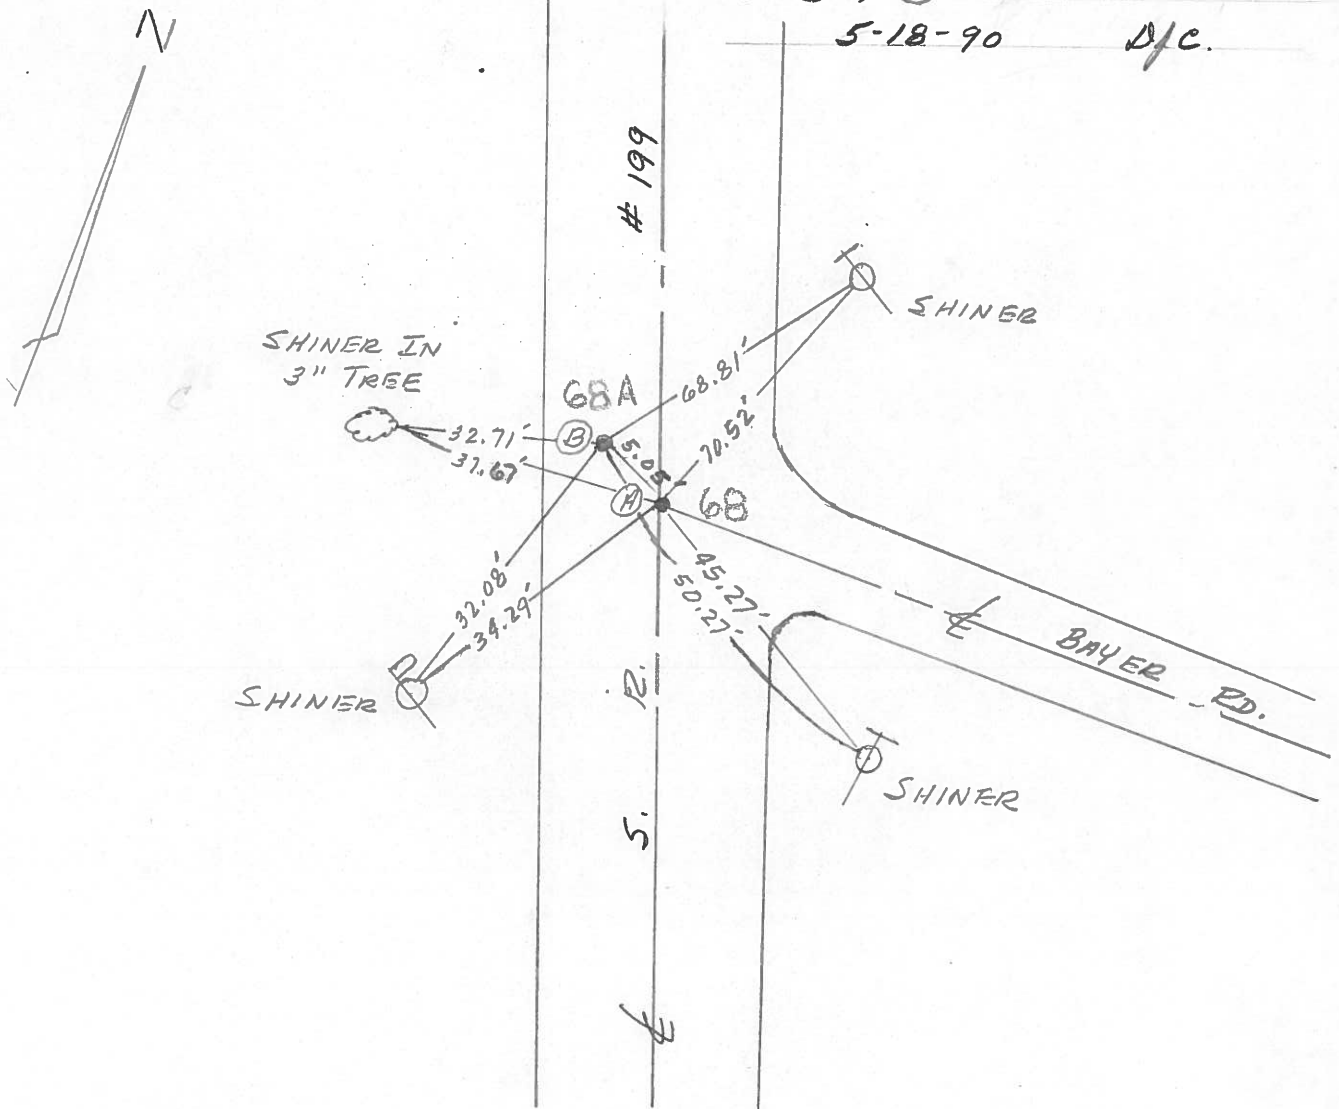

QD.O.T. DISTRICT 2 SURVEY OFFICE

SHEET _____ OF _____

County Wood S.R. 199

Township Perryburg

Section 21

T₆N, R₁E₄SR

Personnel HOFFMAN

LOEHRKE

HOUSEHOLDER


BARNHISEL

#68

Date 1-5-83

Weather Cloudy

Temp. +36°

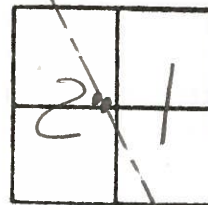


PT "A" Fd P.K. 1" Below surface
on & PAUT SR 199 & BAYER Rd.

S.L.M. 1438+45

Record: 126+81.5
P.I. STA.

SET P.K./WASHER
@ BOTH POINTS
7-22-83 M.D.B.

Set shi
E/S 3"

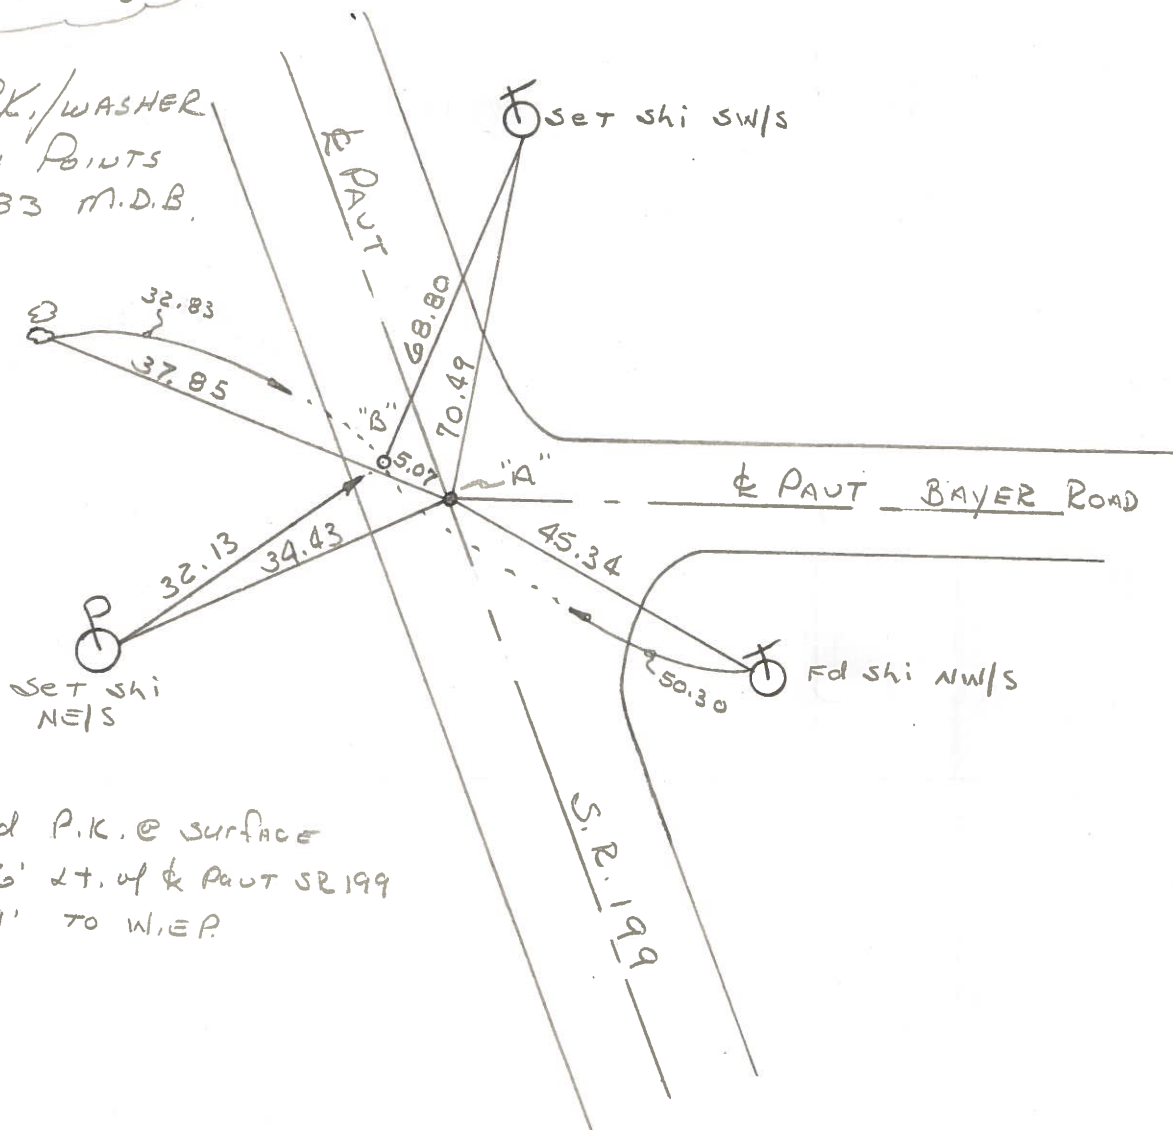

PT. "B" Fd P.K. @ surface

68A

3.6' LT. of & PAUT SR 199
5.9' TO W.E.P.

OF

Date SEPT. 23 - 1971

Weather_____

Temp. _____

17	16
20	21

4

17/16

20 21

[illegible]

FD. TWO P.K
NAILS AT SURFACE

 $126 + 81.5'$ $\pm R/W \rightarrow$

£ ROAD 7
S.R.

BAYER ROAD

PERSONNEL	TITLE	PERSONNEL	TITLE
Tomsic		Curtis	
Neuser			
Vanyo			
Granata			

COUNTY Wood DATE Sept. 23, 1971S. R. #199 WEATHER _____

SEC. _____ TEMP. _____

DESCRIPTION Ref. Mon. JOB NO. _____

LEFT

CENTER LINE

RIGHT

750' South of Roachton

68-B

COPIED

N

#199
4'±
R/W
S.R.

Road

54.59'

shiner

30.81'

"+" cut on metal breather pipe
East Ohio Gas Co.

90.08'

shiner

Found P.K. Nail at Surface
sta. 104+65.03

68

COPIED

N

#199
R/W
S.R.

Road

65.86'

shiner

67.40'

32.36'

34.67'

shiner

50.34'

45.42'

Bayer Rd,

shiner

Found 2 - P.K. Nails at Surface
sta. 126+81.5