

O.D.O.T. DISTRICT 2 SURVEY OFFICE (USE ONLY)

PERSONNEL

REFERENCE NO. 68A


NOTES AUBLE
H.C. LEU
R.C. AUBLE

DATE 4/23/18
WEATHER SUNNY
TEMP. 68°

ROUTE SR 199
COUNTY WOO
TOWNSHIP PERRYSBURG
SECTION 21
T 6 N R 11 E

DWG BY BARRIERE PID 101221

TYPE MONUMENT MAG NAIL/WASHER
ON SURFACE - BELOW ON
OFFSET $\varnothing$ PAVEMENT 3.8' RT

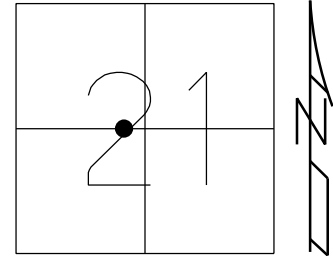


STATION: 1438+54

HORIZ.DATUM: NAD83/OCCS GEOID: 18A

GRID: NORTHING: 675160.853 EASTING: 1667448.269

LDP: NORTHING: 497200.129 EASTING: 177929.843

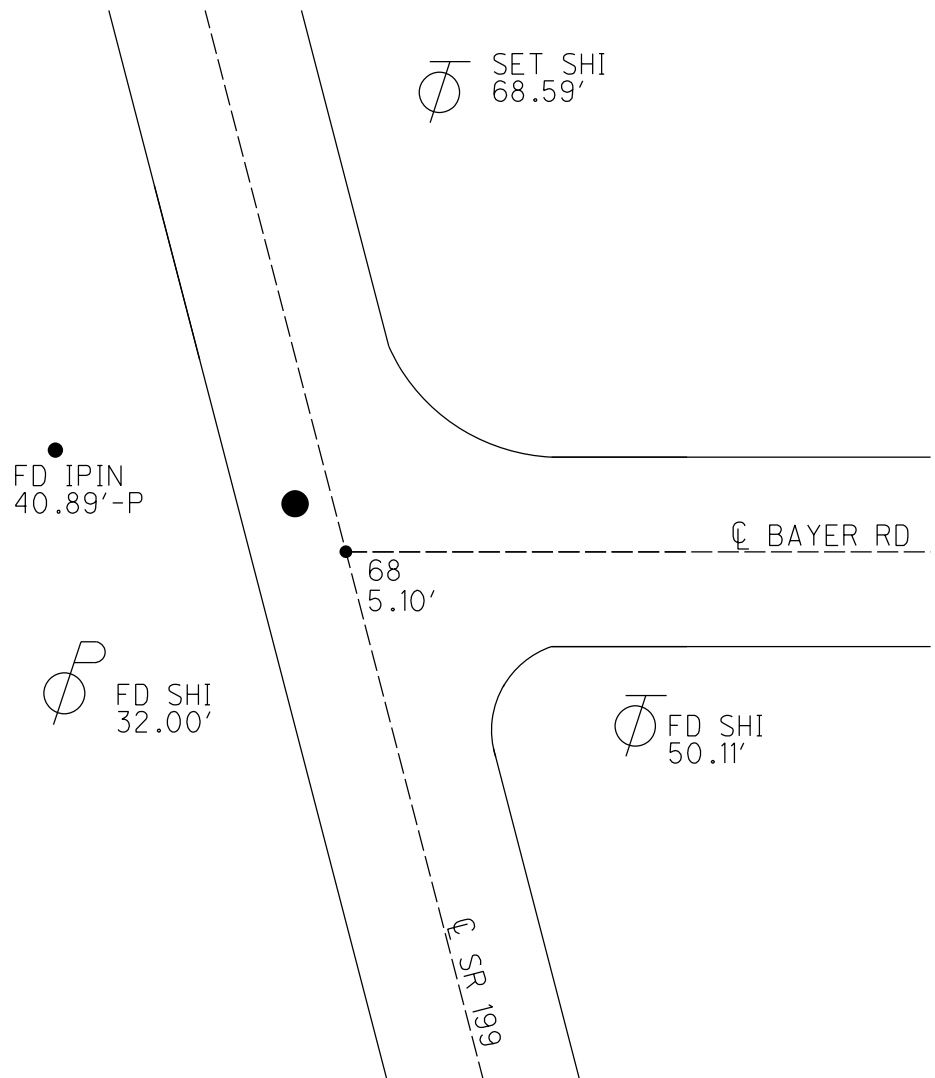

O.D.O.T. DISTRICT 2 SURVEY OFFICE (USE ONLY)

PERSONNEL

REFERENCE NO. 68 A

SHEET 65 OF 75

NOTES AUBLE

DATE 4-23-18

ROUTE SR 199

H.C. LEU

WEATHER SUNNY

COUNTY WOOD

R.C. AUBLE

TEMP. 68°

TOWNSHIP PERRYSBURG

SECTION 21

DWG BY AUBLE

PID 101221

T 6 N R 11 E

TYPE MONUMENT MAG/WASHER

ON SURFACE - ~~BELOW~~ ON

OFFSET CL PAVEMENT 3.8' ~~LT~~ : RT

6.0' TO LT EDGE PAVEMENT



STATION: 1438+54

HORIZ.DATUM: NAD83 (2011)

GEOID: 2012A

GRID: NORTHING: 675160.891

EASTING: 1667448.269

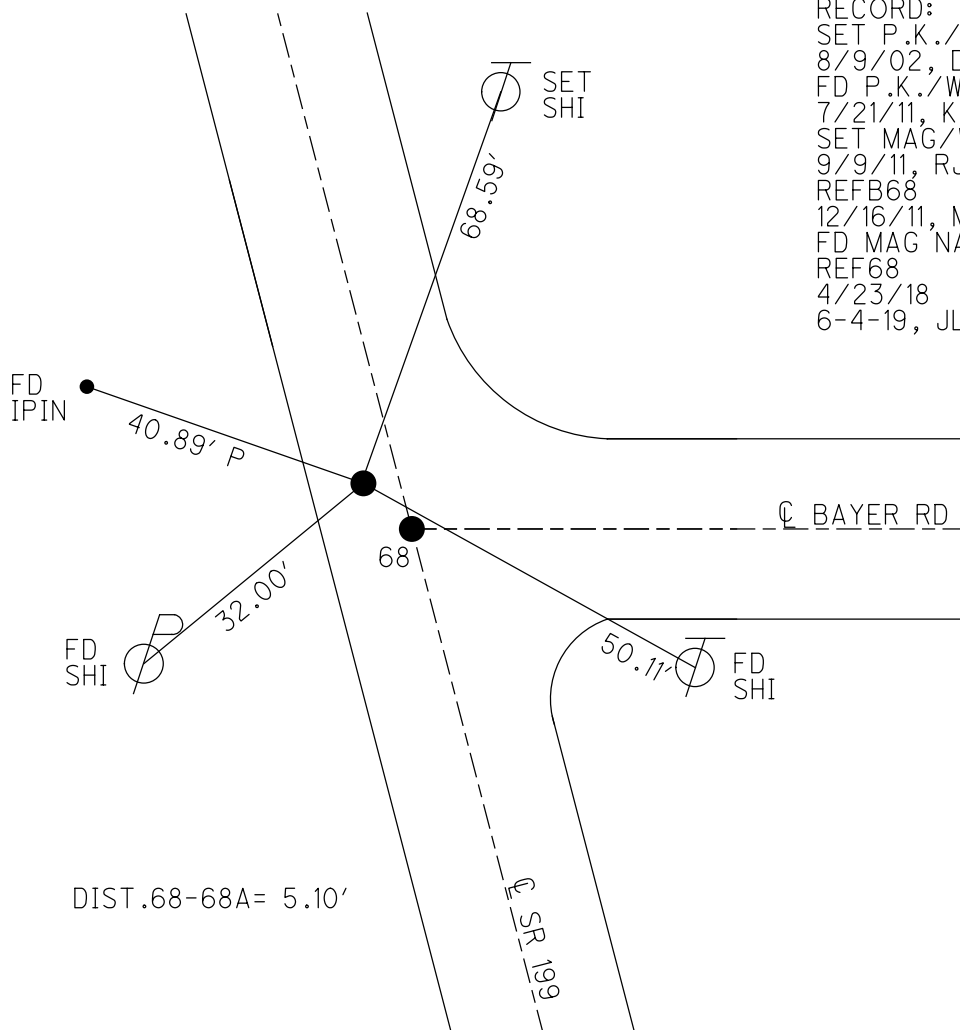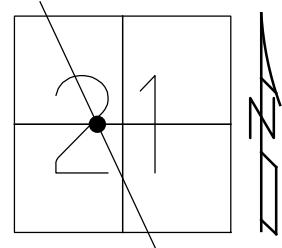

RECORD:
SET P.K./WASHER
8/9/02, DCH
FD P.K./WASHER
7/21/11, KPM
SET MAG/WASHER
9/9/11, RJL
REFB68
12/16/11, MC
FD MAG NAIL
REF68
4/23/18
6-4-19, JLL

DISTANCE BETWEEN
68-68A= 5.05'

O.D.O.T. DISTRICT 2 SURVEY OFFICE

PERSONNEL

REFERENCE NO. 68


SHEET 40 OF 45

NOTES MOSER
H.C. HOMAN
R.C. ROUSOS
CANTERBURY


DATE 4-6-02
WEATHER SUNNY
TEMP. +36°

ROUTE 199
COUNTY WOOD
TOWNSHIP PERRYSBURG
SECTION 28
T 6 N R 11 E

TYPE MONUMENT PK'S & WASHERS
ON SURFACE - ~~BELOW~~ YES
LEFT - Q PAV'T - RIGHT "A" ON Q'S
TO EDGE PAVEMENT
S.L.M. "A" 1438+50, "B" 1438+54

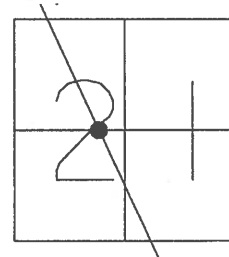

SET MAG NAILS
& WASHERS
8-09-02
D.C.H.

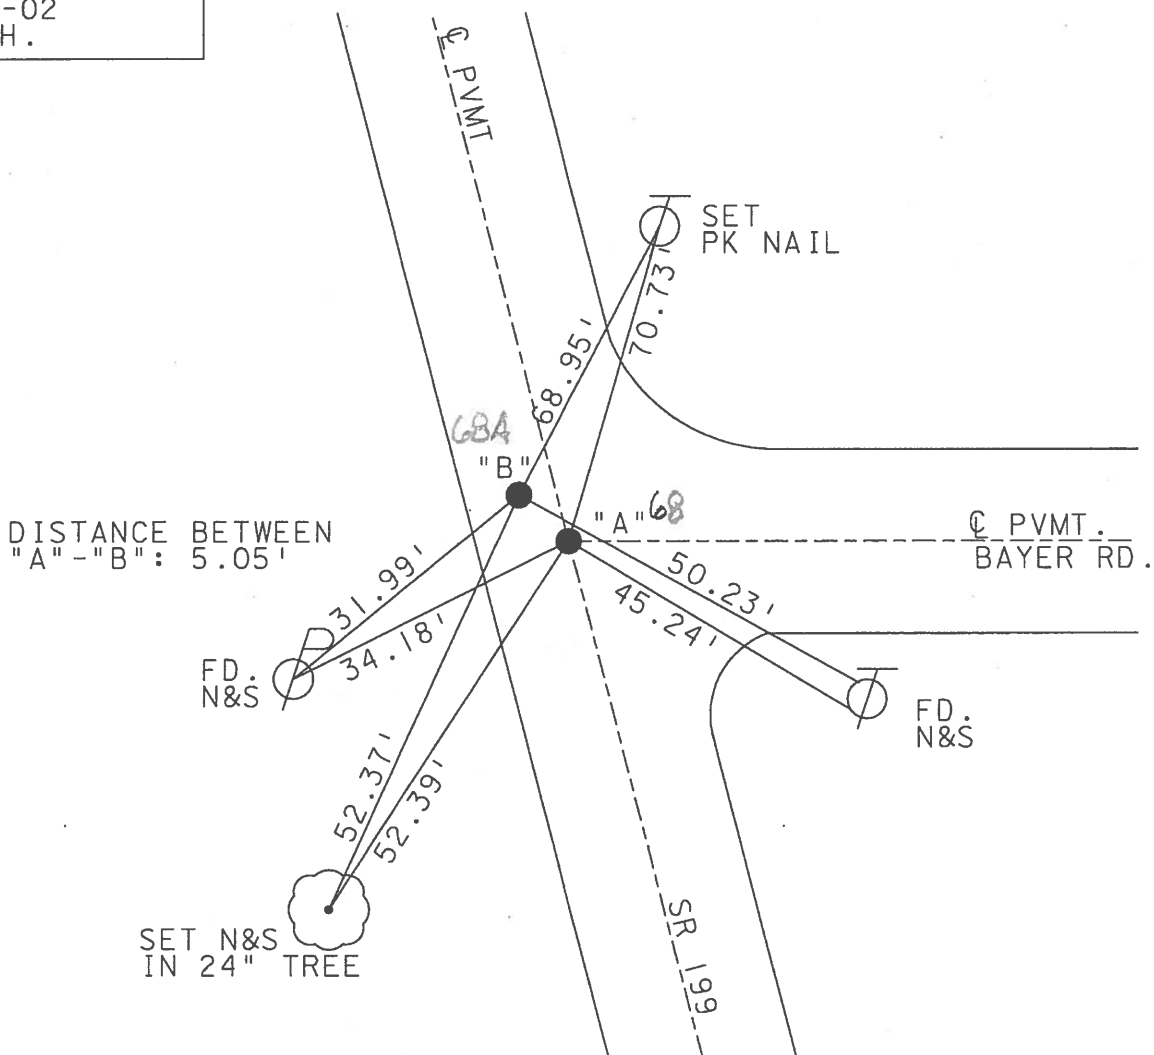

O.D.O.T. DISTRICT 2 SURVEY OFFICE

PERSONNEL

REFERENCE NO. 68

SHEET 13 OF 21

NOTES D. CURTIS

H.C. J. HOUSEHOLDER

DATE 9-8-88

ROUTE S.R. #199

R.C. _____

WEATHER MILD

COUNTY WOOD

TEMP. 75° ±

TOWNSHIP PERRYSBURG

SECTION 21

T. _____ R. _____


TYPE MONUMENT P.K. NAILS IN WASHERS

ON SURFACE - BELOW SURFACE

LEFT- & PAV'T. - RIGHT _____

TO _____ EDGE PAVEMENT


S.L.M. ① 1438+50, ② 1438+54

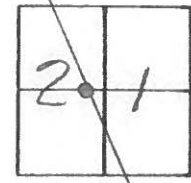

SET P.K. NAILS TO SURFACE AT
PTS. ① & ②

5-18-90

D/C.

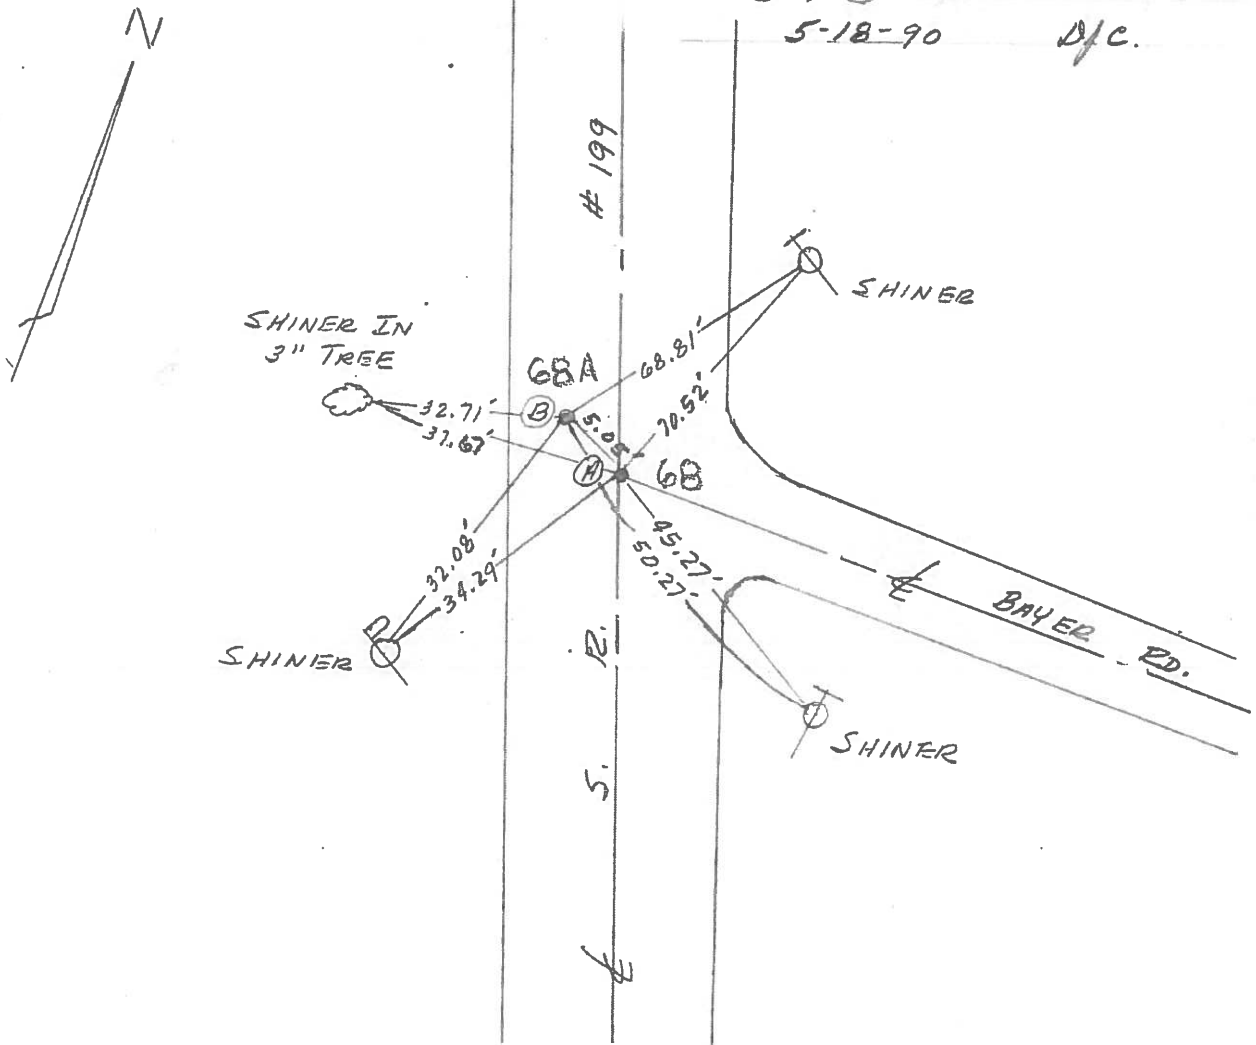

Q.D.O.T. DISTRICT 2 SURVEY OFFICE

SHEET _____ OF _____

County Wood S.R. 199

Township Perryssburg

Section 21

T₆N, R_EUSR

Personnel HOFFMAN

LOEHKE

HOUSEHOLDER


BARNHISEL

#68

Date 1-5-83

Weather Cloudy

Temp. +36°

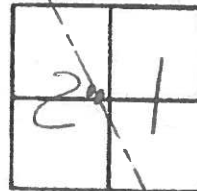

PT "A" Fd P.K. 1" Below surface
ON & PAUT SR 199 & BAYER Rd.

S.L.M. 1438+45

Record: 126+81.5
P.I. STA.

SET P.K./WASHER
@ BOTH POINTS
7-22-83 M.D.B.

Set shi
E/S 3"


Set shi SW/S

Set shi
NE/S

& PAUT BAYER ROAD

Fd shi NW/S

PT. "B" Fd P.K. @ surface
68A 3.6' Lt. up & PAUT SR 199
5.9' TO W.E.P.

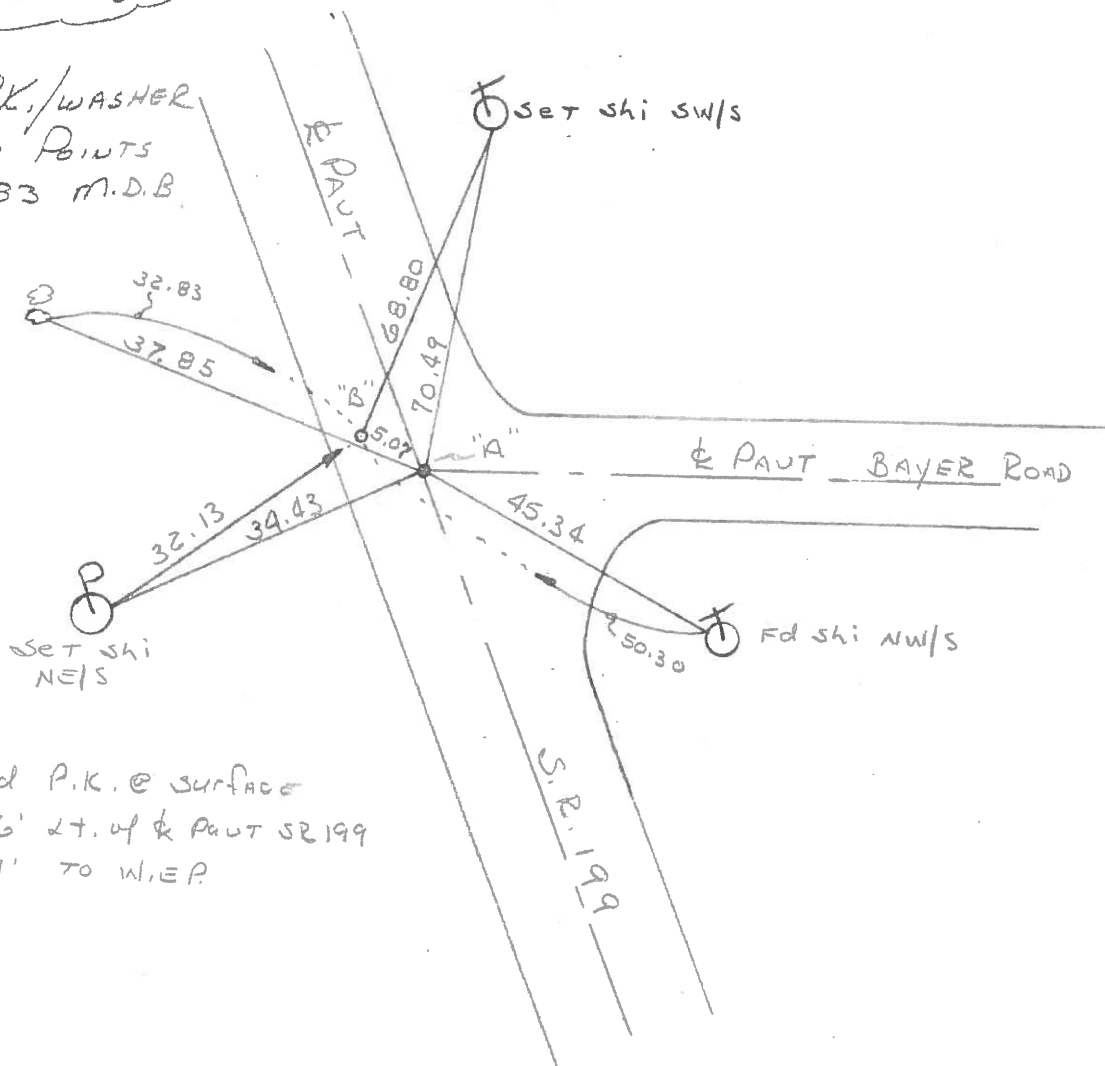

O.D.O.T. DISTRICT 2 SURVEY OFFICE

SHEET

OF

County WOOD S.R. 199

Township PERRYSBURG

Section 21

T N, R E

Personnel TOM SIEG

NEUSER

GRANATA

VANYO

Date FEB. 28 - 1972


Weather

Temp.

17	16
20	21




68-A

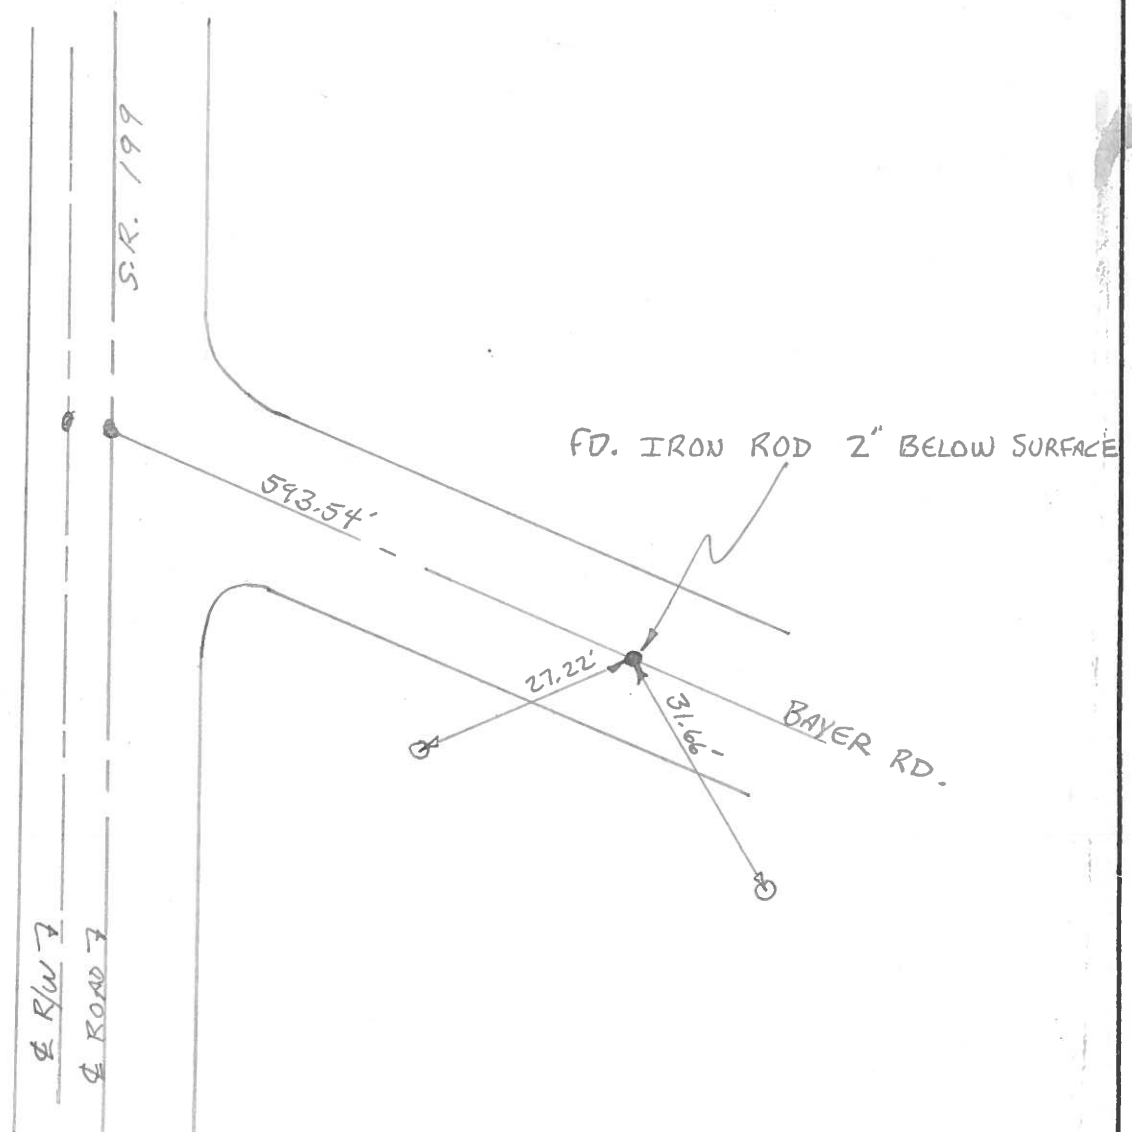

PERSONNEL	TITLE	PERSONNEL	TITLE	COUNTY	DATE	WEATHER	TEMP.
Tomsic				WOOD	FEB. 28-1972		
Neuser				199			
Vango							
Granata							

DESCRIPTION	LEFT	CENTER LINE	RIGHT	JOB NO.
-------------	------	-------------	-------	---------

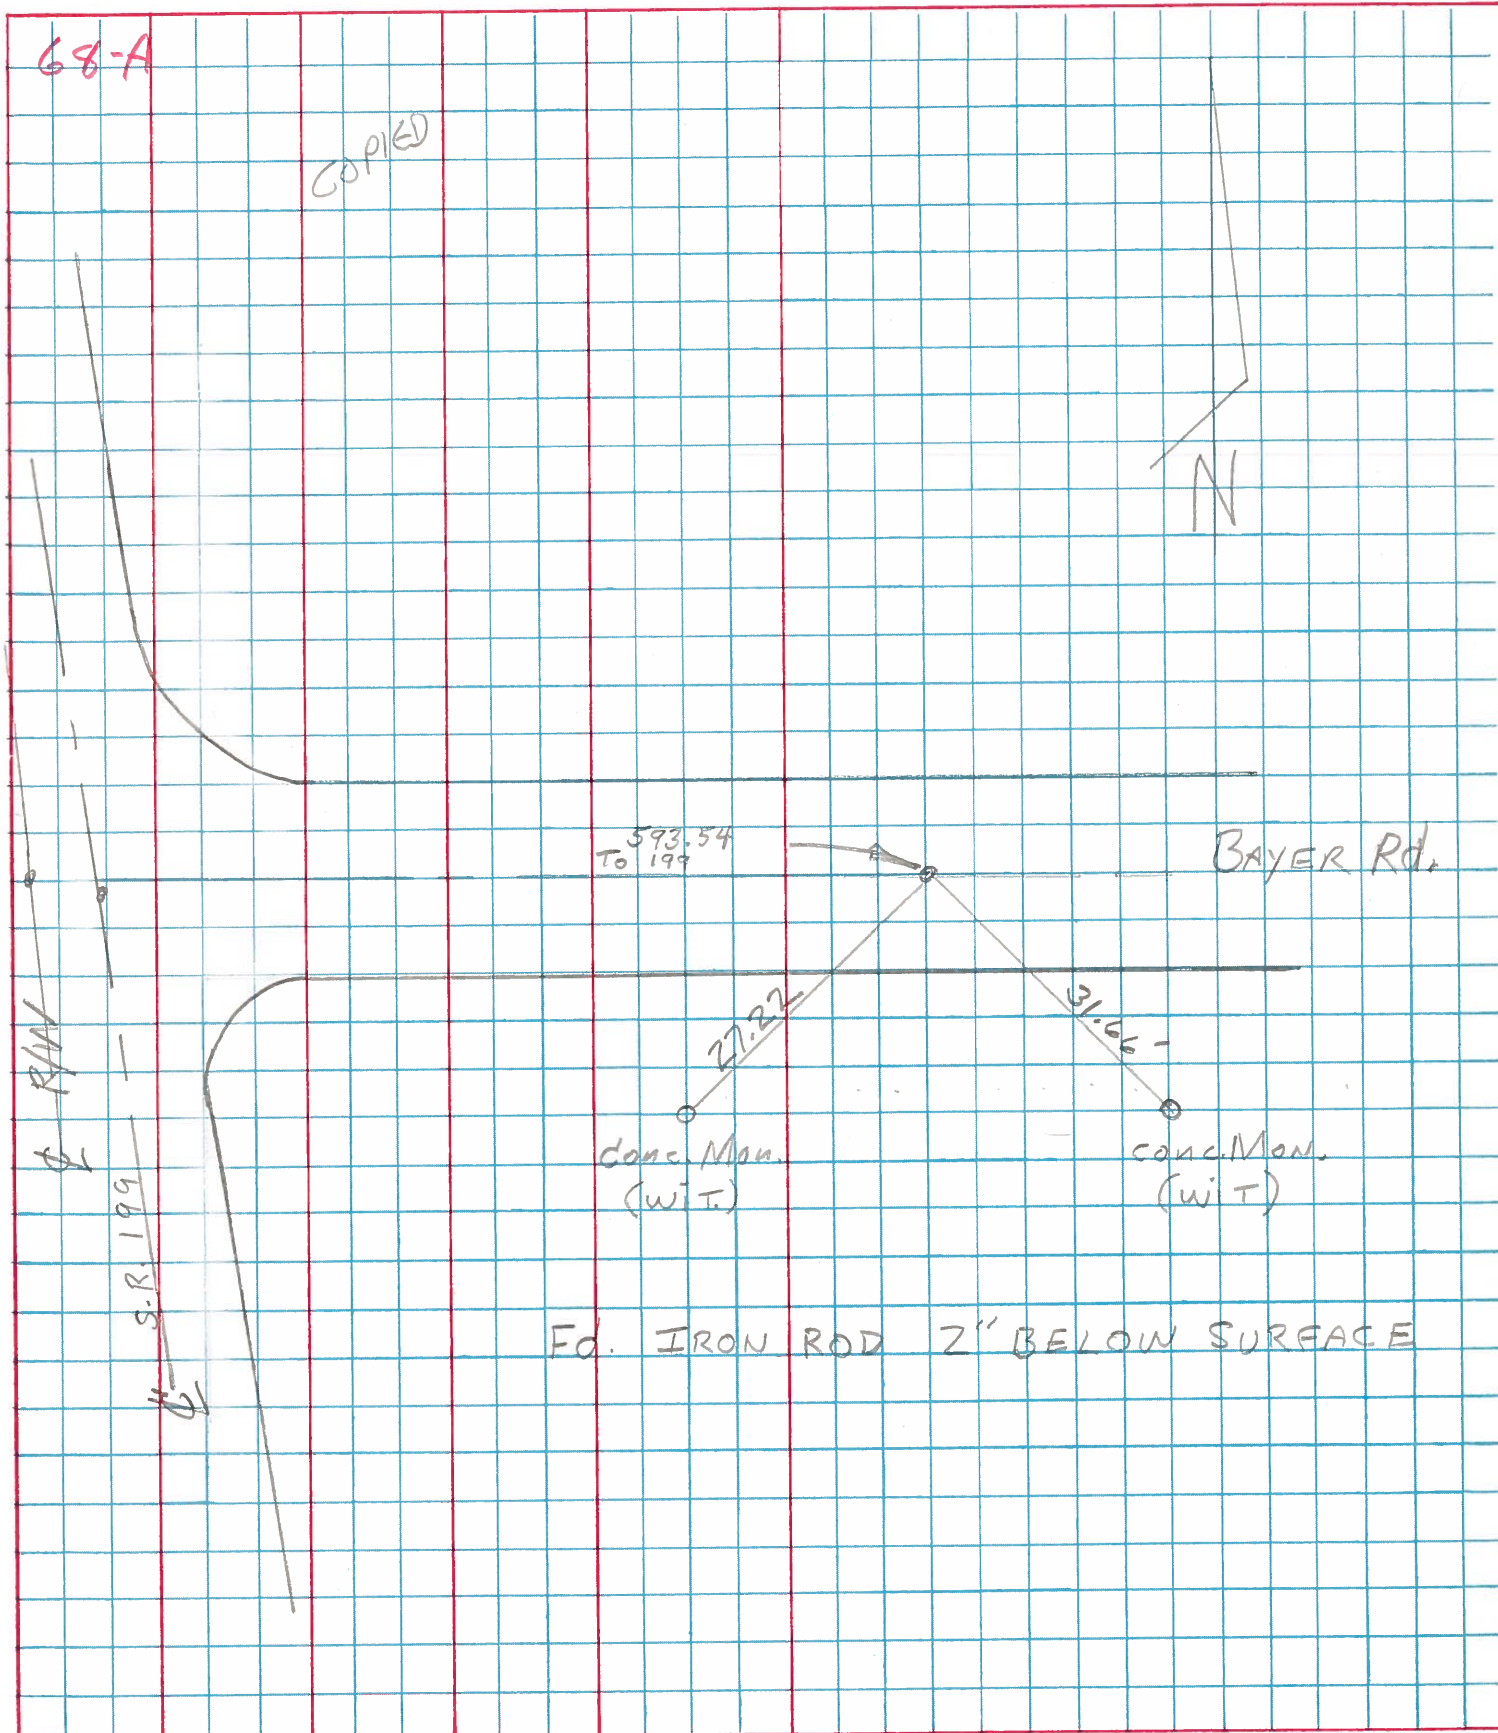

ODOT DISTRICT 2 SURVEY OFFICE

SHEET

OF

County WOOD S.R. 199

Township PERRYSBURG

Section 21

T N, R E

Personnel TOMSLIC
NEUSER
VANYO
GRANATA
CURTIS

Date SEPT. 23 - 1971

Weather _____

Temp. _____

17	16
20	21



68

FD. TWO P.K.
NAILS AT SURFACE

126 + 81.5'

