

O.D.O.T. DISTRICT 2 SURVEY OFFICE (USE ONLY)

PERSONNEL

REFERENCE NO. 70 A

SHEET 75 OF 75

NOTES FARKAS

DATE 4/27/16

ROUTE SR 199

H.C. LEU

WEATHER CLOUDY

COUNTY WOOD

R.C. HOMAN

TEMP. 50°

TOWNSHIP PERRYSBURG

SECTION 17

DWG BY AUBLE

PID 101221

T 6 N R 11 E

TYPE MONUMENT P.K.NAIL

~~ON SURFACE~~ - BELOW 8"

OFFSET ☐ PAVEMENT ON LT : RT

- TO - EDGE PAVEMENT



STATION: 1498+60

HORZ.DATUM: -

GEOID: -

GRID: NORTHING: 680547.034

EASTING: 1664790.891

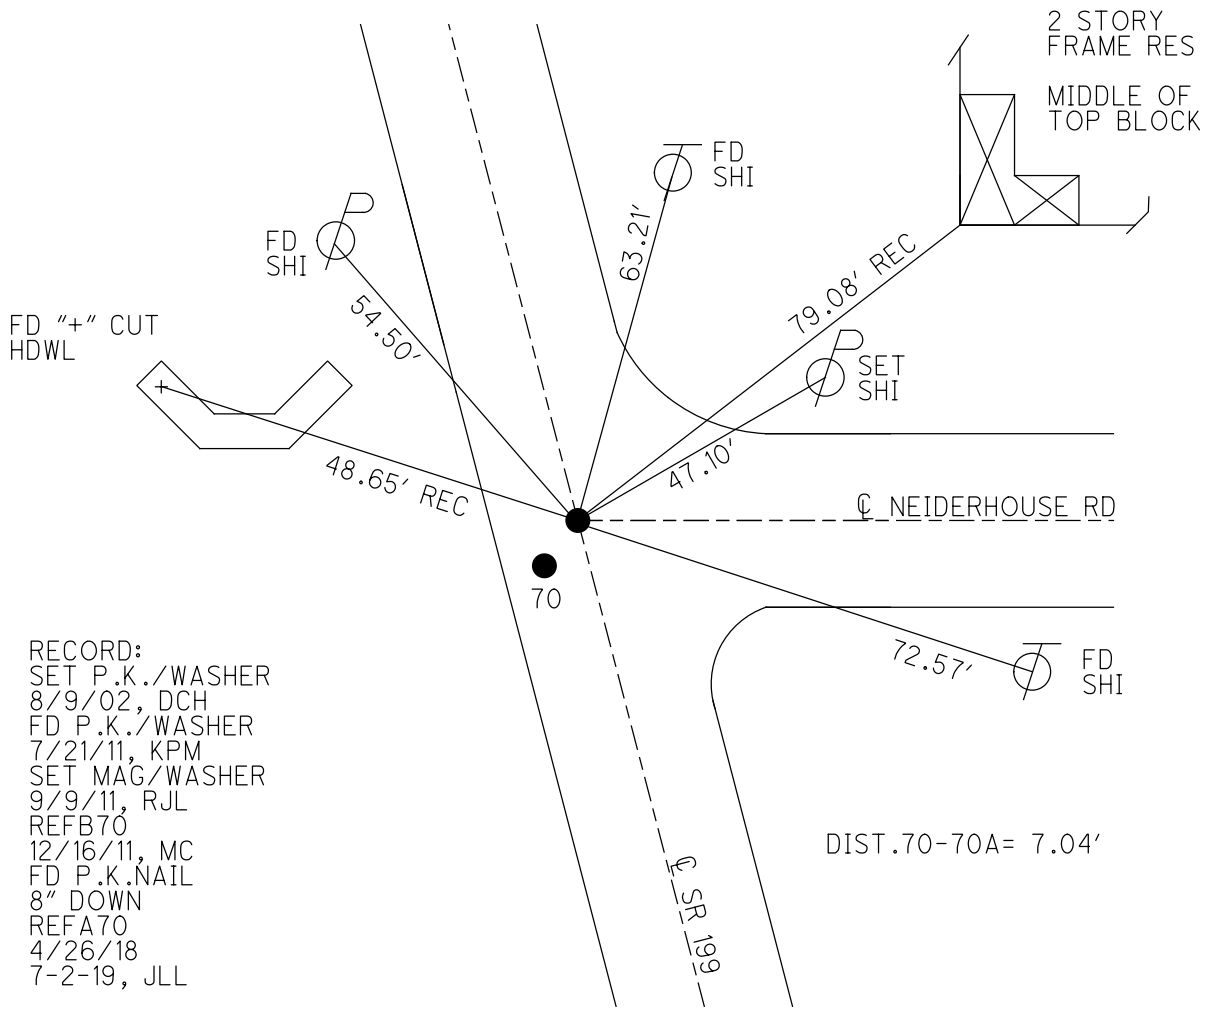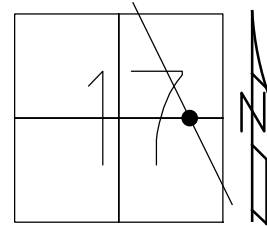


RECORD:  
 SET P.K./WASHER  
 8/9/02, DCH  
 FD P.K./WASHER  
 7/21/11, KPM  
 SET MAG/WASHER  
 9/9/11, RJL  
 REFB70  
 12/16/11, MC  
 FD P.K.NAIL  
 8" DOWN  
 REFA70  
 4/26/18  
 7-2-19, JLL


O.D.O.T. DISTRICT 2 SURVEY OFFICE (USE ONLY)

PERSONNEL \_\_\_\_\_ REFERENCE NO. 70 A SHEET 72 OF 72  
 NOTES MOSER DATE 7/21/11 ROUTE SR 199  
 H.C. MOSER WEATHER SUNNY COUNTY WOOD  
 R.C. HARBAUGH TEMP. 85° TOWNSHIP PERRYSBURG  
 \_\_\_\_\_ SECTION 17  
 \_\_\_\_\_ T 6 N R 11 E

TYPE MONUMENT PK/WASHER  
 ON SURFACE - ~~BELOW~~ ON  
~~LEFT - C PAV'T~~ - RIGHT 1.0'  
- TO - EDGE PAVEMENT  
 S.L.M. 1498+60

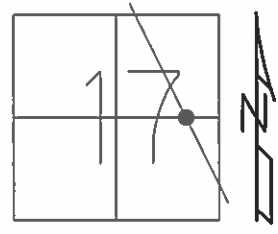

GRID: NORTHING: 680547.002 EASTING: 1664790.811

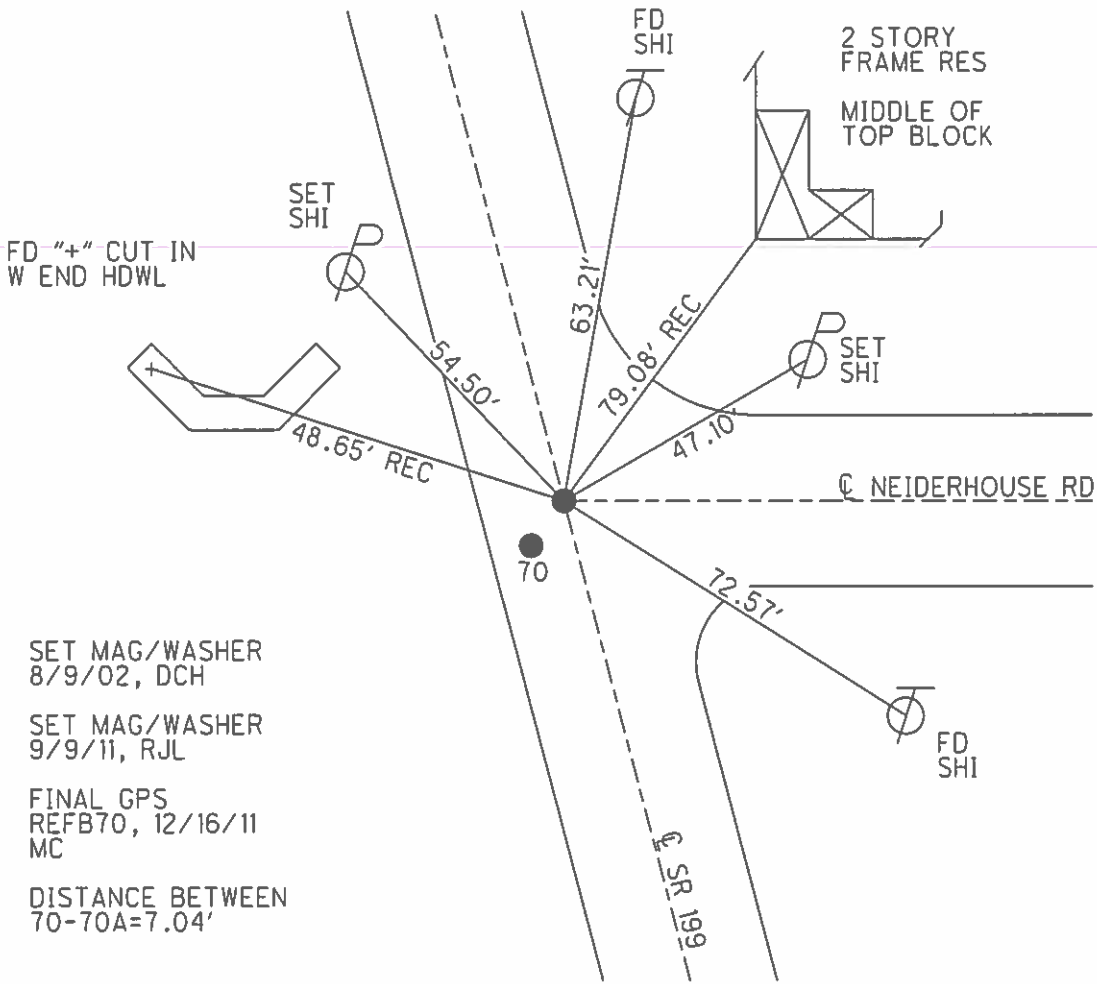

O.D.O.T. DISTRICT 2 SURVEY OFFICE

PERSONNEL

REFERENCE NO. 70


SHEET 45 OF 45

NOTES            MOSER  
 H.C.            HOMAN  
 R.C.            ROUSOS  
                  CANTERBURY


DATE            4-6-02  
 WEATHER            SUNNY  
 TEMP.            +40°

ROUTE            199  
 COUNTY            WOOD  
 TOWNSHIP            PERRYSBURG  
 SECTION            17  
           T 6 N R 11 E

TYPE MONUMENT            PK'S & WASHERS  
 ON SURFACE - BELOW            YES  
 LEFT -             $\phi$  PAV'T - RIGHT             
           TO            EDGE PAVEMENT  
 S.L.M.            "A" 1498+57 "B" 1498+60

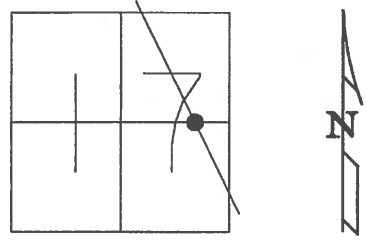

SET MAG NAILS  
& WASHERS  
8-09-02  
D.C.H.

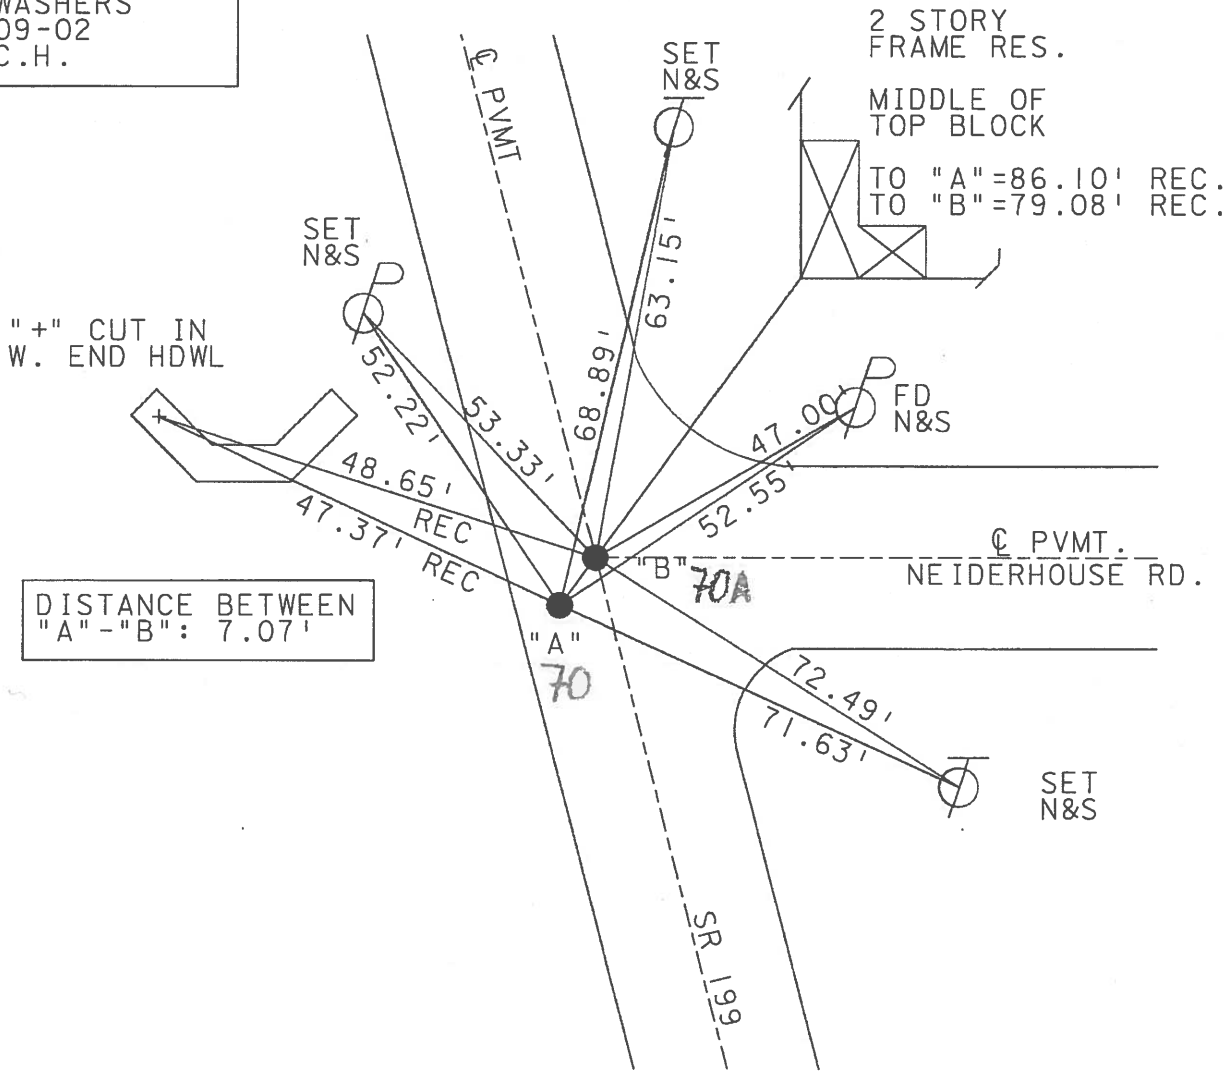

DISTANCE BETWEEN  
"A" - "B": 7.07'

# O.D.O.T. DISTRICT 2 SURVEY OFFICE

PERSONNEL \_\_\_\_\_

REFERENCE NO. 70

SHEET 18 OF 21

NOTES D. CURTIS

H.C. J. HOUSEHOLDER

DATE 9-9-88

ROUTE S.R. #199

R.C. \_\_\_\_\_

WEATHER MILD

COUNTY WOOD

TEMP. 75°±

TOWNSHIP PERYSBURG

SECTION 17

T. \_\_\_\_\_ R. \_\_\_\_\_


TYPE MONUMENT P.K. NAILS IN WASHERS

ON SURFACE - BELOW SURFACE


LEFT- & PAV'T. - RIGHT \_\_\_\_\_

\_\_\_\_\_ TO \_\_\_\_\_ EDGE PAVEMENT

S.L.M. (B) 1498+57 (A) 1498+60

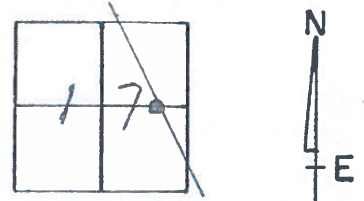

SET P.K. NAILS TO SURFACE AT PTS:  
 (A) & (B) 5-18-90  
 a/c

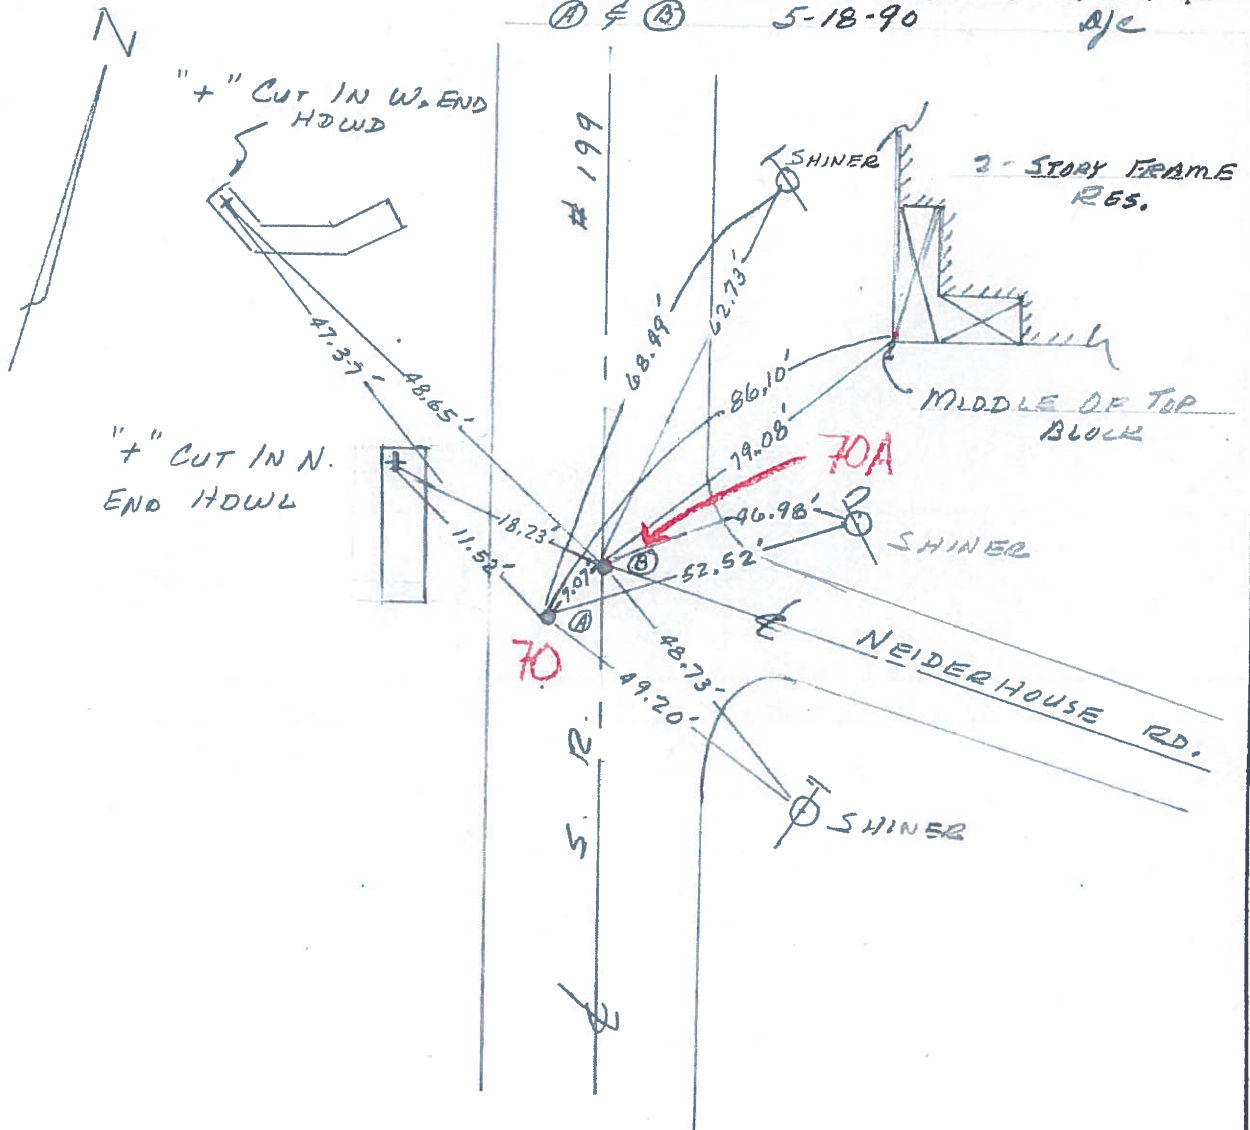

Q.D.O.T. DISTRICT 2 SURVEY OFFICE

SHEET \_\_\_\_\_ OF \_\_\_\_\_

County Wood S.R. 199

Date 12-27-82

Township Perrysburg


Weather RAIN

Section 17

Temp. +40°


T4N, RE U.S.R.

Personnel HOFFMAN  
HOUSEHOLDER  
LOENKE  
BARWISER

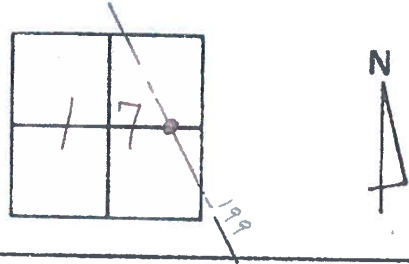

#70

4" = Fd P.K. 3" Below Surface  
 1' RT of & PAUT SR 199  
 11' TO W. E.P.  
 S.L.M. STA 1498+55  
 Record STA 1925 PLAN  
 P.I. 66+74.3  
 Δ = 0°-05' RT.

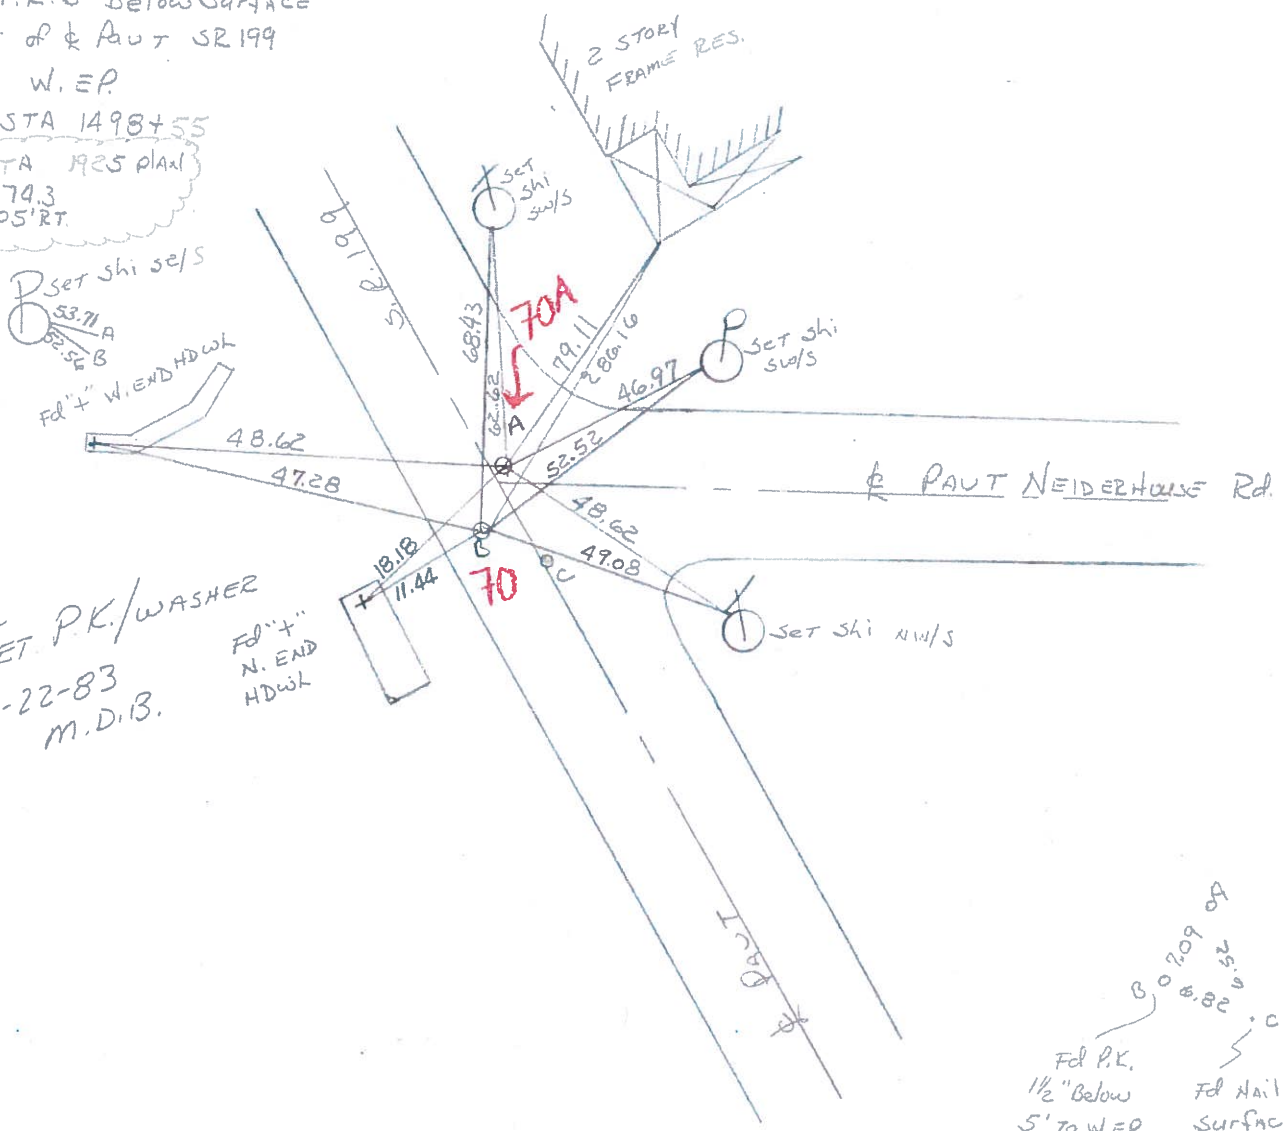

Fd P.K. 1/2" Below Surface  
 5' TO W.E.P.  
 5' LT. of & PAUT

O.D.O.T. DISTRICT 2 SURVEY OFFICE

SHEET OF

County WOOD S.R. 199

Township PERRYS BURG

Section 17

T N, R E

Personnel TOMSIK

NEUSER

VANYO

GRANATA

Date SEPT. 9 - 1971


Weather \_\_\_\_\_

Temp. \_\_\_\_\_

17	16
20	21



#70

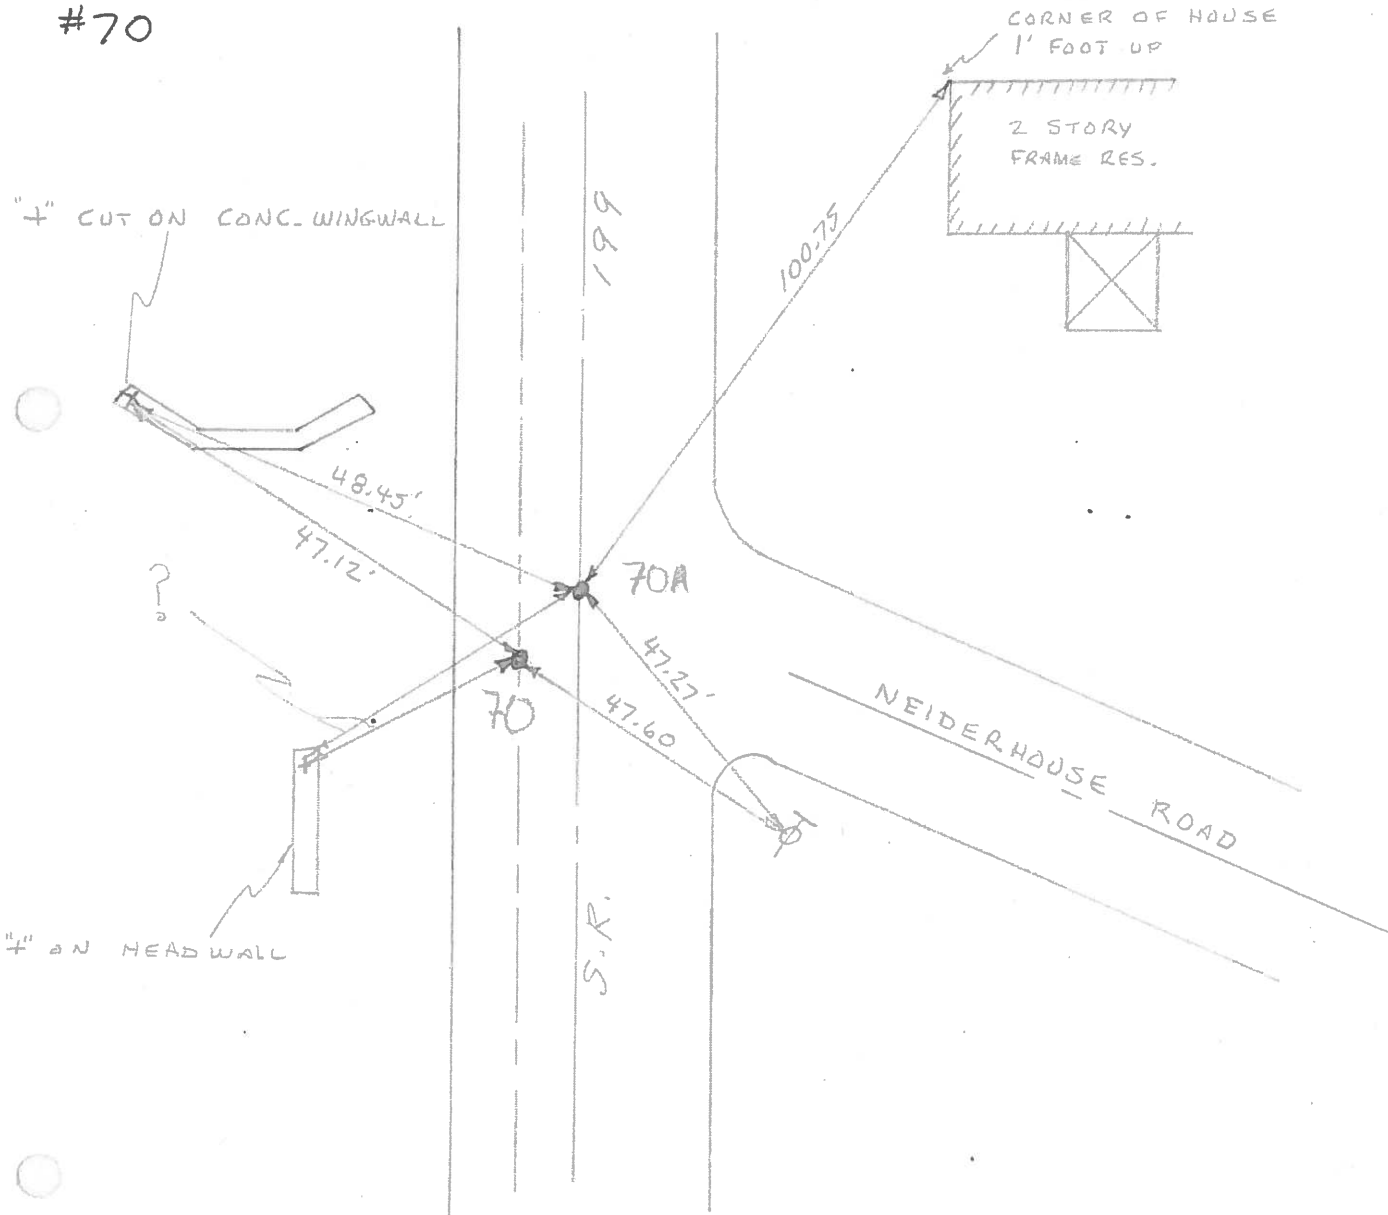

PERSONNEL	TITLE	PERSONNEL	TITLE
Tomsic	_____	_____	_____
Neuser	_____	_____	_____
Vanyo	_____	_____	_____
Granata	_____	_____	_____

COUNTY WOOD DATE Sept. 9-71

S. R. 199 WEATHER \_\_\_\_\_

SEC. \_\_\_\_\_ TEMP. \_\_\_\_\_

DESCRIPTION \_\_\_\_\_ LEFT \_\_\_\_\_ CENTER LINE \_\_\_\_\_ RIGHT \_\_\_\_\_ JOB NO. \_\_\_\_\_

