

O.D.O.T. DISTRICT 2 SURVEY OFFICE (USE ONLY)

PERSONNEL

REFERENCE NO. 10

SHEET 8 OF 26

NOTES ASTON
H.C. NIESE
R.C. PRESTON-COLVIN

DATE 8-21-24
WEATHER CLEAR
TEMP. 65°

ROUTE SR 235
COUNTY WOOD
TOWNSHIP JACKSON
SECTION 11
T 3 N R 9 E

DWG BY PRESTON-COLVIN PID CHIPSEAL

TYPE MONUMENT 1/4" IPIPE

~~ON SURFACE~~ - BELOW 0.2"

OFFSET CL PAVEMENT 13.5" LT : ~~RT~~
4.4" TO LT EDGE PAVEMENT

STATION: 239+33.78

HORIZ.DATUM: NAD83 (2011)


GEOID: 2018

GRID: NORTHING: 573491

EASTING: 1615107

LDP: NORTHING: 394841.8

EASTING: 126929.7

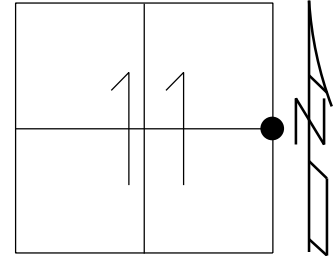


RECORD:
FD 1/2" IPIN
3" BELOW
SLIGHT LEAN WEST
GPS, REF11
10-22-14

GPS, REF10
8-27-15

NOT COVERED
GPS, NEWREF10
7-28-16, DCH

FD 1/4" IPIPE
REF10
8-21-24, TDN

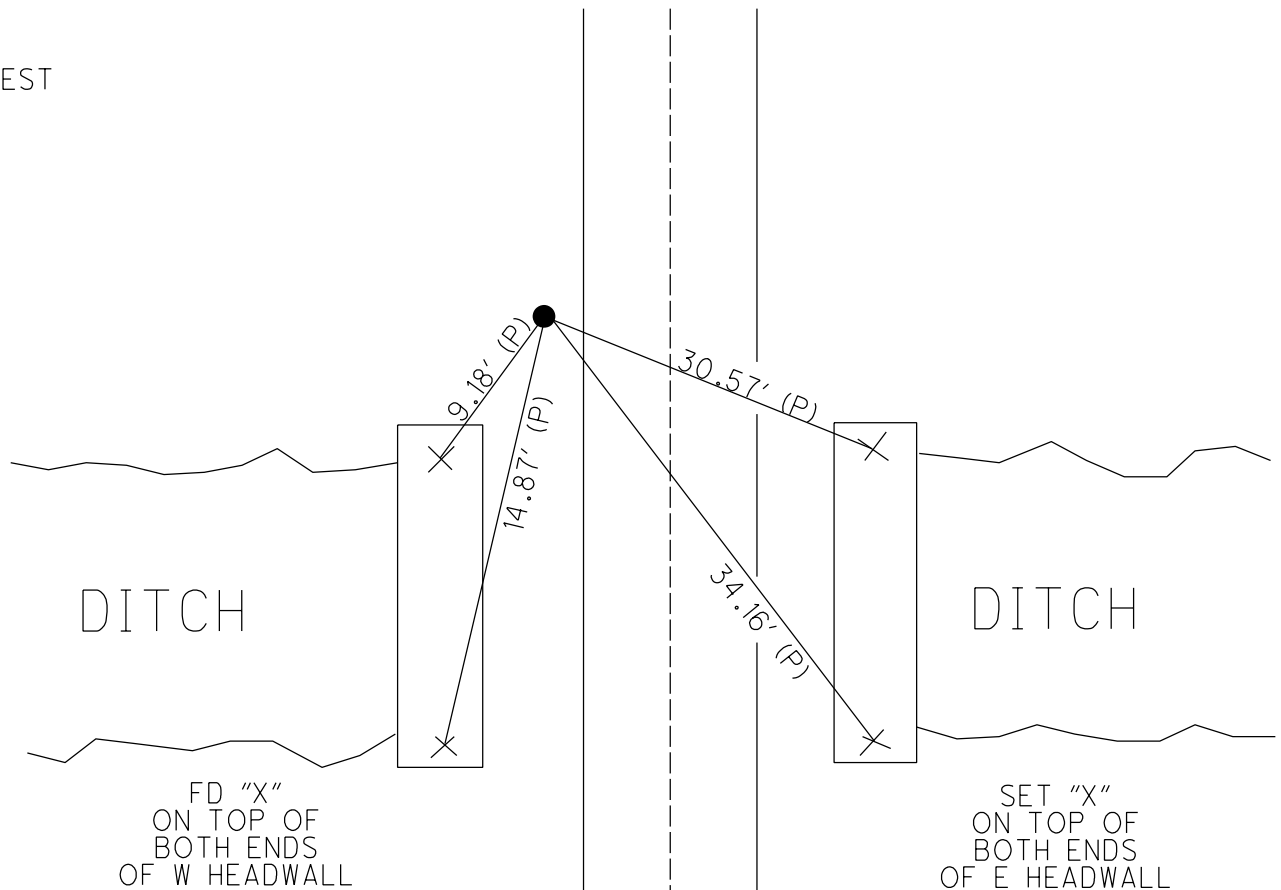

CL SR 235

O.D.O.T. DISTRICT 2 SURVEY OFFICE (USE ONLY)

PERSONNEL

REFERENCE NO. 10

SHEET 8 OF 26

NOTES RHOADES

DATE 8-27-15

ROUTE SR 235

H.C. O'DONNELL

WEATHER CLOUDY

COUNTY WOOD

R.C. RHOADES

TEMP. 70°F

TOWNSHIP JACKSON

SECTION 11

T 3 N R 9 E

TYPE MONUMENT 3/4" IPIPE


~~ON SURFACE~~ - BELOW 0.2'

LEFT - ℄ PAV'T - ~~RIGHT~~ 13.5'

4.4' TO LT EDGE PAVEMENT

S.L.M. 239+33.78


Grid: Northing: 573491.0083 Easting: 1615106.9471

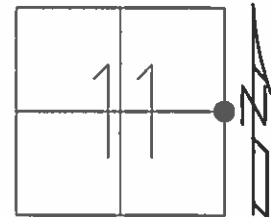

RECORD:
FD 1/2" IPIN
3" BELOW
SLIGHT LEAN WEST
GPS, REF11
10-22-14

GPS, REF10
8-27-15

NOT COVERED
GPS, NEWREF10
7-28-16, DCH

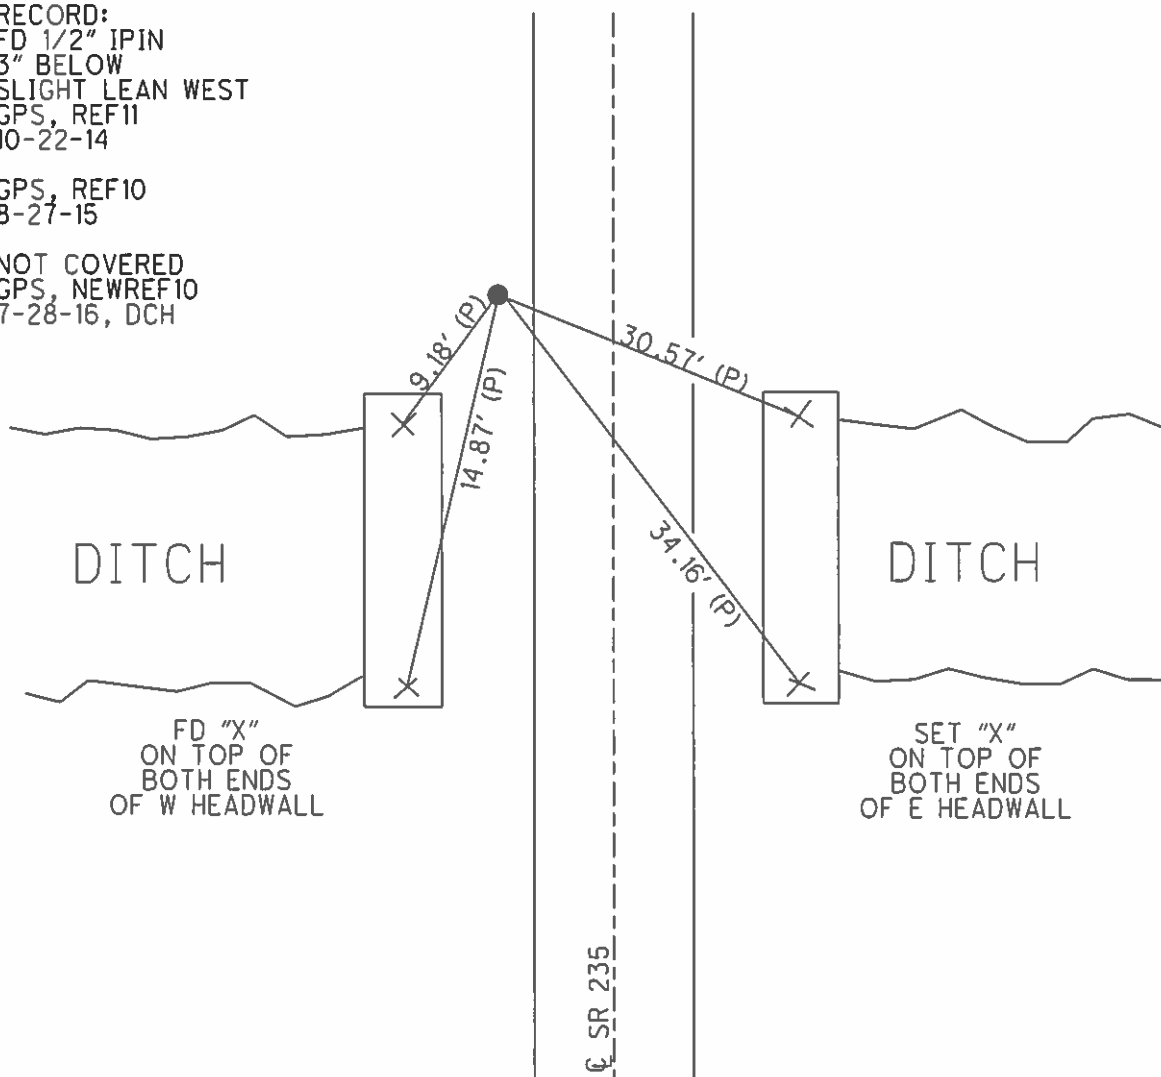

O.D.O.T. DISTRICT 2 SURVEY OFFICE

PERSONNEL

REFERENCE NO. 10

SHEET 7 OF 23

NOTES Homan

DATE 9-24-03

ROUTE 235

H.C. Nuhfer

WEATHER Rain

COUNTY WOOD

R.C. Ballmer

TEMP. 55°

TOWNSHIP JACKSON

SECTION 11

T 3 N R 9 E


TYPE MONUMENT 1/2" Iron Pipe

ON SURFACE - BELOW on surface


LEFT - ~~C PAVT~~ - RIGHT 13.5

4.4 TO LT EDGE PAVEMENT

S.L.M. 238+39

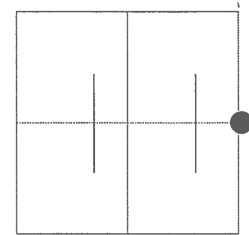

Point Not Disturbed 2003

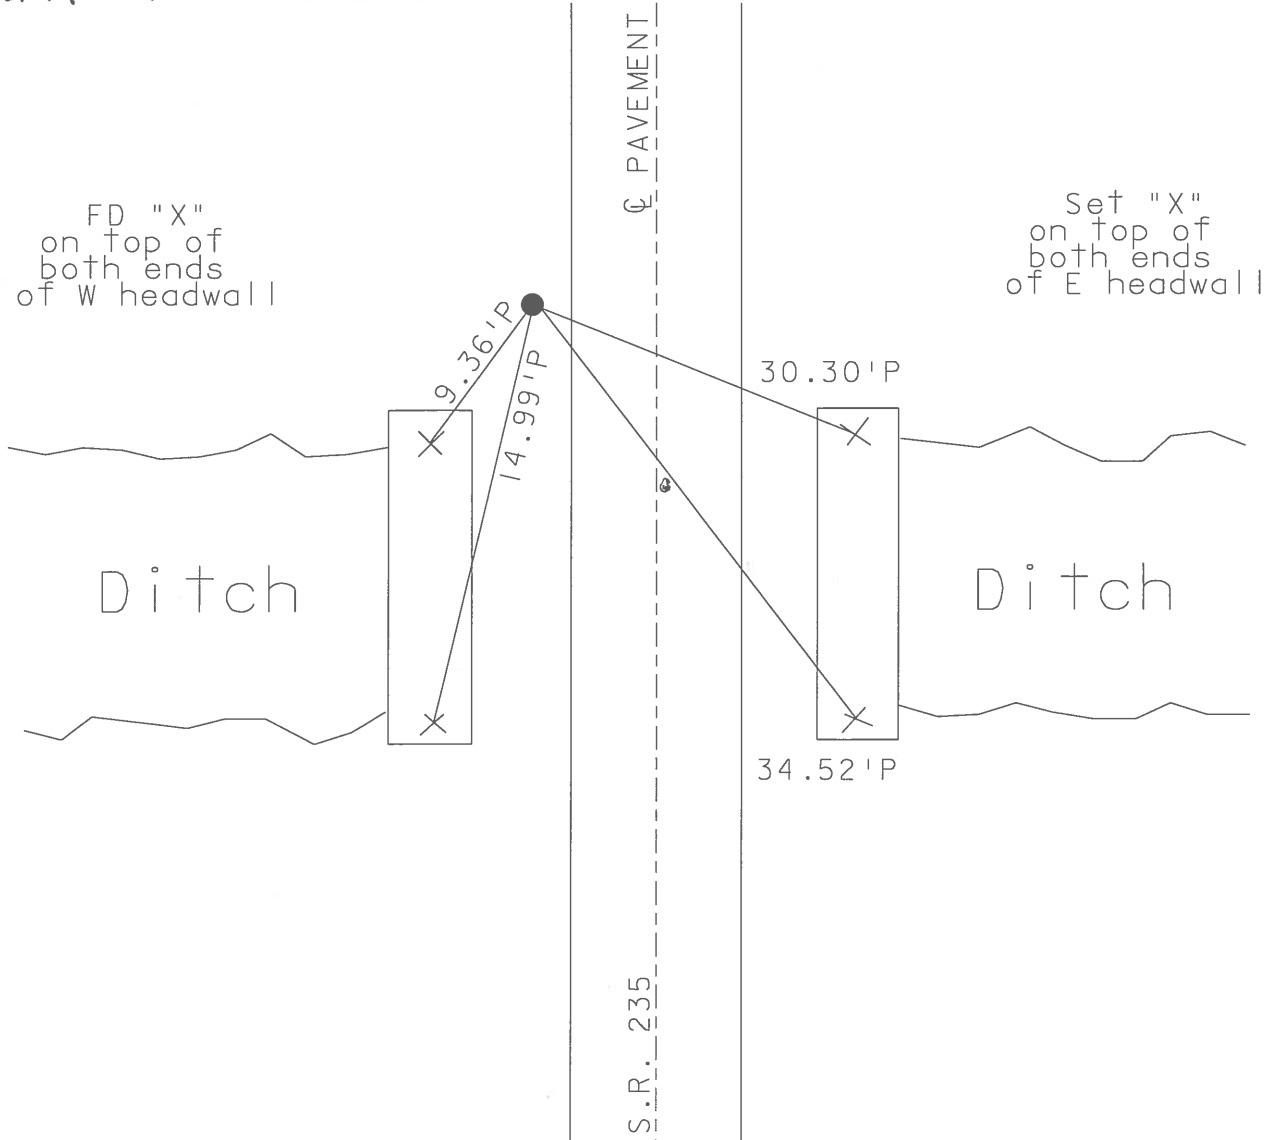

O.D.O.T. DISTRICT 2 SURVEY OFFICE

PERSONNEL

REFERENCE NO. 10

SHEET 6 OF 28

NOTES BALNHISEL

H.C. CORDES

R.C. V. SCOTT

DATE 7-14-96

WEATHER Sunny

TEMP. +85°

ROUTE 235

COUNTY WOOD

TOWNSHIP JACKSON

SECTION 11

T3 N R 9


TYPE MONUMENT 1/2" IRON PIPE

ON SURFACE BELOW YES


LEFT-~~C~~ PAV'T. - RIGHT 13.5

4.4 TO LT. EDGE PAVEMENT

S.L.M. 238 + 39

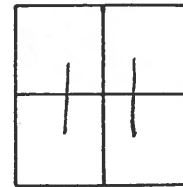

Fd Iron pipe 2"
below surface
10-07-96
BUD

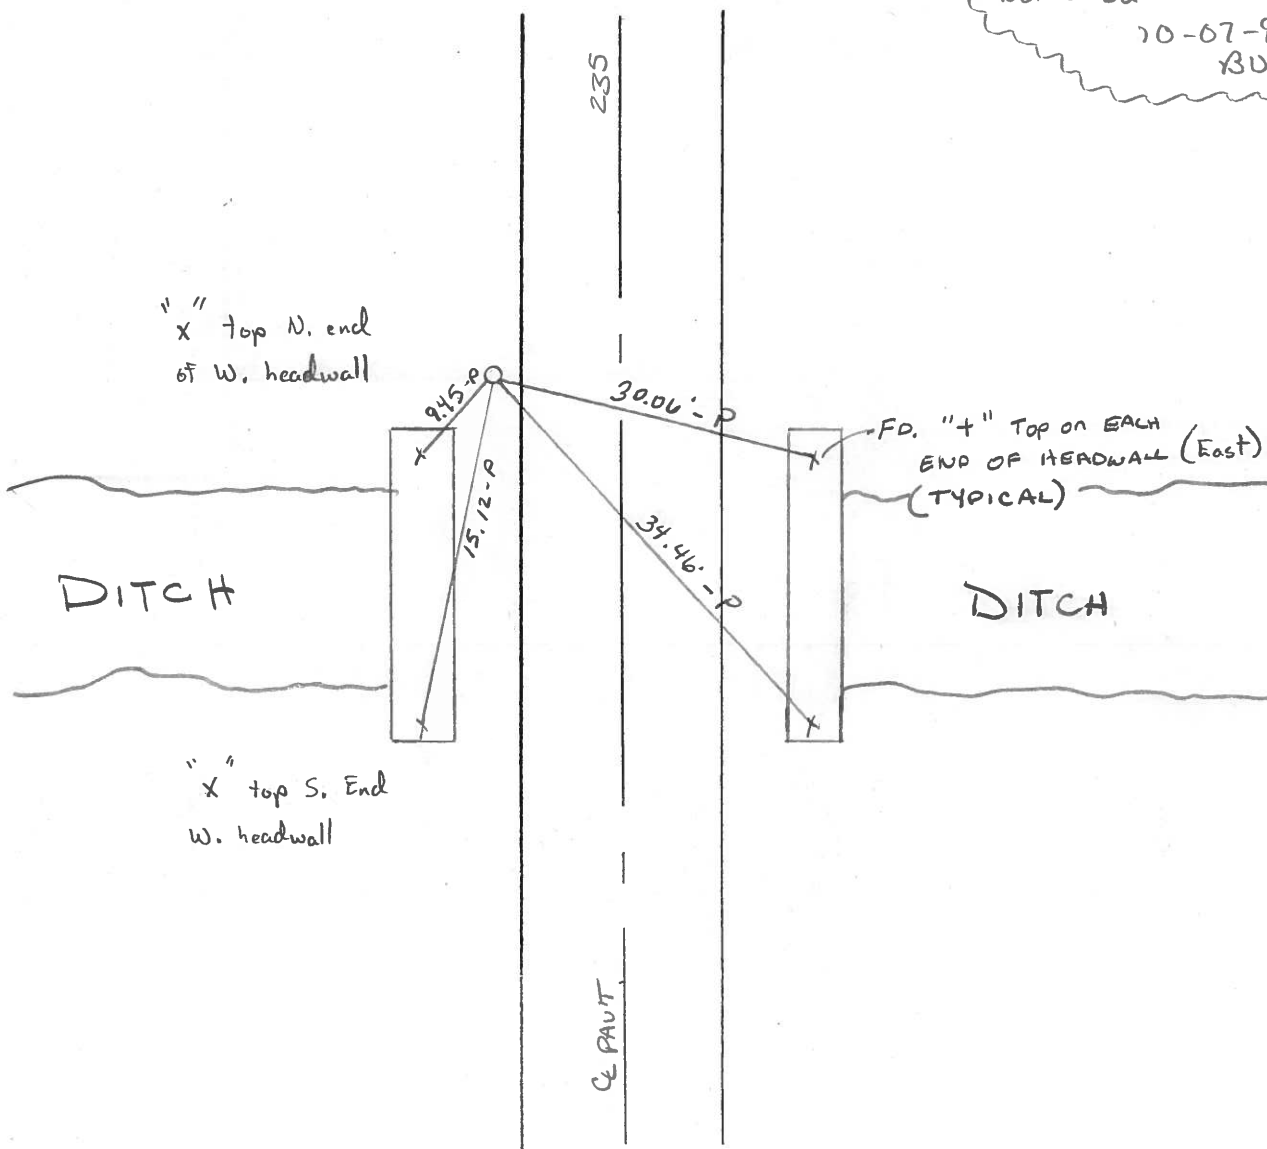

O.D.O.T. DISTRICT 2 SURVEY OFFICE

PERSONNEL

REFERENCE NO. 10

SHEET OF

NOTES BARNHISEL

H.C. Loehrke

R.C. HOFFMAN

DATE 6-3-86

WEATHER SUNNY

TEMP. +55°

ROUTE 235

COUNTY WOOD

TOWNSHIP JACKSON

SECTION 11

T 3 N R 9 E

TYPE MONUMENT 1/2" Iron Pipe



ON SURFACE - BELOW yes

LEFT - Q PAW'T. - RIGHT 13.0

4.5 Lt TO Lt EDGE PAVEMENT

S.L.M. 238+42

2.5 Lt of Lt Ed
13.3 Lt &
6-26-86
MOB

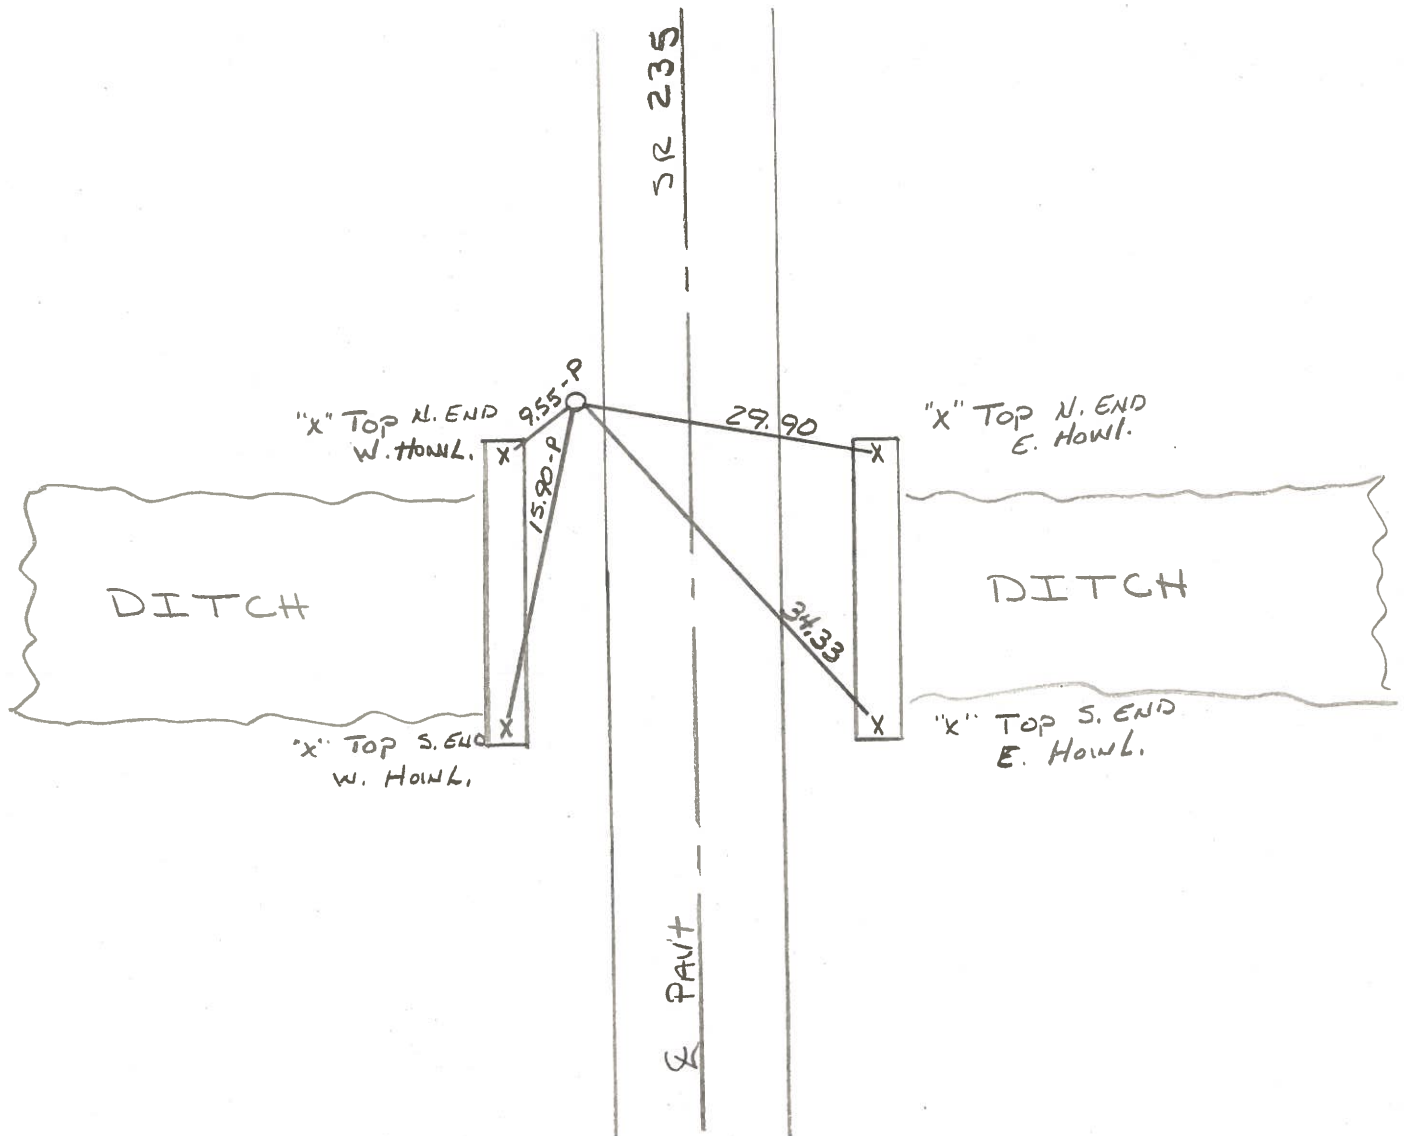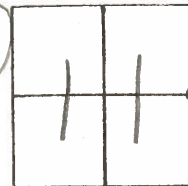


PERSONNEL	TITLE	PERSONNEL	TITLE
BURNSIDE			
SMITH			
BOWERS			
MEAD			

COUNTY Wood DATE 12-17-75

S. R. 235 WEATHER Cloudy

SEC. 12 & 11 TEMP. +20°

DESCRIPTION Control Ties JOB NO. _____

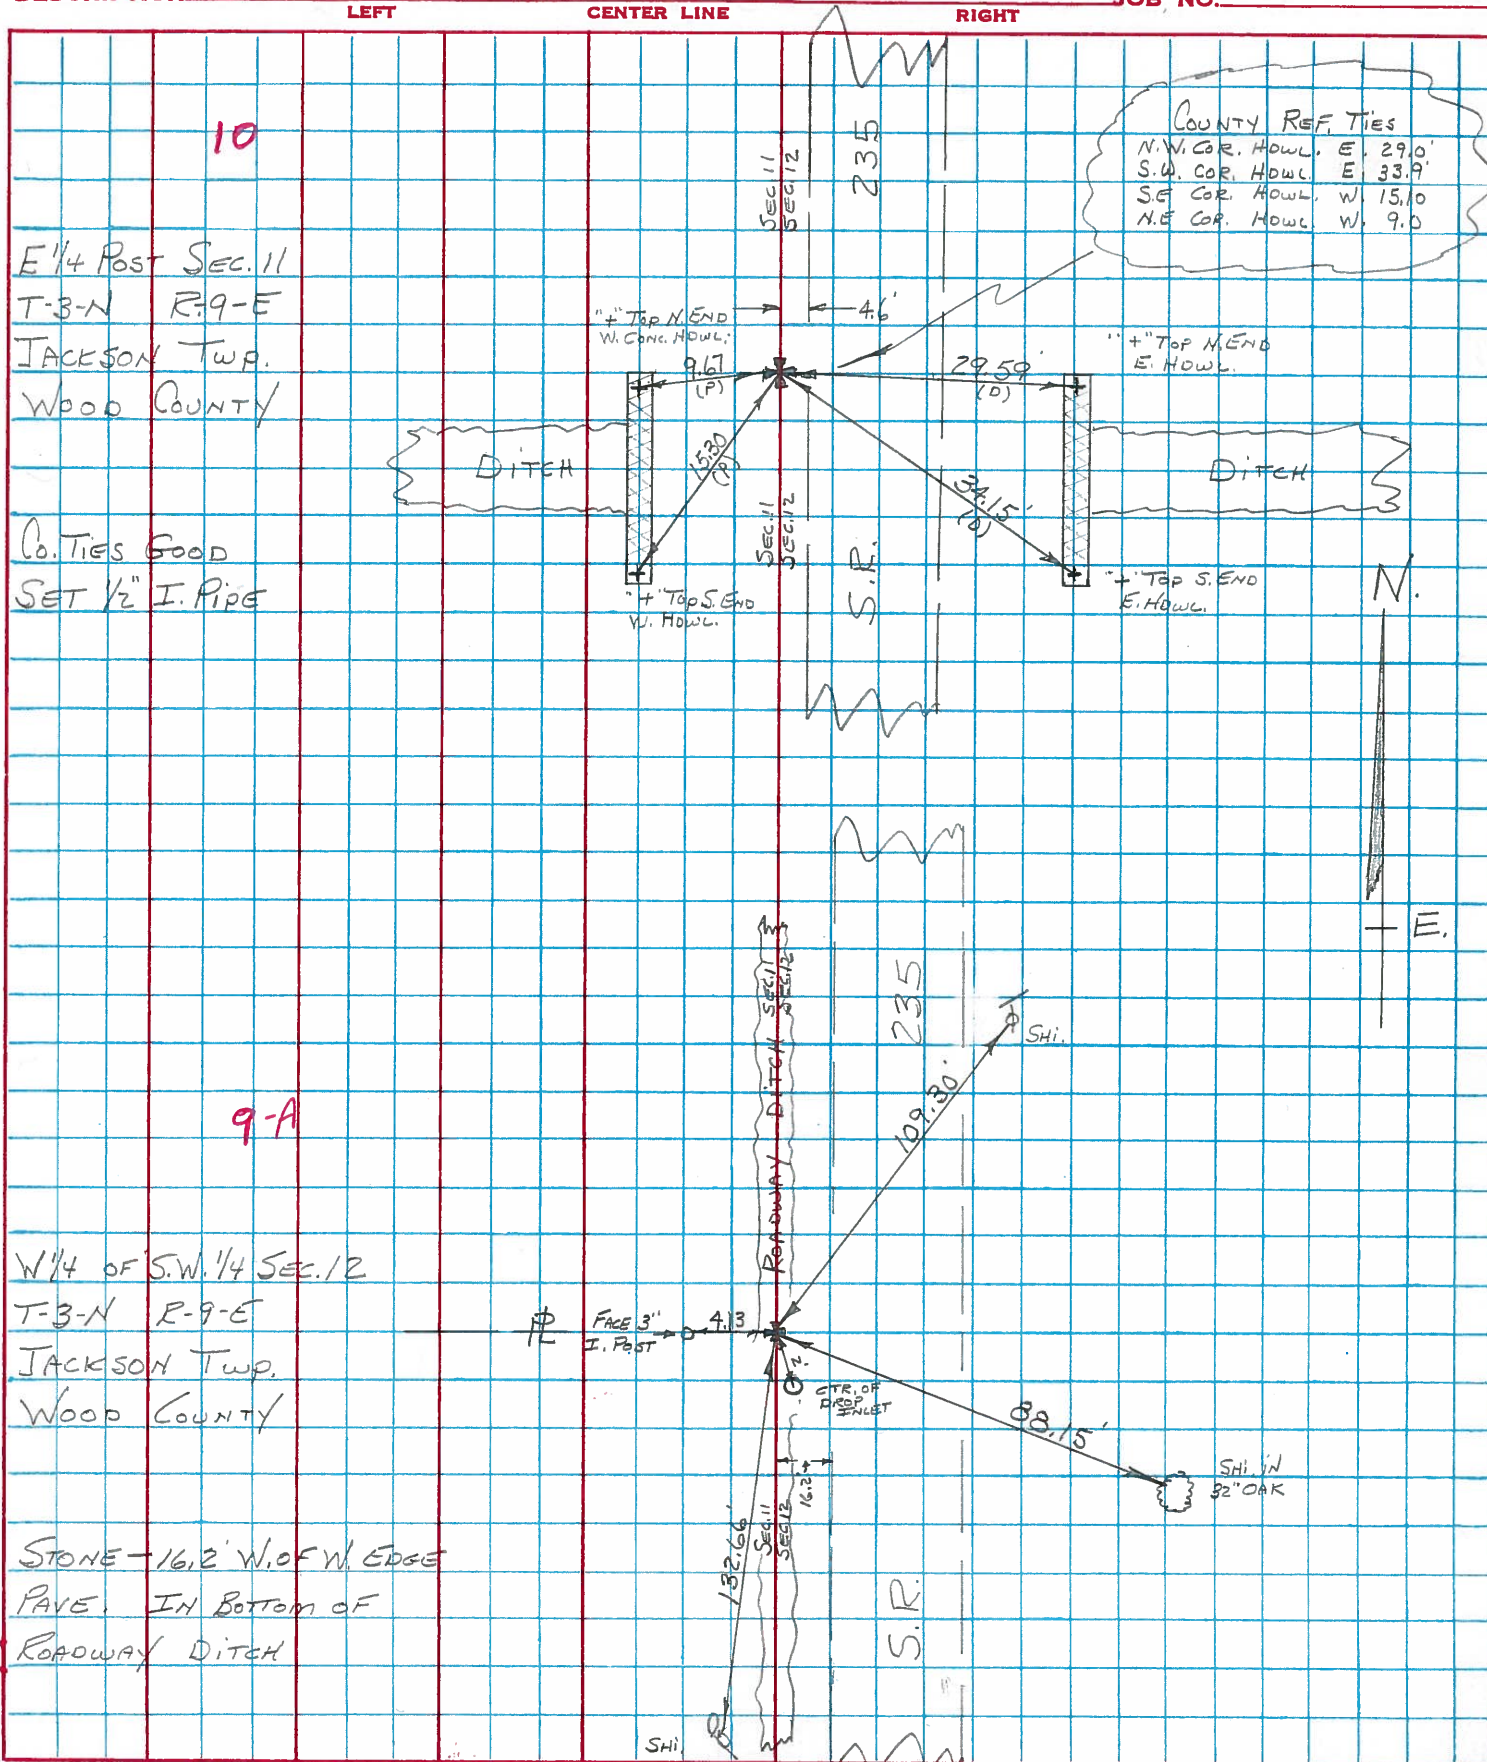

PERSONNEL TITLE PERSONNEL TITLE

COUNTY Wood DATE April 23, 1969S. R. #235 (old SR#69) WEATHER Cloudy & RainSEC. Hammansburg Rd. North TEMP. ± 45°DESCRIPTION Ties to Control points

LEFT

CENTER LINE

RIGHT

JOB NO.

#64

#8

(9)

N.E. Cor. Sec. #14 Jackson Twp.
Hammansburg Road.
Checked ties OK 7-25-69 Morrison & Silvester

Shiner

44.90'


79.32'

Shiner

P 37.85'

52.57'

Shiner

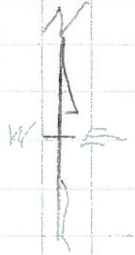

#65

#9

(9A)

Checked ties OK 7/25/69 Morrison & Silvester
Stone in bottom of ditch.
W 1/4 of SW 1/4 Sec #12
Jackson Twp.
Stone is W. of W. Edge Permit 162

Shiner

Cor. Post

5.60'

1/2 of drop in let.

89.20'

Shiner

88.40'

Shiner in 30" Oak



#66 E 1/4 Post Sec. 11 Jackson Twp wit. gone

(10)

#67

#11

P.R. Spk. 8.90' West of edge pavement.
SW. Cor. Sec. #1 Jackson Twp.
Checked ties OK 7/25/69 Morrison & Silvester
S.E. cor. of S. Hdwy S.W. 20.91'
N.E. cor. of N. Hdwy N.W. 10.51'

T 45.02'

47.35'

Shiner in stub pole


Cygnus Road

66.20'

Shiner

63.02'

Shiner

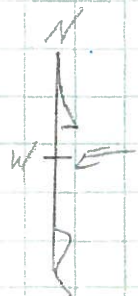

PERSONNEL	TITLE	PERSONNEL	TITLE	COUNTY	DATE
				Wood	OK 12-13-57
				S. R. #69	4-14-60
				SEC. A, B, C	1-18-66
					TEMP.
DESCRIPTION	LEFT	CENTER LINE	RIGHT	JOB NO.	
SE. Cor. sec. 14 Jackson Twp. Iron pin over stone. O. Center Rd.	#62	7	✓ Shi. in 12" Hickory N.W. 46.38 ✓ Shi. in Tele. Pole N.E. 26.95 Conc. man. (No Good) N.E. 25.12 ✓ Conc. man. (Leaning) N.W. 32.00 31.51 Conc. man. (Gone) W.S.W. 34.0 ✓ Vertical pipe of water well S.W. 50.50 ✓ Shi. in 12" Hickory N.N.W. 60.23		
E. 1/4 post sec. 14 Jackson Twp. Iron pin over stone 2' E. of E. Edge Part	#63	8	Conc. man. Broke with H.T. (N.E.) 35.3 ✓ Conc. man. Not Plumb N.E. 35.70 35.81 Conc. man. (Gone) N. of E. 19.45 19.76 ✓ Shi. in T. Pole S.E. 25.45 25.63 ✓ Shi. in 14" spruce N.E. 38.62 ✓ Shi. in 14" spruce N.N.E. 49.78 Shi. in P. Pole S.W. 56.66		
N.E. Cor. sec. 14 Jackson Twp. R.R. spk. over stone Hammansburg Rd.	#64	9	S. to x-on N. end W. about, No Good 8.60' E.S.E. to x-on N. end E. about, No Good 36.50' ✓ SE. to shiner in T.P. 52.57 52.56 ✓ S.S.W. to shiner in R.P. 37.85 ✓ N.W. to man. (Leaning) Plumb 36.83' ✓ Shi. in T. Pole N.W. 40.55 ✓ Shi. in T. Pole N.E. 79.32		
W. 1/4 of the S.W. 1/4 sec. 12 Found stone ✓	#65	9-A	✓ Stone W. of wedge of post. 16.2' ✓ E. of C.B. S.E. 2.0' 1st iron fence post N.N.W. Gone 16.20' Iron sign post stake S.S.W. 13.0' ✓ Anchor post W. 5.60 Shi. in 30" oak S.E. 88.40 Shi. in T.P. N.N.E. 109.20		
E. 1/4 post sec. 11 Jackson Twp. (Ties No Good 12-13-57) " " " (1-18-66)	#66	10	Br. oak 10" SE. 1.07' Center of C.B. SW. 124 lbs		