

O.D.O.T. DISTRICT 2 SURVEY OFFICE (USE ONLY)

PERSONNEL

REFERENCE NO. 21

SHEET 24 OF 26

NOTES NIESE

DATE 8-23-24

ROUTE SR 235

H.C. PRESTON-COLVIN

WEATHER CLEAR

COUNTY WOOD

R.C. BLUNAUGH

TEMP. 60°F

TOWNSHIP MILTON

BARRIERE

SECTION 14

DWG BY PRESTON-COLVIN

PID CHIPSEAL

T 4 N R 9 E

TYPE MONUMENT MAG/WASHER

ON SURFACE - ~~BELOW~~ ON

OFFSET 6.4' TO RT EDGE PAVEMENT

STATION: 505+18.83

HORZ.DATUM: NAD83 (2011)


GEOID: 2018

GRID: NORTHING: 600040.8

EASTING: 1615218

LDP: NORTHING: 421392.9

EASTING: 126690.4

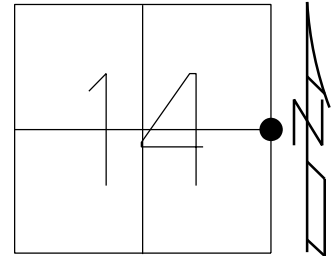

RECORD:
SET SM RR SPK
6-27-86, MDB


SET MAG/WASHER
10-10-03, DCH

FD MAG
GPS, REF25
10-23-14

GPS, REF21
8-26-15

FD MAG/WASHER
REF 21
8-23-24, TDN

FD MAG/WASHER
9-18-24, TDN

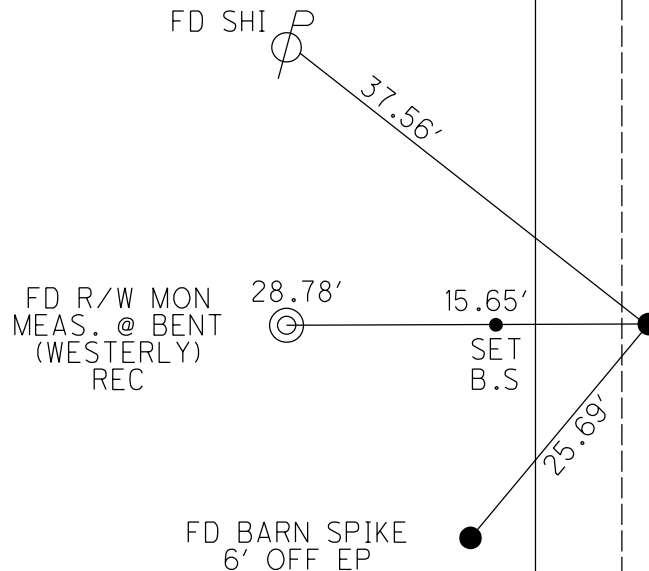

RES#10425

SR 235

O.D.O.T. DISTRICT 2 SURVEY OFFICE (USE ONLY)

PERSONNEL

REFERENCE NO. 21

SHEET 24 OF 26

NOTES RHOADES

DATE 8-26-15

ROUTE SR 235

H.C. O'DONNELL

WEATHER CLOUDY

COUNTY WOOD

R.C. RHOADES

TEMP. 65°F

TOWNSHIP MILTON

SECTION 14

T 4 N R 9 E

TYPE MONUMENT PK/WASHER


ON SURFACE - ~~BELOW~~ ON

~~LEFT~~ - Q PAV'T - RIGHT 2.6'

6.4' TO RT EDGE PAVEMENT

S.L.M. 505+18.83

Grid: Northing: 600040.7701 Easting: 1615217.5250

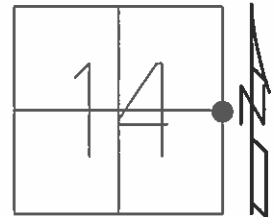

RECORD:
SET SM RR SPK
6-27-86, MDB

SET MAG/WASHER
10-10-03, DCH

FD MAG
GPS, REF25
10-23-14

GPS, REF21
8-26-15

FD SHI

37.58'

FD R/W MON
MEAS. @ BENT
(WESTERLY)



28.78'

SET BARN SPIKE
6' OFF EP

RES#10425

Q SR 235

O.D.O.T. DISTRICT 2 SURVEY OFFICE

PERSONNEL

REFERENCE NO. 21

SHEET 21 OF 23

NOTES Homan

DATE 9-25-03

ROUTE 235

H.C. Nuhfer

WEATHER Sunny

COUNTY WOOD

R.C. Ballmer

TEMP. 60°

TOWNSHIP MILTON

SECTION 14

T 4 N R 9 E


TYPE MONUMENT PK & Washer

ON SURFACE - BELOW on surface

~~LEFT~~ - Q PAV'T - RIGHT 2.6'


6.4 TO RT EDGE PAVEMENT

S.L.M. 504+28

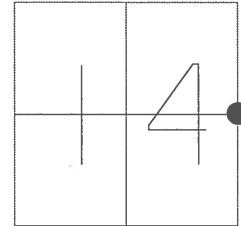

Set Sm RR Spk
6-27-86
MDB

Set Mag & Washer
10-10-03
DCH

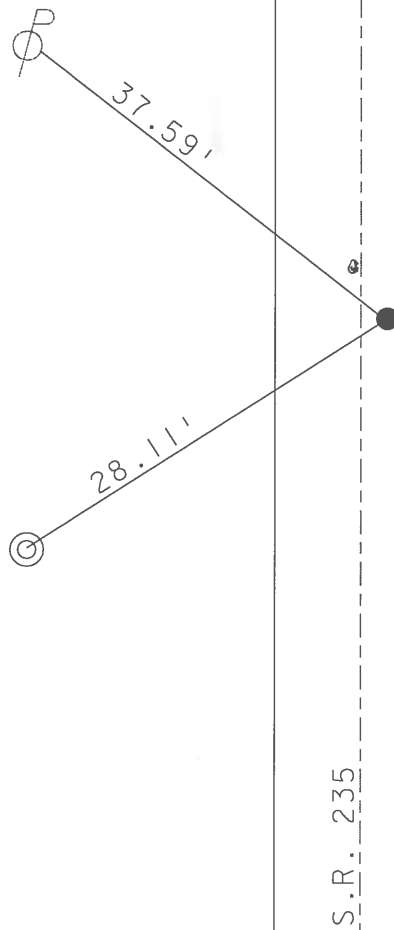

O.D.O.T. DISTRICT 2 SURVEY OFFICE

PERSONNEL

REFERENCE NO. 21

SHEET 20 OF 28

NOTES Van Dusen

H.C. Moser

R.C. Stittler

DATE 07-30-96

WEATHER Cloudy

TEMP. +70°F

ROUTE 235

COUNTY Wood

TOWNSHIP Milton

SECTION 14

T 4 N R 9 E


TYPE MONUMENT Sm RR Spk

ON SURFACE BELOW on surface

LEFT PAV'T. - RIGHT 2.6'


6.4 TO Rt EDGE PAVEMENT

S.L.M. 504 + 28

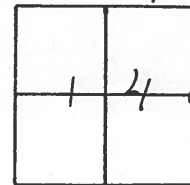

Set Sm. RR Spk
6-27-86
M D B

Set RR/Washer
10-07-96
BUD

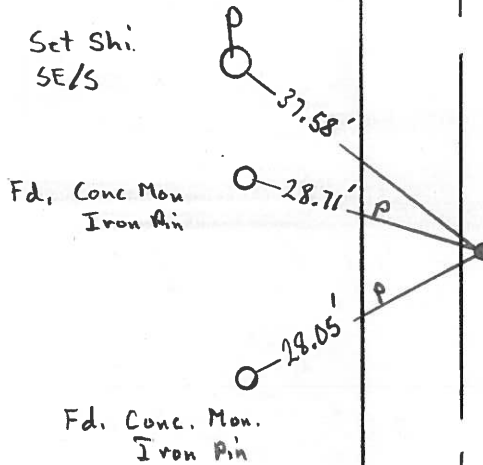

Field Line

6 Post
SR 235

O.D.O.T. DISTRICT 2 SURVEY OFFICE

PERSONNEL

REFERENCE NO. 21

SHEET ____ OF ____

NOTES BARNHISSE

H.C. Loehrke

R.C. HOFFMAN

DATE 6-9-86

WEATHER SUNNY

TEMP. +65°

ROUTE 235

COUNTY WOOD

TOWNSHIP MILTON

SECTION 14

T4 NR 9 E

TYPE MONUMENT Sm RR Spk

ON SURFACE - ~~BELOW~~ yes

LEFT- & PAV'T. - RIGHT 2.3


7.0 TO Rt EDGE PAVEMENT

S.L.M. 504+35

Set Sm RR Spk

6-27-86

WDB

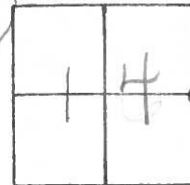

Set SHI
SE/S



40.15

FD IRON PIN
CONC MON



28.75-P

28.07-P

FD IRON PIN
CONC MON




SR 235

& PAV'T

PERSONNEL	TITLE	PERSONNEL	TITLE	COUNTY	WOOD	DATE	5-7-76
BURNSIDE				S. R.	235	WEATHER	Pt. Cloudy
SMITH				SEC.	E 1/4 Post SEC. 14	TEMP.	+52°
MEAD							

DESCRIPTION	REF. TO SECTION	CORNER	JOB NO.
	LEFT	CENTER LINE	RIGHT

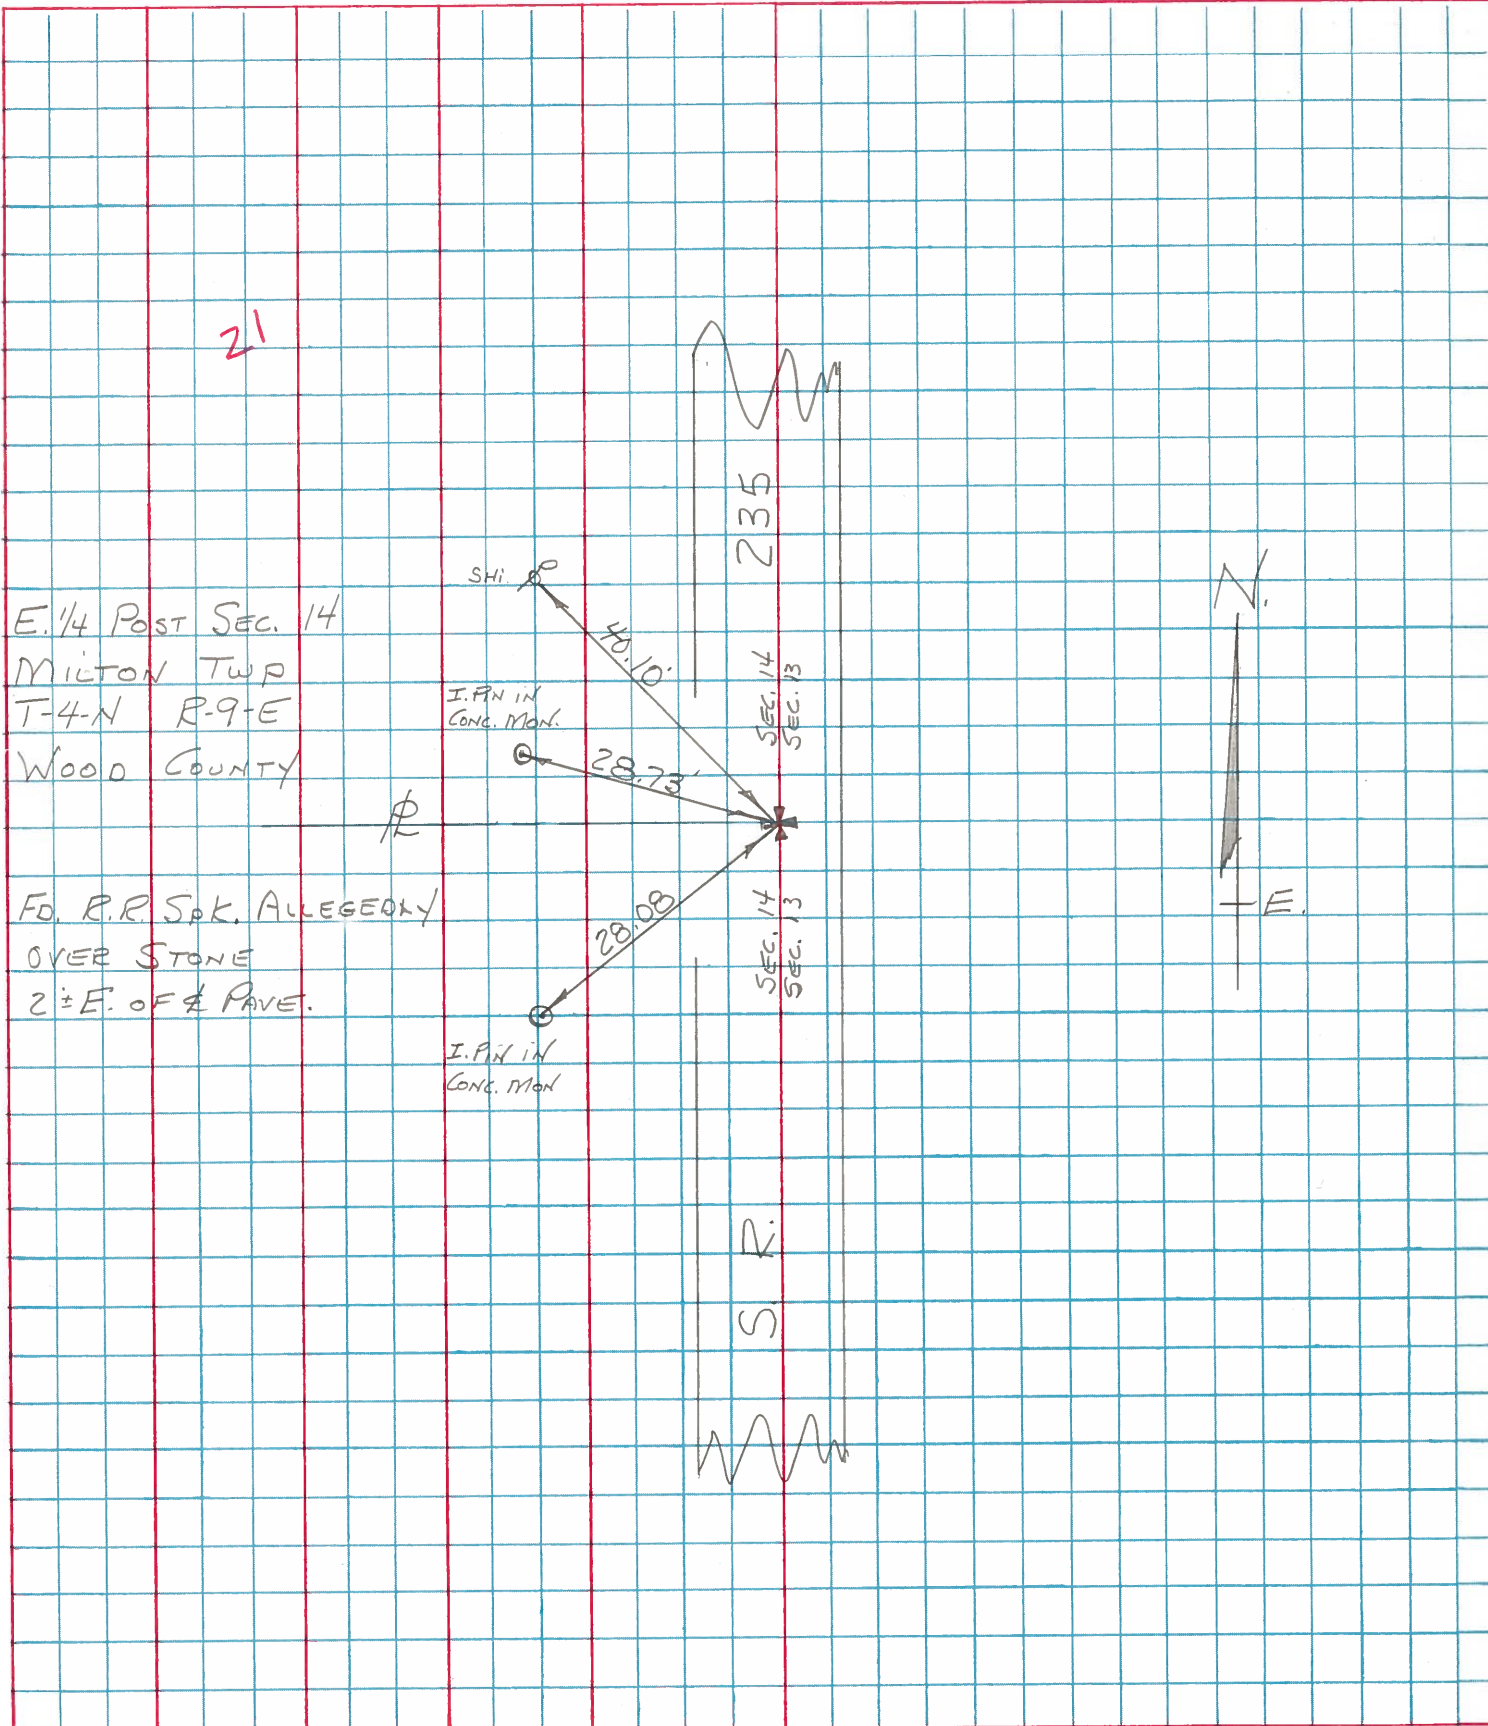

RE-COPIED
7-29-71

SHEET NO. _____

PERSONNEL TITLE PERSONNEL TITLE

COUNTY WOOD DATE _____S. R. 235 (OLD S.R. 69) WEATHER _____

SEC. _____ TEMP. _____

DESCRIPTION _____ JOB NO. _____

LEFT

CENTER LINE

RIGHT

#76
#19N.W. 1/4 SEC. 24. STONE 10.9' E
OF EDGE PAVE. & W. BANK D.H.

#76-A

SHINER IN END POST OF FENCE 37.13'
IRON PIPE W. 30.30'
T.P. N. of W. 69.35'

#20

N.W. COR SEC. 24 MILTON
Twp.
MERMILL ROAD

#77

SHINER IN 24' MAPLE N.W. 57.00'
SHINER IN T. POLE S.W. 51.25'
SHINER IN T. POLE N.E. 35.80'
X IN S.W. COR. S. ABUT. SE. ^(OLD) 15.93'

#78

#79

#21

E. 1/4 POST SEC. 14 MILTON
Twp. STONE 8' BELOW
SURFACE & 6' W. & E. EDGE PAVE.

#80

IRON ROD W. 30.25'
SHINER IN T. POLE N.N.E. 40.09'
SHINER IN T. POLE S.E. 35.66'

#22

N.E. COR. SEC. 14 MILTON
Twp.
STONE 0.6' DEEP R.R. SPK.
MAPLEWOOD ROAD

#81

N. COR. N. Wing of W. ABUT. S. of W. 13.90'
N. COR. N. Wing of E. ABUT. S. of E. 14.13'
SHINER IN T. POLE S.W. 35.03'
SHINER IN T. POLE S.E. 34.17'
SHINER IN T. POLE E. 61.34'

PERSONNEL	TITLE	PERSONNEL	TITLE

COUNTY Wood DATE 02/12-13-57
 S. R. #69 WEATHER Jan 15-60
 SEC. _____ TEMP. _____

DESCRIPTION _____ LEFT _____ CENTER LINE _____ RIGHT _____ JOB NO. _____

#76

N.W. 1/4 Sec. 24 Stone 10.9'E
 of edge part of W. bank dch.

✓ Shiner in End Post of fence 37.13
 ✓ Iron pipe W. 30.30
 ✓ T.P. N of W. 69.35' 67.66

#76-A

N.W. Cor. Sec. 24 Milton
 Twp. Merrill Ed.
 R.R. Spk. ✓

✓ Shiner in 24" maple NW. 57.0
 ✓ Shiner in T.P. SW. 51.25
 ✓ Shiner in T.P. N.E. 35.80 35.72
 ✓ X-in S.W. cor of old S. about S.E. 15.9

#77 20

#78

#79

E 1/4 part Sec. 14 Milton
 Twp. Stone 8" below surface
 of part. 6' W. of E. Edge part.
 of pavement. R.R. Spk. ✓

✓ Shiner in T. Pole N.N.E. 113.52
 ✓ Shiner in P.P. N.W. 40.57 40.52
~~Shiner in Cor. part S. 27.93 27.45~~
~~Stone on E. bank of dch 5.60 5.50~~
 ✓ Shiner in T.P. S.E. 35.66' 35.72
 67

#80 21

N.E. cor. Sec. 14 Milton Twp.
 Stone 0.6 deep R.R. Spk.
 Main road E. ✓

✓ No. cor. N. wing of W. about S.W. 13.95
 ✓ No. cor. N. wing of E. about S.E. 14.16
~~Shiner in P.P. NW. 40.57 40.52~~
 ✓ Shiner in P.P. S.W. 35.06' 33.44
 ✓ Shiner in T.P. S.E. Plumb 34.17 34.13
 ✓ Shiner in T. Pole East 61.34

#81

22

PERSONNEL	TITLE	PERSONNEL	TITLE

COUNTY WoolDATE Oct 12-1960S. R. #69WEATHER 1-30-60

SEC. _____

TEMP. _____

DESCRIPTION

LEFT

CENTER LINE

RIGHT

JOB NO. _____

#76

N.W. 1/4 Sec. 24, Stone 10.9'E
of edge part. 4 W. bank den.

✓ Shiner in End Post of fence 57.13
✓ Iron pipe W. 33.32
✓ T.P. N.W. 69.25' 57.50

#76-1

N.W. Cor. Sec. 24 Milton
Twp. Mermull Rd.
R.R. Spk. ✓

#77

20

57.0
✓ Shiner in 24" maple NW. 57.0
✓ Shiner in T.P. SW. 54.25
✓ Shiner in T.P. NE 35.30 35.7
✓ X in S.W. cor of old S. abut. SE. 15.19

#78

#79

E 1/4 post Sec. 14 Milton
Twp. Stone 8' below surface
of part. 6' W. of E. Edge part.
of fragment. R.R. Spk. ✓

#80

21

Iron Rod W. 30.25

✓ Shiner in T.P. N.W. 113.0
✓ Shiner in P.P. N.W. 107.4 12
~~Shiner in Cor. part. 51.27 51.64~~
~~Stone on E. bank of old S. 51.27 51.64~~
✓ Shiner in T.P. S.E. 35.66' 35.72

N.E. cor. Sec. 14 Milton Twp. 13.90
Stone 0.6 deep R.R. Spk. 14.13
Maplewood Rd. ✓

#81

22

35.03

34.17

61.34

13.75
✓ N. cor. N.W. of old S. Spk. 13.75
✓ N. cor. N.W. of old S. Spk. 13.75
~~Shiner in P.P. 35.06~~
✓ Shiner in P.P. S.W. 35.06 35.06
✓ Shiner in T.P. S.E. 35.06 35.06
✓ Shiner in T.P. East 61.34

PERSONNEL	TITLE	PERSONNEL	TITLE

COUNTY Wood

DATE OK 12-13-57

S. R. #69

WEATHER 4-15-60
1-20-66

SEC.

TEMP.

DESCRIPTION

LEFT

CENTER LINE

RIGHT

JOB NO.

#76

N.W. 1/4 Sec. 24. Stone 10.9' E.
of edge part. & W. bank dch. ✓

✓ Shiner in End Post of fence 37.13
 ✓ Iron pipe W. 30.30
 ✓ T.P. N. of W. 69.35' 69.50'

#76-A

N.W. Cor. Sec. 24 Milton
Twp. Merrill Rd.
R.R. Spk. ✓

57.00
 ✓ Shiner in 24" maple N.W. 57.1
 ✓ Shiner in T.P. S.W. 51.25
 ✓ Shiner in T.P. N.E. 35.80 35.75
 ✓ X in S.W. Cor of old S. abut. S.E. 15.93

#77

20

#78

#79

E 1/4 past Sec. 14 Milton
Twp. Stone 8' below surface
of part. 6' W. of E. Edge part.
of pavement. R.R. Spk. ✓

✓ Shiner in T. Pole N.N.E. 113.05
 ✓ Shiner in P.P. N.W. 40.07 40.02
~~Shiner in Cor. post W. 27.93 27.84~~
~~Stone on E. bank of dch. E. gone 25.53~~
 ✓ Shiner in T.P. S.E. 35.66' 35.82

#80

21

N.E. Cor. Sec. 14 Milton Twp.
Stone 0.6' deep R.R. Spk.
Maplewood Ed. ✓

13.95'
 ✓ N. Cor. N. wing of W. abut. Spk. W. 15.0'
 ✓ N. Cor. N. wing of E. abut. Spk. E. 14.16' 15.1'
~~Shiner in P.P. N.W. Gone 42.55~~
 ✓ Shiner in P.P. S.W. 35.06' 32.40'
 ✓ Shiner in T.P. S.E. Plumb 34.17 34.39
 ✓ Shiner in T. Pole East 61.34'

22

#81