

O.D.O.T. DISTRICT 2 SURVEY OFFICE (USE ONLY)

PERSONNEL

REFERENCE NO. 4

SHEET 4 OF 15

NOTES HOMAN

DATE 7/1/14

ROUTE SR 281

H.C. LEU

WEATHER CLOUDY

COUNTY WOOD

R.C. MEYER

TEMP. 75°

TOWNSHIP MILTON

SECTION 19

DWG BY RHOADES

PID CHIP
SEAL

T 4 N R 9 E

TYPE MONUMENT MAG/WASHER

ON SURFACE - ~~BELOW~~ ON

OFFSET CL PAVEMENT ON LT : RT

9.9' TO LT EDGE PAVEMENT 20.7' LT OF CL N.



STATION: 52+95

HORZ.DATUM: NAD83 2011

GEOID: NAVD88 2018

GRID: NORTHING: 592392.804

EASTING: 1593800.730

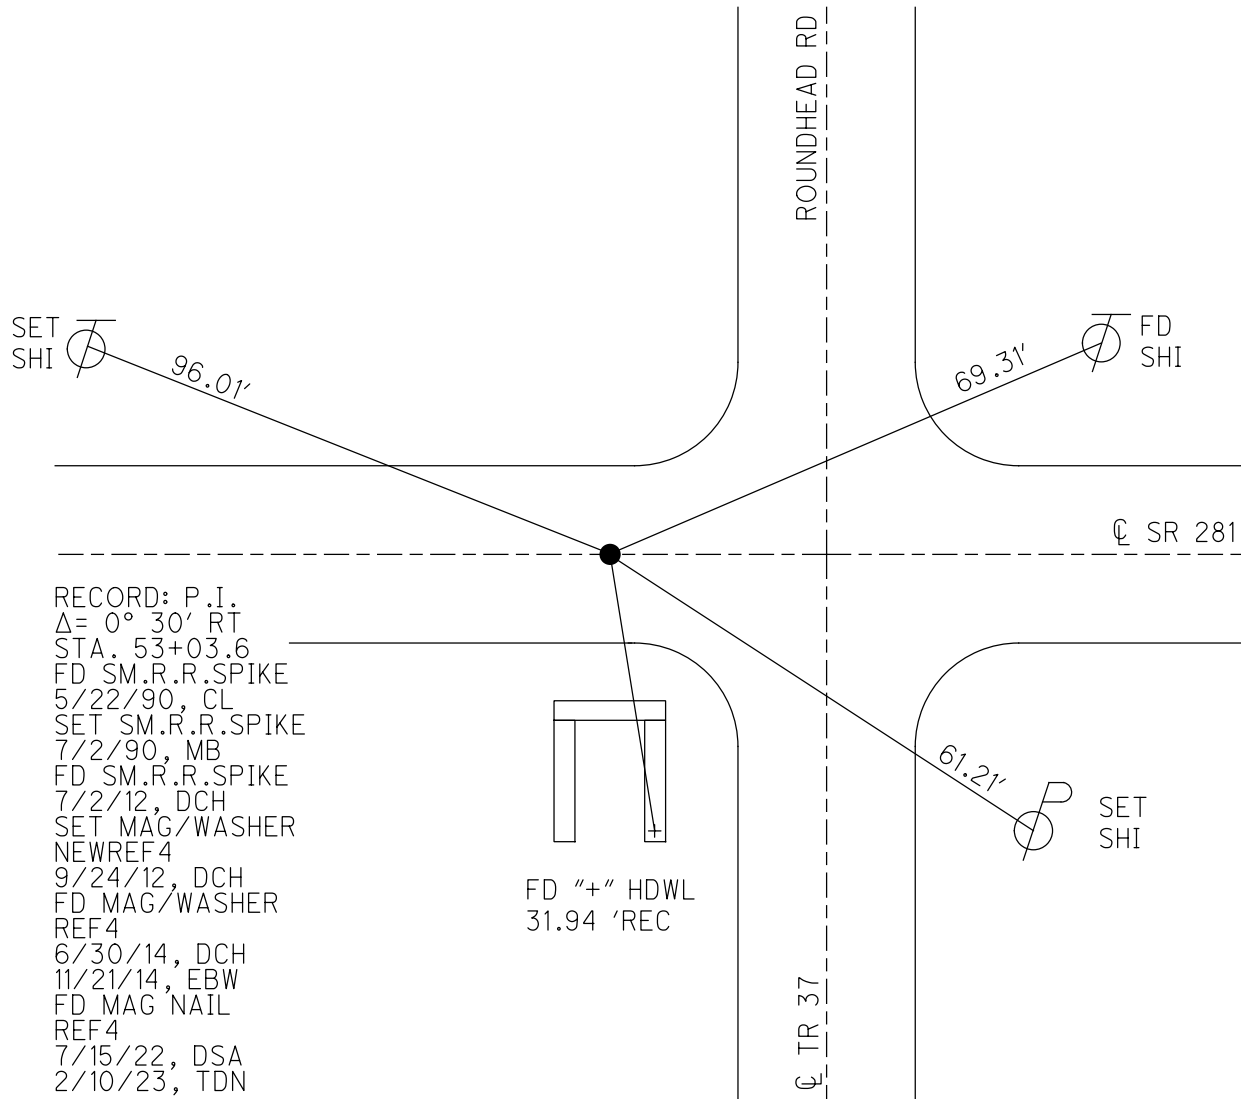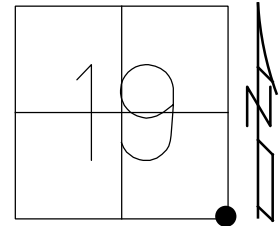

RECORD: P.I.
 $\Delta = 0^\circ 30' \text{ RT}$
STA. 53+03.6
FD SM.R.R.SPIKE
5/22/90, CL
SET SM.R.R.SPIKE
7/2/90, MB
FD SM.R.R.SPIKE
7/2/12, DCH
SET MAG/WASHER
NEWREF4
9/24/12, DCH
FD MAG/WASHER
REF4
6/30/14, DCH
11/21/14, EBW
FD MAG NAIL
REF4
7/15/22, DSA
2/10/23, TDN

O.D.O.T. DISTRICT 2 SURVEY OFFICE (USE ONLY)

PERSONNEL

REFERENCE NO. 4

SHEET 4 OF 15

NOTES HOMAN

DATE 7/1/14

ROUTE SR 281

H.C. LEU

WEATHER CLOUDY

COUNTY WOOD

R.C. MEYER

TEMP. 75°

TOWNSHIP MILTON

SECTION 19

DWG BY ROHOADES

PID 92214

T 4 N R 9 E

TYPE MONUMENT MAG/WASHER

ON SURFACE - ~~BELOW~~ ON

OFFSET CL PAVEMENT ON LT : RT
9.9' TO LT EDGE PAVEMENT (20.7' LT OF CL N.)



STATION: 52+95

HORIZ.DATUM: NAD83 2011

GEOID: NAVD88 2012A

GRID: NORTHING: 592393.022

EASTING: 1593800.705

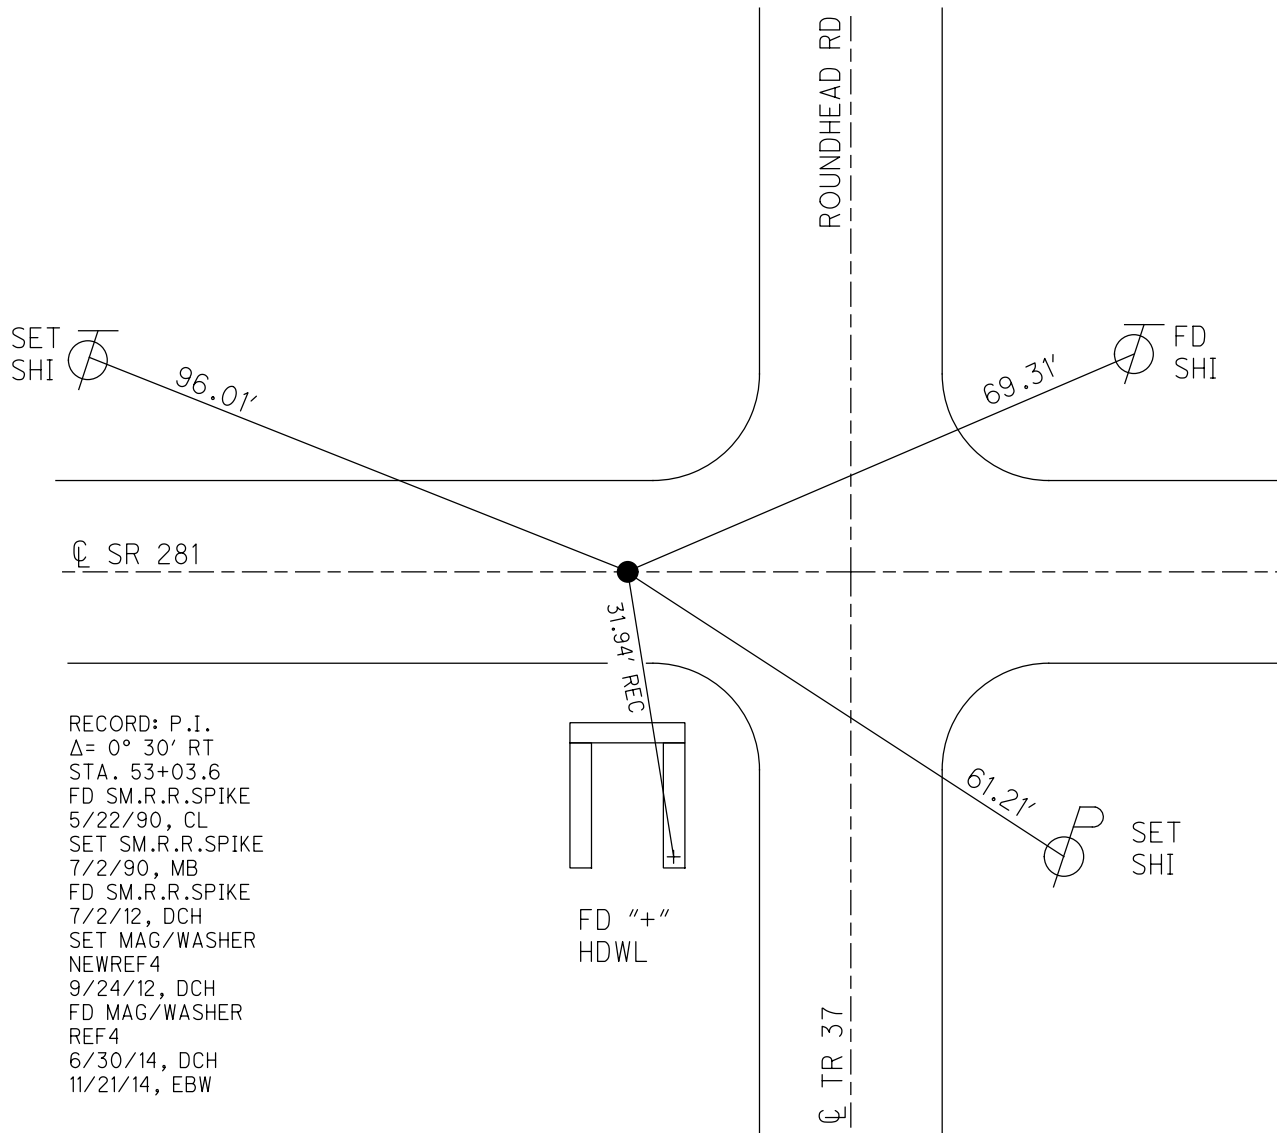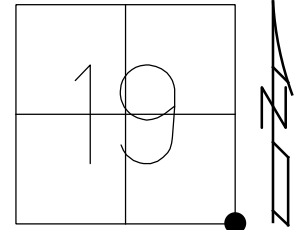

RECORD: P.I.
 $\Delta = 0^\circ 30' \text{ RT}$
STA. 53+03.6
FD SM.R.R.SPIKE
5/22/90, CL
SET SM.R.R.SPIKE
7/2/90, MB
FD SM.R.R.SPIKE
7/2/12, DCH
SET MAG/WASHER
NEWREF4
9/24/12, DCH
FD MAG/WASHER
REF4
6/30/14, DCH
11/21/14, EBW

O.D.O.T. DISTRICT 2 SURVEY OFFICE (USE ONLY)

PERSONNEL

REFERENCE NO. 4

SHEET 4 OF 15

NOTES
H.C. HOMAN
R.C. ROUSOS
HOMAN

DATE 7/2/12
WEATHER SUNNY
TEMP. 75°

ROUTE SR 281
COUNTY WOOD
TOWNSHIP MILTON
SECTION 19
T 4 N R 9 E

TYPE MONUMENT SM.R.R.SPIKE


ON SURFACE - ~~BELOW~~ ON

LEFT - Q PAV'T - RIGHT ON

9.9' TO LT EDGE PAVEMENT (20.7' LT OF Q N.)

S.L.M. 52+95

GRID: NORTHING: 592393.022 EASTING: 1593800.705

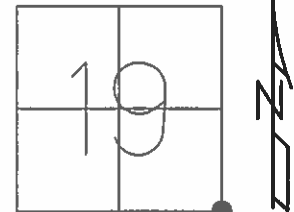

RECORD:


$\Delta = 0^\circ 30' RT$
STA. 53+03.6

FD SM.R.R.SPIKE
5/22/90, CL

SET SM.R.R.SPIKE
7/2/90, MB

FD SM.R.R.SPIKE
7/2/12, DCH

SET MAG/WASHER
GPS, NEWREF4
9/24/12, DCH

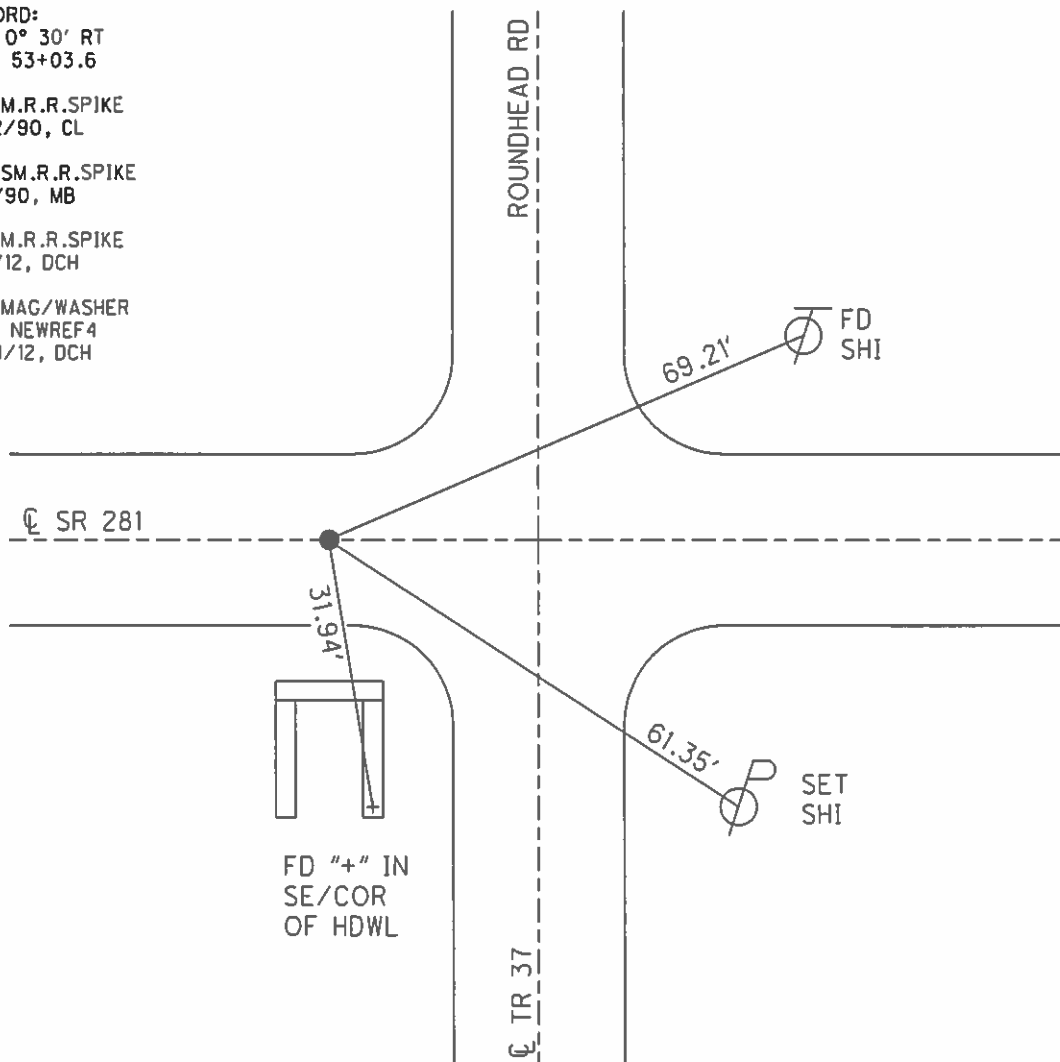

O.D.O.T. DISTRICT 2 SURVEY OFFICE

PERSONNEL

REFERENCE NO. 4

SHEET _____ OF _____

NOTES BARNHISEL

H.C. Loehrke

DATE 5-22-90

ROUTE 281

R.C. HOFFMAN

WEATHER WINDY

COUNTY Wood

TEMP. + 62°

TOWNSHIP Milton

SECTION 19

T4NR9E

TYPE MONUMENT Sm RE Spk


ON SURFACE - ~~BELOW~~ yes

LEFT - & PAN'T. - RIGHT yes

9.9 TO LT EDGE PAVEMENT

S.L.M. 52+95

20.7 LT OF E NORTH

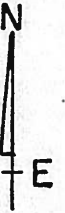


RECORD:

$$\Delta = 0^\circ - 30' \text{ Et}$$

STA: 53+03.6 OLD =
53+04.2 NEW

Set Sm RR Spk
7-2-90
MB

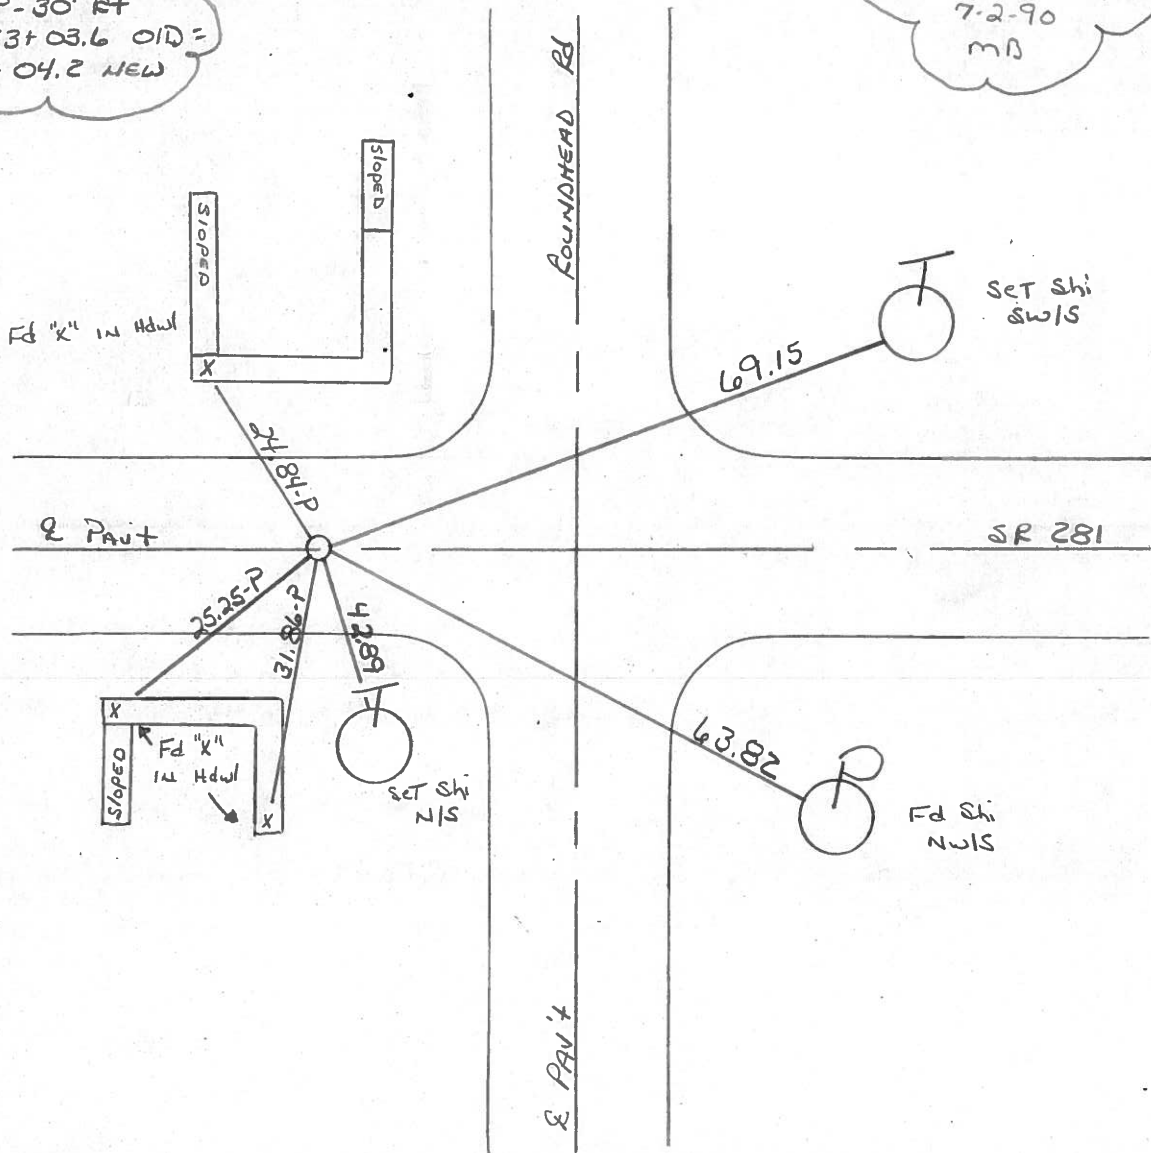

O.D.O.T. DISTRICT 2 SURVEY OFFICE

SHEET

OF

County Wood S.R. 281

Township Milton

Section 19

T4N, R9E

Personnel S. Hoffman


C. Loehrke

L. Householder

Date 5-19-81 8:24-81


Weather PART. Cloudy - Windy

Temp. 58°

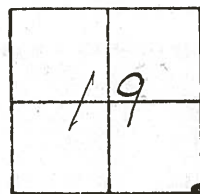

#4

STA. 53+03.6 OLD =
53+04.2 NEW.
 $\Delta = 0^\circ - 30'$ RT.

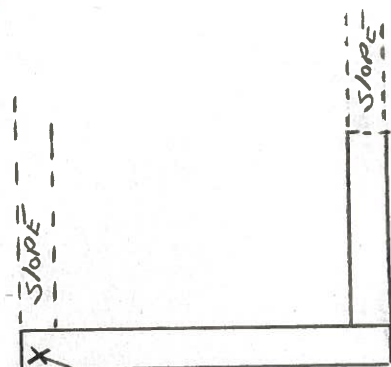


"+" CUT SW COR
W. END CONC ABUT

281

24.82 (D)

25.27 (D)

CUT "+"
W. END
CONC. ABUT

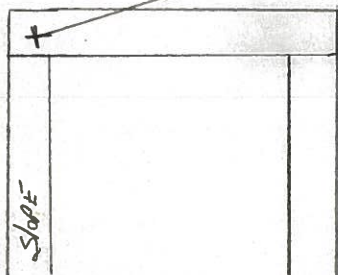

31.91 (D)

"+"
S.E. CORNER
S. END
CONC. ABUT.

Roundhead Rd.

69.14 (D)
SHINER
S.W. SIDE

Found ^{BOAT} SMALL SPK @ SURFACE OVER STONE

SET SMALL R.R. SPK.
ON 281

63.88 (D)

SHINER
N.W. SIDE

O.D.O.T. DISTRICT 2 SURVEY OFFICE

SHEET

OF

County Wood S.R. 281

Township M. 1 T. 1

Section 19

T4N, R9E

Personnel S. Hoffman


C. Loehrke

L. Householder

Date 5-19-81 8-24-81

Weather PART. Cloudy - Windy

Temp. 58°

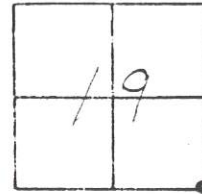

STA. 53 + 03.6 OLD =
53 + 04.2 NEW.
 $\Delta = 0^\circ - 30'$ RT.

ON $\angle$ 281

20.7 LT OF $\angle$ N.

9.9 TO LT ES

SET
SHINER
S.W./SIDE

15
69.14 (D)

BOAT
Found small SPK @ SURFACE OVER STONE

SET SMALL RR. SPK.
ON $\angle$ POINT 281

63.88 (D)
1.82

SET
SHINER
N.W./SIDE

25.27 (D)
25 - P

86 - P
31.91 (D)
SET
HIS



"+"
S.E. CORNER
S. END
CONC. ABUT.

Roundhead Rd.

"+" CUT SW COR
W. END CONC ABUT

$\angle$ 281

CUT "+"
W. END
CONC. ABUT

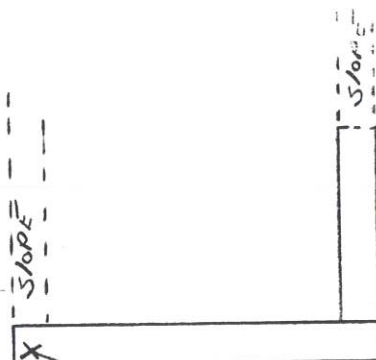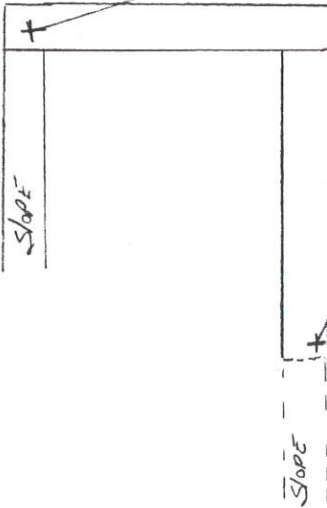

PERSONNEL TITLE PERSONNEL TITLE
 CK. BY TAG COUNTY Wood DATE OK-11-18-71
 SILVESTER S. R. #281 WEATHER
 BURNSIDE
 SMITH SEC. 20 TEMP.

DESCRIPTION CONTROL TIES JOB NO.
 LEFT CENTER LINE RIGHT

STA. 79+87.4
 S $\frac{1}{4}$ POST SEC 20
 MILTON TWP.
 T-4-N R-9-E
 $\Delta = 0^\circ - 8^\circ 30' RT.$
 "STONE" SET BOAT SPK.
 (WENTZ ROAD)

#147

#5

"X" N.W. COR. WINGWALL N.E. 35.4
 "X" S.W. COR. WINGWALL S.E. 35.0
 N.E. COR. HOUSE 2' ABOVE GND S.W. 77.4
 SHINER T. POLE N.W. 43.1
 SHINER 12" PINE S.W. 63.1

STA. 53+03.6 (OLD) = 53+04.2
 S.W. COR. SEC. 20
 MILTON TWP.
 T-4-N R-9-E
 $\Delta = 0^\circ - 30' RT.$
 "STONE" SET BOAT SPK.
 (ROUND HEAD ROAD)

#146

#4

"X" ON S. CULVERT ABUT. S. 31.92
 SHINER P. POLE S.E. 62.65
 "X" N.W. COR. S. CULVERT ABUT. 25.2
 "X" S.W. COR. N. CULVERT ABUT. 24.8

STA. 26+00.8

(DID NOT FIND)
 (12-2-57 & 4-27-70)

#145

PERSONNEL TITLE PERSONNEL TITLE

COUNTY Wood

DATE OK 12-3-57

S. R. #281

Sworden 3-22-64

Knebe 11-3-64

2-28-64

SEC.

TEMP.

DESCRIPTION

LEFT

CENTER LINE

RIGHT

JOB NO.

Sta. 53+0.36 (old) = 53+0.42

S.W. Cor. sec. 20 Milton

Twp. Stone - Iron rod (Fd)

 $\Delta = 0^\circ - 30' \text{ Rt.}$ (Roundhead Rd.)

(4)

#146

set
P.K. Nail

S. to X on S. culvert about.

31.1

31.2

S.E. to shiner in P.P. 62.65' 62.

X in N.W. Cor. of S. culvert about. 25.26' 25.

X in S.W. Cor. of N. culvert about. 24.

Sta. 79+87.4

S. 1/4 post sec. 20 Milton

Twp. Stone - Iron pin (Fd)

 $\Delta = 0^\circ - 8\frac{1}{2}' \text{ Rt.}$ (Wentz Rd.)

(5)

#147

X on N.W. Cor. W. wall N.E. 35.40' 35.

X on S.W. Cor. W. wall S.E. 35.02' 34.

N.E. Cor. of house 2' above gnd. S.W. 77.

Shiner in Tele. Pole N.W. 43.5

Sta. 93+33.6

S.E. 1/8 post sec. 20 W. Corp.

line Custer (Fd I. Rod)

No Angle

(5-A)

#147-A

set
P.K. Nail

Face leaning

Steel sign post N. 33.54' 33.

Steel sign post S.W. 42.38' 42.

N. Steel Sign Post Corp. sign 22.4

Sta. 106+83.16
R.R. Spike in center of
S.R. #281 & Custer Rd.

(Fd)

(6)

#148

Shiner in P. Pole N.E. 51.1

Well pump casing S.W. 41.03' 40.8

N. pt. Gas pump island S.E. 69.3

N.E. to stone fln. store 46.20' 46.1

Shiner P. Pole S.W. 39.49

Shiner P. Pole N.E. 50.6

Shiner 12" Walnut N.W. 67.83

.70