

O.D.O.T. DISTRICT 2 SURVEY OFFICE (USE ONLY)

PERSONNEL

REFERENCE NO. 5

SHEET 5 OF 15

NOTES HOMAN

DATE 7/1/14

ROUTE SR 281

H.C. LEU

WEATHER CLOUDY

COUNTY WOOD

R.C. MEYER

TEMP. 75°

TOWNSHIP MILTON

SECTION 20

DWG BY RHOADES

PID CHIP SEAL

T 4 N R 9 E

TYPE MONUMENT MAG/WASHER

ON SURFACE - ~~BELOW~~ ON

OFFSET CL PAVEMENT ON LT : RT

- TO LT EDGE PAVEMENT


STATION: 79+91

HORZ.DATUM: NAD83 2011


GEOID: NAVD88 2018

GRID: NORTHING: 592343.193

EASTING: 1596494.809

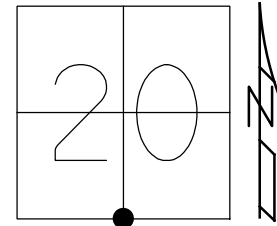

RECORD: P.I.
 $\Delta = 0^\circ 8' 30''$ RT
STA. 74+87.4
FD STONE
FD SM.R.R.SPIKE
5/22/90, CL
SET SM.R.R.SPIKE
7/2/90, MB
FD SM.R.R.SPIKE
7/2/12, DCH
SET MAG/WASHER
NEWREF4
9/24/12, DCH
FD MAG/WASHER
REF3
6/30/14, DCH
11/21/14, EBW
FD MAG NAIL
REF5
7/15/22, DSA
2/10/23, TDN

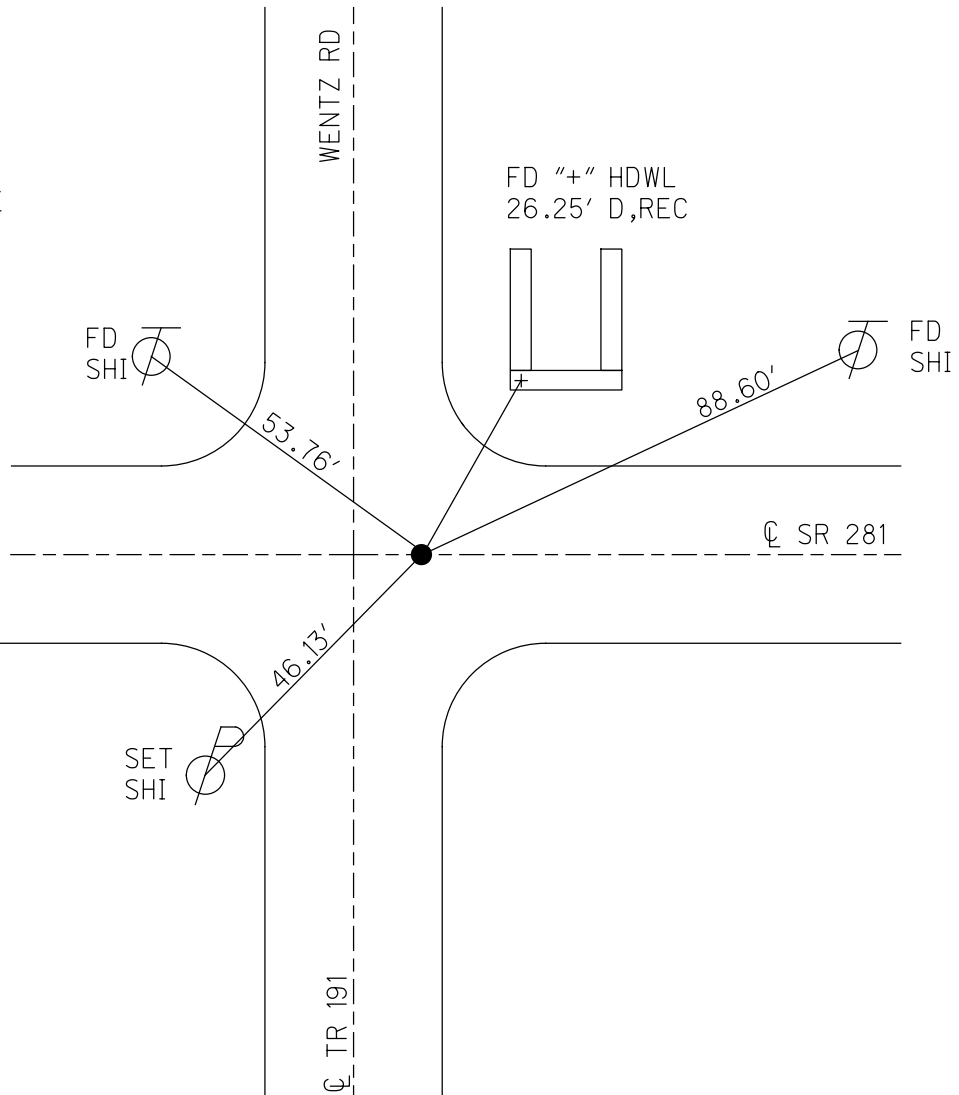

O.D.O.T. DISTRICT 2 SURVEY OFFICE (USE ONLY)

PERSONNEL

REFERENCE NO. 5

SHEET 5 OF 15

NOTES HOMAN

DATE 7/1/14

ROUTE SR 281

H.C. LEU

WEATHER CLOUDY

COUNTY WOOD

R.C. MEYER

TEMP. 75°

TOWNSHIP MILTON

SECTION 20

DWG BY ROHOADES

PID 92214

T 4 N R 9 E

TYPE MONUMENT MAG/WASHER

ON SURFACE - ~~BELOW~~ ON

OFFSET Q PAVEMENT ON LT : RT

- TO - EDGE PAVEMENT


STATION: 79+91

HORZ.DATUM: NAD83 2011


GEOID: NAVD88 2012A

GRID: NORTHING: 592343.256

EASTING: 1596494.706

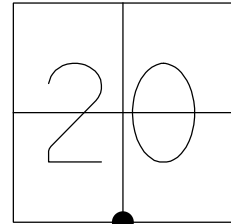


RECORD: P.I.
 $\Delta = 0^\circ 8' 30''$ RT
STA. 74+87.4
FD STONE
FD SM.R.R.SPIKE
5/22/90, CL
SET SM.R.R.SPIKE
7/2/90, MB
FD SM.R.R.SPIKE
7/2/12, DCH
SET MAG/WASHER
NEWREF4
9/24/12, DCH
FD MAG/WASHER
REF3
6/30/14, DCH
11/21/14, EBW

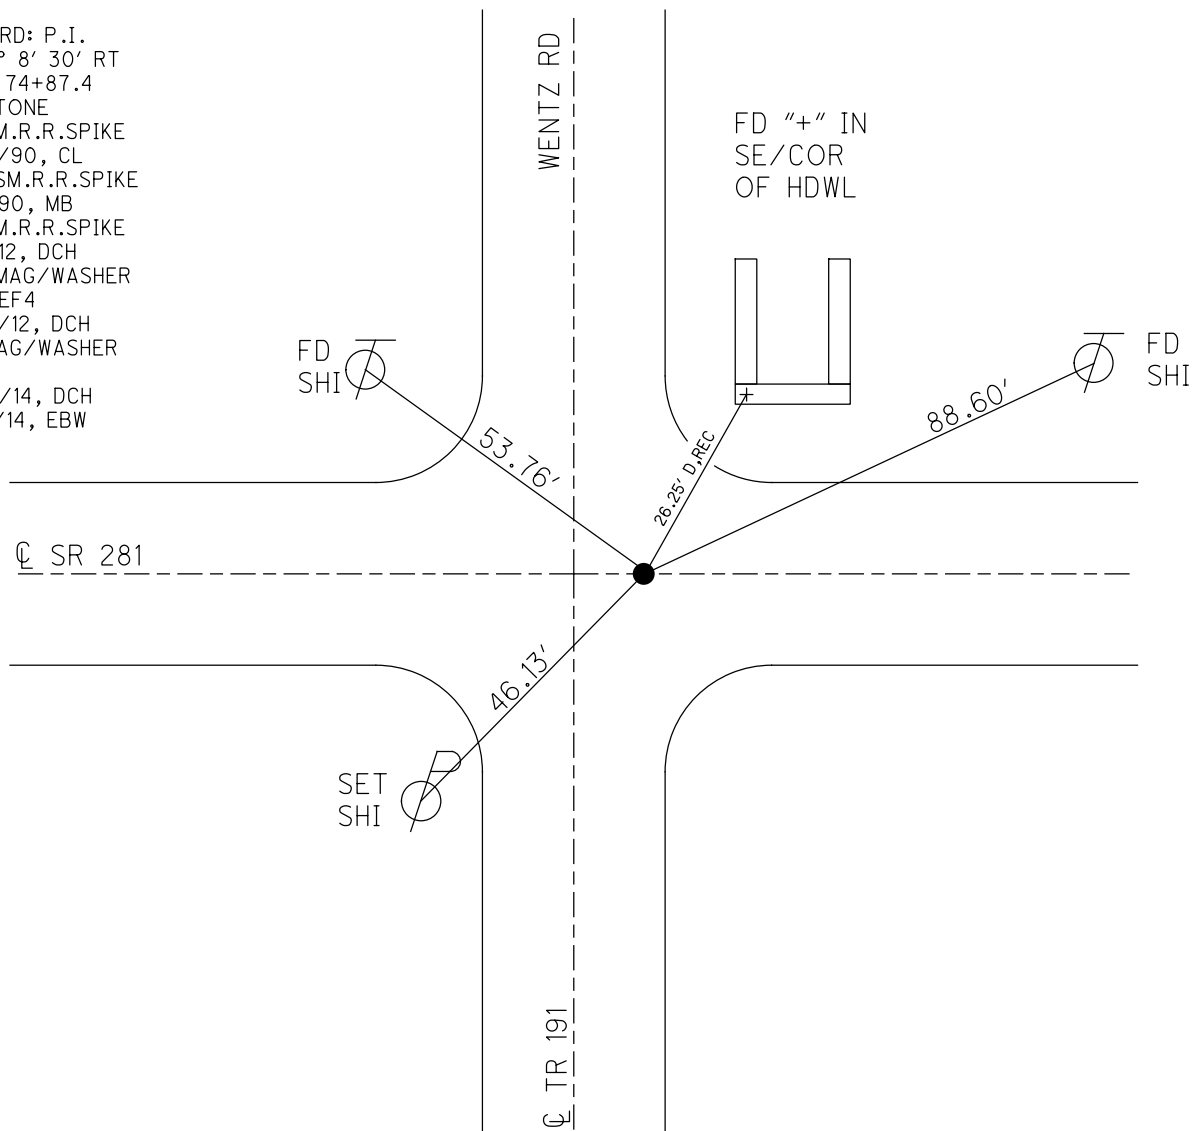

PERSONNEL	REFERENCE NO.	5	SHEET	5	OF	15
NOTES	HOMAN	DATE	7/2/12	ROUTE	SR 281	
H.C.	ROUSOS	WEATHER	SUNNY	COUNTY	WOOD	
R.C.	HOMAN	TEMP.	75°	TOWNSHIP	MILTON	
				SECTION	20	
				T	4	N
				R	9	E

TYPE MONUMENT SM.R.R.SPIKE
ON SURFACE - ~~BELOW~~ ON
LEFT - C PAV'T - RIGHT ON
- TO - EDGE PAVEMENT
S.L.M. 79+91

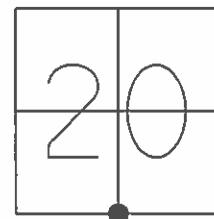

GRID: NORTHING: 592343.256 EASTING: 1596494.706

RECORD:
 $\Delta = 0^\circ 8' 30''$ RT
 STA. 74+87.4
 FD STONE


FD SM.R.R.SPIKE
5/22/90, CL

SET SM.R.R.SPIKE
7/2/90, MB

FD SM.R.R.SPIKE
7/2/12, DCH

SET MAG/WASHER
GPS, NEWREF5
9/24/12, DCH

FD "+" IN
SE/COR
OF HDWL

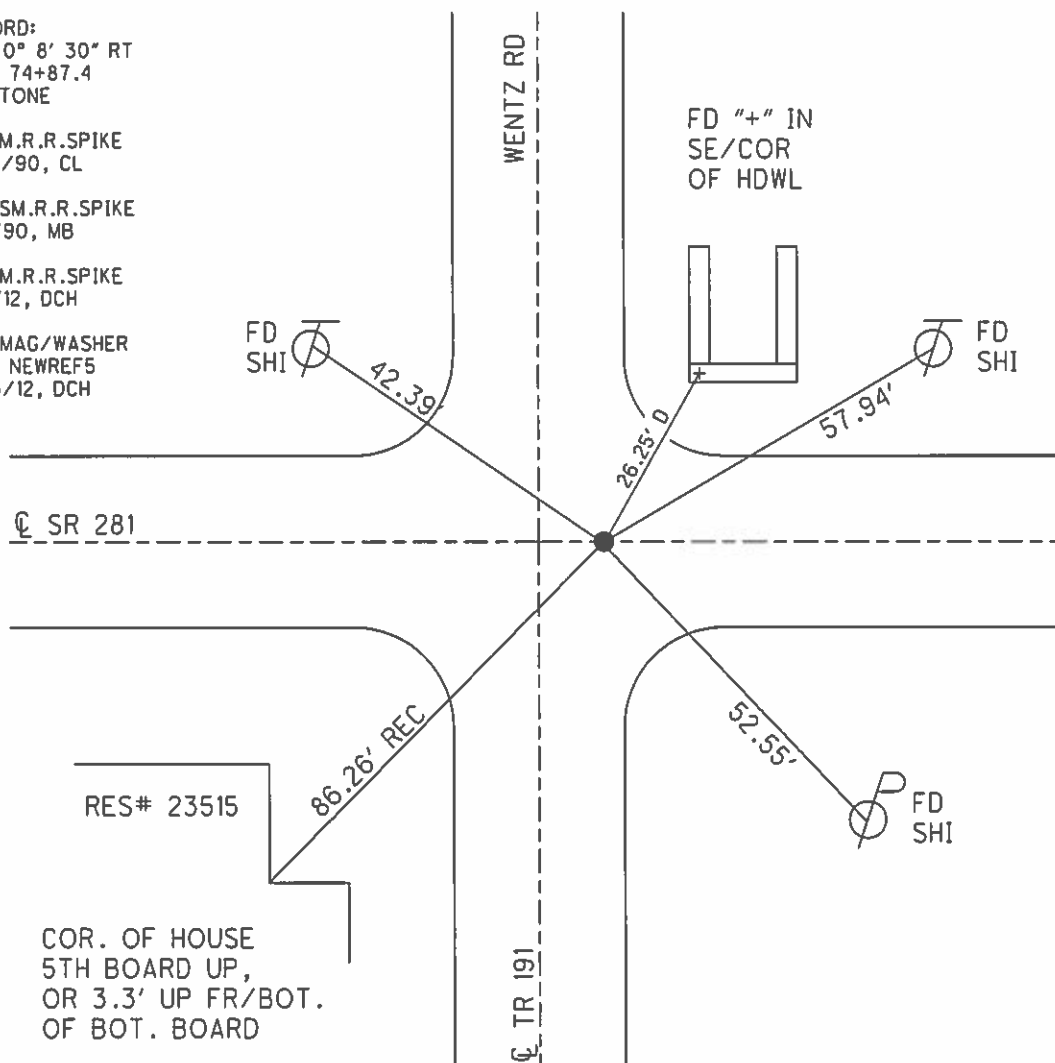

O.D.O.T. DISTRICT 2 SURVEY OFFICE

PERSONNEL

REFERENCE NO. 5

SHEET OF

NOTES BARNHISEL

H.C. Loehake

R.C. HOFFMAN

DATE 5-22-90

WEATHER WINDY

TEMP. +62°

ROUTE 281

COUNTY WOOD

TOWNSHIP MILTON

SECTION 20

T 4 N R 9 E


TYPE MONUMENT Sm RR Spk

ON SURFACE - BELOW yes

LEFT - ℄ PAV'T. - RIGHT yes


- TO - EDGE PAVEMENT

S.L.M. 79+91 6.0 RT OF ℄ NORTH

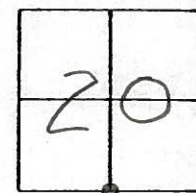

RECORD
Δ: 0°-8'-30" RT
STA: 74+87.4
"STONE"

Set Sm RR Spk
7-2-90
MB

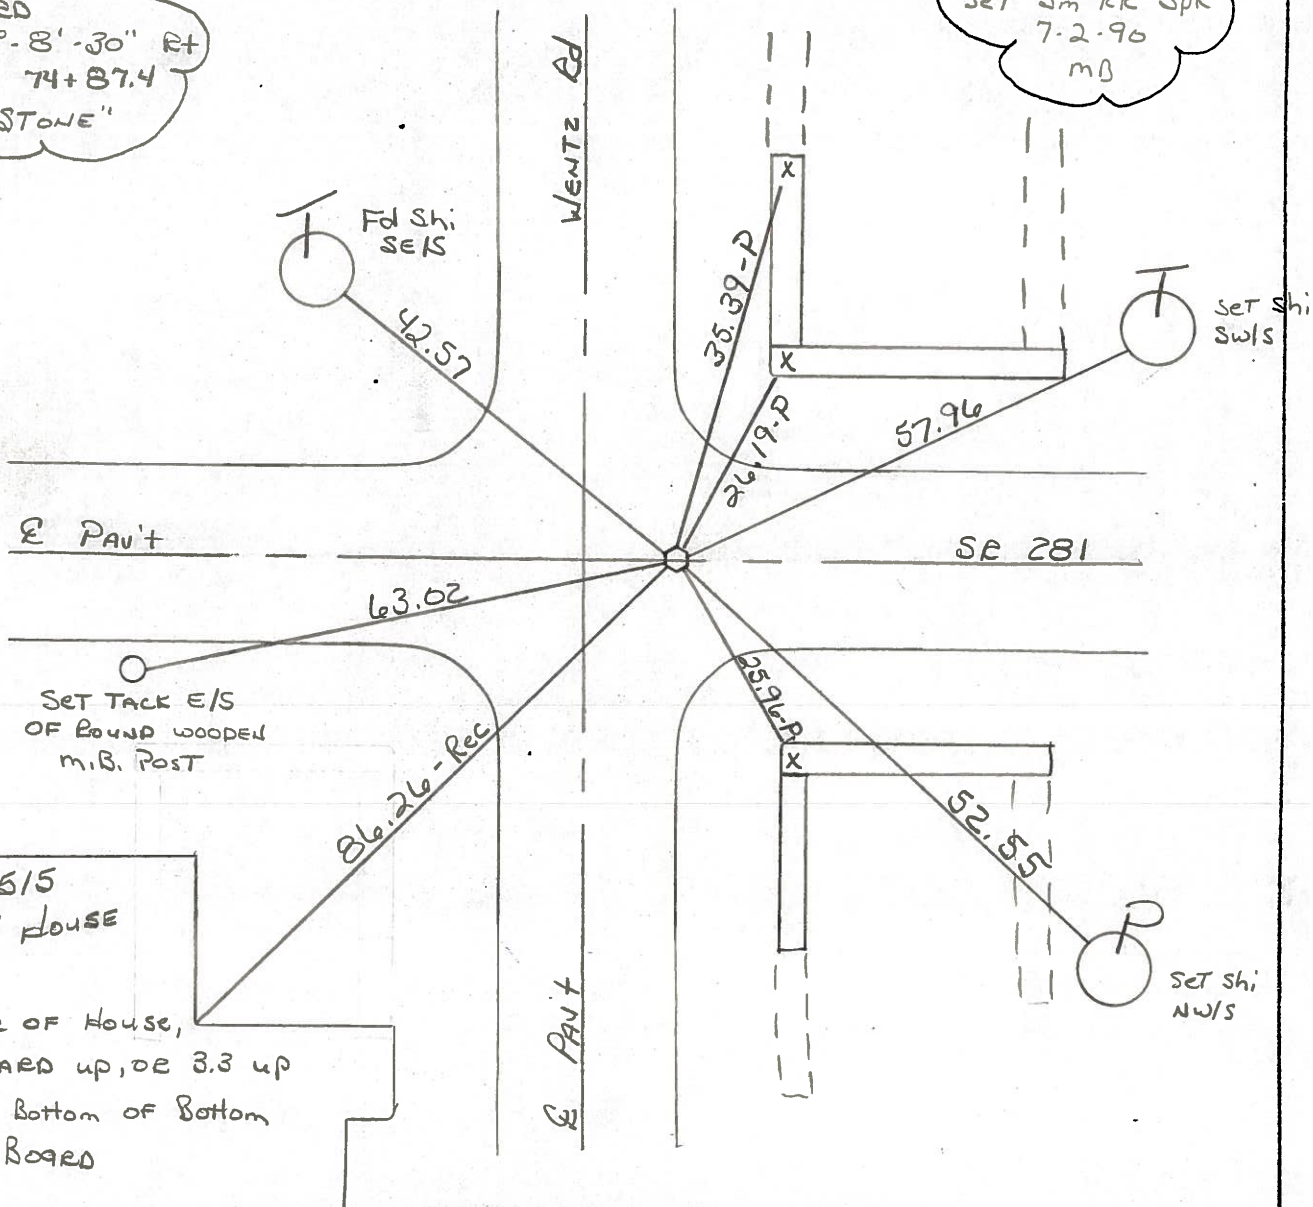

ODOT DISTRICT 2 SURVEY OFFICE

SHEET

OF

County Wood S.R. 281

Township MILTON

Section 20

T4N, R9E

Personnel S. Hoffmann


C. Loehrke

L. Householder

Date 5-19-81 - 5-24-81

Weather SUNNY - WINDY

Temp. 60°

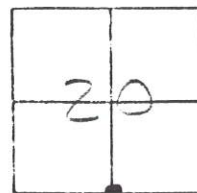

#5

Q OF 281
6.0 E. OF N. Rd
79+91

STA. 79+87.4
 $\Delta = 0^\circ - 8' - 30''$ RT.
"STONE"

SET SMALL
R.R. SPR.
0.40' NO OF $\pm$ 281

N. W. COR
@ N. END

SLOPE

SLOPE

SET SWIS
⊕

CTR @ W. END

57.96

FOUND BOAT SPR 1" below surface

$\pm$ 281

0 m.B.
WOODEN POST
SET TACK

SHINER
S.E. SIDE

42.51- Δ
35.40- Δ
26.21- Δ
17.1- Δ

REC.
86.26- Δ

42.51- Δ

39.1- Δ
35.40- Δ
26.21- Δ
17.1- Δ

CTR @ W. END

~~SW COR~~
@ S. END

SLOPE

SLOPE

52.55

SET NWIS
⊕

WENTZ Road

#23515

CORNER of
HOUSE, 5" BOARD UP
OR 3.3' UP FROM
BOTTOM of BOTTOM
BOARD.

ODOT DISTRICT 2 SURVEY OFFICE

SHEET

OF

County Wood S.R. 281

Township MILTON

Section 20

T4N, R9E

Personnel S. Hoffmann


C. Loehrke

L. Householder

Date 5-19-81 - 8-24-81

Weather SUNNY - Windy

Temp. 60°

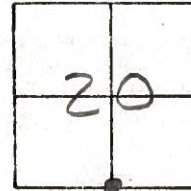

#5

STA. 79+87.4
Δ = 0° - 8' - 30" RT.
"STONE"

SET SMALL

R.R. SPK.

0.40' No of Δ 281

Δ 281

#23515

CORNER of
HOUSE, 5th BOARD UP
OR 3.3' UP FROM
BOTTOM of BOTTOM
BOARD.

SHINER
S.E. SIDE

N.W. COR
@ N. END

SLOPE

SLOPE

CTR @ W. END

FOUND BOAT SPK 1" below surface

86.26-D

35.40-D
26.21-D

26.01-D
35.01-D

CTR @ W. END

S.W. COR
@ S. END

SLOPE

SLOPE

LEWENTZ Road

PERSONNEL TITLE PERSONNEL TITLE

CK. BY

COUNTY WOODDATE OK-11-18-7

SILVESTER

S. R. #281

WEATHER

BURNSIDE

SMITH

SEC. 20

TEMP

DESCRIPTION

CONTROL TIES

JOB NO.

LEFT

CENTER LINE

RIGHT

STA. 79+87.4

S 1/4 POST SEC 20

MILTON TWP.

T-4-N R-9-E

 $\Delta = 0^\circ - 8' - 30''$ RT.

"STONE" SET BOAT SPK.

(WENTZ ROAD)

#147

#5

"X" N.W. COR. WINGWALL N.E. 35.4

"X" S.W. COR. WINGWALL S.E. 35.0

N.E. COR. HOUSE 2' ABOVE GND S.W. 77.4

SHINER T. POLE N.W. 43.2

SHINER 12" PINE S.W. 63.2

STA. 53+03.6 (OLD) = 53+04.2

S.W. COR. SEC. 20

MILTON TWP.

T-4-N R-9-E

 $\Delta = 0^\circ - 30'$ RT.

"STONE" SET BOAT SPK.

(ROUND HEAD ROAD)

#146

#4

"X" ON S. CULVERT ABUT. S. 31.92

SHINER P. POLE S.E. 62.65

"X" N.W. COR. S. CULVERT ABUT. 25.2

"X" S.W. COR. N. CULVERT ABUT. 24.8

STA. 26+00.8

(DID NOT FIND)

(12-2-57 & 4-27-70)

#145

PERSONNEL	TITLE	PERSONNEL	TITLE

COUNTY Wood DATE OK 12-3-57
 S. R. #281 Sworden 3-22-60
 WEATHER Knebe 11-3-60
 SEC. _____ TEMP. 2-28-64

DESCRIPTION	LEFT	CENTER LINE	RIGHT	JOB NO.
Sta. 53+0.36 (old) = 53+0.42 S.W. Cor. sec. 20 Milton Twp. Stone - Iron rod (Fd) $\Delta = 0^\circ - 30' E.$ (Roundhead Rd.) (4) #146		Set P.K. Nail	S. to X on S. culvert about 31.5 S.E. to shiner in P.P. 62.65' 62. X in N.W. Cor. of S. culvert about 25.26' 25. X in S.W. Cor. of N. culvert about 24.	
Sta. 79+87.4 S 1/4 post sec. 20 Milton Twp. Stone - Iron pin (Fd) $\Delta = 0^\circ - 8 1/2' E.$ (Wentz Rd.) (5) #147			X on N.W. Cor. W. wall N.E. 35.40' 35. X on S.W. Cor. W. wall S.E. 35.02' 34. N.E. Cor. of house 2' above gnd. S.W. 77. Shiner in Tele. Pole N.W. 43.5	
Sta. 93+33.6 S.E. 1/8 post sec. 20 U. Corp. line Custer (Fd I. Rod) No Angle (5-A) #147-A		Set P.K. Nail	Face leaning Steel sign post N. 33.54' 33. Steel sign post S.W. 42.38' 42. N. Steel Sign Post S.E. sign 22.4	
Sta. 106+83.16 R.R. Spike in center of S.R. #281 & Custer Rd. (6) #148		(Fd)	Shiner in P. Pole N.E. 51.1 Well pump casing 1" above cap S.W. 41.03' 40.8 N. pt. Gas pump Island S.E. 69.3 N.E. to stone fdn. store 46.20' 46.1 Shiner P. Pole S.W. 39.44 Shiner P. Pole N.E. 50.6 Shiner 12" Walnut N.W. 67.83 70	