

O.D.O.T. DISTRICT 2 SURVEY OFFICE (USE ONLY)

PERSONNEL

REFERENCE NO. 5 A

SHEET 6 OF 15

NOTES HOMAN

DATE 7/2/12

ROUTE SR 281

H.C. LEU

WEATHER SUNNY

COUNTY WOOD

R.C. MEYER

TEMP. 75°

TOWNSHIP MILTON

SECTION 20

DWG BY RHOADES

PID CHIP SEAL

T 4 N R 9 E

TYPE MONUMENT SM.R.R.SPIKE

ON SURFACE - ~~BELOW~~ ON

OFFSET CL PAVEMENT 3.8' LT : ~~RT~~

5.7' TO LT EDGE PAVEMENT


STATION: 93+38

HORZ.DATUM: NAD83 2011

GEOID: NAVD88 2018

GRID: NORTHING: 592315.128

EASTING: 1597840.761

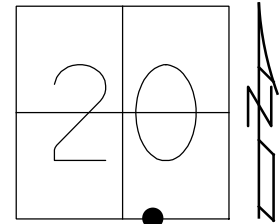

RECORD:

STA. 93+33.6

FD SM.R.R.SPIKE

5/22/90, CL

SET SM.R.R.SPIKE

7/2/90, MB

FD SM.R.R.SPIKE

7/2/12, DCH

SET MAG/WASHER

NEWREFA5


9/24/12, DCH

FD MAG/WASHER

REFA5

7/15/22, DSA


2/10/23, TDN

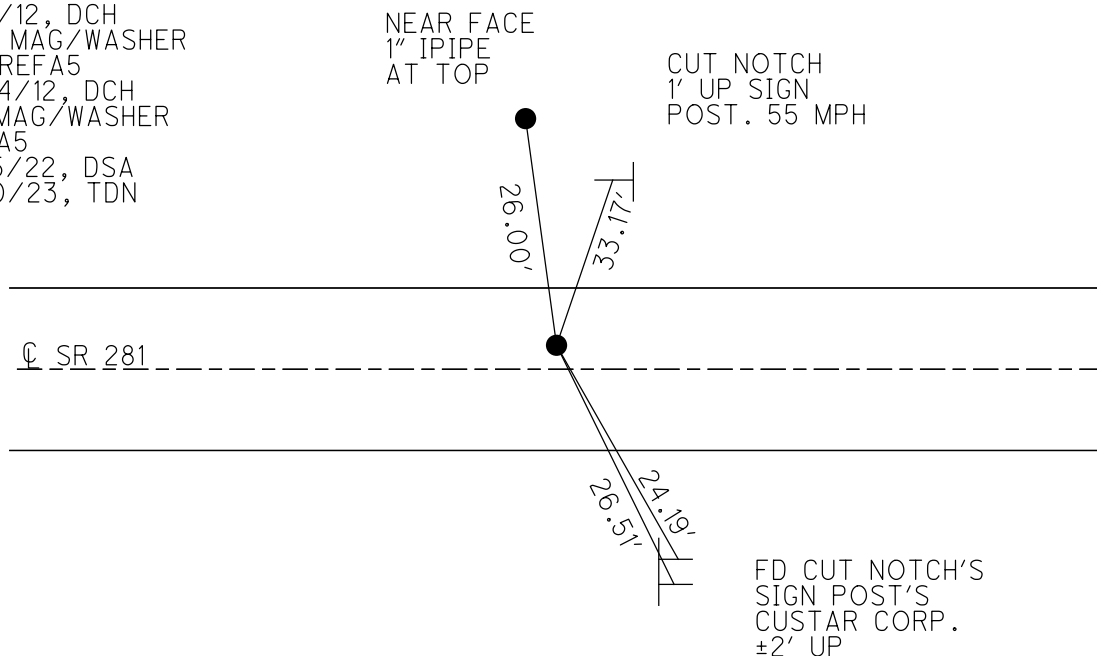

O.D.O.T. DISTRICT 2 SURVEY OFFICE (USE ONLY)

PERSONNEL _____ REFERENCE NO. 5 A SHEET 6 OF 15
 NOTES HOMAN DATE 7/2/12 ROUTE SR 281
 H.C. ROUSOS WEATHER SUNNY COUNTY WOOD
 R.C. HOMAN TEMP. 75° TOWNSHIP MILTON
 SECTION 20
T 4 N R 9 E

TYPE MONUMENT SM.R.R.SPIKE
 ON SURFACE - ~~BELOW~~ ON
 LEFT - CL PAV'T - ~~RIGHT~~ 3.8'
5.7' TO LT EDGE PAVEMENT
 S.L.M. 93+38

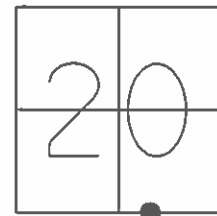

GRID: NORTHING: 592315.113 EASTING: 1597840.678


RECORD:
 STA. 93+33.6

FD SM.R.R.SPIKE
 5/22/90, CL

SET SM.R.R.SPIKE
 7/2/90, MB

FD SM.R.R.SPIKE
 7/2/12, DCH

SET MAG/WASHER
 GPS, NEWREFA5
 9/24/12, DCH

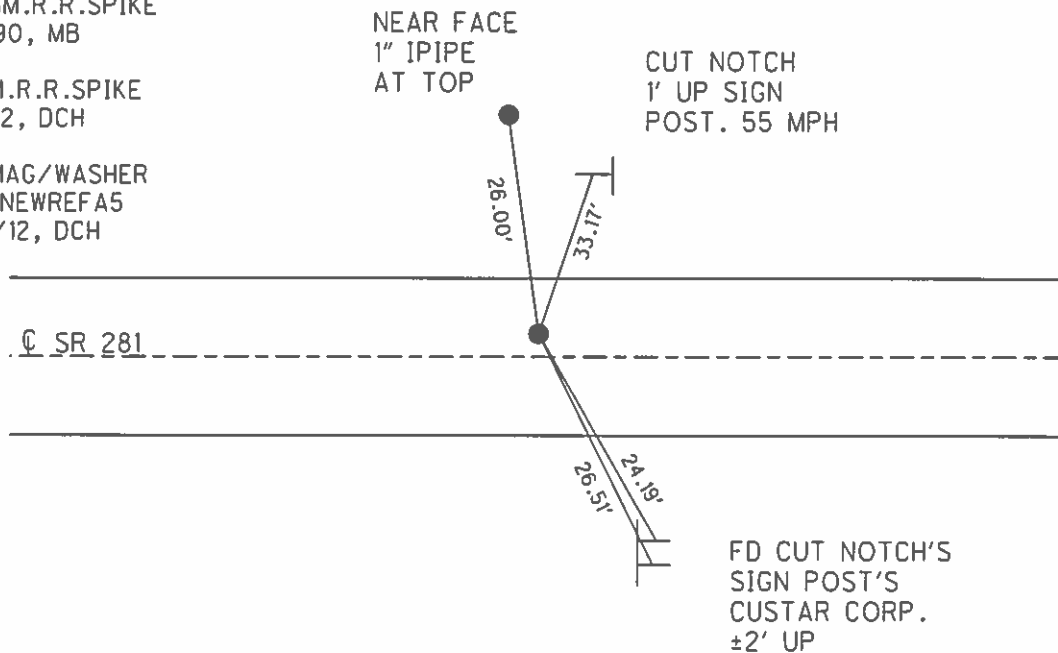

O.D.O.T. DISTRICT 2 SURVEY OFFICE

PERSONNEL

REFERENCE NO. 5 A

SHEET OF

NOTES BARNHISEL

H.C. Locheke

DATE 5-22-90

ROUTE 281

R.C. HOFFMAN

WEATHER WINDY

COUNTY WOOD

TEMP. +62°

TOWNSHIP MILTON

SECTION 20

T 4 N R 9 E


TYPE MONUMENT Sm RR Spk

ON SURFACE - BELOW yes

LEFT - PAV'T. - RIGHT 38

5.7 TO LT EDGE PAVEMENT

S.L.M. 93+38

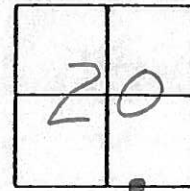

Record:


STA: 93+33.6

No X

Set Sm RR Spk

7-2-90

mB

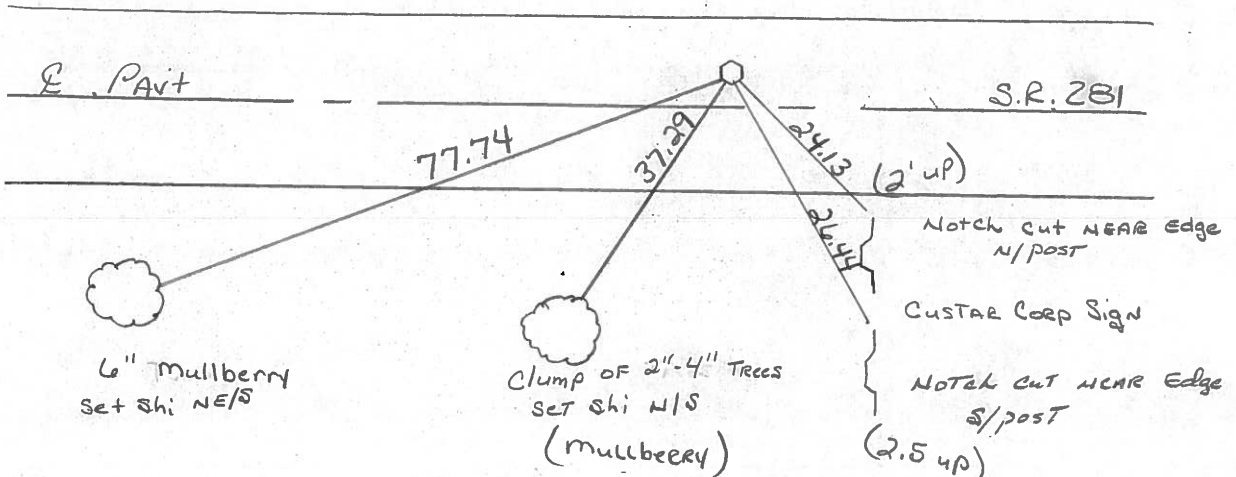

Q.D.O.T. DISTRICT 2 SURVEY OFFICE

Sht. ____ of ____

County Wood S.R. 281

Township Milton

Section 20

T4N, R9E

Personnel Hoffman

Householder


Loehrke

#5-A

Date 7-14-81 8-20-81

Weather clear ✓

Temp. +68° 80°

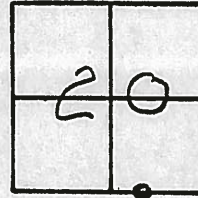

Fd. R.R. SPK 1" Below Surface

PROJECT STA ± 93+33.6

3.4' N. of & Paut.

No 7


9.1' 2.5' to N. E.P.

West. Corp. Line of Custer

13.0' to S. E.P.

5.6'

Set small
RR SPK

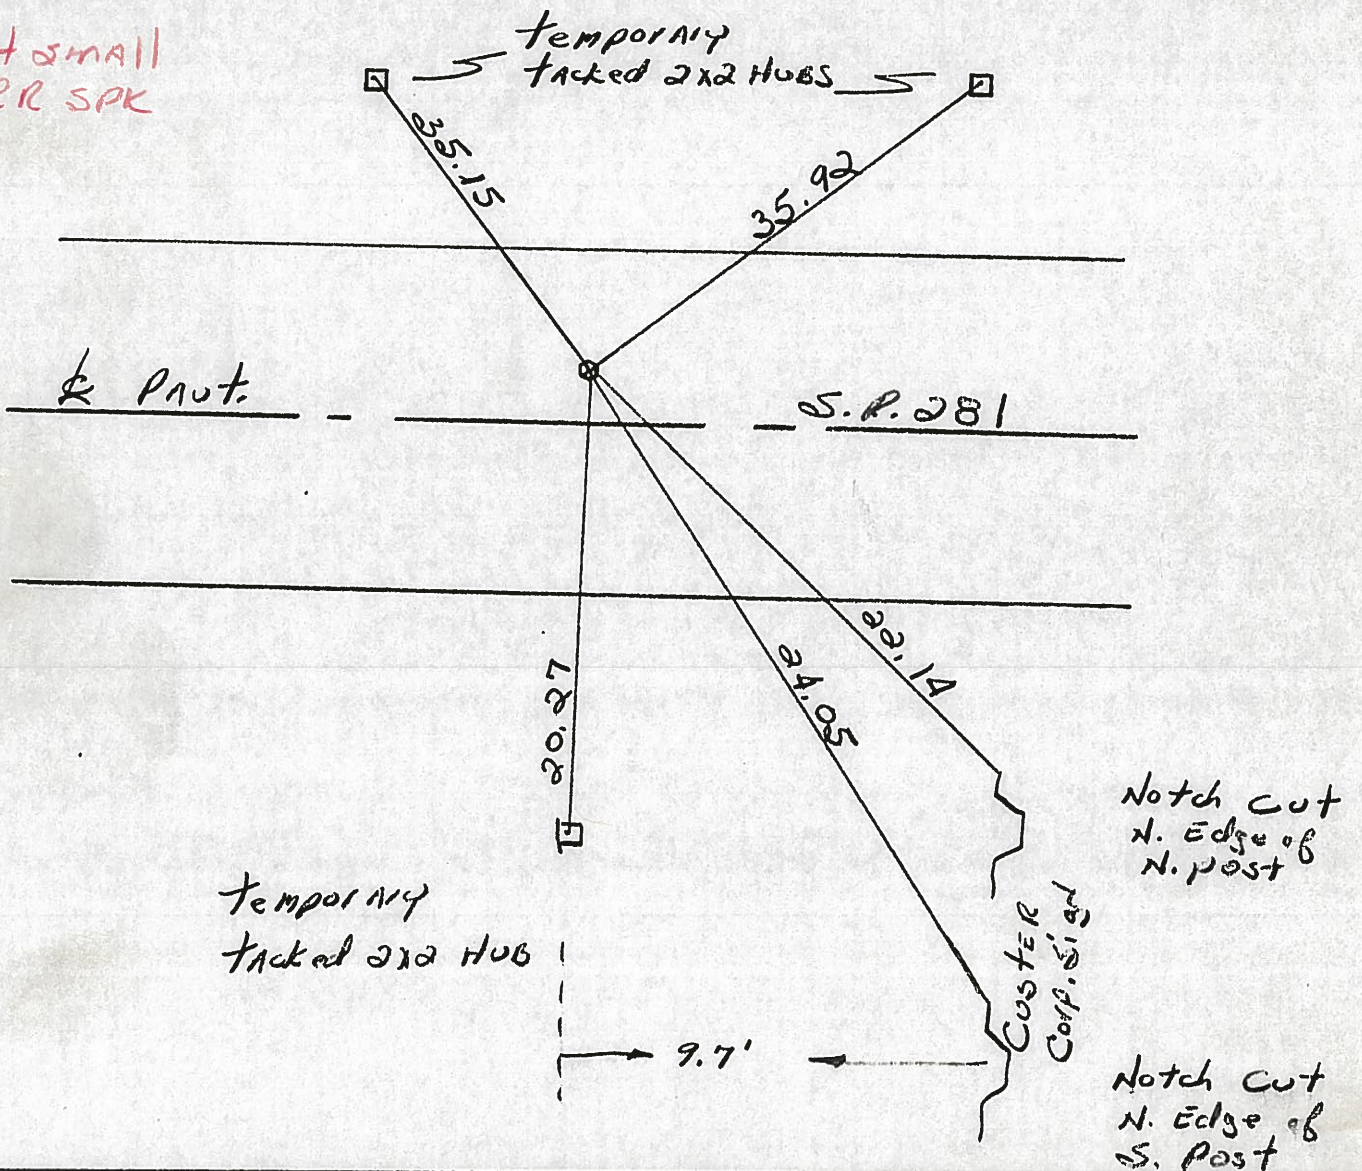

Q.D.O.T. DISTRICT 2 SURVEY OFFICE

Sht. ___ of ___

County Wood S.R. 281

Township Milton

Section 20

T4N, R9E

Personnel HOFFMAN

Householder


Loehrke

5-A

Date 7-14-81 - 8-20-81

Weather clear

Temp. +68°

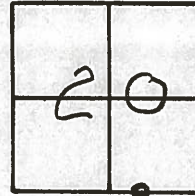

Fd. R.R. SPK 1" Below Surface

3.4' N. of & PAUT.

7.5' to N. EP.


13.0' to S. EP.

PROJECT STA ± 93+33.6

No 4

West. Corp. line of Custer

SET SMALL
R.R. SPK.

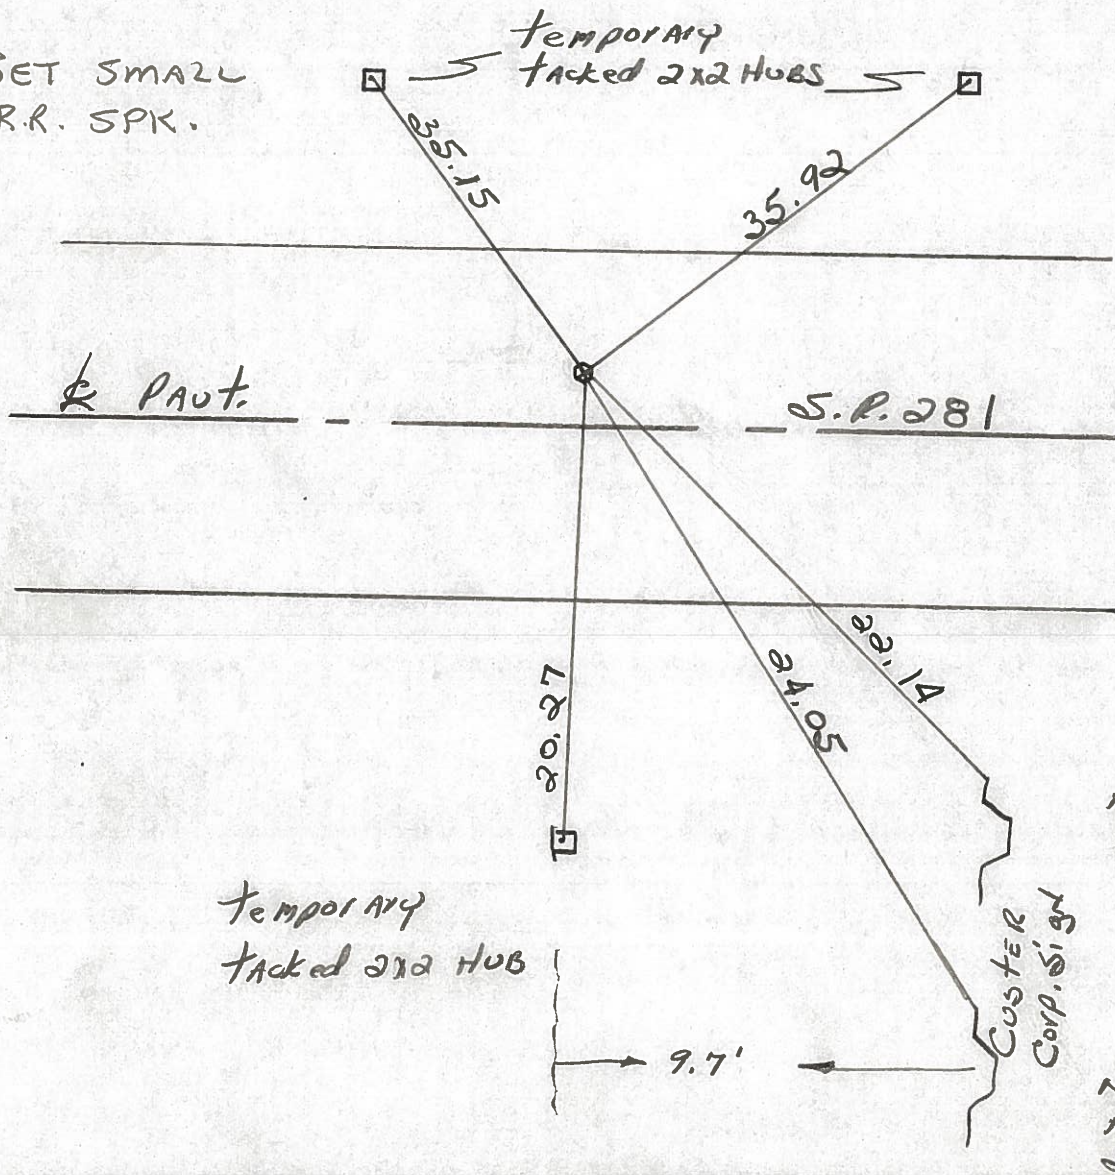

PERSONNEL TITLE PERSONNEL TITLE
 CK. BY _____ COUNTY WOOD
 SILVESTER _____ S. R. #281
 BURNSIDE _____ WEATHER _____
 SMITH _____ SEC. 20 TEMP. _____
 DESCRIPTION CONTROL TIES ~ CUSTAR ~ JOB NO. _____

LEFT	CENTER LINE	RIGHT
STA. 106+83.16 R.R. SPIKE (INTERSECTION S.R. #281 & CUSTAR ROAD) S.E. COR. SEC. 20 #148 MILTON TWP. T-4-N R-9-E #6 #148		N.W. COR. CONC. SIGN BASE S.E. 48.1 SHINER P. POLE N.E. 51.1 STONE FDN. STORE N.E. 46.2 SHINER P. POLE S.W. 39.3 SHINER P. POLE N.E. 50.6 SHINER 12" WALNUT N.W. 67.7 WELL PUMP CASING 1" ABOVE CAP. S.W. 40.86
STA. 93+33.6 S.E. 1/8 Post SEC. 20 MILTON TWP. T-4-N R-9-E #5-A NO ANGLE R.R. SPK. (WEST CORPORATION) LINE CUSTAR #147-A		STEEL SIGN POST N. 33.35 NORTH STEEL SIGN POST CORP SIGN S.E. 22. 3/4" IRON ROD { FLUSH WITH } N.W. 38 3/4" IRON ROD { GROUND } N.E. 38

PERSONNEL TITLE PERSONNEL TITLE

COUNTY Wood

DATE 12-3-57

S. R. #281

WEATHER 11-3-64

2-28-64

SEC.

TEMP.

DESCRIPTION

LEFT

CENTER LINE

RIGHT

JOB NO.

Sta. 53+0.36 (old) = 53+0.42 S.W. Cor. sec. 20 Milton Twp. Stone - Iron rod (Fd) $\Delta = 0^\circ - 30' \text{ Rt.}$ (Roundhead Rd.) (4) #146	set P.K. Nail	S. to X on S. Culvert about 31. S.E. to shiner in P.P. 62.65' 62. X in N.W. Cor. of S. Culvert about 25.26 25. X in S.W. Cor. of N. Culvert about 24.
Sta. 79+87.4 S 1/4 post sec. 20 Milton Twp. Stone - Iron pin (Fd) $\Delta = 0^\circ - 8 \frac{1}{2}' \text{ Rt.}$ (Wentz Rd.) (5) #147		X on N.W. Cor. W. wall N.E. 35.40' 35. X on S.W. Cor. W. wall S.E. 35.02' 34. N.E. Cor. of house 2' above gnd. S.W. 47. Shiner in Tele. Pole N.W. 43.
Sta. 93+33.6 S.E. 1/8 post sec. 20 W. Corp. line Custer (Fd I. Rod) No Angle (5-A) #147-A	set P.K. Nail	Face leaning Steel sign post N. 33.54' 33. Steel sign post S.W. 42.38' 42. N. Steel Sign Post S.E. sign 22.
Sta. 106+83.16 R.R. Spike in center of S.R. #281 & Custer Rd. (6) #148	(Fd)	Shiner in P. Pole N.E. 51.1 Well pump casing S.W. 41.03' 40.8 N. pt. Gas pump Island S.E. 69.3 N.E. to stone Adn. store 46.20' 46.1 Shiner P. Pole S.W. 39.4 Shiner P. Pole N.E. 50.6 Shiner 12" Walnut N.W. 67.8 .70

Sht. ____ of ____

Date 7-14-81 - 8-20-81

Weather clear

Temp. +68°

2	0

N

Householder

Loehrke

#5-A

PROJECT STA ± 93+~~33.6~~

3.4 ^{LT} N. of $\frac{1}{2}$ Part.

No 4

5.7 to ^{LT} A. EP.

~~13.0' to 5. E.P.~~

west. Corp. line of Costar

SET SMALL
R.R. SPK.

(NEW)
Temporary
tacked 2x2 Hubs

2 part.

5. P. 28

Temporary
tacked old HUB

Notch cut
N. Edge of
N. post.

Notch cut
N. Edge of
S. Post