

O.D.O.T. DISTRICT 2 SURVEY OFFICE (USE ONLY)

PERSONNEL

REFERENCE NO. 6

SHEET 7 OF 15

NOTES HOMAN

DATE 7/2/12

ROUTE SR 281

H.C. ROUSOS

WEATHER SUNNY

COUNTY WOOD

R.C. HOMAN

TEMP. 75°

TOWNSHIP MILTON

SECTION 20

DWG BY RHOADES

PID CHIP SEAL

T 4 N R 9 E

TYPE MONUMENT P.K./WASHER

ON SURFACE - ~~BELOW~~ ON

OFFSET Q PAVEMENT ON LT : RT

- TO - EDGE PAVEMENT


STATION: 106+87

HORZ.DATUM: NAD83 2011


GEOID: NAVD88 2012A

GRID: NORTHING: 592287.223

EASTING: 1599189.500

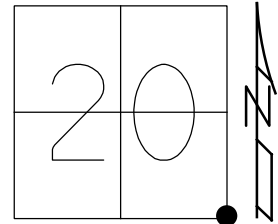


RECORD:
FD P.K./WASHER
5/23/90, MB
SET P.K./WASHER
7/2/90, MB
FD P.K./WASHER
7/2/12, DCH
SET MAG/WASHER
NEWREF6
9/24/12, DCH
FD MAG/WASHER
2/10/23, TDN

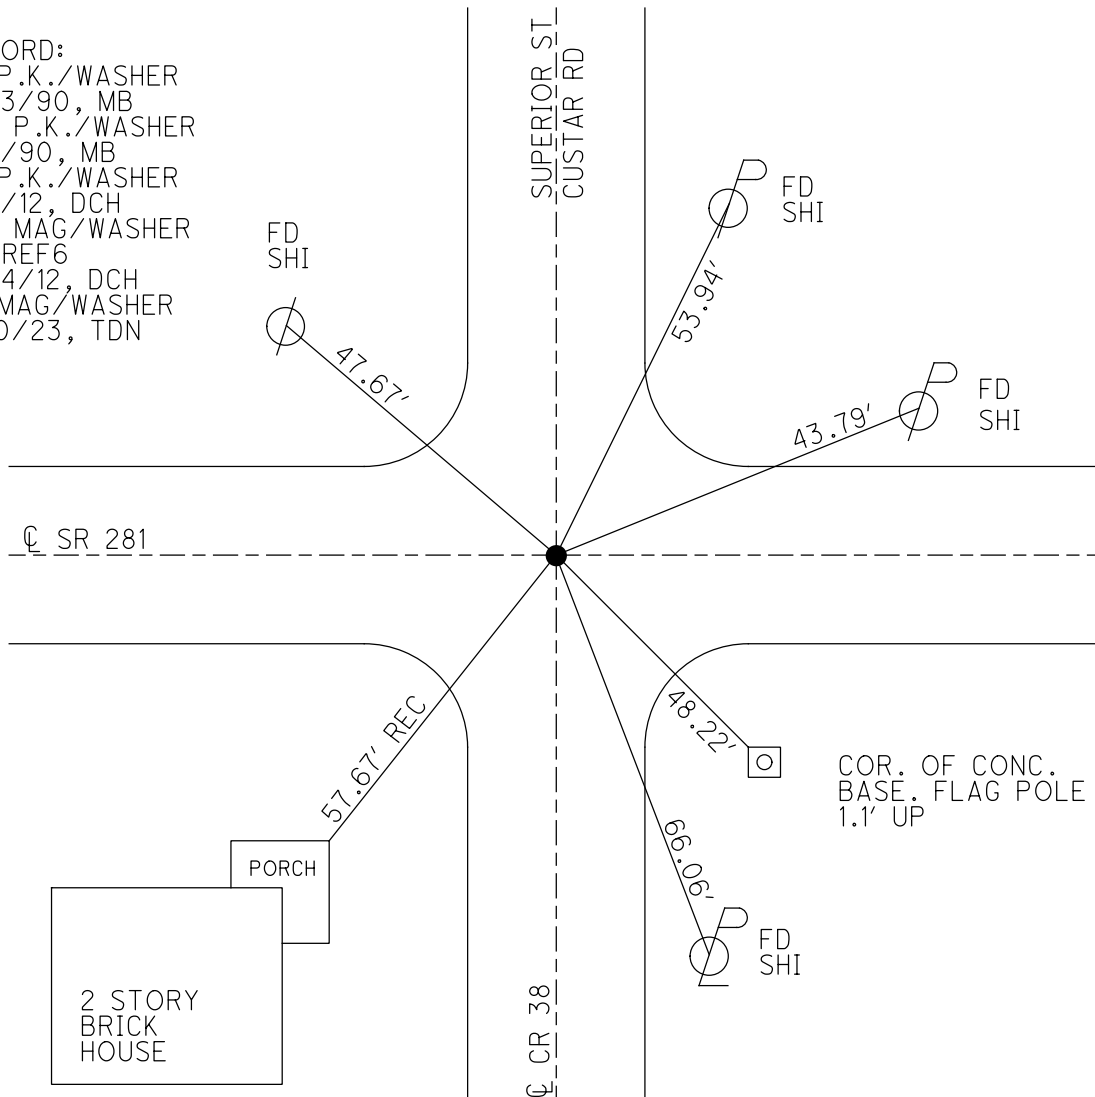

PERSONNEL		REFERENCE NO.	6	SHEET	7	OF	15
NOTES	HOMAN	DATE	7/2/12	ROUTE	SR 281		
H.C.	ROUSOS	WEATHER	SUNNY	COUNTY	WOOD		
R.C.	HOMAN	TEMP.	75°	TOWNSHIP	MILTON		
				SECTION	20		
				T 4	N	R 9	E

TYPE MONUMENT _____ P.K./WASHER _____
ON SURFACE - ~~BELOW~~ _____ ON _____
LEFT - C PAV'T - RIGHT _____ ON _____
_____ TO _____ EDGE PAVEMENT
S.L.M. _____ 106+87

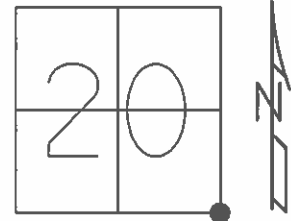


GRID: NORTHING: 592287.223 EASTING: 1599189.500

RECORD:
FD P.K./WASHER
5/23/90, MB

SET P.K./WASHER
7/2/90, MB

FD P.K./WASHER
7/2/12, DCH

SET MAG/WASHER
GPS, NEWREF6
9/24/12, DCH

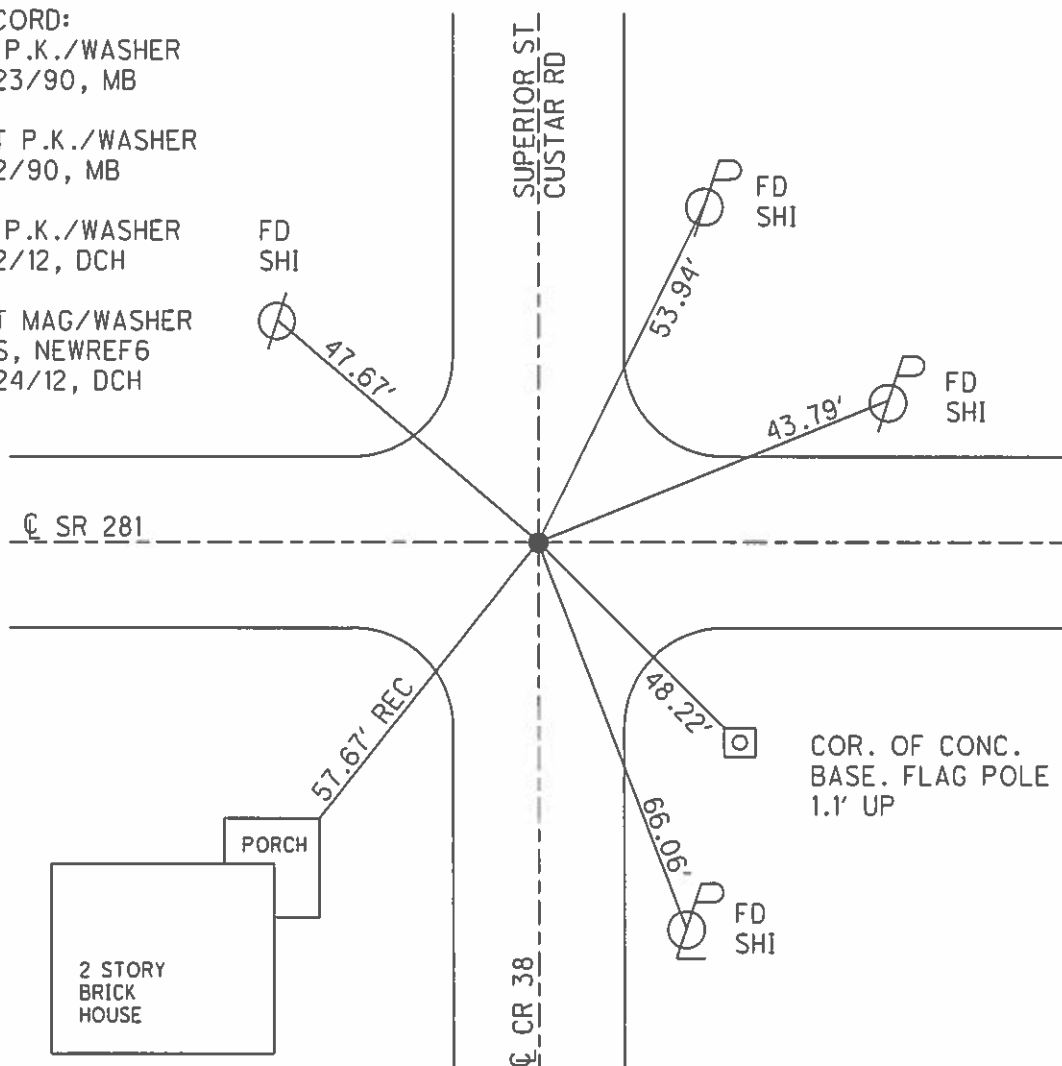

O.D.O.T. DISTRICT 2 SURVEY OFFICE

PERSONNEL

REFERENCE NO. 6

SHEET OF

NOTES BARNHISEL

H.C. " "

R.C. HOFFMAN

DATE 5-23-90

WEATHER Sunny

TEMP. +65°

ROUTE 281

COUNTY Wood

TOWNSHIP Milton

SECTION 20

T 4 N R 9 E



TYPE MONUMENT P.K. & Washer

ON SURFACE - BELOW yes

LEFT - & PAV'T. - RIGHT yes

- TO - EDGE PAVEMENT

S.L.M. 106+87

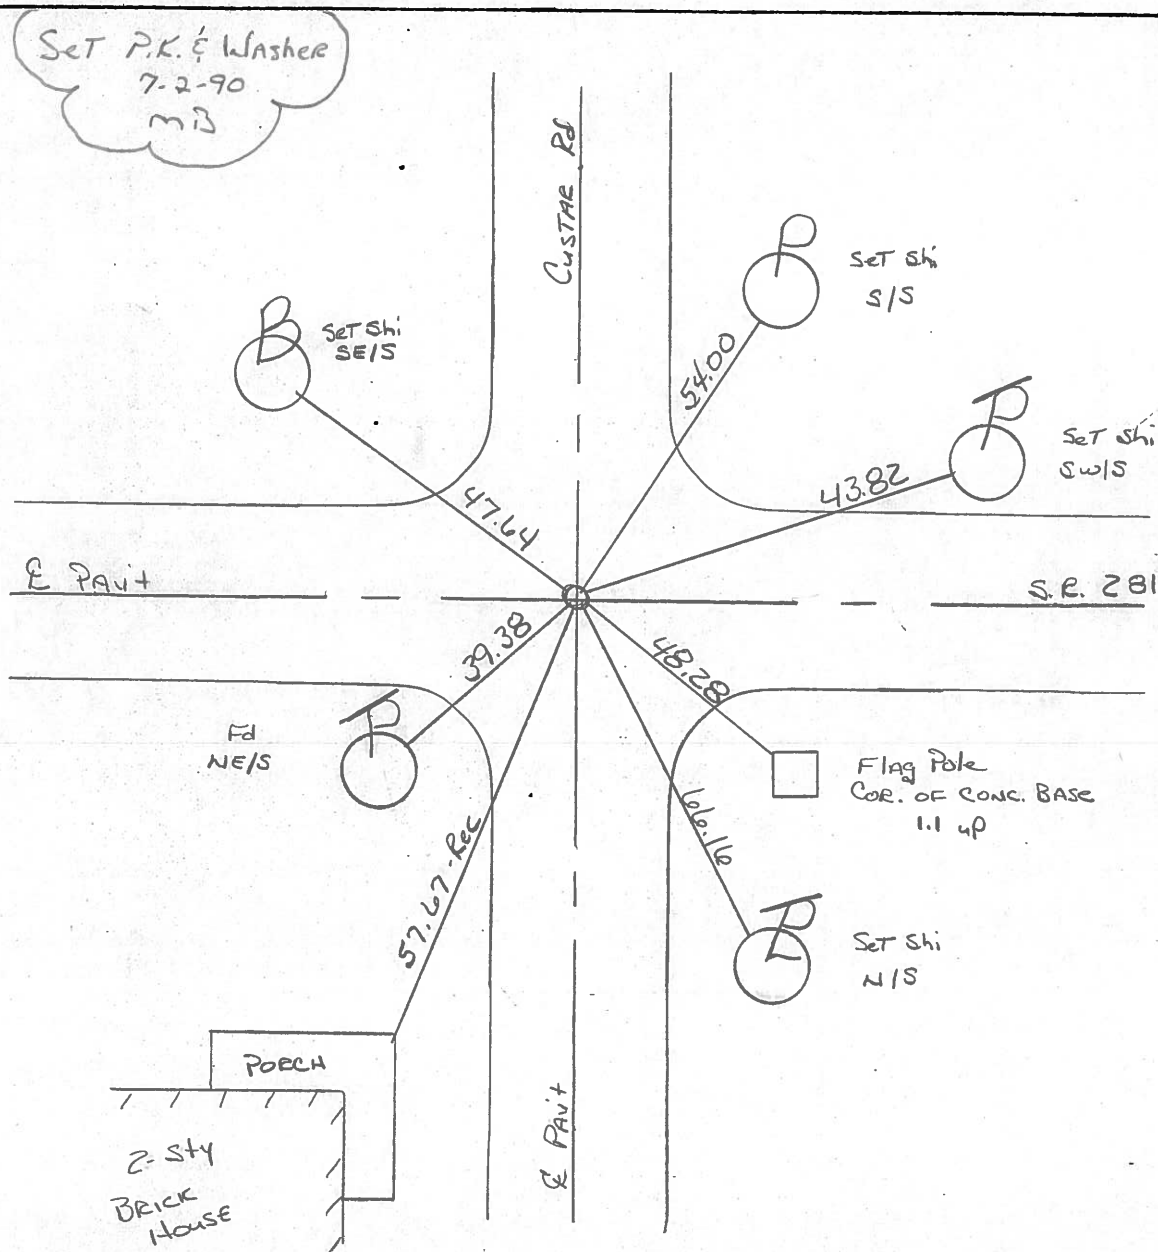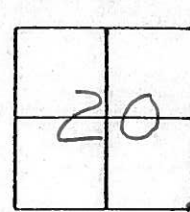

O.D.O.T. DISTRICT 2 SURVEY OFFICE

SHEET

OF

OK-7-27-82

S.W.H.

County Wood S.R. 281

Date 5-19-81

Township mil Tox

Weather Clear - 63° 73°

Section 20



Temp. _____

T4N, R9E

Personnel S Hoffmann

C. Lochrke

L Householder

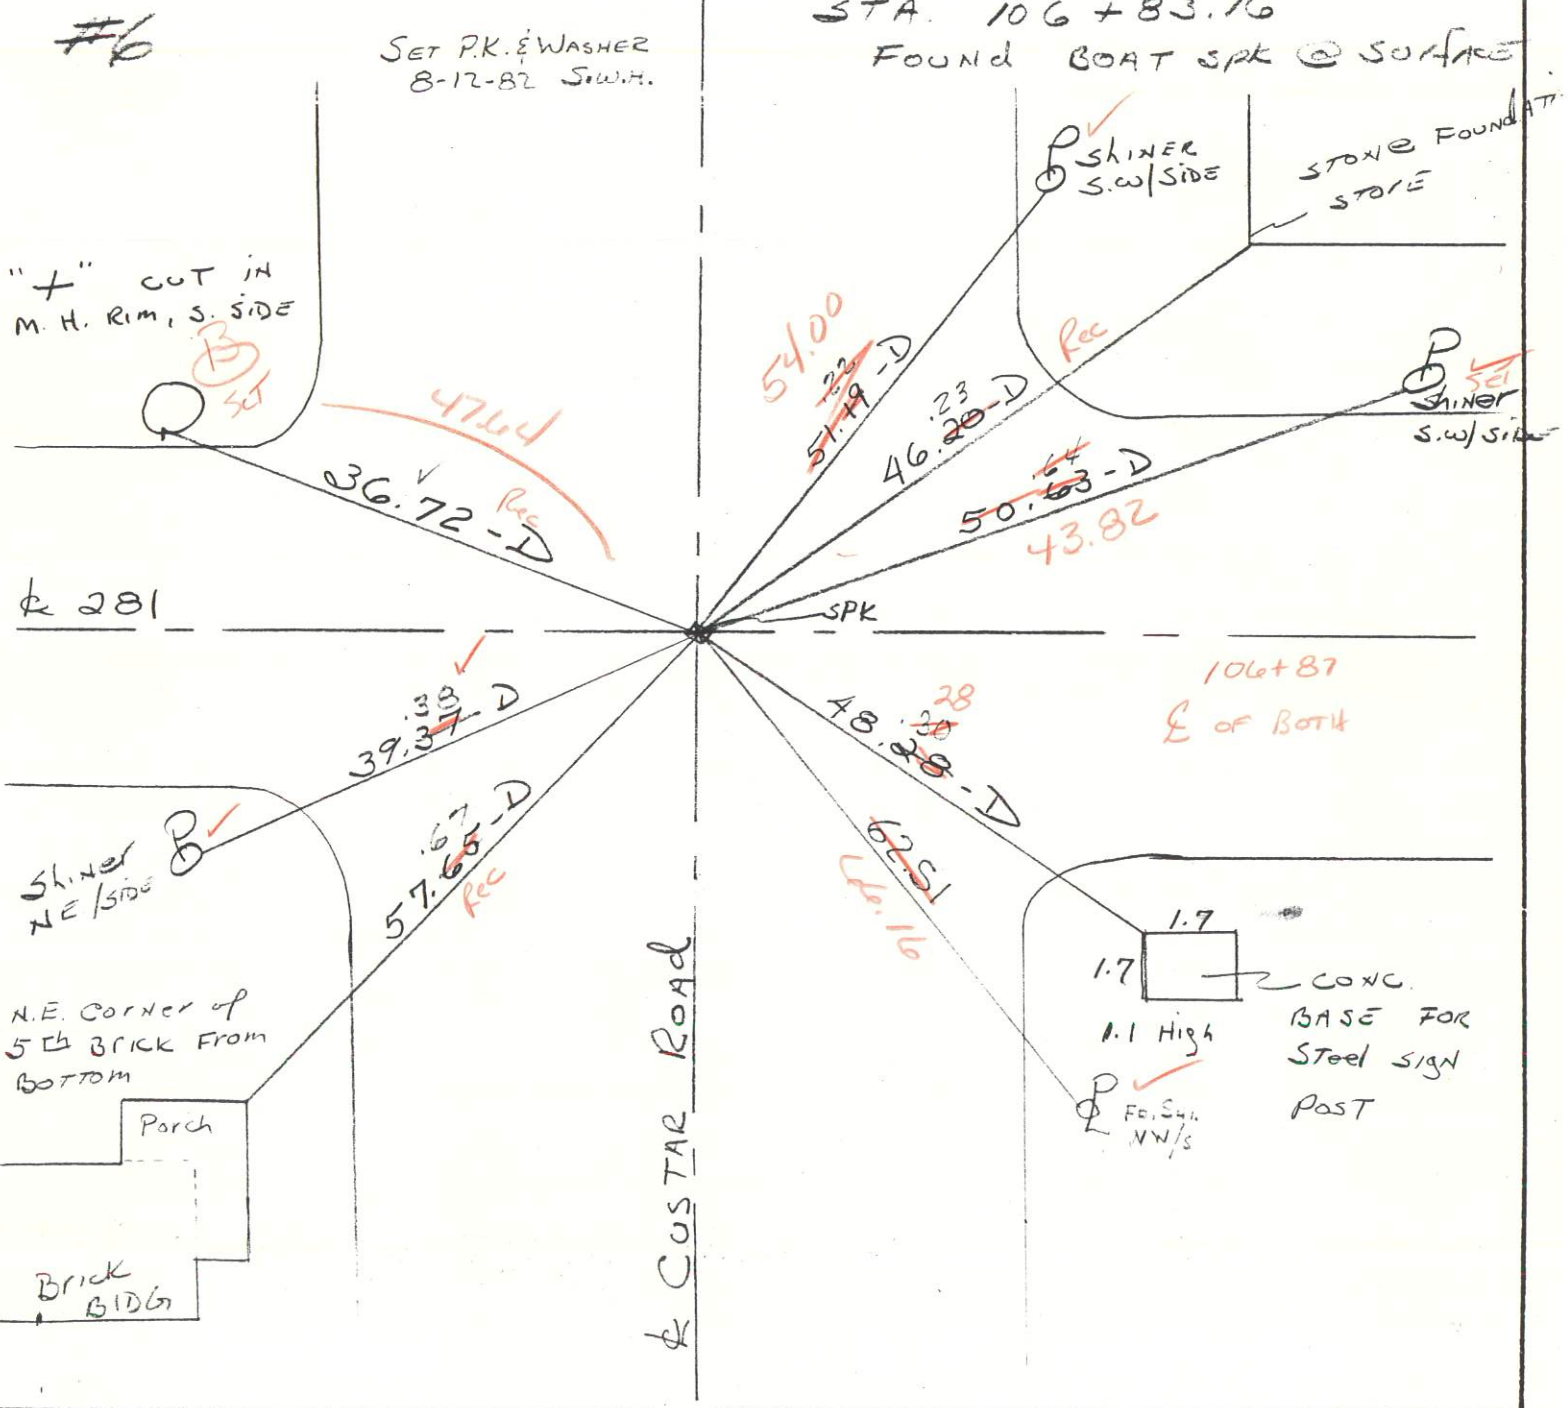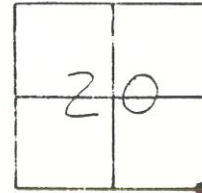

ODOT. DISTRICT 2 SURVEY OFFICE

SHEET

OF

OK-7-27-82

S.W.H.

County Wood S.R. 281

Date 5-19-81

Township MILTOX

Weather clear - 63° 73°

Section 20


Temp. _____

T4N, R9E

Personnel S. Hoffmann

C. Locherke

J. Householder

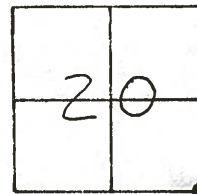

#6

SET P.K. & WASHER
8-12-82 S.W.H.

STA. 106 + 83.16

FOUND BOAT SPK @ SURFACE

"+" CUT IN
M. H. Rim, S. SIDE

Shiner
S.W. SIDE

STONE FOUND
STONE

Shiner
S.W. SIDE

36.72 - D

51.22 - D
51.19 - D

46.23 - D
46.20 - D

50.64 - D
50.63 - D

SPK

R 281

39.38 - D
39.37 - D

48.30 - D
48.28 - D

62.51

Shiner
N.E. SIDE

57.67 - D
57.65 - D

N.E. Corner of
5th BRICK FROM
BOTTOM

Porch

Brick
BIDG

COSTAR ROAD



1.1 High

CONC.
BASE FOR
STEEL SIGN
POST

FO. SHI.
NW/S

PERSONNEL TITLE PERSONNEL TITLE

COUNTY Wood

DATE 12-3-57

S. R. #281

WEATHER Swarden 3-22-61 Knebe 11-3-61

SEC.

TEMP.

2-28-64

DESCRIPTION

LEFT

CENTER LINE

RIGHT

JOB NO.

Sta. 53+0.36 (old) = 53+04.2 S.W. Cor. sec. 20 Milton Twp. Stone - Iron rod (Fd) $\Delta = 0^\circ - 30' \text{ Rt.}$ (Roundhead Rd.) (4) #146	set P.K. Nail	S. to X on S. culvert about 31. S.E. to shiner in P.P. 62.65' 62. X in N.W. Cor. of S. culvert about 25.26' 25. X in S.W. Cor. of N. culvert about 24.
Sta. 79+87.4 S 1/4 post sec. 20 Milton Twp. Stone - Iron pin (Fd) $\Delta = 0^\circ - 8\frac{1}{2}' \text{ Rt.}$ (Wentz Rd.) (5) #147		X on N.W. Cor. W. wall N.E. 35.40' 35. X on S.W. Cor. W. wall S.E. 35.02' 34. N.E. Cor. of house 2' above gnd. S.W. 47. Shiner in Tele. Pole N.W. 43.
Sta. 93+33.6 S.E. 1/8 post sec. 20 U. Corp. line Custer (Fd I. Rod) No Angle (5-A) #147-A	set P.K. Nail	Face leaning Steel sign post N. 33.54' 33. Steel sign post S.W. 42.38' 42. N. Steel Sign Post corp. sign S.E. sign 22.
Sta. 106+83.16 R.R. Spike in center of S.R. #281 & Custer Rd. (6) #148	(Fd)	Shiner in P. Pole N.E. 51. Well pump casing S.W. 41.03' 40.5 N. pt. Gas pump Island S.E. 69.3 N.E. to stone fn. store 46.20' 46.1 Shiner P. Pole S.W. 39.4 Shiner P. Pole N.E. 50.6 Shiner 12" Walnut N.W. 67.8 .70