

O.D.O.T. DISTRICT 2 SURVEY OFFICE (USE ONLY)

PERSONNEL

REFERENCE NO. 6 A

SHEET 8 OF 15

NOTES HOMAN

DATE 7/3/12

ROUTE SR 281

H.C. ROUSOS

WEATHER CLOUDY

COUNTY WOOD

R.C. HOMAN

TEMP. 70°

TOWNSHIP MILTON

HARBAUGH

SECTION 21

DWG BY RHOADES

PID CHIP SEAL

T 4 N R 9 E

TYPE MONUMENT SM.R.R.SPIKE

ON SURFACE - ~~BELOW~~ ON

OFFSET CL PAVEMENT 4.6' LT : RT

4' TO RT EDGE PAVEMENT


STATION: 120+15

HORZ.DATUM: NAD83 2011

GEOID: NAVD88 2018


GRID: NORTHING: 592276.509

EASTING: 1600517.186

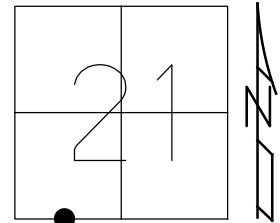

RECORD:

Δ= 0° 16' RT
 STA. 120+11.4
 FD STONE
 FD P.K./WASHER
 5/23/90, MB
 SET SM.R.R.SPIKE
 7/2/90, MB
 FD SM.R.R.SPIKE
 7/2/12, DCH
 SET MAG/WASHER
 NEWREFA6
 9/24/12, DCH
 FD HOLE
 REFA6
 7/15/22, DSA
 2/10/23, TDN

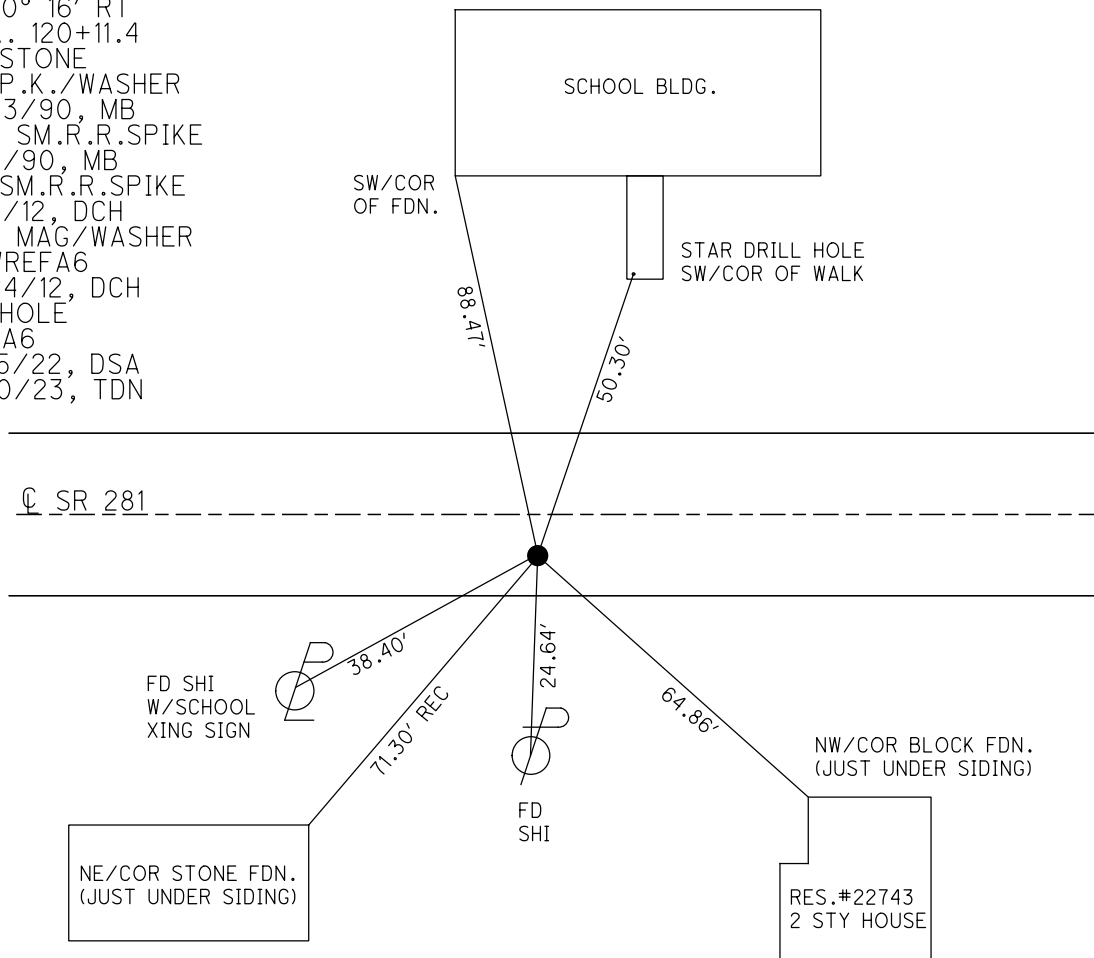

O.D.O.T. DISTRICT 2 SURVEY OFFICE (USE ONLY)

PERSONNEL

REFERENCE NO. 6 A

SHEET 8 OF 15


NOTES
H.C. HOMAN
R.C. ROUSOS
HOMAN
HARBAUGH

DATE 7/3/12
WEATHER CLOUDY
TEMP. 70°

ROUTE SR 281
COUNTY WOOD
TOWNSHIP MILTON
SECTION 21
T 4 N R 9 E

TYPE MONUMENT SM.R.R.SPIKE
ON SURFACE - ~~BELOW~~ ON
~~LEFT~~ - C PAV'T - RIGHT 4.6'
4.0' TO RT EDGE PAVEMENT
S.L.M. 120+15

GRID: NORTHING: 592276.519 EASTING: 1600517.163

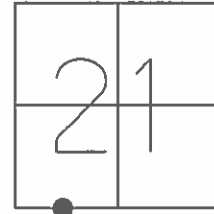


RECORD:
△ = 0° 16' RT
STA. 120+11.4
FD STONE

FD P.K./WASHER
5/23/90, MB

SET SM.R.R.SPIKE
7/2/90, MB

FD SM.R.R.SPIKE
7/2/12, DCH

SET MAG/WASHER
GPS, NEWREFA6
9/24/12, DCH

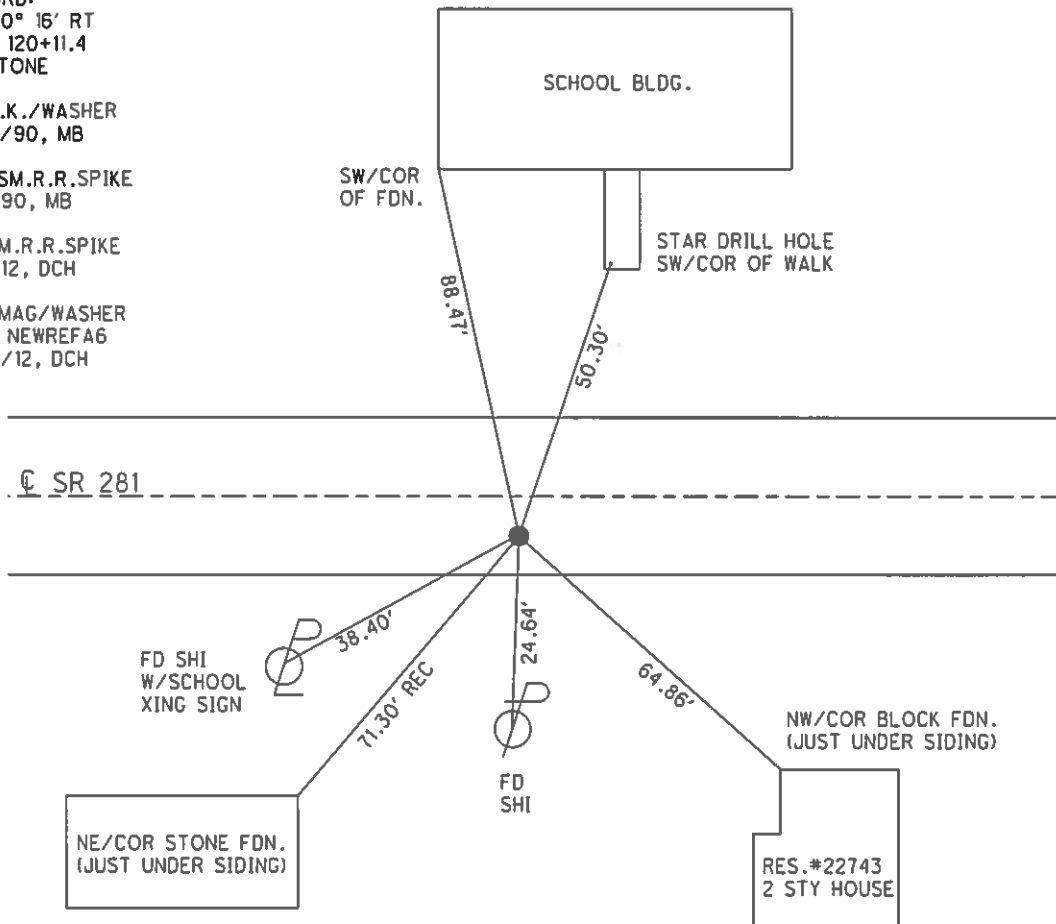

O.D.O.T. DISTRICT 2 SURVEY OFFICE

PERSONNEL

REFERENCE NO. 6A

SHEET OF

NOTES BARNHISEL

H.C. " "

R.C. HEFFMAN

DATE 5-23-90

WEATHER Sunny

TEMP. +65°

ROUTE 281

COUNTY Wood

TOWNSHIP Milton

SECTION 21

T 4 N R 9 E


TYPE MONUMENT P.K. & Washers

ON SURFACE - BELOW yes

LEFT - ℄ PAV'T. - RIGHT 4.6

4.0 TO RT EDGE PAVEMENT

S.L.M. 120+15

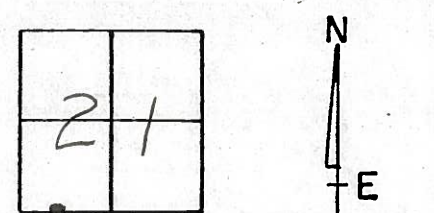

RECORD
Δ = 00-16' Rt
STA = 120+11.4
"STONE"

S.W. COR OF
School Fdn.

School Bldg

Set Sm RR Spk
7-2-90
MB


STAR DRILL HOLE
S.W. CORNER OF WALK TO School

School Crossing
Sign mounted
on this pole
Set Shi
NE/S

N.E. COR STONE Fdn
Just under Siding

Set Shi
N/S

N.W. COR BIK
Fdn
#22743
2-Story House
Just under
Siding

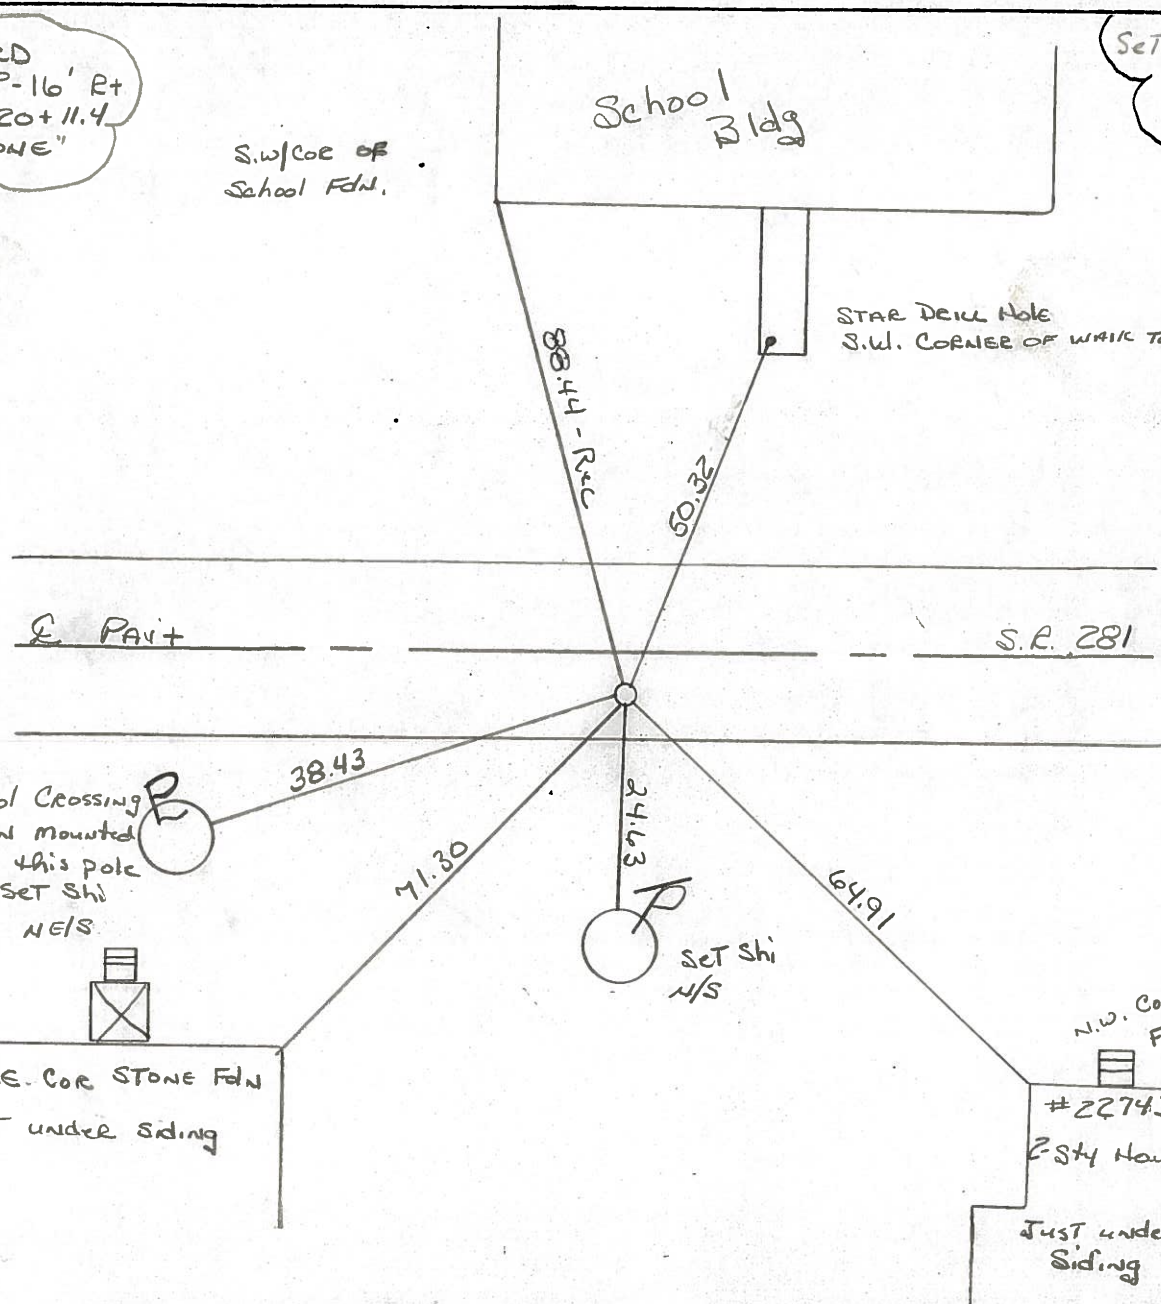

O.D.O.T. DISTRICT 2 SURVEY OFFICE

SHEET

OF

County Wood S.R. 281

Township Milton

Section 21

T4N, R9E

Personnel S. Hoffmann

C. Loehrke

L. Householder


Date 5-20-81

Weather Clear

Temp. 45°

7-27-82

+73° SW

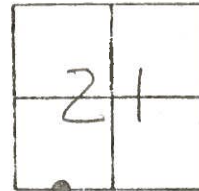

SLM 120+29.5

STA 120+11.4

$\Delta = 0^\circ - 16' RT$

"STONE" Fd. BOAT Spk @ SURFACE 6' N. of S. EDGE PWT.

#6-A

SW COR School FDN.

School Bldg

4.7' RT of PWT.

STAR DRILL HOLE S.W. CORNER of WALK TO School

281

Set P.K./washer 8-12-82 SWN

Light pole f school CROSSING SIGN


SHINER NE/S

N.E. COR. STONE FDN.

SHINER N/S

22743

N.W. COR. BIK FDN.

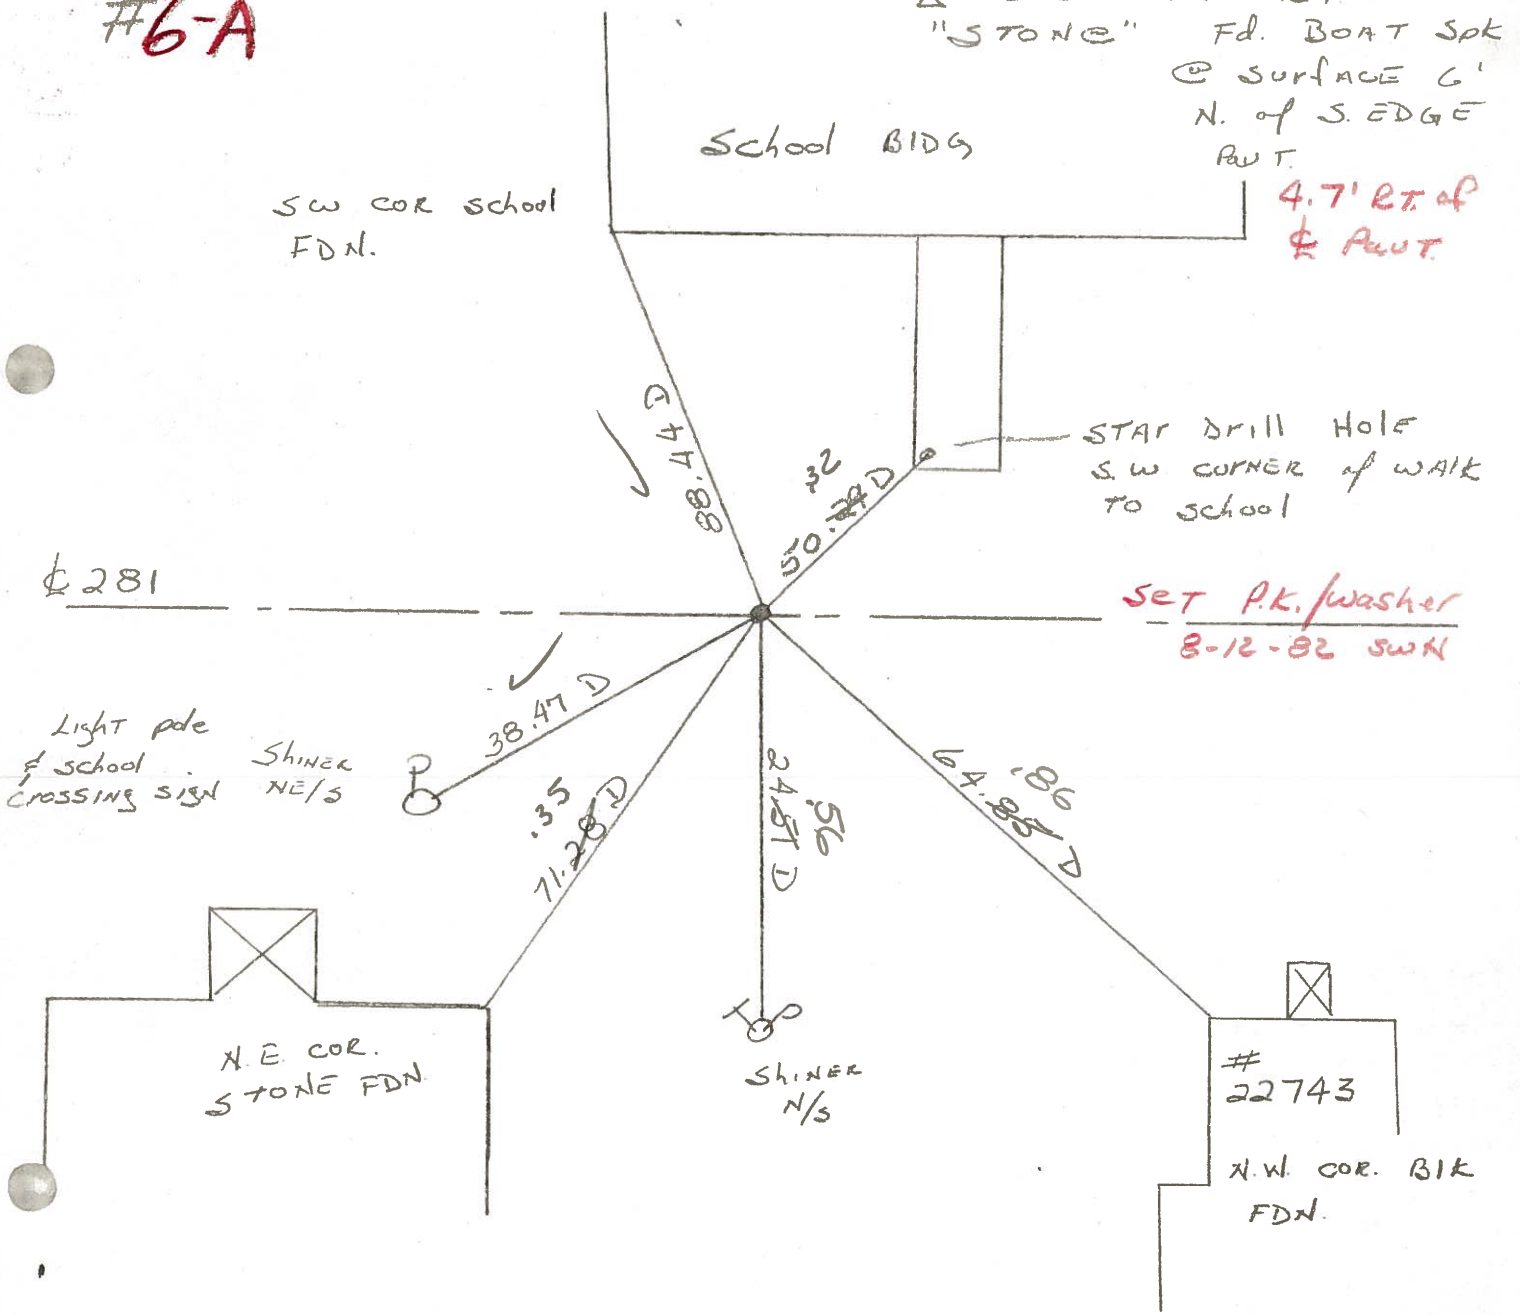

O.D.O.T. DISTRICT 2 SURVEY OFFICE

SHEET

OF

OK-7-27-82 - 75° - S.W.H.

County Wood S.R. 281

Date 5-20-81

Township Milton

Weather Clear

Section 21


Temp. 45°

T4N, R9E

Personnel S Hoffman

C. Loehrke

L. Householder

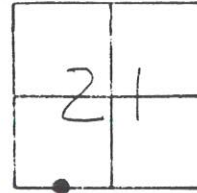

SET P.K. & WASHER
B-12-82 S.W.H.

STA 120+11.4

$\Delta = 0^\circ - 16' RT$

"STONE" Fd. BOAT Spk
@ SURFACE 6'
N. of S. EDGE
Pavt.

#6-A

SW COR School
FDN.

School Bldg

P.K. & Washer

4.0 To Rt Edge

4.6 Ft of R

120+15

STAR DRILL HOLE
S.W. CORNER of WALK
TO SCHOOL

281

Light pole
of school
CROSSING SIGN

Shiner
NE/S

N.E. COR.
STONE FDN

JUST UNDER
SIDING

TOP
SHINER
N/S

22743

N.W. COR. Bldg
FDN

JUST UNDER SIDING

O.D.O.T. DISTRICT 2 SURVEY OFFICE

SHEET OF

OK-7-27-82 - 75° - S.W.H.

County Wood S.R. 281

Date 5-20-81

Township MILTON

Weather Clear

Section 21


Temp. 45°

T4N, R9E

Personnel S. Hoffmann

C. Loehrke

L. Householder

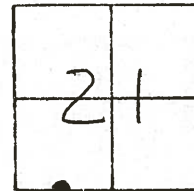

#6-A

SET P.K. & WASHER
8-12-82 S.W.H.

STA. 120 + 11.4

$\Delta = 0^\circ - 16' \text{ RT.}$

"STONE" Fd. BOAT Spk
@ SURFACE 6'
N. of S. EDGE
PAV'T.

School Bldg

SW COR School
FDN.

STAR DRILL HOLE
S.W. CORNER of WALK
TO SCHOOL

281

Light pole
f school
CROSSING SIGN


SHINER
NE/S

N.E. COR.
STONE FDN.

SHINER
N/S

22743

N.W. COR. Bldg
FDN.

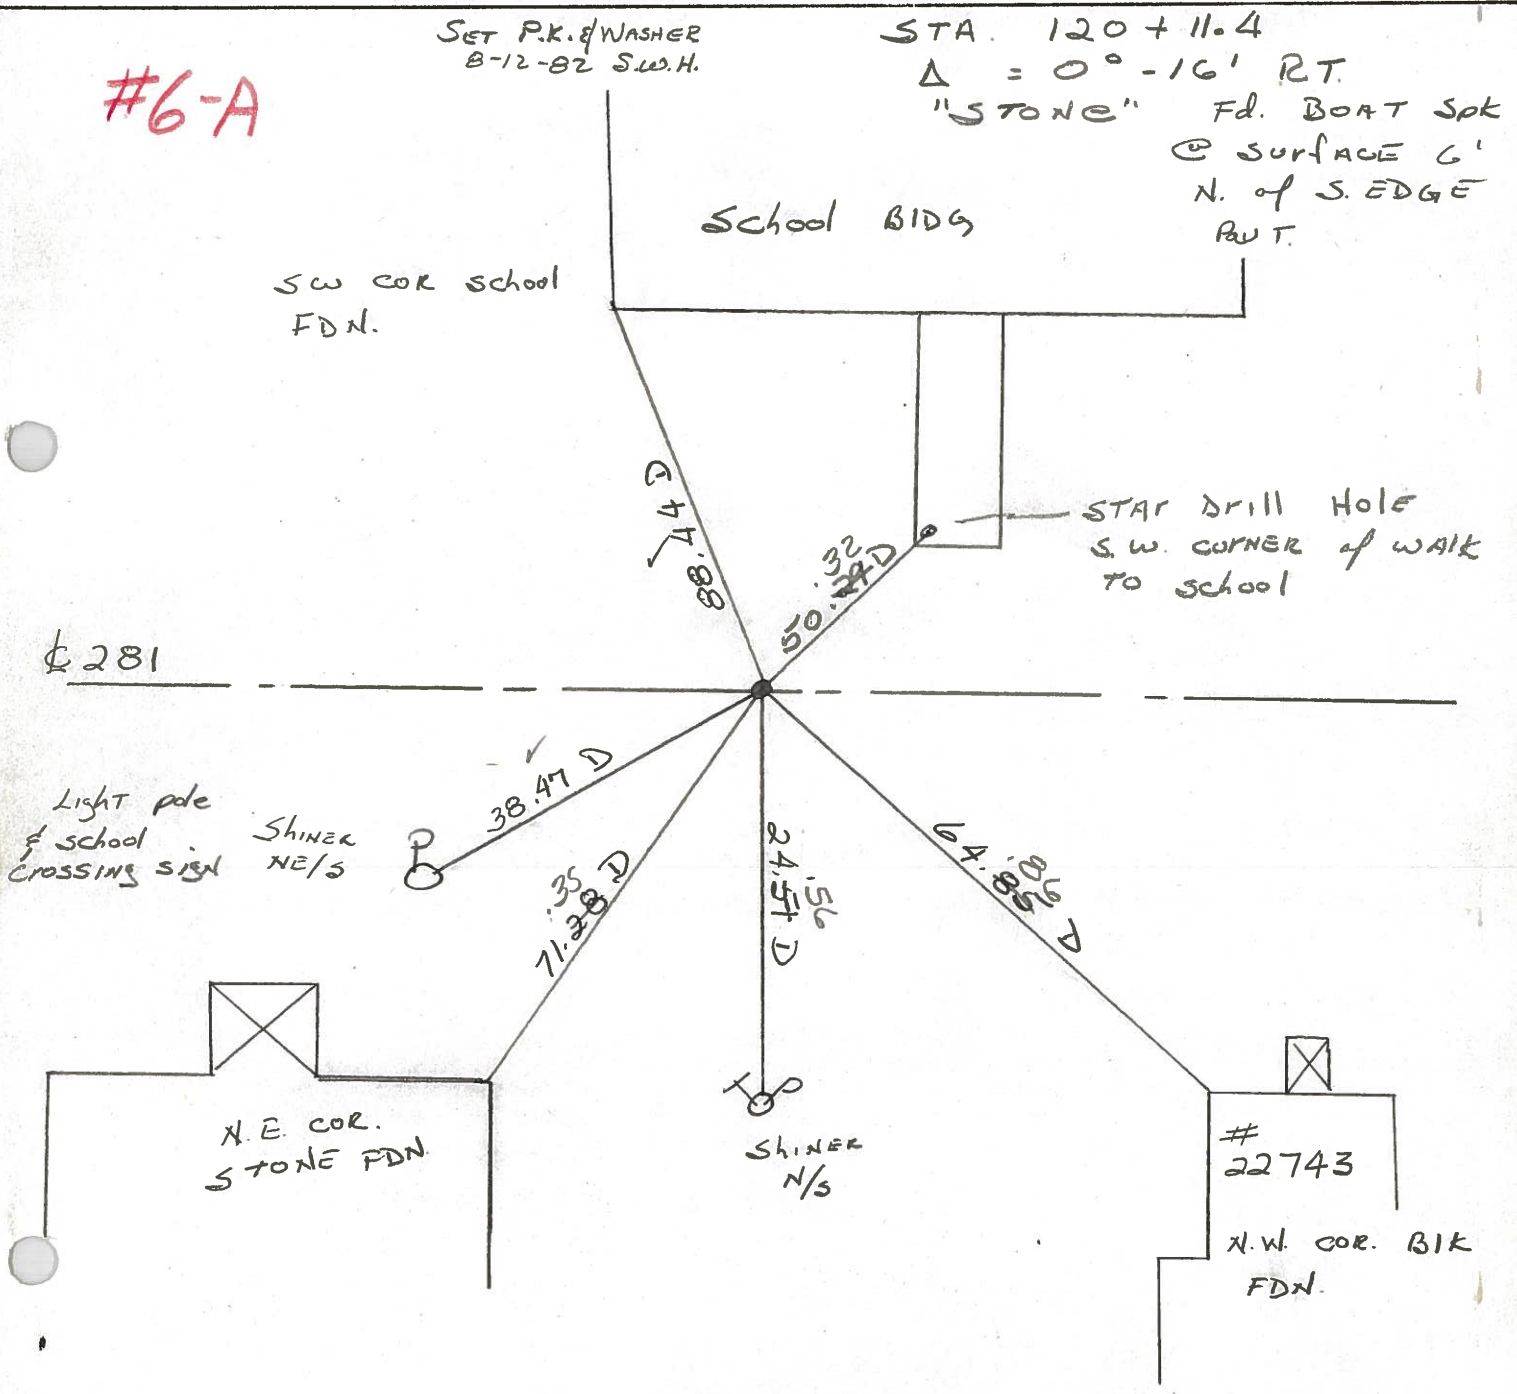

PERSONNEL TITLE PERSONNEL TITLE
CK. BY STAC COUNTY WOOD DATE OK-11-18-70
SILVESTER TA S. R. #281 WEATHER
BURNSIDE SEC. 21 & 22 TEMP.
SMITH

DESCRIPTION CONTROL TIES JOB NO.
 LEFT CENTER LINE RIGHT

STA. 158+62.0
 S.W. COR. SEC. 22
 MILTON TWP.
 $\Delta = 2^{\circ} 21' 30''$ RT.
 IRON PIN - SET BOAT SPK.
 (MILTON ROAD)
 #150

#8

SHINER P. POLE N.W. 40.2
 SHINER BRACE POLE S.W. 39.56
 SHINER T. POLE S.E. 40.4
 CONC. MON (LEANING) S.W. 49.1

5/4 POST SEC. 21
 MILTON TWP.
 $\Delta = 1^{\circ} 51'$ RT.

#7

#149

POINT GONE NEW BRIDGE

STA. 120+11.4
 S.W. 1/8 POST SEC. 21
 MILTON TWP.
 $\Delta = 0^{\circ} - 16'$ RT.
 "STONE" - SET BOAT SPK.

#6-A

#148-A

S.W. COR. SCHOOL FON. N.W. 85
 "X" S.E. COR. WALK TO SCHOOL 53
 N.W. COR. BLK. FON. HO. S.E. 64
 N.E. COR. STONE FON. HO. S.W. 71
 SHINER T. POLE S. 24

PERSONNEL TITLE PERSONNEL TITLE

COUNTY Wood

DATE OK 12-4-51

S. R. #281

Sweeney 3-22-6

WEATHER Silvester 2-28-6

SEC.

TEMP.

DESCRIPTION

LEFT

CENTER LINE

RIGHT

JOB NO.

Sta. 120+11.4

S.W. 1/4 post sec. 21. Milton

Twp. Stone Iron pin

 $\Delta = 0^{\circ}16' \text{ Rt.}$

(Fd. small

R.R. SpK)

S.W. Cor. school Fdn. N.W.W.

88.0

X on S.E. cor. walk to school

53.0

S.W. cor. 1st step walk bet. Ch. & sch.

85.0

N.W. cor. block fdn. house S.E.

64.0

N.E. cor. stone fdn. house S.W.

71.0

Shiner in T.P. S.

23.0

(6-A)

#148-A

S. 1/4 post sec. 21 Milton

Twp. Shi. in Δ of bridge

No

 $\Delta = 1^{\circ}51' \text{ Rt.}$

(Gone! new bridge) (Beaver creek)

End of
bridge

30'

8.5'

8.5'

30'

End of
bridge

(7)

#149

Sta. 158+62.0

S.W. Cor. sec. 22 Milton (Fd. P.K.)

Twp. Iron pin

 $\Delta = 2^{\circ}-21\frac{1}{2}' \text{ Rt.}$ (Milton Rd.)

Shiner in P.P. N.W.

40.28 40.28

Shiner in br. pole S.W.

39.0

Shiner in T.P. S.E.

40.47' 40.47

Conc. mon. S.W. (leaning) 49.12' 49.12

(8)

#150

Sta. 185+28.39

S. 1/4 post Sec. 22 Milton (Fd.)

Twp. Set. R.R. spk.

 $\Delta = 0^{\circ}-18' \text{ Rt.}$ P.I.N. To Δ on Top steel Sign Post STK. 150

S. " " " " " " " " 150

S.E. "X" Cut in S end 60" Conc. Pipe 26.0

E.S.E. Shiner in East Guard Rail Post (Plum be 31.0

(Shiner Guard Rail Post N. 1767) 31.0

E.N.E. Shiner in East Guard Rail Post

Shiner Guard Rail Post S.W. 18.22) 32.0

N.N.E. "X" Cut in North end 60" Conc. Pipe

Plumbed 27.8

S.E. "X" Near Top Retaining Wall (Plum be 33.60'

(9)

#151

31.02 Shiner in Guard Rail Post S.E.

32.30 " " " " " N.E.