


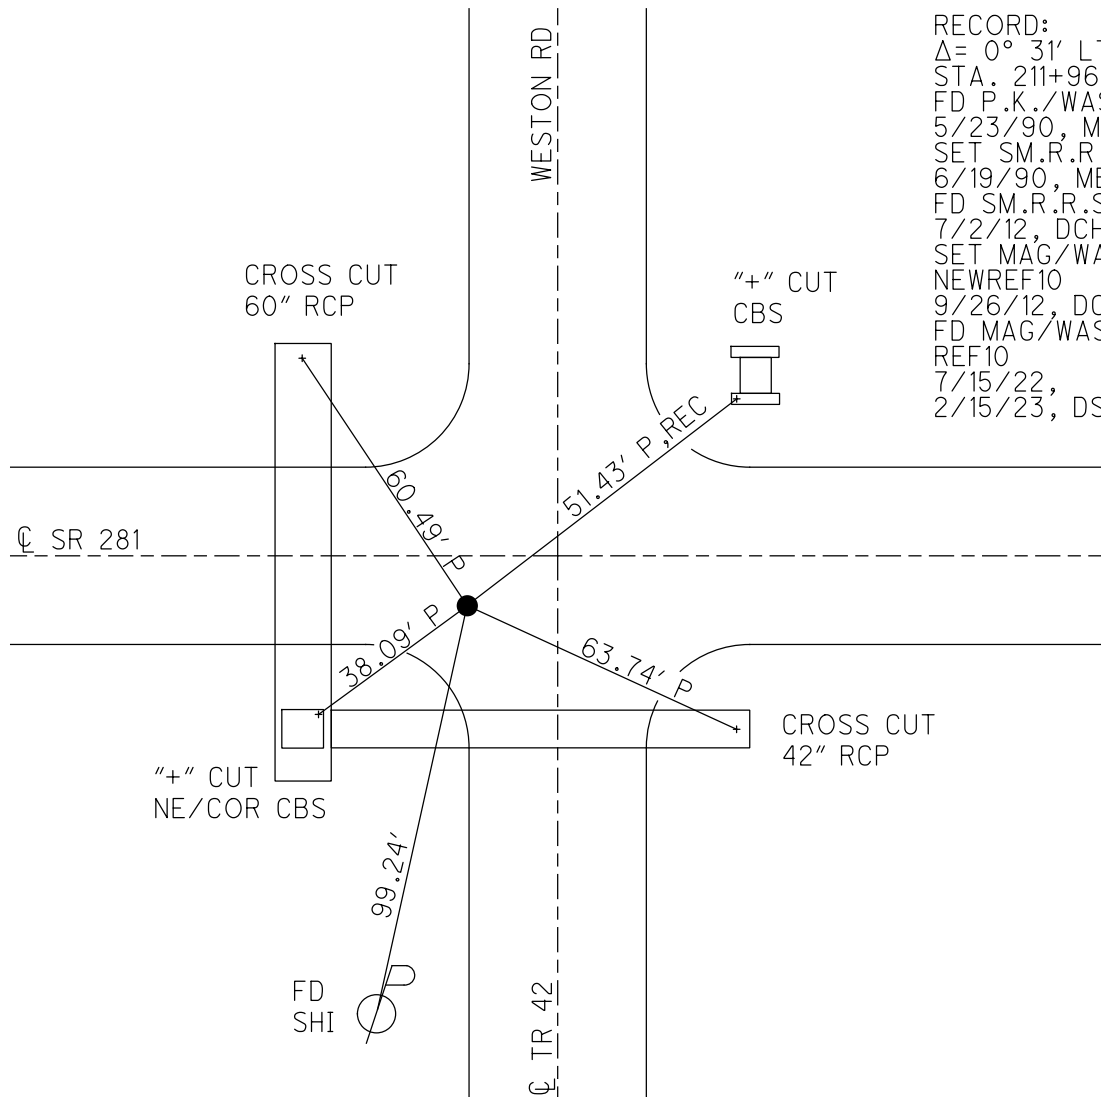

O.D.O.T. DISTRICT 2 SURVEY OFFICE (USE ONLY)

PERSONNEL

REFERENCE NO. 10

SHEET 14 OF 15

NOTES

HOMAN

DATE

7/3/12

ROUTE

SR 281

H.C.

ROUSOS

WEATHER

CLOUDY

COUNTY

WOOD

R.C.

COUTCHER

TEMP.

75°

TOWNSHIP

MILTON

HARBAUGH

SECTION

23

T 4 N R 9 E

TYPE MONUMENT SM.R.R.SPIKE


ON SURFACE - ~~BELOW~~ ON

~~LEFT~~ - CL PAV'T - RIGHT 4.5'

- TO - EDGE PAVEMENT

S.L.M. 213+01

GRID: NORTHING: 592118.891 EASTING: 1609798.054

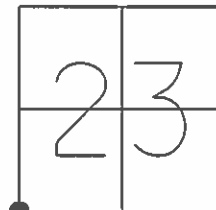

RECORD:


$\Delta = 0^{\circ} 31' \text{ LT}$
STA. 211+96.5

FD P.K./WASHER
5/23/90, MB

SET SM.R.R.SPIKE
6/19/90, MB

FD SM.R.R.SPIKE
7/2/12, DCH

SET MAG/WASHER
GPS, NEWREF10
9/26/12, DCH

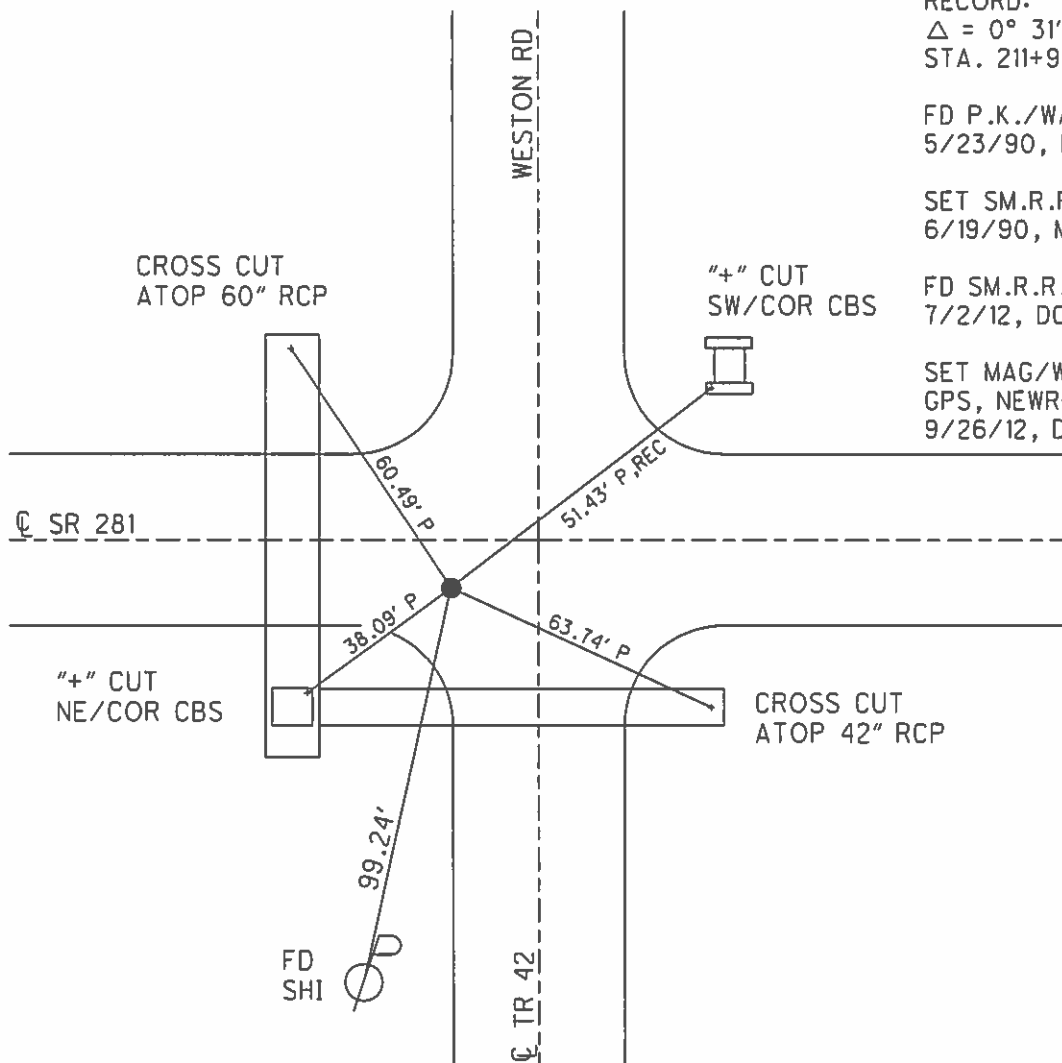

O.D.O.T. DISTRICT 2 SURVEY OFFICE

PERSONNEL

REFERENCE NO. 10

SHEET _____ OF _____

NOTES BARNHISEL

H.C. 11 4

R.C. Hoffman

DATE 5-23-90

WEATHER Sunny

TEMP. +65°

ROUTE 281

COUNTY WOOD

TOWNSHIP Milton

SECTION 23

T4 NR 9 E

TYPE MONUMENT P.K. & Washere

ON SURFACE - ~~BELOW~~ YES


LEFT - C. PAN'T. - RIGHT 4.5

— TO — EDGE PAVEMENT

SIM 213 + 01 on W. Edge of

[illegible]

ON W. Edge of Pav't North

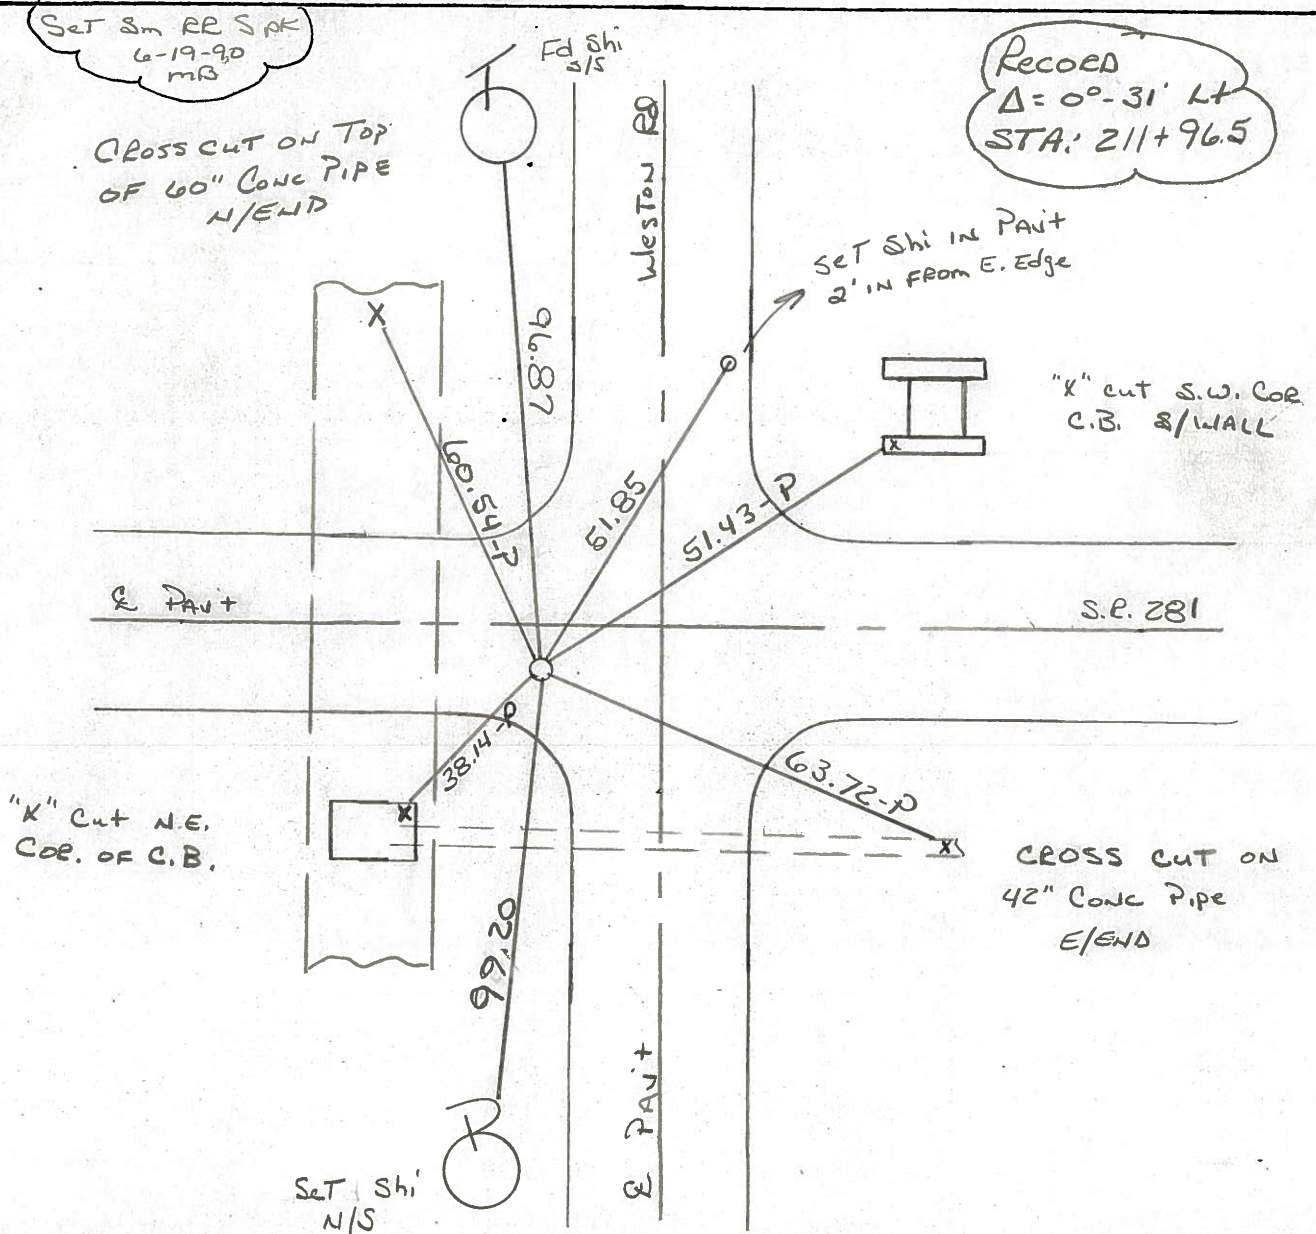

OD.OT. DISTRICT 2 SURVEY OFFICE

Sht. of

OK - 7-27-82 - 75° S.W.H.

County WOOD S.R. 281

Township MILTON

Section 23

T4N, R9E

Personnel S. HOFFMAN


C. Lochrke

J. Householder

Date 5-20-81

Weather clear

Temp. 65°

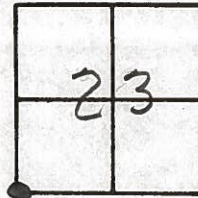

#10

"+" TOP of
PIPE @ N. END.

60" CONC. PIPE

± 281

"+" N.E. COR.
C.B. TOP



38.15-P

98.27-D

SHINER
S/S



96.82-D

WESTON ROAD

STA. 211 + 96.5

Δ = 0° - 31' LT.

Fd. BOAT SPK. @ SURFACE


4.5' S. OF ± PAVT. 281

10.3' W OF ± PAVT. WESTON RD.

SET P.K. & WASHER

8-12-82

S.W.H.

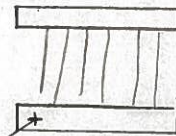

"+" S.W. COR
C.B. STRUCTURE

51.38-P

63.68-P

"+" TOP of 42" CONC. PIPE
@ E. END

SHINER
N/S

Q.D.O.T. DISTRICT 2 SURVEY OFFICE

Sht. of

OK - 7-27-82 - 75° S.W.H.

County WOOD S.R. 281

Date 5-20-81

Township MILTON

Weather clear

Section 23


Temp. 65°

T4N, R9E

Personnel S Hoffman

C Lockke

J Houscholder

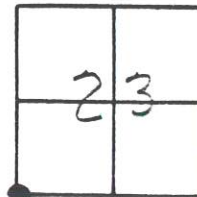

#10

"+" TOP of
PIPE @ N. END.

SHINER
S/S

STA. 211 + 96.5

$\Delta = 0^\circ - 31' \text{ LT.}$

Fd. GOAT SPR. @ SURFACE


4.5' S. OF & PAUT. 281

10.3' W OF & PAUT. WESTON RD.

SET P.K. & WASHER

8-12-82
S.W.H.

• SET shi
2' int From
E. Edge of PAUT

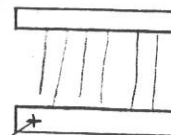

"+" S.W. COR
C.B. STRUCTURE

& 281

"+" N.E. COR
C.B. TOP

38.15-P
14

51.85
42.43
51.38-P

"+" TOP of 42" CONC. PIPE
@ E. END

213+01

FB P.K. SHANK

4.5 RT &

8.5 LT OF & NORTH

ON W. Edge PAUT NORTH

WESTON ROAD

SHINER
N/S

Q.D.O.T. DISTRICT 2 SURVEY OFFICE

Sht. ___ of ___

County WOOD S.R. 281

Township MILTON

Section 23

T4N, R9E

Personnel S. HOFFMAN

C. Loehrke

L. Householder

Date 5-20-81


Weather clear

Temp. 65°

7-27-82

+75°

SWN

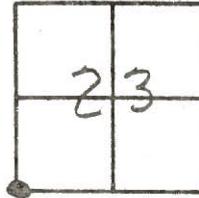

#10

"+" TOP of
PIPE @ N. END.

60" CONC. PIPE

± 281

"+" N.E. COR
C.B. TOP

SHINER
S/S

96.82-D

38.15-P

98.27-D

WESTON ROAD

SHINER
N/S

STA. 211 + 96.5


$\Delta = 0^\circ - 31'$ LT.

Fd. BOAT SPK. @ SURFACE

SLM 213 + 31

4.5 Sof & Pav + 281

0.3 W of & Pav + WESTON Rd.

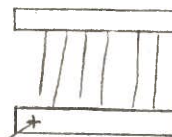

"+" S.W. COR
C.B. STRUCTURE

50.65 T.HUB

51.38-P
42

SCF P.K. / WASHER

8-12-82
SWN

"+" TOP of 42" CONC. PIPE
@ E. END

Notch cut
1' up stop sign post
45.88

PERSONNEL TITLE PERSONNEL TITLE
 CK. BY _____ COUNTY WOOD DATE OK-11-18-70
 SILVESTER _____ S. R. #281 WEATHER _____
 BURNSIDE _____ SEC. 23 TEMP. _____
 SMITH _____

DESCRIPTION LEFT CENTER LINE RIGHT JOB NO.

CONTROL TIES

STA. 238+39.4
 S. 1/4 Post SEC. 23
 MILTON Twp.
 $\Delta = 1^{\circ} 14' \text{ RT.}$
 13' S. OF N. EDGE PAVE.
 SET BOAT SPIKE

#153

#11

SHINER P. PILE N. 30.40
 SHINER T. PILE S. 29.29
 FACE IRON SIGN POST S.W. 37.79

STA. 211+96.5
 S.W. COR. SEC. 23
 MILTON TWP.
 T-4N R-9-E
 $\Delta = 0^{\circ} 31' \text{ LT.}$
 SET BOAT SPIKE
 (WESTON ROAD)

#152

#10

"X"-E. END 42' PIPE S.E. 63.6^(P)
 "X"-N. END 60' PIPE N.W. 60.5^(P)
 "X"-N.E. COR. C.B. TOP S.W. 38.1^(P)
 "WESTON ROAD" SIGN Post S.E. 38.1^(P)

PERSONNEL TITLE PERSONNEL TITLE

COUNTY Wood

DATE 12-4-57

S. R. #281

6-27-58

WEATHER 7-24-59

Sworden 3-22-60

SEC.

TEMP. 2-28-64

DESCRIPTION

LEFT

CENTER LINE

RIGHT

JOB NO.

Sta. 198+62.6

S.E. 1/4 post sec. 22

1960

Milton Twp.

(Fd P.K.)

No Angle P.I.

1959 Dug & Fd. Stone

#151-A

(9-A)

Sta. 211+96.5

S.W. Cor. sec. 23. Milton

Twp. Set P.R. Spk.

Weston Ed.

 $\Delta = 0^\circ - 31' 11''$

(10)

#152

Set Conc. Post N.N.E.

26.6

Shiner in cor. post N.

26.1

Shiner in P.P. N.W.

63.41 63.1

Set Conc. Post S.E.

47.3

N. To Tacked Hub

300'

S. To Shiner

300'

S.E. "X" cut in East end 42" Pipe

(Plumbed) 63.6

N.W. "X" cut in N. end 60" Pipe

(Plumbed) 60.5

S.W. "X" cut in N.E. Cor. C.B. Top

(Plumbed) 38.15

Sta. 238+39.4

S. 1/4 post sec. 23 Milton

Twp. (Fd 1/2" Iron Rod) (Fd. P.K.)

P.I. $\Delta = 1^\circ - 14' 11''$

13' S. of N. edge of pav't.

Shiner in P.P. N.

30.1

Shiner in T.P. S.

29.29' 29.1

Face iron sign post S.S.W.

45.1

(11)

#153

Note: For S.E. Cor. sec. 23

Milton Twp. see point

#75 S.H. 899, sec. A.