

O.D.O.T. DISTRICT 2 SURVEY OFFICE (USE ONLY)

PERSONNEL

REFERENCE NO. 27 A

SHEET 16 OF 36

NOTES NIESE

DATE 10/5/21

ROUTE SR 281

H.C. AUBLE

WEATHER PT.CLOUDY

COUNTY WOOD

R.C. NIESE

TEMP. 68°

TOWNSHIP PORTAGE

SECTION 19

DWG BY RHOADES

PID 94340

T 4 N R 11 E

TYPE MONUMENT MONBOX W/ 1" IPIN

ON SURFACE - ~~BELOW~~ ON

OFFSET CL PAVEMENT 0.5' LT : ~~RT~~

12' TO LT EDGE PAVEMENT



STATION: 660+24.21

HORIZ.DATUM: NAD83 2011

GEOID: NAVD88 2018

GRID: NORTHING: 590833.640

EASTING: 1654501.798

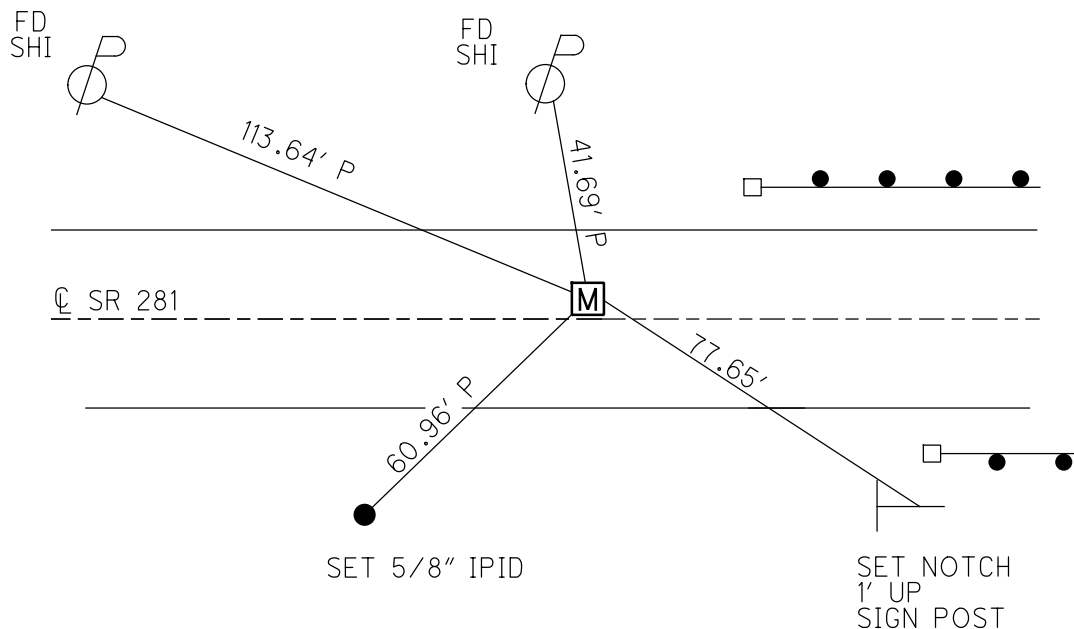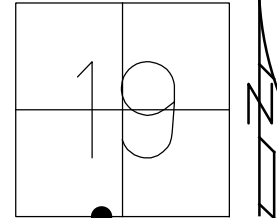

RECORD:
FD MONBOX
9-27-00
FD MONBOX
W/ 1" IPIN
5-25-04
7-8-04, RGN
FD MONBOX
W/ 1" IPIN
12-20-13, JLL
FD MONBOX
W/ 3/4" IPIN
REFA27
3-19-18, JLL
FD IPIN
5" DOWN
LEANING SOUTH
CKREFA27
6-13-18, JLL
FD MONBOX
W/ 1" IPIN
NEWREFA27
1-14-19, JLL
10/5/21, DSA

O.D.O.T. DISTRICT 2 SURVEY OFFICE (USE ONLY)

PERSONNEL

REFERENCE NO. 27 A

SHEET 16 OF 27

NOTES LEU

DATE 1-14-19

ROUTE SR 281

H.C. LEU

WEATHER SUNNY

COUNTY WOOD

R.C. MILLER

TEMP. 25°

TOWNSHIP PORTAGE

DWG BY JAMES PID 97957

SECTION 19

T 4 N R 11 E

TYPE MONUMENT MONBOX W/ 1" IPIN

ON SURFACE - ~~BELOW~~ ON

OFFSET Q PAVEMENT 0.5' LT : ~~RT~~

12' TO LT EDGE PAVEMENT


STATION: 660+67

HORIZ.DATUM: NAD83 2011


GEOID: NAVD88 2012A

GRID: NORTHING: 590833.640

EASTING: 1654501.798

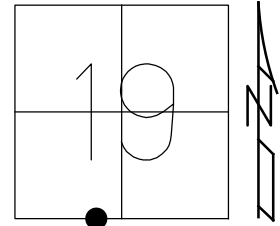

RECORD:
FD MONBOX
9-27-00
FD MONBOX
W/ 1" IPIN
5-25-04
7-8-04, RGN
FD MONBOX
W/ 1" IPIN
12-20-13, JLL
FD MONBOX
W/ 3/4" IPIN
REFA27
3-19-18, JLL
FD IPIN
5" DOWN
LEANING SOUTH
CKREFA27
6-13-18, JLL
FD MONBOX
W/ 1" IPIN
NEWREFA27
1-14-19, JLL

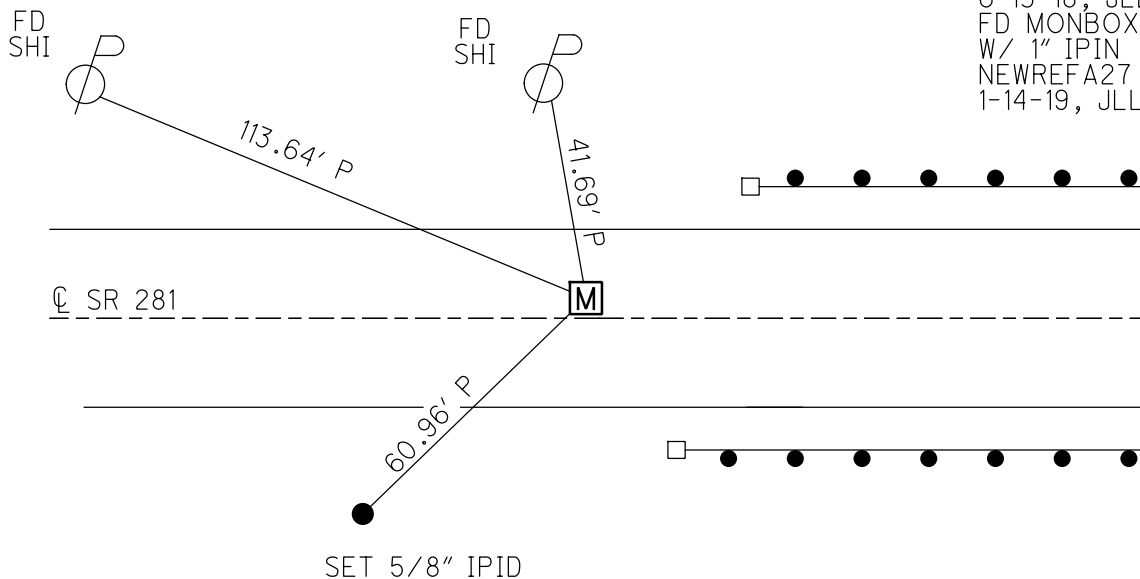

O.D.O.T. DISTRICT 2 SURVEY OFFICE (USE ONLY)

PERSONNEL

REFERENCE NO. 27-A

SHEET 16 OF 25

NOTES RHOADES

DATE 12-20-13

ROUTE S.R. 281

H.C. LEU

WEATHER RAINY/WINDY

COUNTY WOOD

R.C. RHOADES

TEMP. 40° F

TOWNSHIP PORTAGESECTION 19

T 4 N R 11 E

TYPE MONUMENT 1" IRON PIN IN MONUMENT BOX

ON SURFACE - ~~BELOW~~ YES

LEFT - C PAV'T ~~RIGHT~~ 0.9'


12' TO LT. EDGE PAVEMENT

S.L.M. 660+67

Grid: Northing: 590,833.637 Easting: 1,654,501.846



NAD83 (2011) GEOID 12A

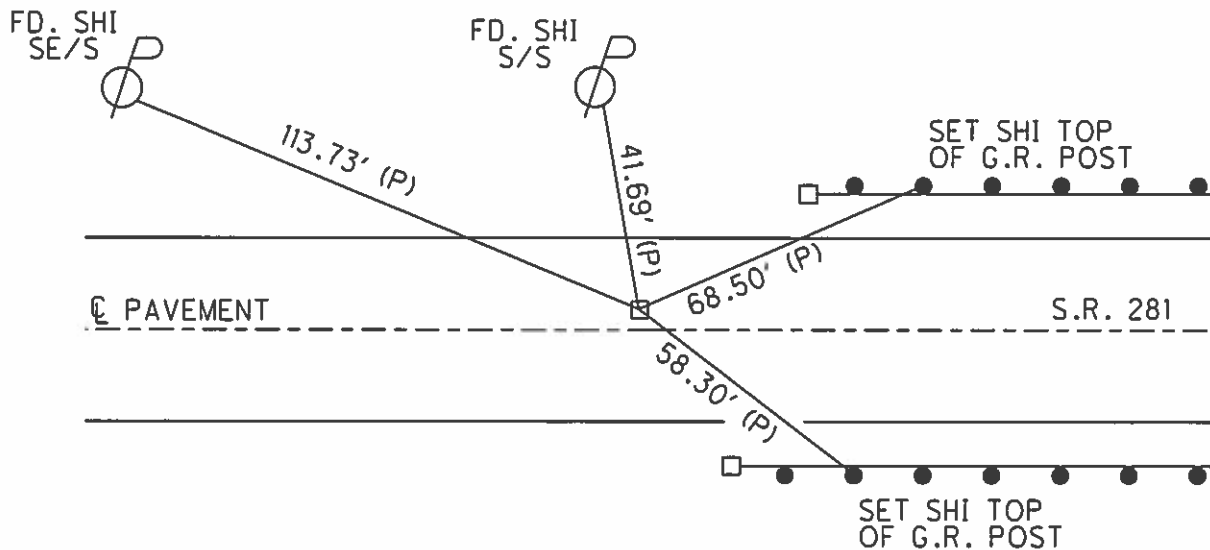

RECORD

09-27-00
RE-SET WITH NEW
BOX TO GRADE

05-25-04 RGN
FD. 1" I.P. IN MON BOX

07-08-04 RGN
MON BOX VISIBLE

O.D.O.T. DISTRICT 2 SURVEY OFFICE

PERSONNEL

REFERENCE NO. 27-A

SHEET 2 OF 11

NOTES HOFFMAN

H.C. LOEHRKE

R.C. BARNHISEL

DATE 6-5-90

WEATHER CLEAR

TEMP. 68°

ROUTE SR 281

COUNTY WOOD

TOWNSHIP PORTAGE

SECTION 19

T 4 N R 11 E


TYPE MONUMENT MONUMENT BOX

ON SURFACE - BELOW YES


LEFT - 0 PAV'T. - RIGHT 0.9

11.0 TO LT EDGE PAVEMENT

S.L.M. 660+67

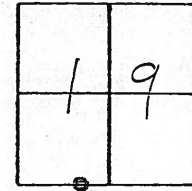

DID NOT OPEN BOX
TIES TO CTR of LID

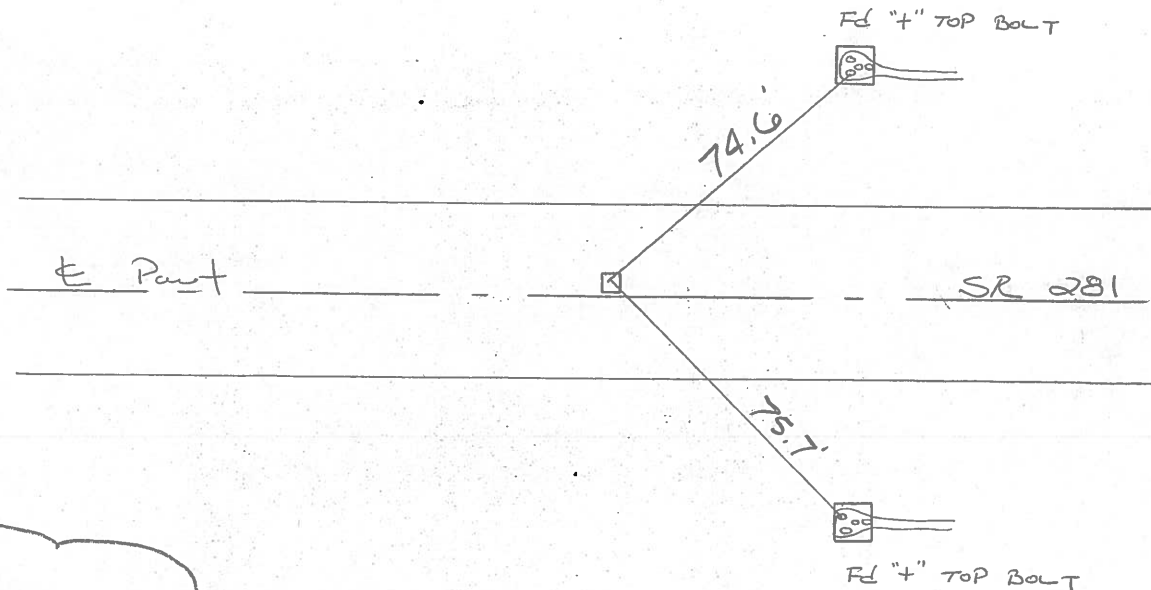

NOTE:
Re-set with
New Box To GRADE
9-27-00

ODOT. DISTRICT 2 SURVEY OFFICE

SHEET _____ OF _____

County Wood S.R. 281

Township PORTAGE

Section 19

T4N, R1E

Personnel HOFFMAN

LOEHLKE

HOUSEHOLDER


BARNHISEL

27-A

Date MARCH 28, 83

Weather OVERCAST - WINDY


Temp. +30°

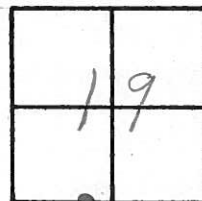

Fd ☐ mon. Box @ surface ✓ 5/25/83
on & PAUT.

SLM 661+15

DID NOT OPEN BOX -
TIES TO CTR of LID.

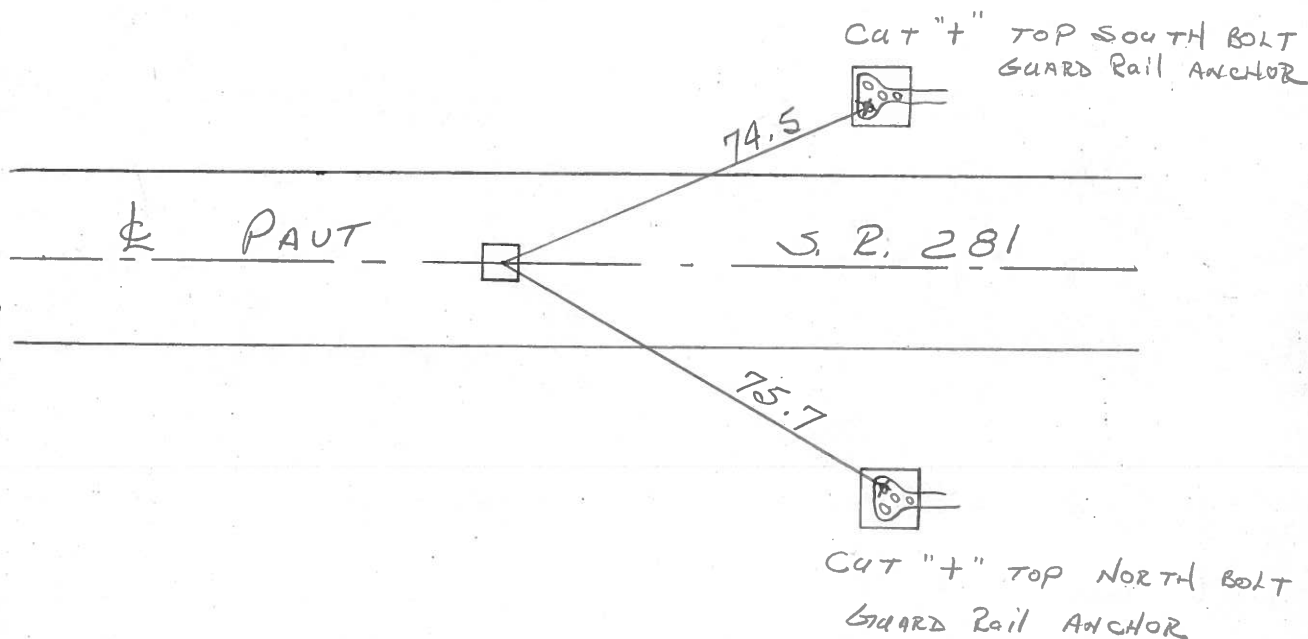

Q.D.O.T. DISTRICT 2 SURVEY OFFICE

SHEET _____ OF _____

County Wood S.R. 281

Township PORTAGE

Section 19

T4N, R1E

Personnel HOFFMAN

LOEHLKE

HOUSEHOLDER


BARNHISEL

27-A

Date MARCH 28, 83

Weather OVERCAST - WINDY

Temp. +30°

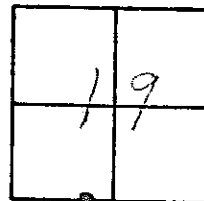


Fd ☐ mon. Box @ surface ✓ 5/25/83
ON & PAUT.

SLM 661+15

DID NOT OPEN BOX -
TIES TO CTR of LID.

660+67
0.9
11.0

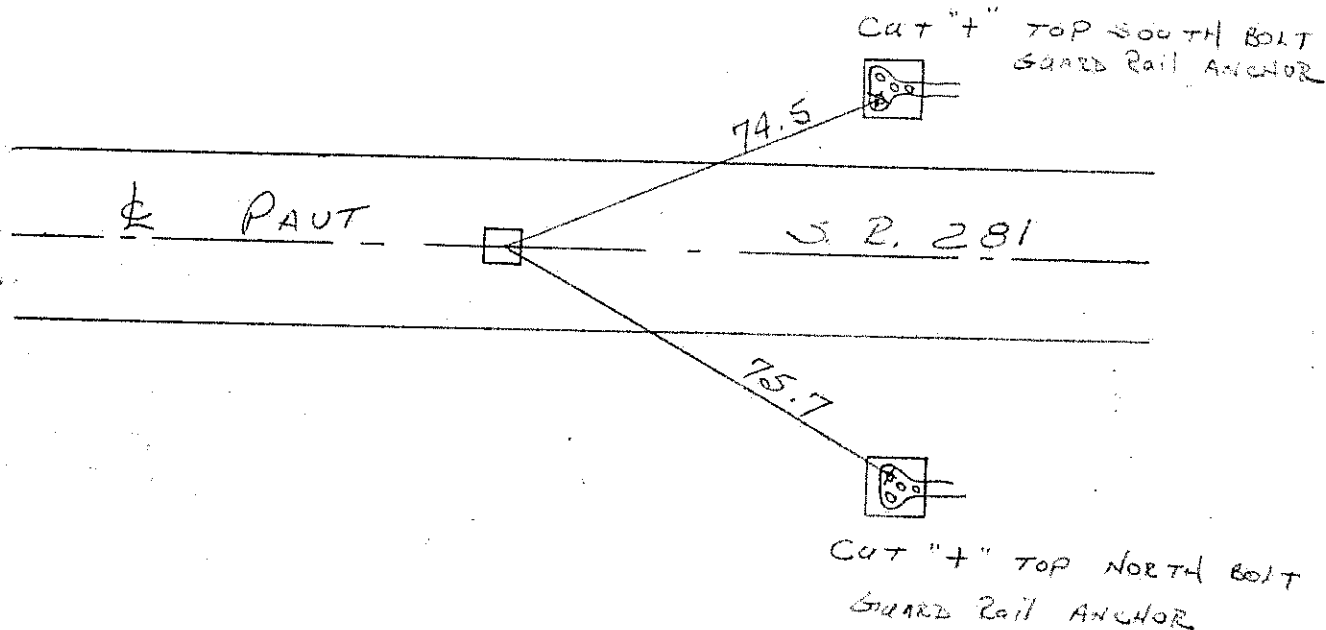

27-A

