

O.D.O.T. DISTRICT 2 SURVEY OFFICE (USE ONLY)

PERSONNEL

REFERENCE NO. 28 B

SHEET 18 OF 27

NOTES LEU

DATE 1-14-19

ROUTE SR 281

H.C. LEU

WEATHER SUNNY

COUNTY WOOD

R.C. MILLER

TEMP. 26°

TOWNSHIP PORTAGE

DWG BY JAMES PID 97957

SECTION 19

T 4 N R 11 E

TYPE MONUMENT MONBOX W/ 1" IPIN

ON SURFACE - ~~BELOW~~ ON

OFFSET CL PAVEMENT ON ~~LT~~ : ~~RT~~

11' TO RT EDGE PAVEMENT


STATION: 672+68

HORZ.DATUM: NAD83 2011


GEOID: NAVD88 2012A

GRID: NORTHING: 590783.978

EASTING: 1655700.784

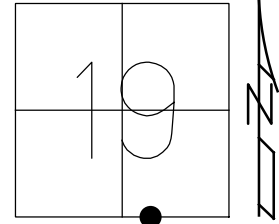

RECORD:
FD MONBOX
9-26-00
FD MONBOX
W/ 1" IPIN
5-25-04
7-8-04, RGN
REFB28
3-19-18, JLL
CKREFB28
6-13-18, JLL
NEWREFB28
1-14-19, JLL

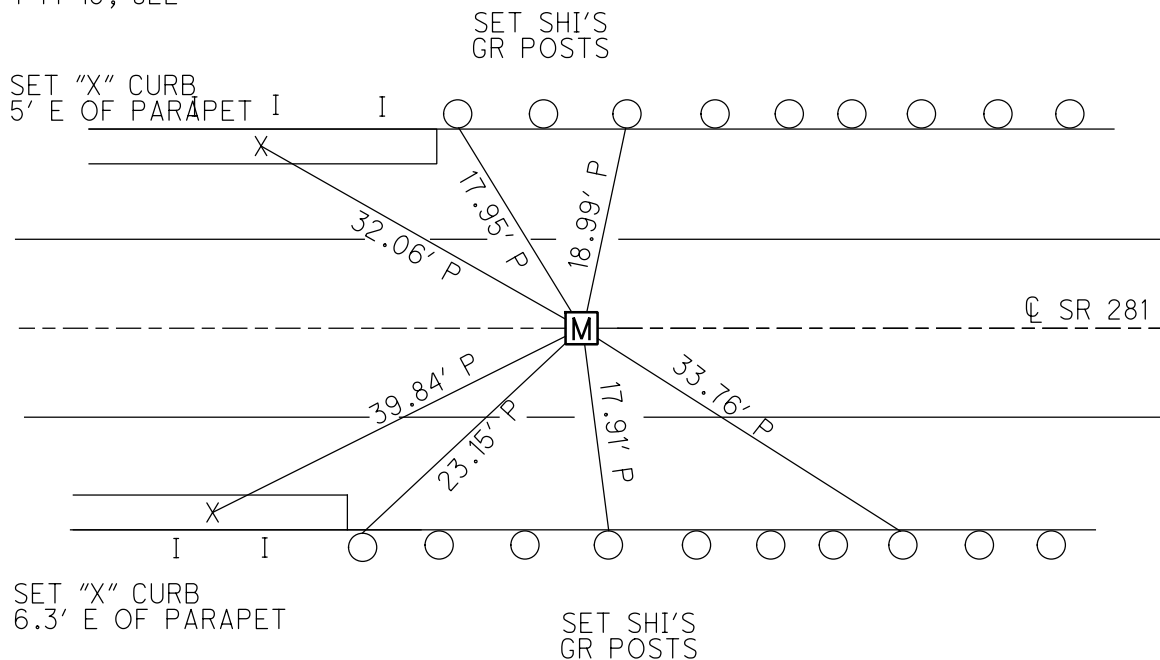

O.D.O.T. DISTRICT 2 SURVEY OFFICE (USE ONLY)

PERSONNEL

REFERENCE NO. 28-B

SHEET 18 OF 25

NOTES RHOADES

DATE 12-20-13

ROUTE S.R. 281

H.C. LEU

WEATHER RAINY/WINDY

COUNTY WOOD

R.C. RHOADES

TEMP. 40° F

TOWNSHIP PORTAGE

SECTION 19

T 4 N R 11 E

TYPE MONUMENT 1" IRON PIN IN MONUMENT BOX


ON SURFACE - ~~BLOW~~ YES

~~PAV'T~~ RIGHT YES

11' TO RT. EDGE PAVEMENT


S.L.M. 672+68

Grid: Northing: 590,783.999 Easting: 1,655,700.776

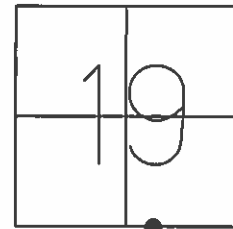

FD. CUT "x"
ON SIDEWALK
OVER BRIDGE

1' UP STEEL
G.R. I-POST
NEAR SIDE

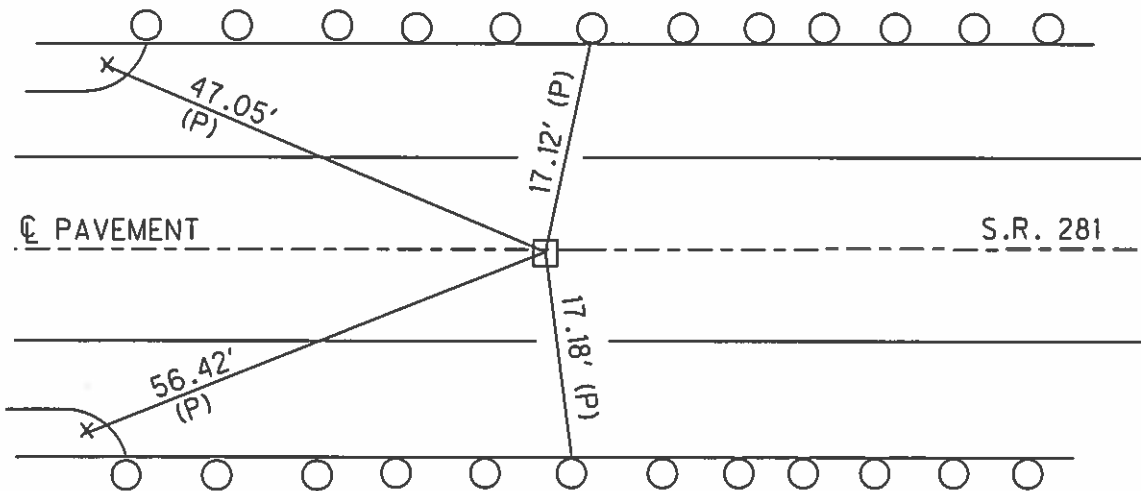

FD. CUT "x"
ON SIDEWALK
OVER BRIDGE

1' UP STEEL
G.R. I-POST
NEAR SIDE

RECORD

09-26-00
RE-SET SAME
BOX TO GRADE

05-25-04 RGN
FD. 1" I.P. IN MON BOX

07-08-04 RGN
MON BOX VISIBLE

O.D.O.T. DISTRICT 2 SURVEY OFFICE

PERSONNEL

REFERENCE NO. 28-B

SHEET 4 OF 11

NOTES HOFFMAN

H.C. LOSHRKE

R.C. BARNHISEL

DATE 6-5-90

WEATHER CLEAR

TEMP. 68°

ROUTE SR 281

COUNTY WOOD

TOWNSHIP PORTAGE

SECTION 19

T. 4 N. R. 11 E.


TYPE MONUMENT MONUMENT BOX

ON SURFACE - BELOW YES


LEFT - ~~C~~ PAVT. - RIGHT 0.6'

11.5 TO RT. EDGE PAVEMENT

S.L.M. 672+68

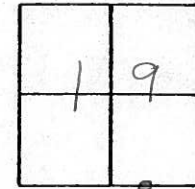

DID NOT OPEN BOX
TIES TO CTR. of LID

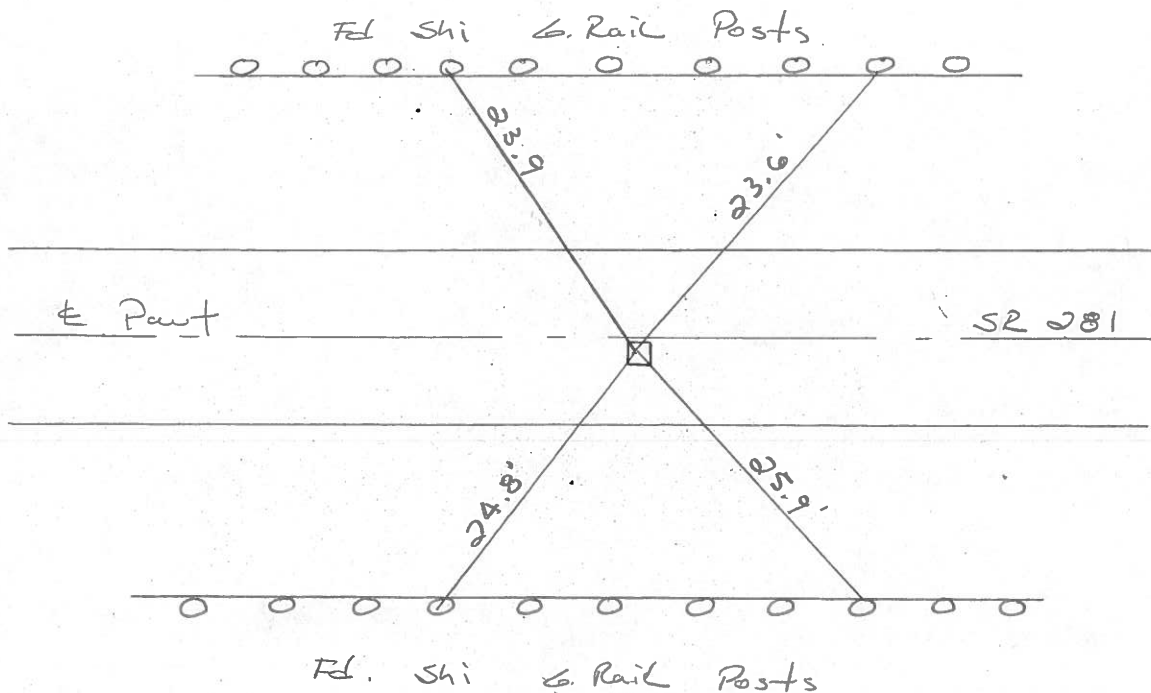

NOTE:
Re-set
SAME BOX
TO GRADE.
9-27-00

Q.D.O.T. DISTRICT 2 SURVEY OFFICE

SHEET _____ OF _____

County WOOD S.R. 281

Date MARCH 28, 83

Township PORTAGE

Weather OVERCAST - WINDY

Section 19

Temp. +30°

T4N, R11E


Personnel HOFFMAN

LOEHKE

HOUSEHOLDER

BARNHISEL


28-B

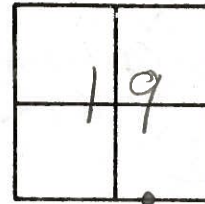

Fd. ☐ MON. BOX @ SURFACE 5/25/83
ON R PAUT

SLM 673 + 15

DID NOT OPEN BOX -
TIES TO CTR of LID.

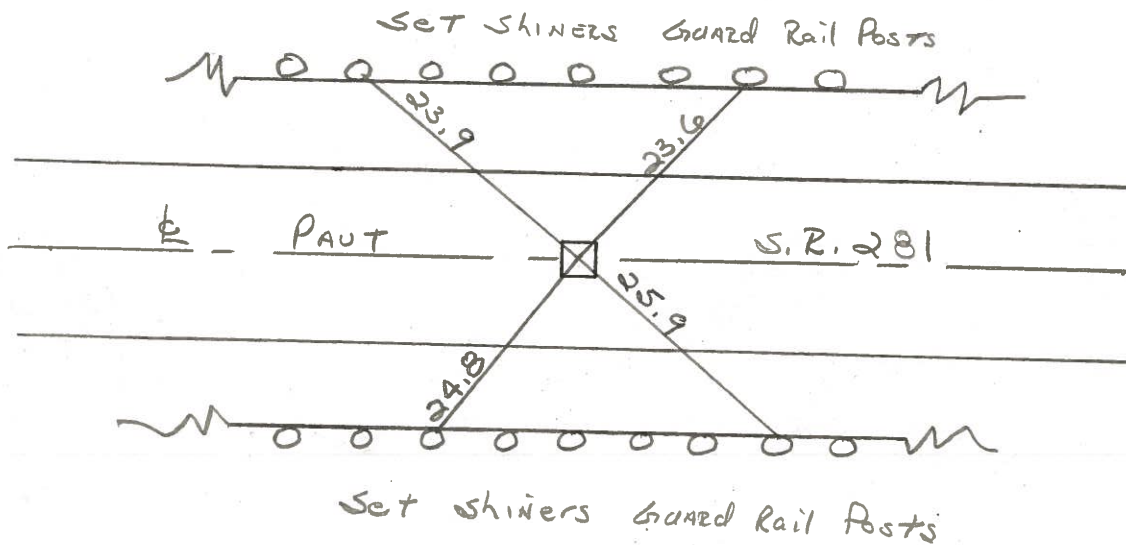

Q.D.O.T. DISTRICT 2 SURVEY OFFICE

SHEET _____ OF _____

County WOOD S.R. 281

Township PORTAGE

Section 19

T4N, R11E

Personnel HOFFMAN

LOEHRKE


HOUSEHOLDER

BARNHISEL

Date MARCH 28, 83

Weather OVERCAST - WINDY

Temp. +30°

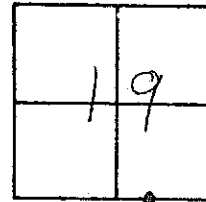

28-B

Fd. ☐ Mon. Box @ SURFACE ☒ 5/25/83
ON & PAUT


SLM 673 + 15


672 + 68

0.6 R+off

11.5 R+off

DID NOT OPEN BOX -
TIES TO CTR of LID.

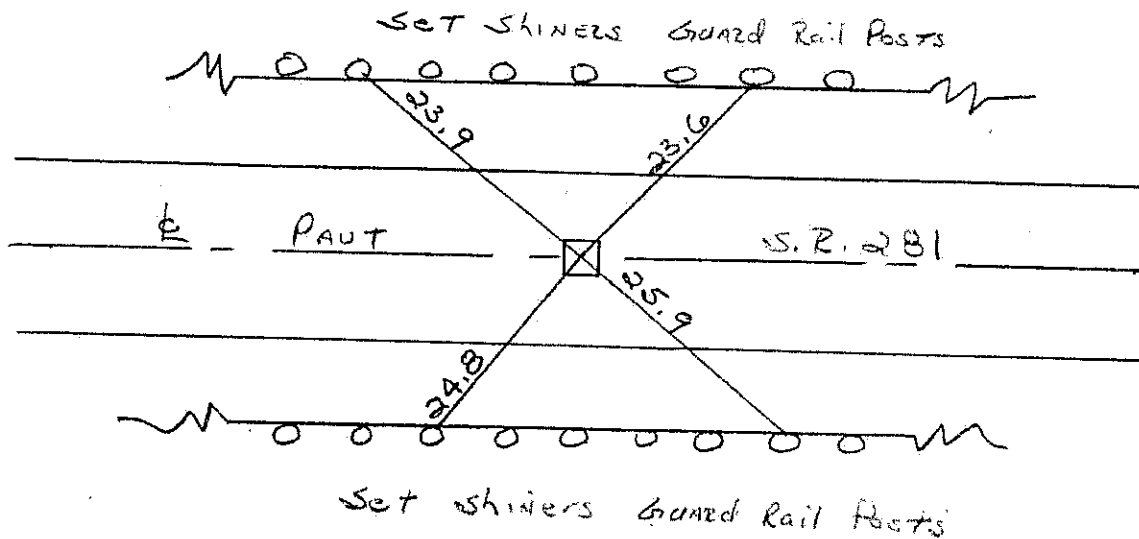

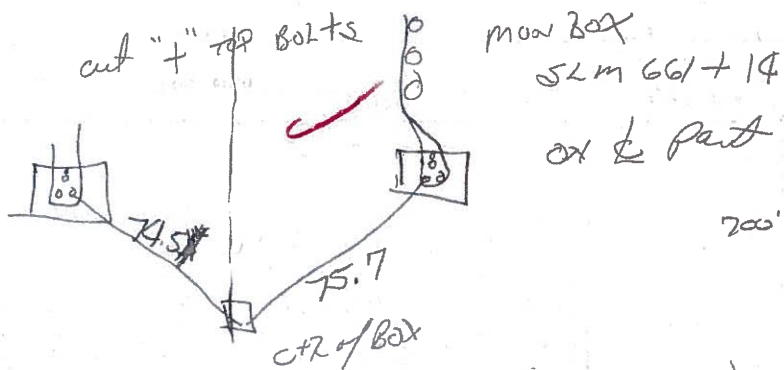

$$\begin{array}{r} 692 + 61 \\ 661 + 14 \\ \hline 31 + 47 \end{array}$$

26+40

$$\begin{array}{r} 692 + 61 \\ 681 + 15 \\ \hline 11 + 46 \end{array}$$

$$\begin{array}{r} 692 + 61 \\ 668 + 15 \\ \hline 24 + 46 \end{array}$$

