

O.D.O.T. DISTRICT 2 SURVEY OFFICE (USE ONLY)

PERSONNEL

REFERENCE NO. 29

SHEET 21 OF 36

NOTES PRESTON-COLVIN

DATE 10/4/24

ROUTE SR 281

H.C.

WEATHER CLOUDY

COUNTY WOOD

R.C. NEISE

TEMP. 73°

TOWNSHIP PORTAGE

DWG BY PRESTON-COLVIN

PID CHIP SEAL

SECTION 19

T 4 N R 11 E

TYPE MONUMENT SHANK

ON SURFACE - ~~BELOW~~ ON

OFFSET Q PAVEMENT 1.0' ~~LT~~ : RT

 TO EDGE PAVEMENT

STATION: 691+69.25

HORIZ.DATUM: NAD83 2011


GEOID: NAVD88 2018

GRID: NORTHING: 590704.042


EASTING: 1657644.165

LDP: NORTHING: 412615.59

EASTING: 169239.86

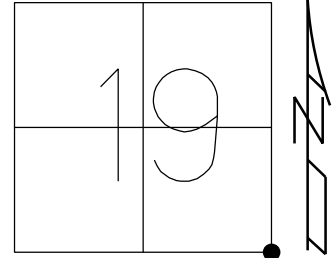

RECORD:
SET P.K./WASHER
7-2-90, SWH
FD P.K./WASHER
7-8-04
FD P.K. NAIL
REF29
FD P.K./WASHER
7-3-12, DCH
SET MAG/WASHER
NEWREF29
1-7-13, DCH
FD MAG/WASHER
REF29
3-19-18, JLL
10/5/21, DSA
FD SHANK
NEWREF29
8-2-24, TDN
SET MAG/WASHER
10-4-24, TDN

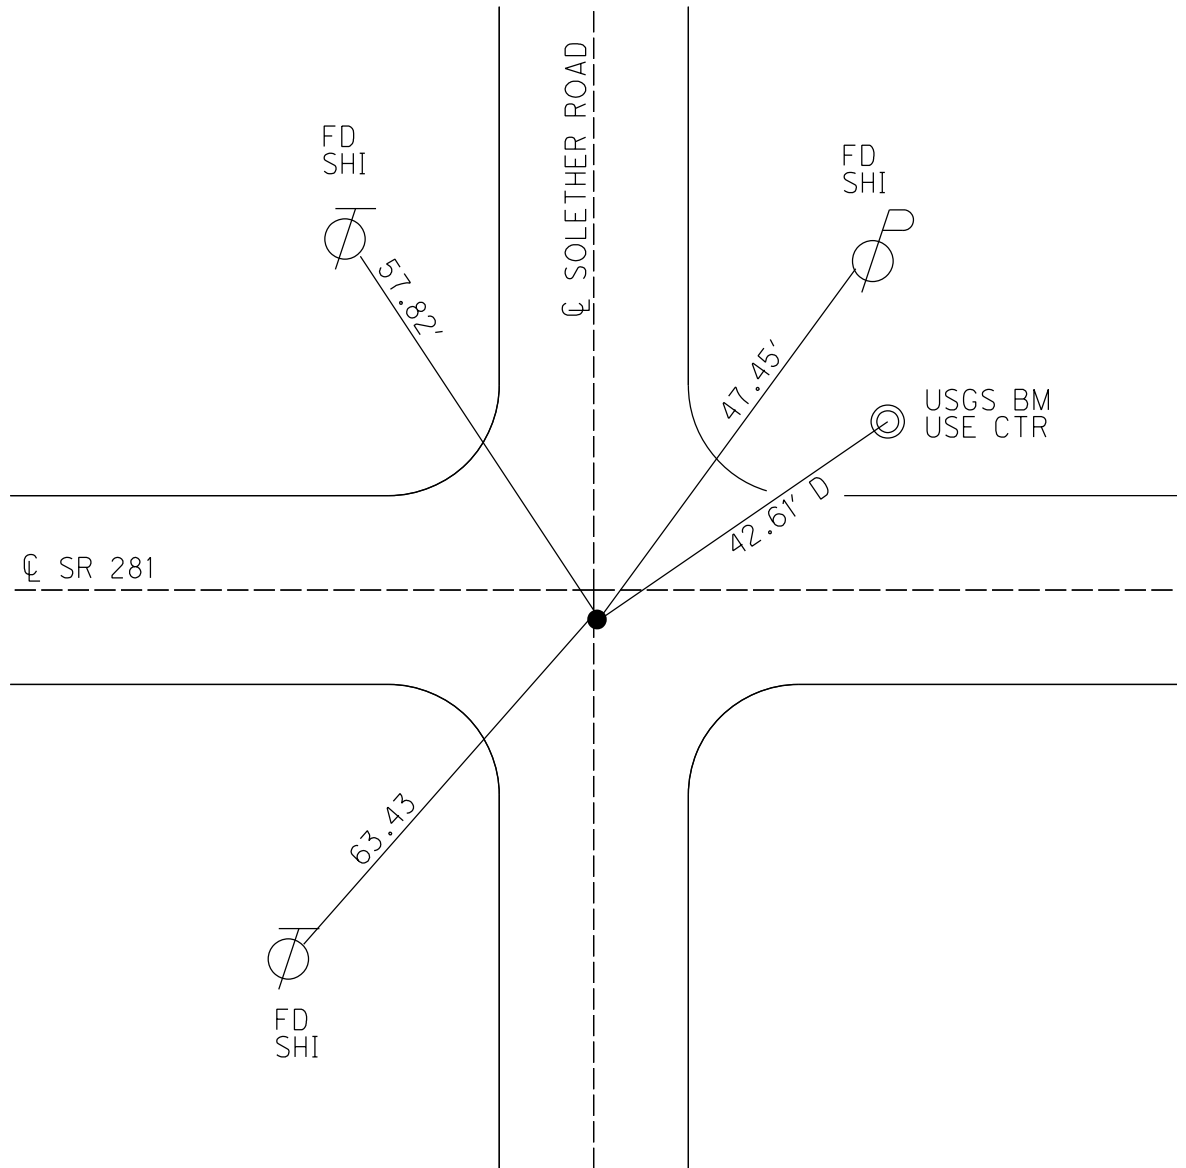

O.D.O.T. DISTRICT 2 SURVEY OFFICE (USE ONLY)

PERSONNEL

REFERENCE NO. 29

SHEET 20 OF 36

NOTES NIESE

DATE 10/5/21

ROUTE SR 281

H.C. AUBLE

WEATHER OVERCAST

COUNTY WOOD

R.C. NIESE

TEMP. 66°

TOWNSHIP PORTAGE

SECTION 19

DWG BY RHOADES PID 94340

T 4 N R 11 E

TYPE MONUMENT MAG/WASHER

ON SURFACE - ~~BELOW~~ ON

OFFSET CL PAVEMENT 1.0' ~~LT~~ : RT

- TO - EDGE PAVEMENT


STATION: 691+69.25

HORIZ.DATUM: NAD83 2011


GEOID: NAVD88 2012A

GRID: NORTHING: 590704.042

EASTING: 1657644.165

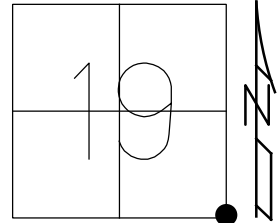

RECORD:
SET P.K./WASHER
7-2-90, SWH
FD P.K./WASHER
7-8-04
FD P.K. NAIL
REF29
FD P.K./WASHER
7-3-12, DCH
SET MAG/WASHER
NEWREF29
1-7-13, DCH
FD MAG/WASHER
REF29
3-19-18, JLL
10/5/21, DSA

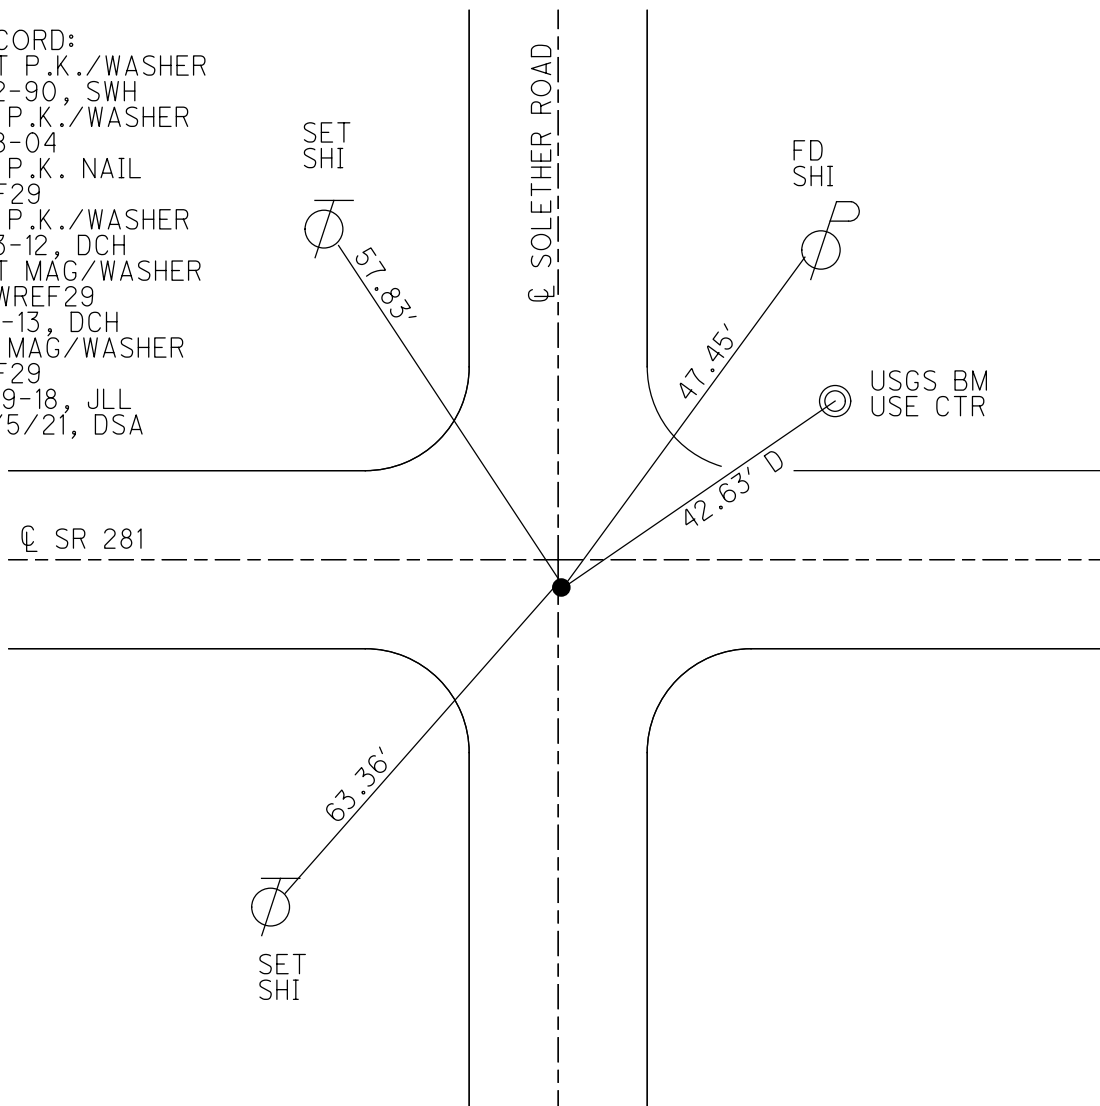

O.D.O.T. DISTRICT 2 SURVEY OFFICE (USE ONLY)

PERSONNEL

REFERENCE NO. 29

SHEET 20 OF 27

NOTES HOMAN
H.C. ROUSOS
R.C. COUTCHER
HARBAUGH

DATE 7-3-12
WEATHER CLOUDY
TEMP. 85°

ROUTE SR 281
COUNTY WOOD
TOWNSHIP PORTAGE
SECTION 19
T 4 N R 11 E

DWG BY JAMES PID 97957

TYPE MONUMENT P.K./WASHER

ON SURFACE - ~~BELOW~~ ON

OFFSET $\varnothing$ PAVEMENT 1.0' ~~LT~~ : RT

- TO - EDGE PAVEMENT


STATION: 693+79.20

HORZ.DATUM: NAD83 2011


GEOID: NAVD88 2012A

GRID: NORTHING: 590704.042

EASTING: 1657644.165

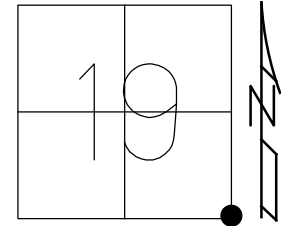

RECORD:
SET P.K./WASHER
7-2-90, SWH
FD P.K./WASHER
7-8-04
FD P.K. NAIL
REF29
FD P.K./WASHER
7-3-12, DCH
SET MAG/WASHER
NEWREF29
1-7-13, DCH
FD MAG/WASHER
REF29
3-19-18, JLL

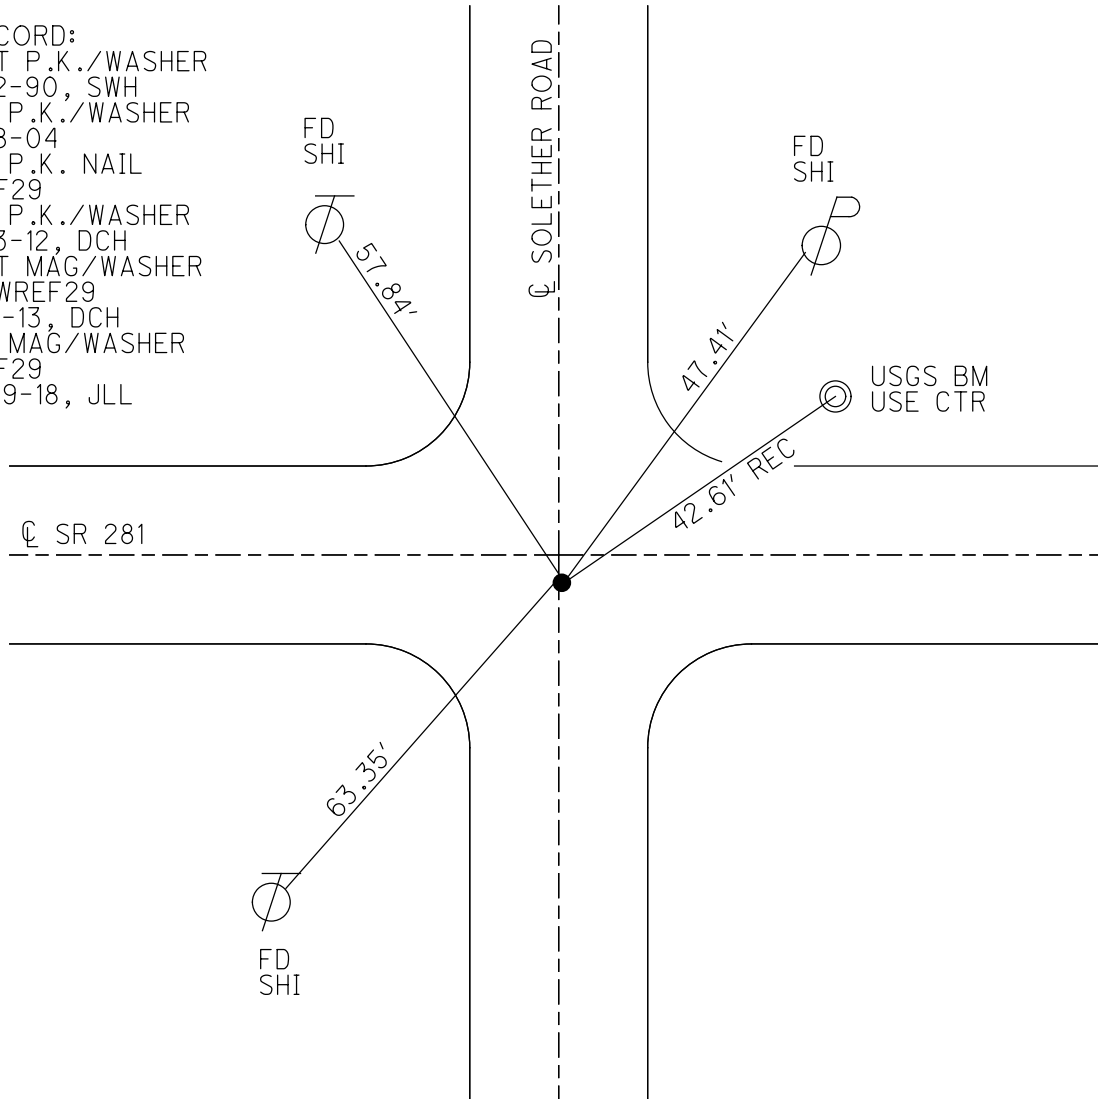

O.D.O.T. DISTRICT 2 SURVEY OFFICE (USE ONLY)

PERSONNEL

REFERENCE NO. 29

SHEET 20 OF 25

NOTES NUHFER

DATE 5-25-04

ROUTE S.R. 281

H.C. HOMAN

WEATHER CLEAR

COUNTY WOOD

R.C. ADKINS

TEMP. +68°

TOWNSHIP PORTAGE

SECTION 19

T 4 N R 11 E

TYPE MONUMENT P.K./WASHER


ON SURFACE - ~~BELLO~~ YES

~~SET~~ - CL PAV'T - RIGHT 1.0'

- TO - EDGE PAVEMENT


S.L.M. 692+14

Grid: Northing: _____ Easting: _____

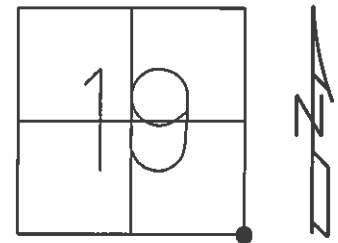

SET P.K./WASHER
7-2-90 SWH
FD PK/WASHER
7-8-04
RGN

RECORD:
S.E. COR. SEC. 19

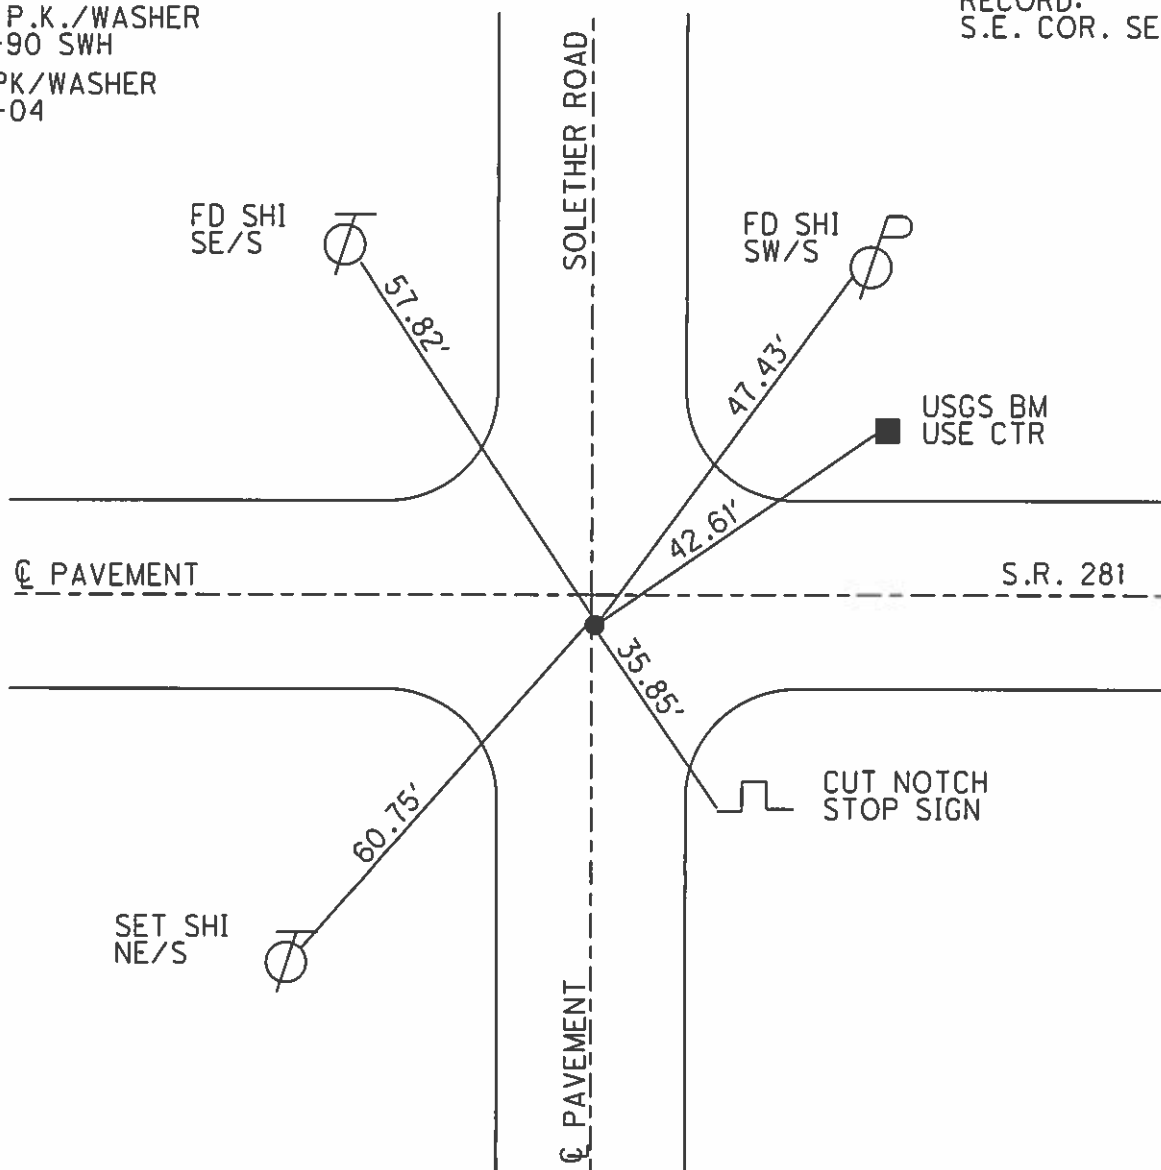

O.D.O.T. DISTRICT 2 SURVEY OFFICE

PERSONNEL

REFERENCE NO. 29

SHEET 6 OF 11

NOTES HOFFMAN

H.C. LOENRKE

R.C. BARNHISEL

DATE 6-5-90

WEATHER CLEAR

TEMP. 68°

ROUTE SR 281

COUNTY WOOD

TOWNSHIP PORTAGE

SECTION 19

T4 N R 11 E


TYPE MONUMENT P.K. / WASHER

ON SURFACE - BELOW YES

LEFT - C PAV'T. - RIGHT 1.0'


TO EDGE PAVEMENT

S.L.M. 692 + 14

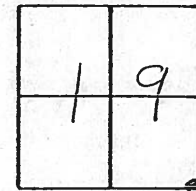

Set P.K. / WASHER
7-2-90 SWN

RECORD:
S.E. COR. SEC. 19

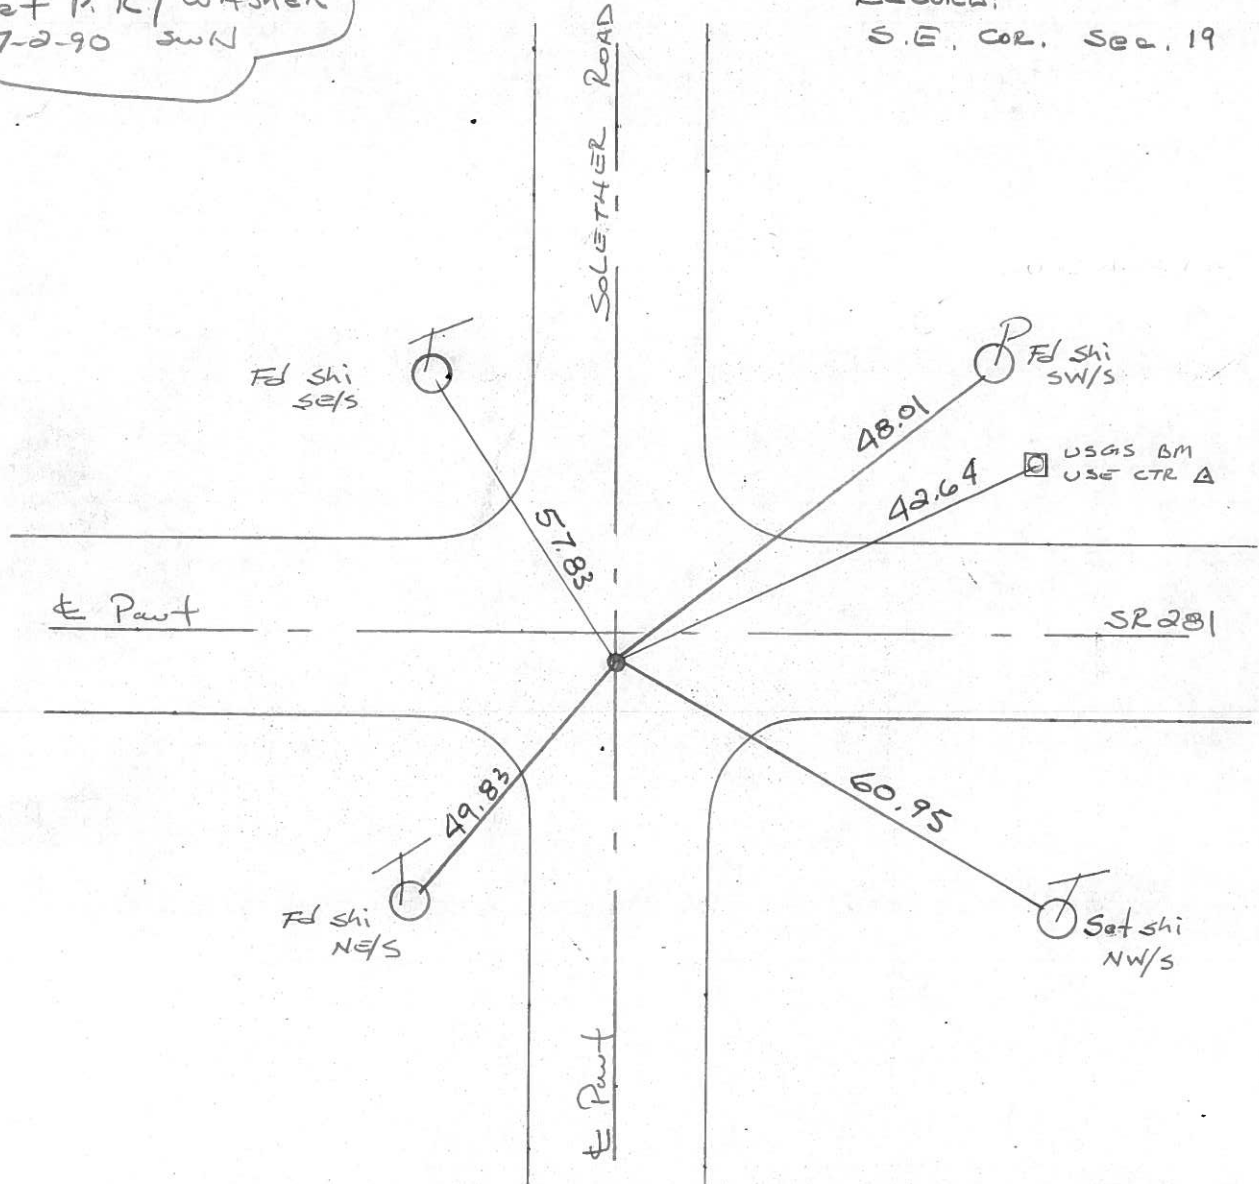

SHEET _____ OF _____

Date MARCH 28, 83

Weather OVERCAST - WINDY

Temp. +30°

1	9

N
A


#29

Fd Boat spike @ surface
0.8' Rt of L Paut SR 281
ON L Paut SOUTHER Rd.

SLM 692 + 61

SET P.K./WASHER
5/25/83 S.W.H.

Record:
S, E, Cor, Sec. 19

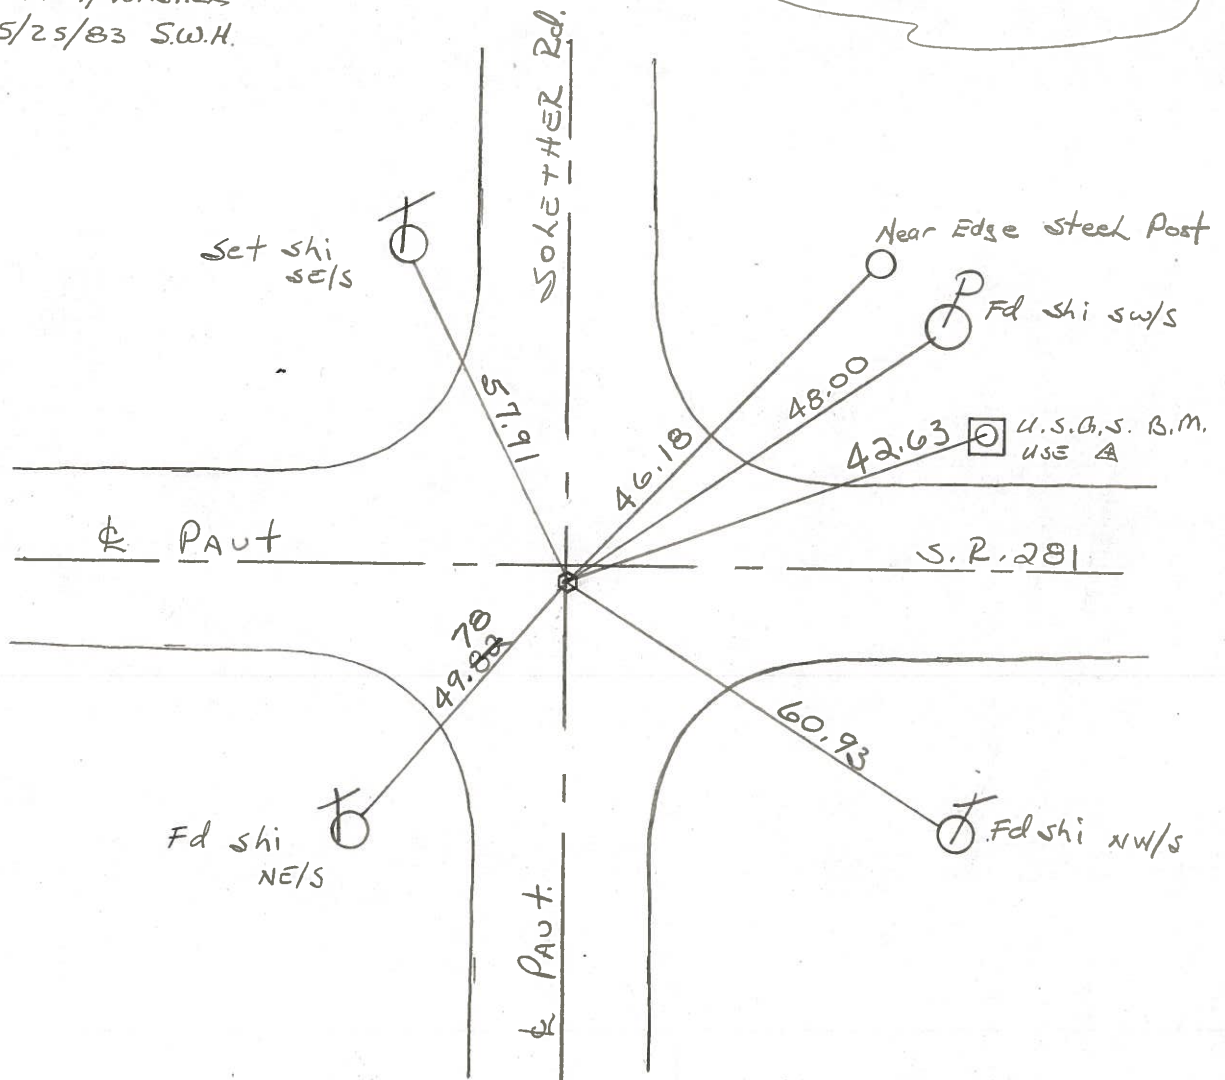

ODOT. DISTRICT 2 SURVEY OFFICE

SHEET _____ OF _____

County WOOD S.R. 281

Township PORTAGE

Section 19

T4N., R1E

Personnel Hoffman

LOHRKE

HOUSEHOLDER


BARNHISEL

#29

Date MARCH 28, 83

Weather OVERCAST - WINDY

Temp. +30°

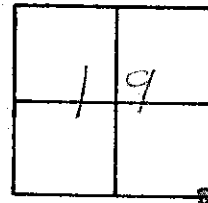

Fd Boat spike @ surface
0.8' Rt of & Paut S.R. 281
ON & Paut SOLE+HER Rd.

SET P.K./WASHER

5/25/83 S.W.H.

692+14


1.0 Rt of & 281

PK/washer surface

S.L.M. 692+61

Record!

S.E. Cor. Sec. 19

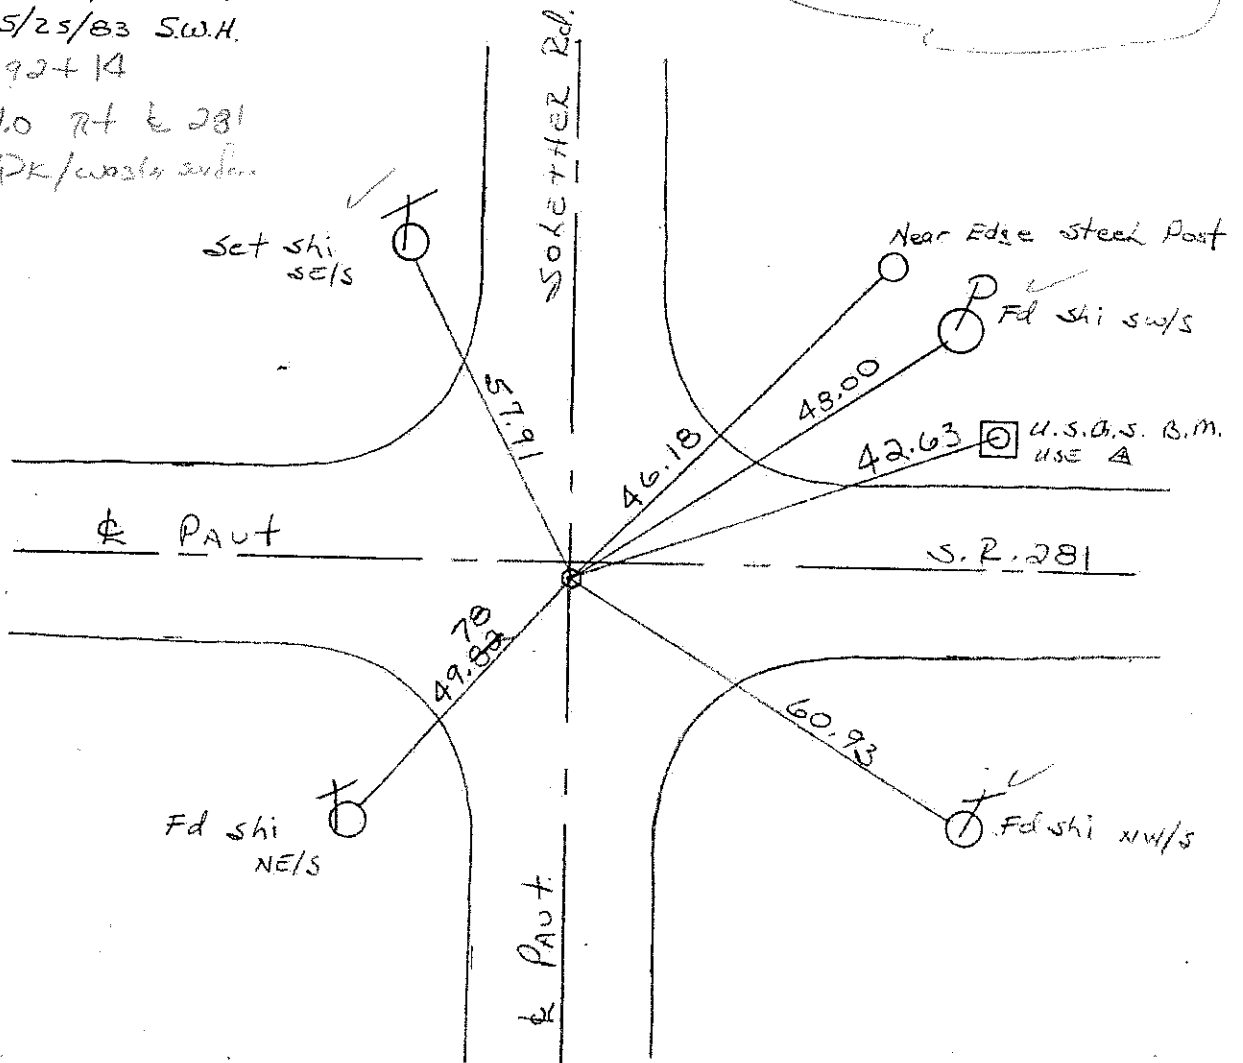

RE COPIED
1-26-71

SHEET NO. 15

PERSONNEL	TITLE	PERSONNEL	TITLE	COUNTY	DATE	WEATHER	TEMP.	JOB NO.
CK. BY				WOOD	OK-7-24-69			
SILVESTER				S. R. #281				
BURNSIDE				SEC. 19 & 20				
SMITH								

DESCRIPTION: CONTROL TIES

LEFT CENTER LINE RIGHT

STA. 78+86.0
S. 1/4 Post SEC. 20 = N 1/4 Sec 29
PORTAGE TWP.
A = 0° - 22' - 30" RT.
"STONE" - R.R. Spk.

#30

#169

30.59

29.35

36.21

cut +
soud. edge Rim

Rd Bnt + Spk

S.E. COR, SEC. 19 = NW cor Sec 29
PORTAGE TWP.
R.R. Spk.

#29

SOLETHOR ROAD

692+6

#168

57.91

49.82

SHINER IN T. POLE S.W. 36.10'
SHINER IN CABLE POLE N.W. 29.43
~~"X" IN 6" STEEL COR. POST S.E. 34.82~~
SHINER IN P. POLE N.E. 30.56
~~FACE 6" STEEL BR. POST S.E. 38.06~~

Lf & 3.9

N 4 5.9

S 4 12.3

SLM 718+84

to
pole loose

~~SHINER 12" CHERRY N.E. 51.43'~~
~~SHINER P. POLE S.W. 43.55'~~
~~CONC. MON. S.E. 51.32'~~
~~U.S.G.S. MON. N.E. 42.62'~~
46.18 ~~FACE IRON COR. POST N.E. 46.62~~
48.00 ~~SHINER IN T. POLE E.S.E. 60.94'~~
48.00 ~~SHINER IN T. POLE S.S.W. 49.86~~
48.00 ~~SHINER IN T. POLE N.N.W. 55.98~~

0.8 R + & 281

RE COPIED
1-26-71

SHEET NO.

15

PERSONNEL

TITLE

PERSONNEL

TITLE

COUNTY

WOOD

DATE

OK-7-24-69

CK. BY

SILVESTER

S. R.

#281

WEATHER

BURNSIDE

SMITH

SEC.

19 & 20

TEMP.

DESCRIPTION

CONTROL TIES

JOB NO.

LEFT

CENTER LINE

RIGHT

STA. 78+86.0
S. 1/4 Post SEC. 20 = N. 1/4 Sec 29
PORTAGE TWP.
 $\Delta = 0^\circ - 22' - 30''$ RT.
"STONE" - R.R. Spk.

#30

#169

SHINER IN T. POLE S.W. 36.10'
SHINER IN CABLE POLE N.W. 29.43'
"X" IN 6" STEEL COR. POST S.E. 34.82'
SHINER IN P. POLE N.E. 30.56'
FACE 6" STEEL BR. POST E.S.E. 38.06'

S.E. COR. SEC. 19 = NW COR SEC 29
PORTAGE TWP.
R.R. Spk.

#29

SOLETHUR ROAD

#168

SHINER 12" CHERRY N.E. 51.43'
SHINER P. POLE S.W. 43.55'
CONC. MON. S.E. 51.32'
U.S.G.S. MON. N.E. 42.62'
FACE IRON COR. POST N.E. 46.62'
SHINER IN T. POLE E.S.E. 60.91'
SHINER IN T. POLE S.S.W. 49.86'
SHINER IN T. POLE N.N.W. 55.98'


PERSONNEL TITLE PERSONNEL TITLE

COUNTY Wood. DATE April 28, 1969S. R. #281 WEATHER Cloudy.SEC. Dixie East. TEMP. +70°DESCRIPTION Ties to Control Points JOB NO. _____

LEFT

CENTER LINE

RIGHT

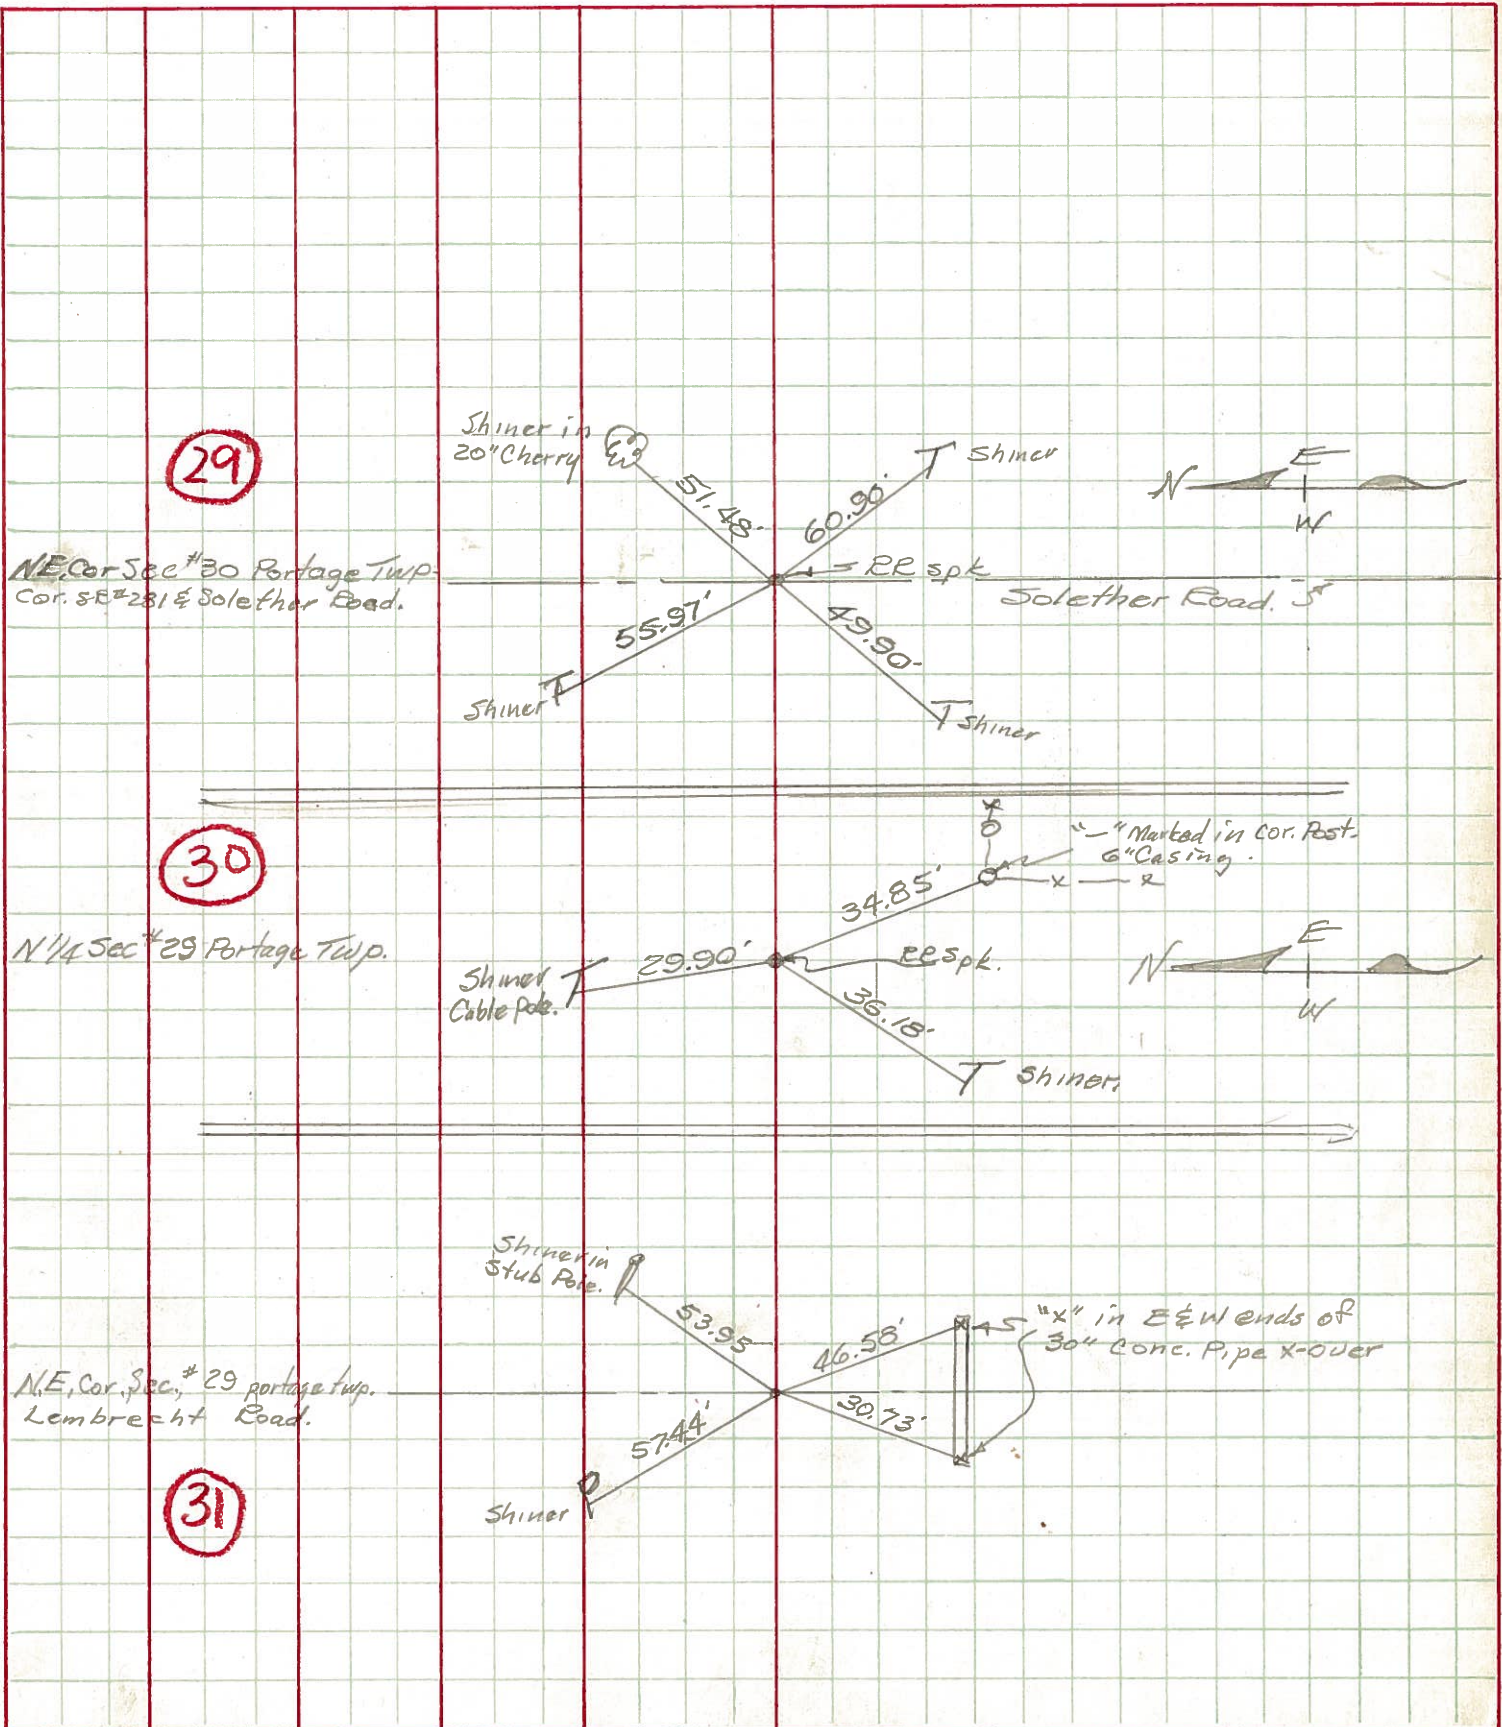

PERSONNEL TITLE PERSONNEL TITLE

COUNTY Wood

DATE OK 12-5-57

3-29-60

S. R. #281

WEATHER

SWOODEN

8-24-62

SEC. H, I, B & A

TEMP.

MORRISON

10-31-62

DESCRIPTION

LEFT

CENTER LINE

RIGHT

JOB NO.

Silver 2-28-64

Resurfaced 10-62

No. 167

S.E. cor. sec. 19 Portage

S.E. #281 & so leather Ed.

~~R.R. spike - Iron Pin Rd~~ OK

Set. R.R. Spk. 11-1-62

(29)

#168

Shiner 12" cherry

N.E.

43
51.55

Power Pole

S.W.

43.56

Conc. mon.

S.E. 51.32' 51.28

U.S.G.S. mon.

N.E.

42.62

Face iron Cor. post

N.E. 46.62 46.69

Shiner in T. Pole

E.S.E.

60.91

Shiner in T. Pole

S.S.W.

43.53

Sta. 78+86.0

S. 1/4 post sec. 20 Portage

Twp. Stone - R.R. Spk. set 11/1/62

 $\Delta = 0^\circ - 22\frac{1}{2}' \text{ Pt.}$

(30)

#169

Shiner in T.P.

S.W.

36.10'

Cable pole

N.W.

29.43

X in 6" steel cor. post S.E. 34.82' 34.86

Shiner in P.P.

N.E.

30.56

Face of 6" steel Br. post S.E. 38.12

E.S.E. 38.04

Sta. 104+85.9

S.W. cor. sec. 21 Portage OK

twp. set E.R. spk. over stone 11-1-62

 $\Delta = 10^\circ - 20' \text{ Pt.}$

Fd. large

Lembrecht Rd Iron Pin 4" below Part.

P. Pole

N.W.

36.42

Br. Pole

N.E. 47.75' 47.70

S.W. cor. S.W. Hdw. S.W. P. 32.15

S.E. cor. S.E. Hdw. S.E. 31.60

Shiner in P.P. S.W. 42.15' 42.20

(31)

#170