

O.D.O.T. DISTRICT 2 SURVEY OFFICE (USE ONLY)

PERSONNEL

REFERENCE NO. 30

SHEET OF

NOTES ASTON

DATE 7/18/24

ROUTE SR 281

H.C. NIESE

WEATHER SUNNY

COUNTY WOOD

R.C. PRESTON-COLVIN

TEMP. 77°

TOWNSHIP MONTGOMERY

DWG BY BARRIERE

PID 113719

SECTION 20

T 4 N R 12 E

TYPE MONUMENT MONBOW W/ 1" IPIN

ON SURFACE - BELOW ON

OFFSET Q PAVEMENT 0.5' LT LT : RT


 TO EDGE PAVEMENT

STATION: 1029+41


HORZ.DATUM: NAD83(2011)/WOOD LDP GEOID: 18

GRID: NORTHING: 590307.926 EASTING: 1691280.373

LDP: NORTHING: 412663.122 EASTING: 202881.012

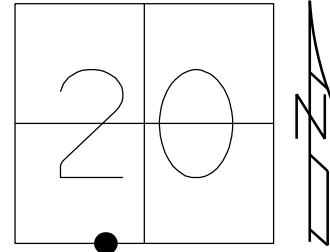

RECORD:
 $\Delta = 01^{\circ}05' \text{ RT}$
 FD SM.R.R.SPIKE
 7/14/87, MDB
 SET SM.R.R.SPIKE
 8/25/87, MDB
 FD SM.R.R.SPIKE
 3/16/06, RGN
 8/18/09, MC
 SET MAG/WASHER
 11/10/09, MC
 FD MAG SHANK
 9/10/21, DSA
 FD SHANK
 NEWREF30
 7/18/24, TDN
 FD MONBOW
 W/ 1" IPIN
 SET PER
 PID 113719 PLANS
 NEWREF30
 10/31/24, TDN

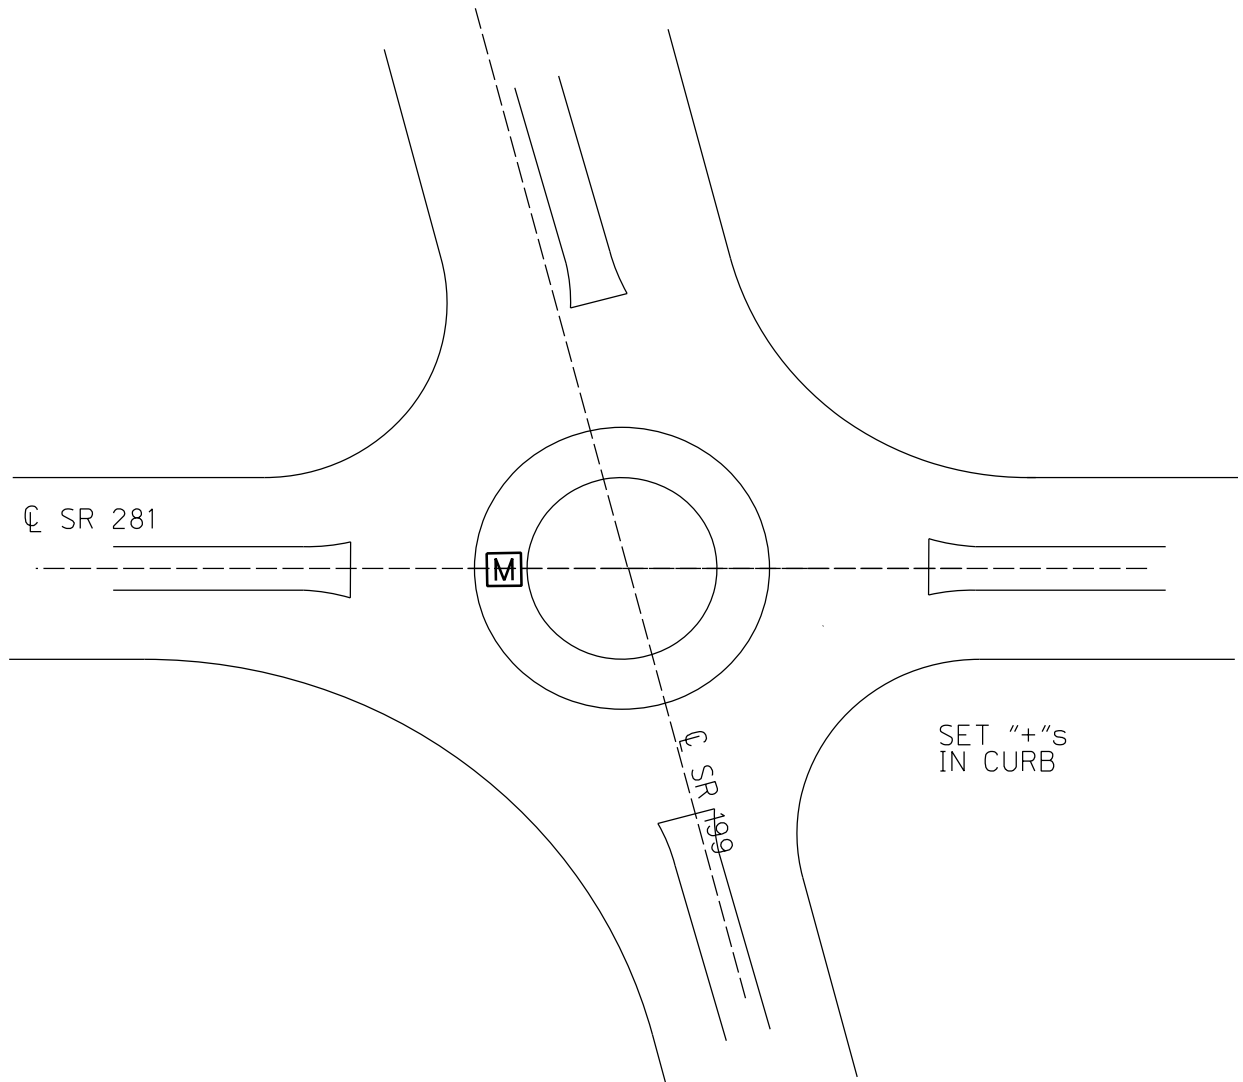

O.D.O.T. DISTRICT 2 SURVEY OFFICE (USE ONLY)

PERSONNEL

REFERENCE NO. 42 A

SHEET 1 OF 49

NOTES BARNHISEL

DATE 7/14/87

ROUTE SR 281

H.C. LOEHRKE

WEATHER SUNNY

COUNTY WOOD

R.C. HOFFMAN

TEMP. 75°

TOWNSHIP MONTGOMERY

SECTION 20

DWG BY NIESE

PID --

T 4 N R 12 E

TYPE MONUMENT SM R.R. SPIKE

ON SURFACE - ~~BELOW~~ ON

OFFSET Q PAVEMENT 1.0' LT : RT

- TO - EDGE PAVEMENT



STATION: 1029+41

HORIZ.DATUM: NAD83(2011)

GEOID: 2012A

GRID: NORTHING: 590308.039

EASTING: 1691280.344

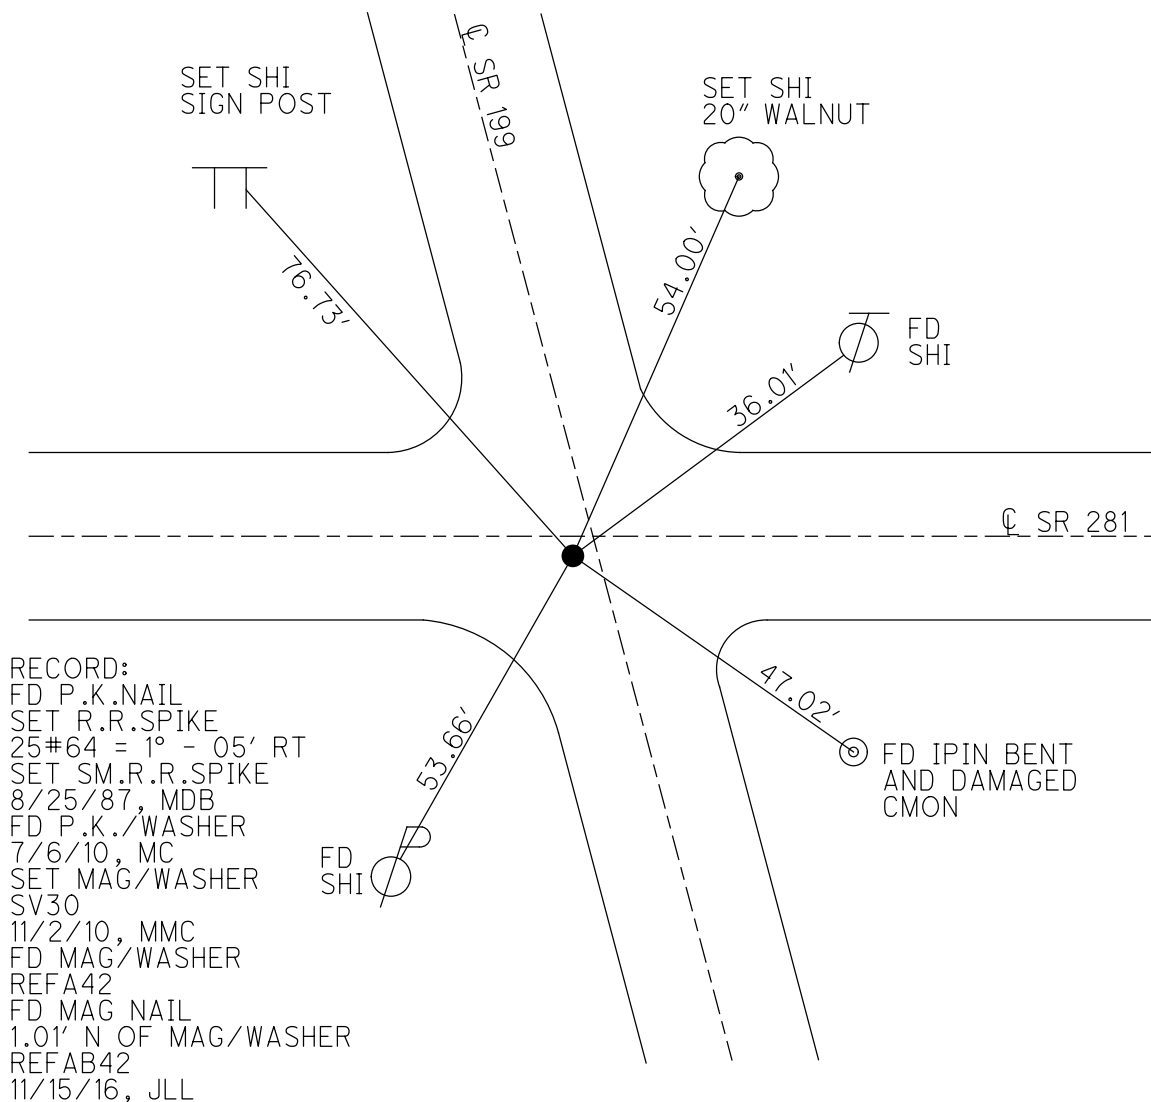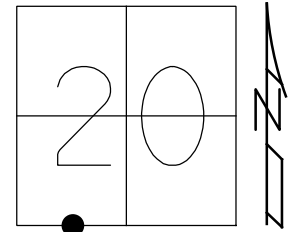

O.D.O.T. DISTRICT 2 SURVEY OFFICE (USE ONLY)

PERSONNEL

REFERENCE NO. 42 A

SHEET 1 OF 49

NOTES BARNHISEL

DATE 7/14/87

ROUTE SR 281

H.C. LOEHRKE

WEATHER SUNNY

COUNTY WOOD

R.C. HOFFMAN

TEMP. 75°

TOWNSHIP MONTGOMERY

SECTION 20

T 4 N R 12 E

TYPE MONUMENT SM.R.R.SPIKE

ON SURFACE - ~~BELOW~~ ON

~~LEFT~~ - Q PAV'T - RIGHT 1.0'

- TO - EDGE PAVEMENT

S.L.M. 1029+41

Grid: Northing: 590308.164 Easting: 1691280.294

