

O.D.O.T. DISTRICT 2 SURVEY OFFICE (USE ONLY)

PERSONNEL

REFERENCE NO. 44

SHEET 3 OF 51

NOTES MILLER

DATE 6/14/23

ROUTE SR 281

H.C. AUBLE

WEATHER BREEZY

COUNTY WOOD

R.C. NIESE

TEMP. 57°

TOWNSHIP MONTGOMERY

BEJARANO

SECTION 29

DWG BY RHOADES

PID CHIP SEAL

T 4 N R 12 E

TYPE MONUMENT MAG/WASHER

ON SURFACE - ~~BELOW~~ ON

OFFSET Q PAVEMENT ON LT : RT

- TO - EDGE PAVEMENT


STATION: 1048+18

HORZ.DATUM: WOOD LDP

GEOID: NADV88 2018


LDP: NORTHING: 412669.995

EASTING: 204686.730

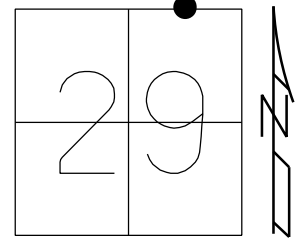

RECORD:  
1013.83' EAST  
OF NORTH POST  
SEC.29  
SET P.K./WASHER  
3/3/92, MB  
FD P.K./WASHER  
SV 44  
11/2/10  
SET MAG/WASHER  
7/24/12, MC  
REF 44  
7/30/12  
FD MAG/WASHER  
REF44  
8/5/16, JFO  
FD MAG/WASHER  
REF44  
6/14/23, DSA  
10/20/23, DSA  
10/31/24, TDN

WOOD LPD:  
N: 412669.990  
E: 204686.736

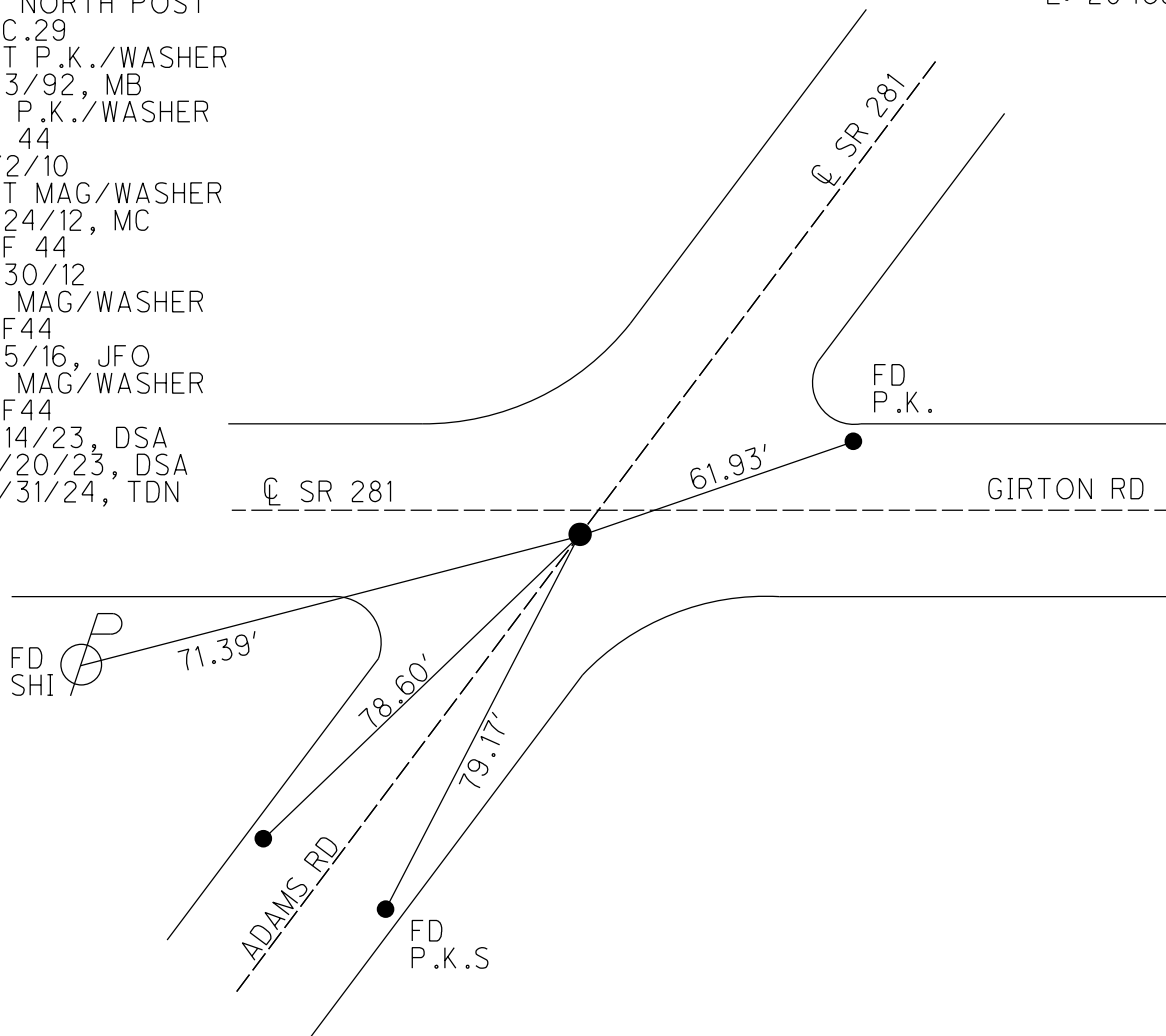

O.D.O.T. DISTRICT 2 SURVEY OFFICE (USE ONLY)

PERSONNEL

REFERENCE NO. 44

SHEET 3 OF 51

NOTES MILLER

DATE 6/14/23

ROUTE SR 281

H.C. AUBLE

WEATHER BREEZY

COUNTY WOOD

R.C. NIESE

TEMP. 57°

TOWNSHIP MONTGOMERY

BEJARANO

SECTION 29

DWG BY RHOADES

PID CHIP SEAL

T 4 N R 12 E

TYPE MONUMENT MAG/WASHER

ON SURFACE - ~~BELOW~~ ON

OFFSET Q PAVEMENT ON LT : RT

- TO - EDGE PAVEMENT


STATION: 1048+18

HORZ.DATUM: NAD83 2011

GEOID: NADV88 2018


GRID: NORTHING: 590290.974

EASTING: 1693085.885

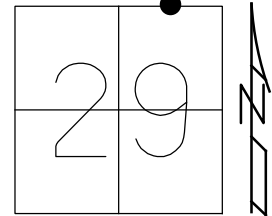

RECORD:  
1013.83' EAST  
OF NORTH POST  
SEC.29  
SET P.K./WASHER  
3/3/92, MB  
FD P.K./WASHER  
SV 44  
11/2/10  
SET MAG/WASHER  
7/24/12, MC  
REF 44  
7/30/12  
FD MAG/WASHER  
REF44  
8/5/16, JFO  
FD MAG/WASHER  
REF44  
6/14/23, DSA  
10/20/23, DSA


WOOD LPD:  
N: 412669.990  
E: 204686.736

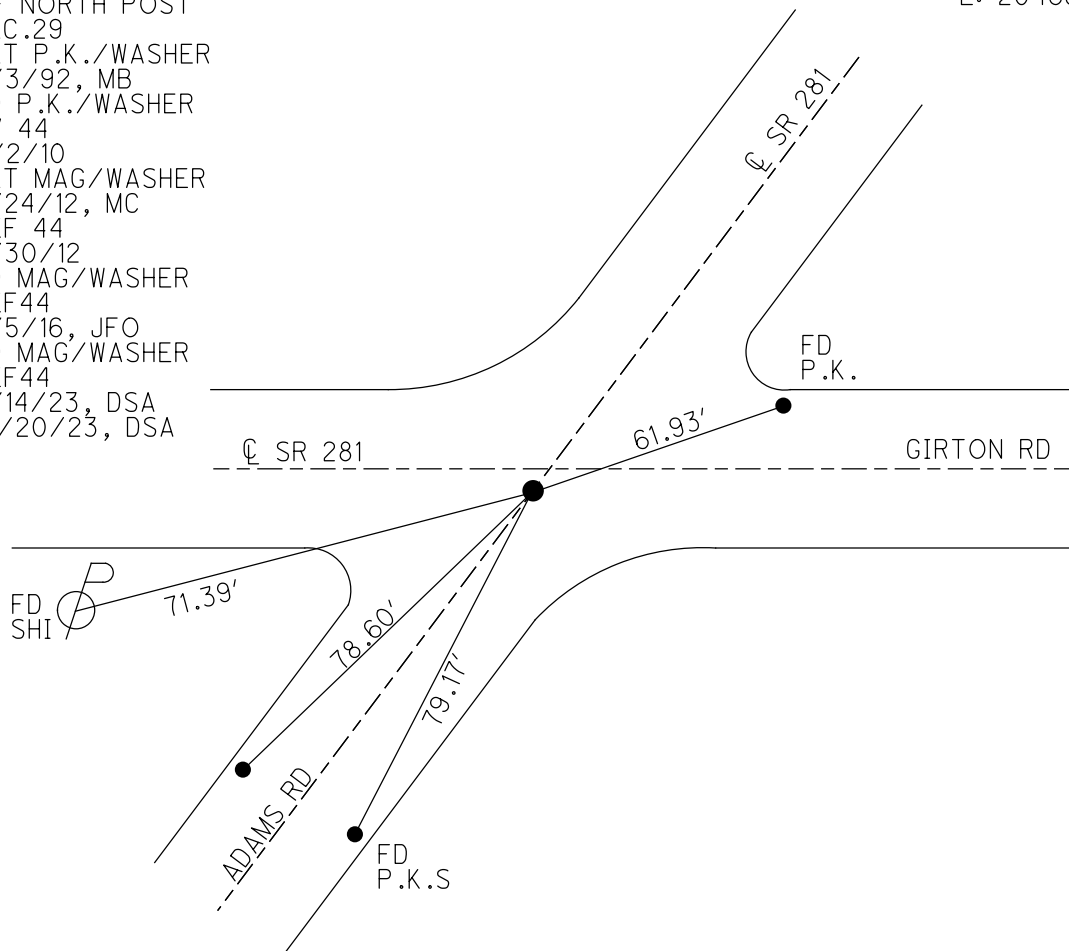

# O.D.O.T. DISTRICT 2 SURVEY OFFICE (USE ONLY)

|                  |                         |                             |
|------------------|-------------------------|-----------------------------|
| PERSONNEL        | REFERENCE NO. <u>44</u> | SHEET <u>3</u> OF <u>49</u> |
| NOTES            | DATE <u>3/19/12</u>     | ROUTE <u>SR 281</u>         |
| H.C. <u>HUSS</u> | WEATHER <u>CLEAR</u>    | COUNTY <u>WOOD</u>          |
| R.C. <u>HUSS</u> | TEMP. <u>65°</u>        | TOWNSHIP <u>MONTGOMERY</u>  |
|                  |                         | SECTION <u>29</u>           |
|                  |                         | T <u>4</u> N R <u>12</u> E  |

TYPE MONUMENT P.K./WASHER  
~~ON SURFACE~~ - BELOW 0.15'  
 LEFT - Q PAV'T - RIGHT ON, 3.2' S. OF Q W.  
- TO - EDGE PAVEMENT  
 S.L.M. 1048+18  
 GRID: NORTHING: 590290.739 EASTING: 1693085.930

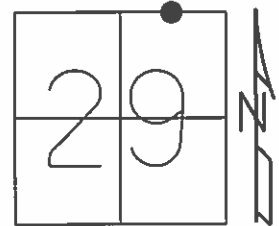


RECORD: 1013.83' EAST  
OF NORTH POST,  
SEC.29

SET PK/WASHER  
3/3/92, MB

SV 44, 11/2/10  
SET MAG/WASHER 7/24/12

FINAL GPS, REF 44  
7/30/12

FD MAG/WASHER  
REF44  
8/5/16, JFO

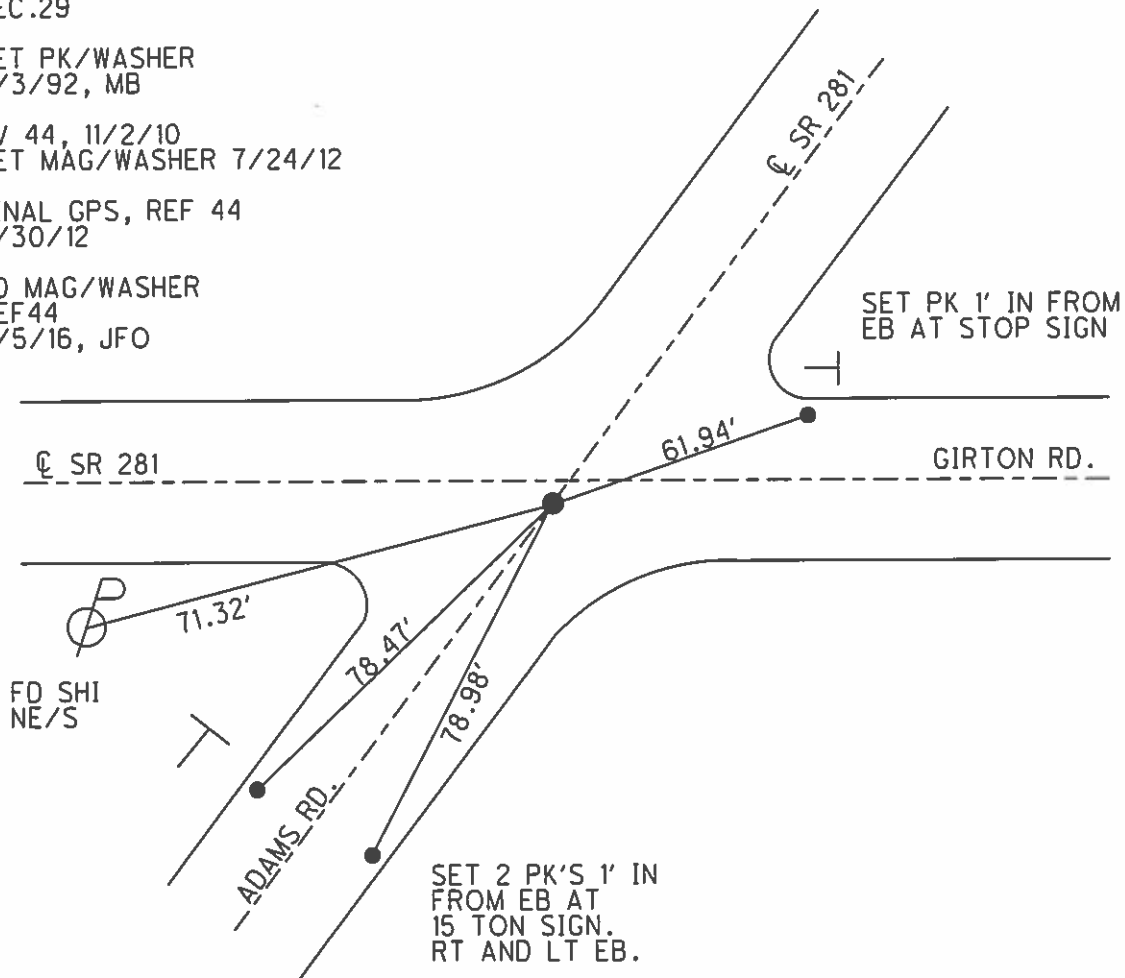

# O.D.O.T. DISTRICT 2 SURVEY OFFICE

PERSONNEL

REFERENCE NO. 44

SHEET 2 OF       

NOTES LOEHRKE

H.C. BAENHISEC

R.C. KUSZ

VAN DUSEN

DATE 7-18-91

WEATHER clear

TEMP. +80°

ROUTE 281

COUNTY WOOD

TOWNSHIP MONTGOMERY

SECTION 29

T 4 N R 12 E


TYPE MONUMENT P.K. & Washer

ON SURFACE - BELOW yes

LEFT - & PAV'T. - RIGHT yes

- TO - EDGE PAVEMENT 3.2 S. OF & Pav't 281 West

S.L.M. 1048+18

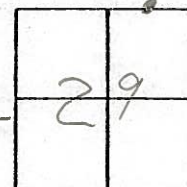

Set P.K. & Washer  
3-3-92  
mib

Record:  
10 13.83' EAST OF  
North 1/4 Post, Sec. 29

S.R. 281

PAVT 281

Set Shi on E of Pav't GIBTON RD

GIBTON Rd

FD Shi N.E.  
SIDE

NEAR Edge of ROAD Sign  
2.0' up

Set Shi on  
E Pav't of Adams Rd

ADAMS Rd

71.23

57.25

58.94

26.96

# Q.D.O.T. DISTRICT 2 SURVEY OFFICE

SHEET \_\_\_\_\_ OF \_\_\_\_\_

County Wood S.R. 281

Township MONTGOMERY

Section 29

T4N, R2E

Personnel HOFFMAN

LOEHKE


BARNHISEL

#44

Date 12-12-83

Weather OVERCAST

Temp. +40°

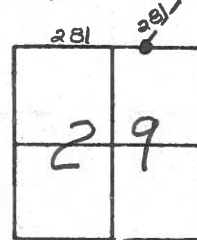

Fd. P.R. SPK @ SURFACE  
ON & PAUT 281 N.E.  
3.2' S. of & Paut 281 West.

S.L.M. 1048+17


RECORD:

1013.83' E. of N 1/4  
Post of Sec. 29

Set P.K./Washer

8-15-84

S.W.H.

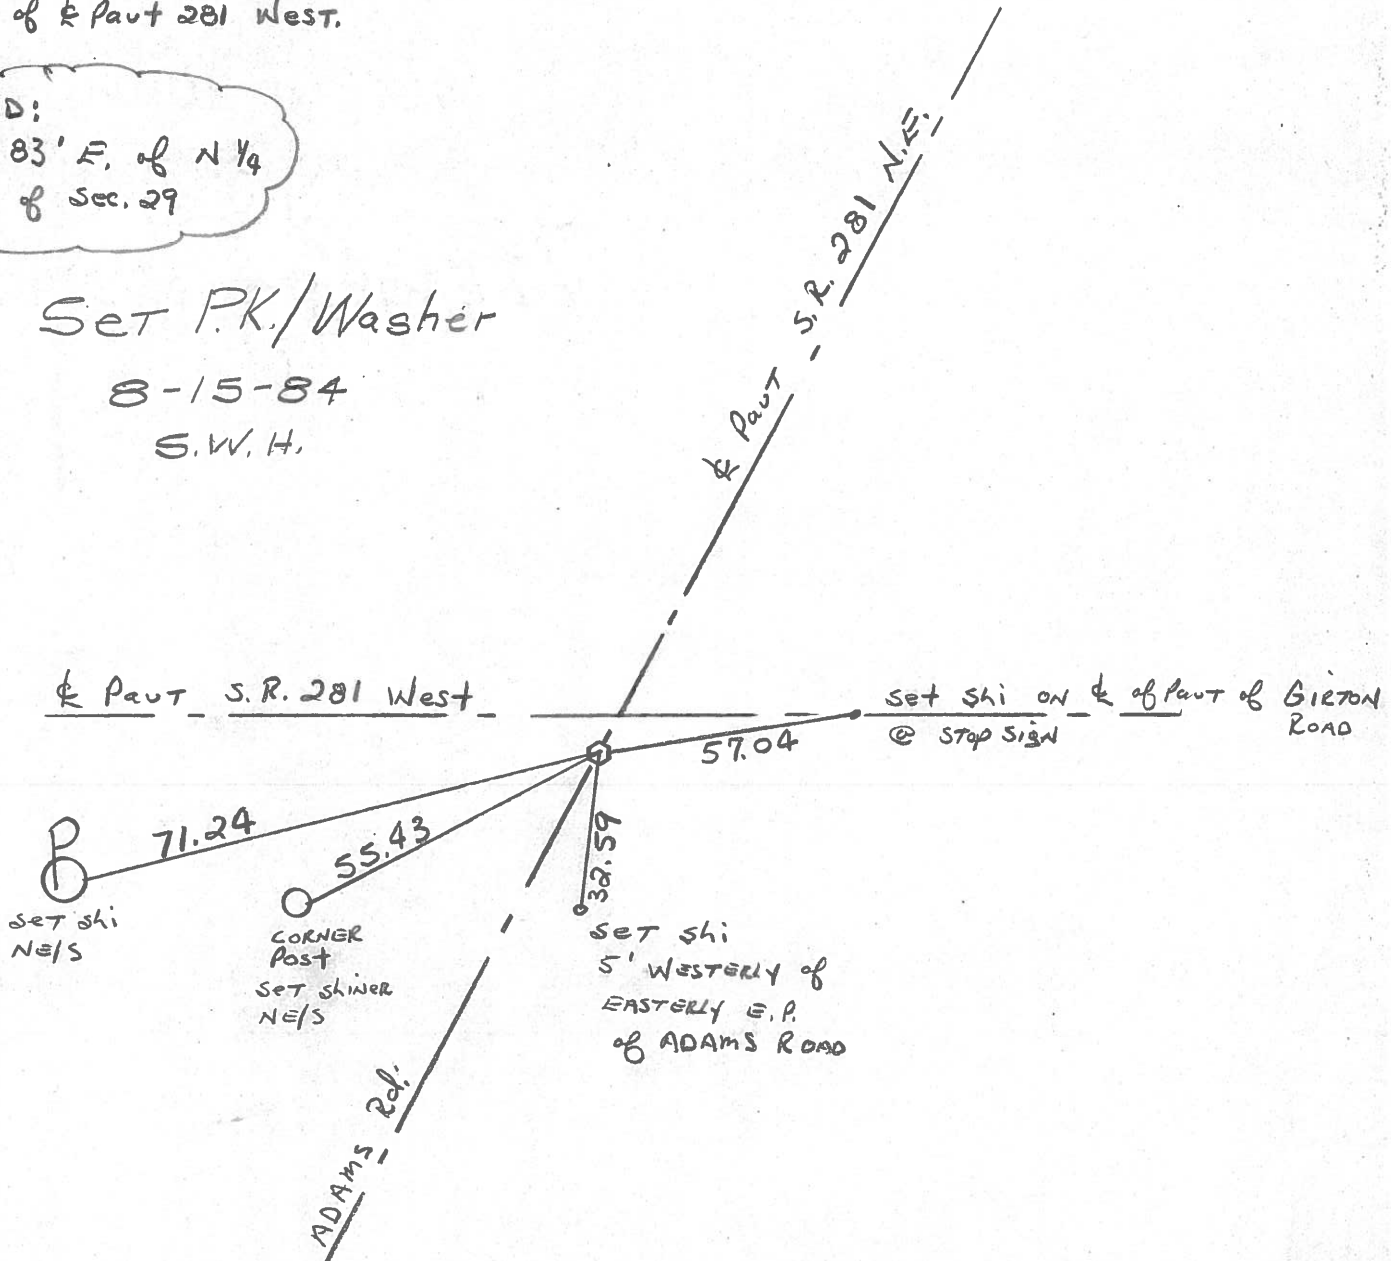

RE Copied  
1-26-71

SHEET NO. 22

| PERSONNEL | TITLE | PERSONNEL | TITLE | COUNTY       | DATE       | WEATHER | TEMP. |
|-----------|-------|-----------|-------|--------------|------------|---------|-------|
| CK. BY    |       |           |       | WOOD         | OK-8-11-69 |         |       |
| SILVESTER |       |           |       | S. R. #281   |            |         |       |
|           |       |           |       | SEC. 29 & 20 |            |         |       |

| DESCRIPTION | LEFT | CENTER LINE | RIGHT | JOB NO. |
|-------------|------|-------------|-------|---------|
|-------------|------|-------------|-------|---------|

Approx. .35' N.E. From  
ANGLE COR. SEC. 20  
T-4-N R-12-E  
FD. I. PIPE - SET R.R. SPK.

Lt up  
7.7


Rt up  
12.5  
#184

2.5 Lt ok

12" maple  
SE/S  
set shi

4104

Fd shi  
set  
5777

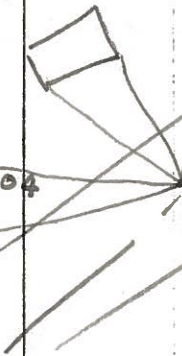

ZELEXAK Farm  
N.E. COR. Ho. FON. N.W. 76.55  
S.E. COR. Ho. FON. N.W. 72.22  
SHINER IN P. POLE S.W. 57.73  
SHINER IN POLE N.E. 30.28  
SHINER IN 12" MAPLE N. 76.15

1066 + 48

set shi 45

47.54

1013.83' E. OF N. 1/4  
POST SEC. 29  
T-4-N R-12-E  
R.R. SPK. Fd @ surface

#44

ONE 281 NE  
3.2 S 281 west  
183

038405  
10413  
948 + 10

SHINER 2<sup>ND</sup> post S. OF COR POST  
S.W. 78.33  
SHINER 3<sup>RD</sup> post S. OF COR. POST  
S.E. 48.16'  
SHINER IN T. POLE N.W. 46.80  
SHINER IN T. POLE N.E. 66.00  
SHINER IN T. POLE S.E. 39.90'

1048 + 17

even / stop sign

on k post 57.04

71.24

55.43

B

111 d shi



RE COPIED  
1-26-71

SHEET NO. 22

PERSONNEL

TITLE

PERSONNEL

TITLE

COUNTY

WOOD

DATE

OK-8-11-69

S. R.

#281

WEATHER

SEC.

29 &amp; 20

TEMP.

DESCRIPTION

LEFT

CENTER LINE

RIGHT

JOB NO.

Approx. .35' N.E. From  
ANGLE COR. SEC. 20  
T-4-N R-12-E  
FD. I. PIPE - SET R.R. SPK.

#45

N.E. COR. HO. FON. N.W. 76.35'  
S.E. COR. HO. FON. N.W. 72.22'  
SHINER IN P. POLE S.W. 57.73'  
SHINER IN POLE N.E. 30.28'  
SHINER IN 12" MAPLE N. 76.15'

#184

1013.83' E. OF N. 1/4  
POST SEC. 29  
T-4-N R-12-E  
R.R. SPK.

#44

SHINER 2<sup>ND</sup> post S. OF COR POST  
S.W. 78.33'  
SHINER 3<sup>RD</sup> post S. OF COR. POST  
S.E. 48.16'  
SHINER IN T. POLE N.W. 46.80'  
SHINER IN T. POLE N.E. 66.00'  
SHINER IN T. POLE S.E. 39.90'

#183



PERSONNEL TITLE PERSONNEL TITLE

COUNTY Wood

DATE OK 12-5-57

Sworben 3-29-60

S. R. #281

WEATHER 8-24-62

Morrison 11-1-62

SEC.

TEMP Sworben 2-10-64

DESCRIPTION

LEFT

CENTER LINE

RIGHT

JOB NO.

N.W. cor. Sec. 29 Montgomery  
Twp. Stone - R.R. spike set.  
Bridge View Road.

OK ✓

Shiner in T.P. N. 28.95' 183.2  
~~Shiner in Br. P. S.E.~~ 38.6  
Shiner in P.P. S.W. 47.58' 41.9  
Shiner in T.P. S.E. 71.16

(42)

#181

N.W. post sec. 29 Montgomery  
Twp. Found iron pin - set small  
for corner. R.R. spike.

OK ✓

Shiner in P.P. S.E. 55.9  
Shiner in T.P. N.W. 30.58' 30.8  
~~Shiner in 24" stump S. Gone~~ 40.2  
~~Shiner in 40" oak S.~~ 40.2  
" " old stump. S. 41.22

(43)

#182

Approximately .35 N.E.  
from Angle cor. sec. 20  
T-4-N R-12-E. iron pipe. Fd.  
Set R.R. spike.

OK ✓

N.E. cor. house And. N.W. 76.3  
S.E. cor. house fdn. N.W. 72.2  
~~N.E. to shiner in butternut tree~~  
(gone) 28.6  
S.W. To shiner in P. Pole 57.7  
N.E. To shiner in P. Pole 30.3  
Shiner in 12" maple N. 76.35

(45)

#184

1013.83 E. of N.W. post  
sec. 29 T-4-N R-12-E  
Set R.R. spike Fd.

OK ✓

Shiner in fence post S.E. 28.  
Shiner in 2nd post S. of cor. 78.3  
Past S.W. 78.3  
Shiner in 3rd post S. of cor. post  
S.E. 48.16' 18.6

(44)

#183

Shiner in T.P. N.W. 46.77' 46.7  
Shiner in T.P. N.E. 65.70' 65.7  
Shiner in T.P. S.E. 39.9