

O.D.O.T. DISTRICT 2 SURVEY OFFICE (USE ONLY)

PERSONNEL

REFERENCE NO. 7

SHEET 7 OF 25

NOTES MILLER
H.C. MILLER
R.C. BARRIERE
BLUBAUGH

DATE 8/6/24
WEATHER CLOUDY
TEMP. 75°

ROUTE SR 582
COUNTY WOOD
TOWNSHIP MIDDLETON
SECTION 21

DWG BY BARRIERE PID 114849

T 6 N R 10 E

TYPE MONUMENT MAG WASHER

ON SURFACE - BELOW 0.5" BELOW

OFFSET $\varnothing$ PAVEMENT 3.1' ~~LT~~ : RT

TO EDGE PAVEMENT

STATION: 96+00

HORIZ.DATUM: NAD83 (2011)


GEOID: 18

GRID: NORTHING: 655481.119


EASTING: 1634468.795

LDP: NORTHING: 477086.080

EASTING: 145210.706

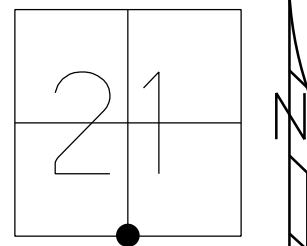

FD SM RR SPIKE
4/20/04, M.B.
RESET MAG/WASHER
8/2/04, MC
FND, 3/14/14
FD MAG/W
GPS, RE7
4/8/14, TMR
SET MAG/W
7/25/14, EBW
GPS, NEWREF7
7/29/14, JMR
FD MAG/WASHER
REF7
12/7/23, JAM
FD TONE, DID NOT UNCOVER
8/6/24, JAM

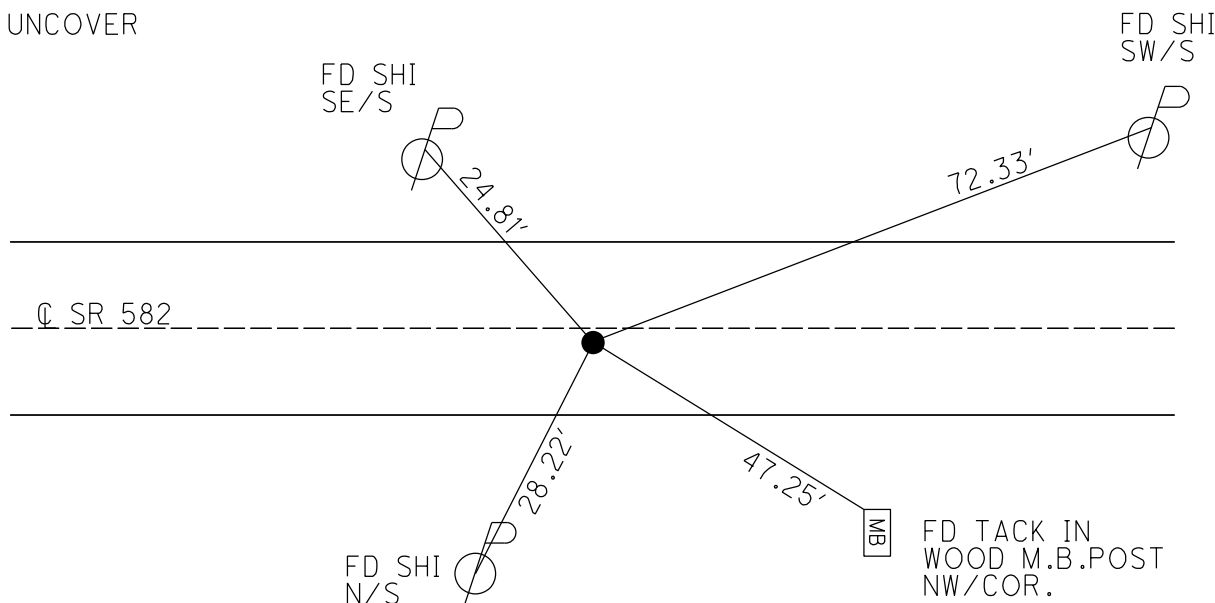


O.D.O.T. DISTRICT 2 SURVEY OFFICE (USE ONLY)

PERSONNEL	REFERENCE NO. <u>7</u>	SHEET <u>7</u> OF <u>25</u>
NOTES	DATE <u>4/8/14</u>	ROUTE <u>SR 582</u>
H.C. <u>RHOADES</u>	WEATHER <u>FAIR</u>	COUNTY <u>WOOD</u>
R.C. <u>ROUSOS</u>	TEMP. <u>53°</u>	TOWNSHIP <u>MIDDLETON</u>
<u>HOMAN</u>		SECTION <u>21</u>
<u>GABLE</u>		T <u>6</u> N R <u>10</u> E

TYPE MONUMENT MAG/W
 ON SURFACE - ~~BELOW~~ ON
~~LEFT~~ - Q PAV'T - RIGHT 2.5'
5.8' TO RT EDGE PAVEMENT
 S.L.M. 96+00

Grid: Northing: 655481.119 Easting: 1634468.795

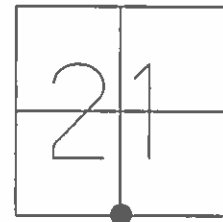

FD SM RR SPIKE
 4/20/04, M.B.


RESET MAG/WASHER
 8/2/04, MC

FND, 3/14/14

FD MAG/W
 GPS, RE7
 4/8/14, TMR

SET MAG/W
 7/25/14, EBW

GPS, NEWREF7
 7/29/14, JMR

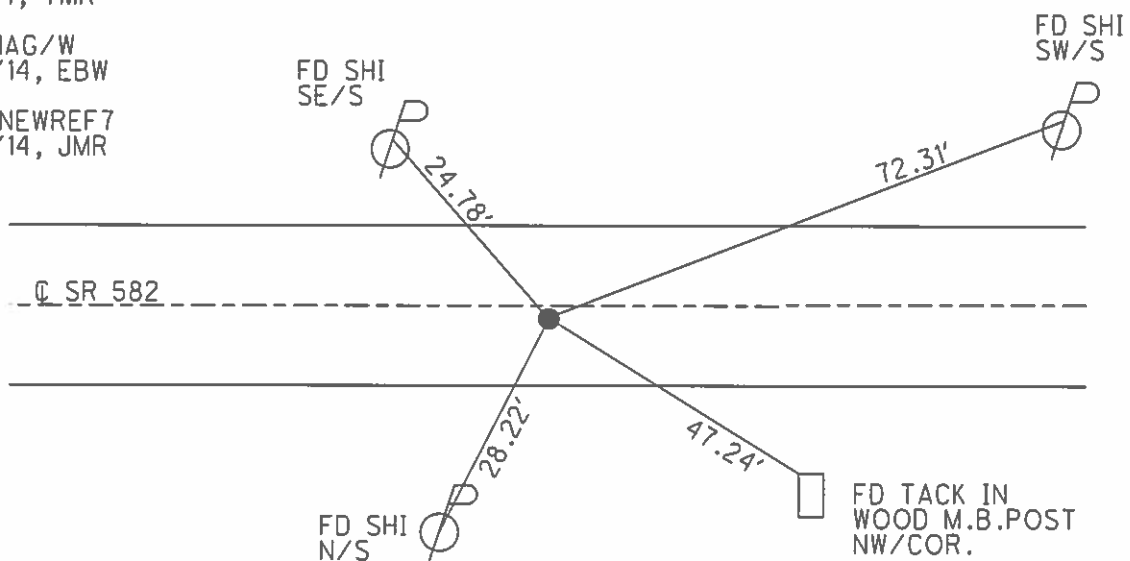

O.D.O.T. DISTRICT 2 SURVEY OFFICE

PERSONNEL _____

REFERENCE NO. 7

SHEET 5 OF 23

NOTES CANTERBURY RC

H.C. BARNHISEL (DRAWN)

R.C. _____

DATE 04/20/04

WEATHER Cloudy

TEMP. +48°

ROUTE S.R. 582

COUNTY Wood

TOWNSHIP MIDDLETON

SECTION 21

T. 6 N. R. 10 E.


TYPE MONUMENT Sm RR Spr

ON SURFACE - BELOW 2"


LEFT - CL PAW'T. - RIGHT 2.3'

S.8 TO RT EDGE PAVEMENT

S.L.M. 96+00

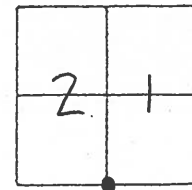

Reset May/Washer
08/02/04
MC

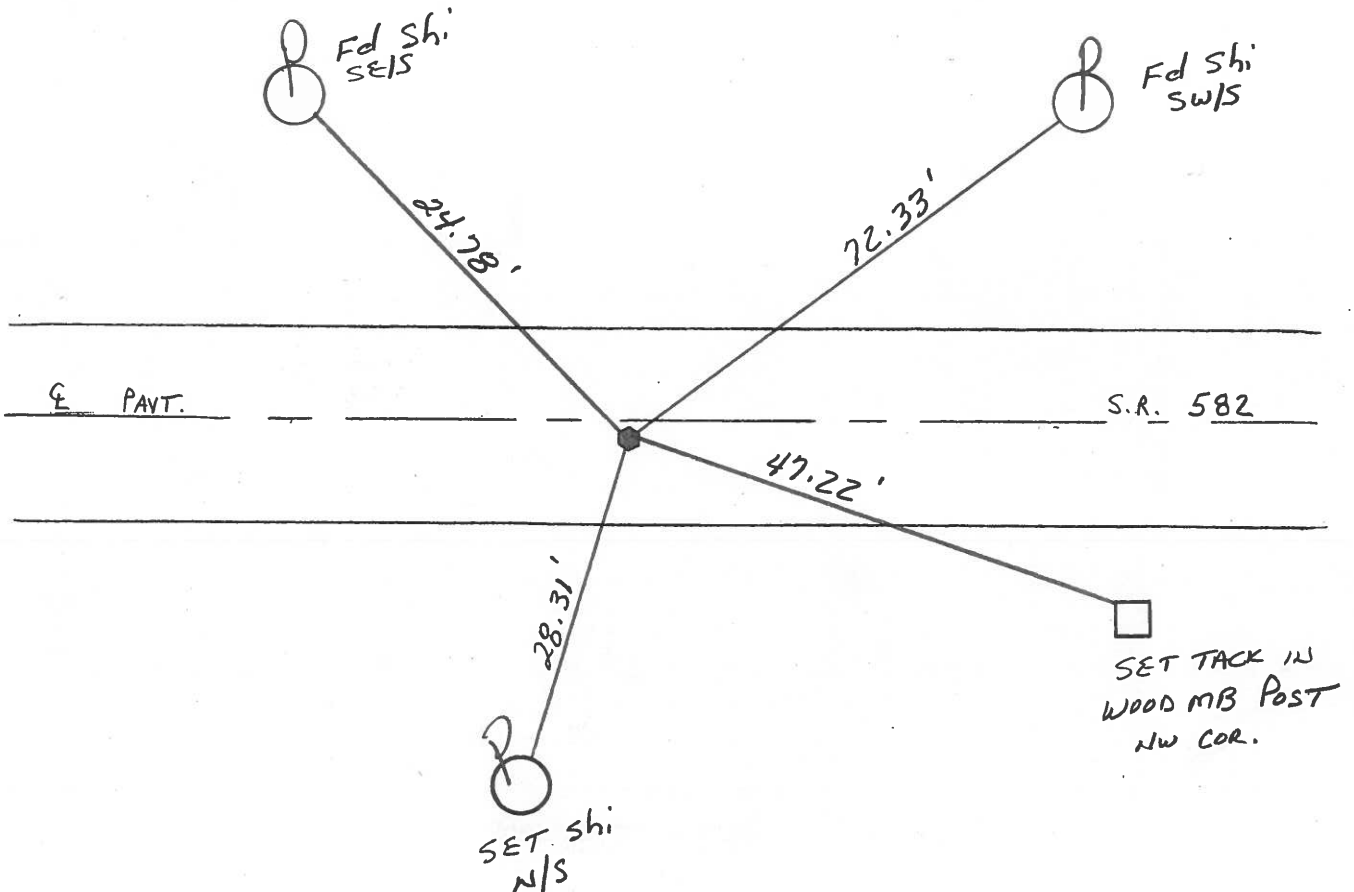

O.D.O.T. DISTRICT 2 SURVEY OFFICE

PERSONNEL

REFERENCE NO. 7

SHEET OF

NOTES BARNHISEL

H.C. HOFFMAN

R.C. Loehrke

GRAMER

DATE 3-27-86

WEATHER SUNNY

TEMP. +35°

ROUTE 582

COUNTY WOOD

TOWNSHIP MIDDLETON

SECTION 21

T 6 N R 10 E

TYPE MONUMENT Sm RR Spk



ON SURFACE - BELOW yes

LEFT - 0 PAV'T. - RIGHT 2.0

5.3 TO RT EDGE PAVEMENT


S.L.M. 96+00

Set P.K./washer
5-6-86 SWN

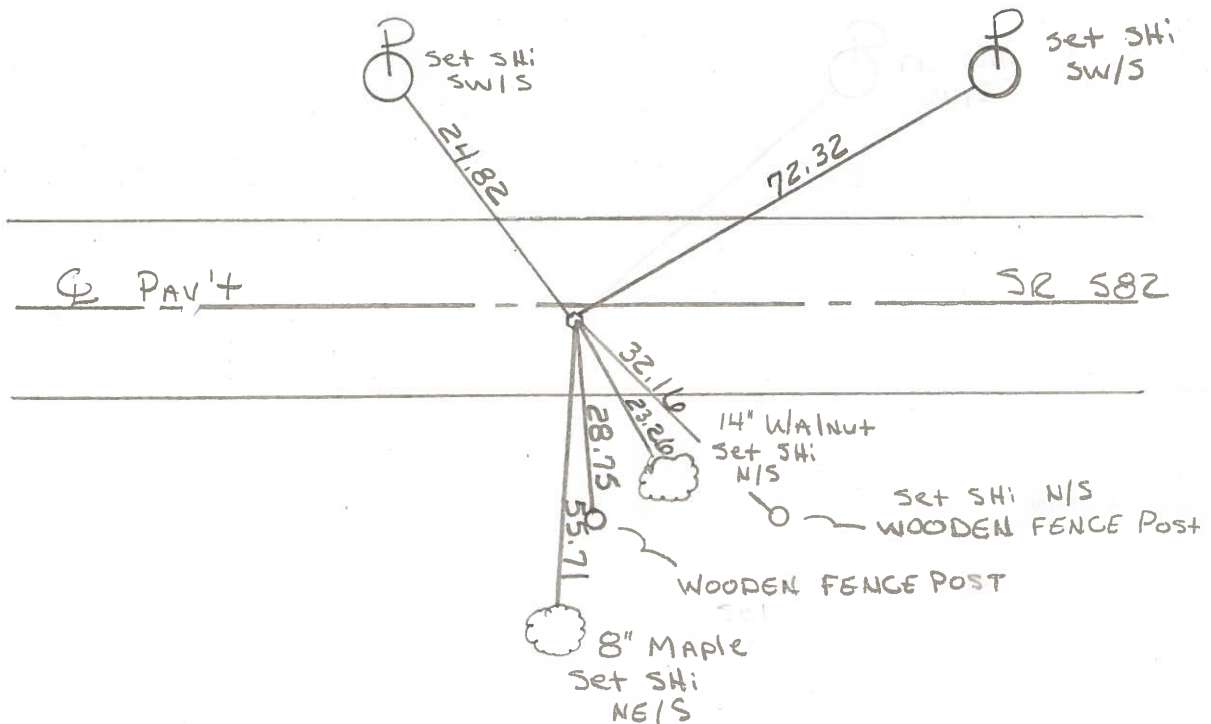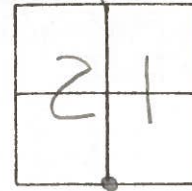


County Wood S.R. 582Date 5-11-1979Township WashingtonWeather Partly CloudySection N 1/4 Corner Sec. 28Temp. 84°

T6N, R10E

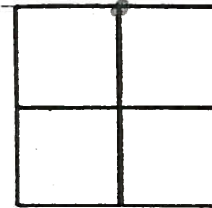
Personnel SmithKnappeMead

(7)

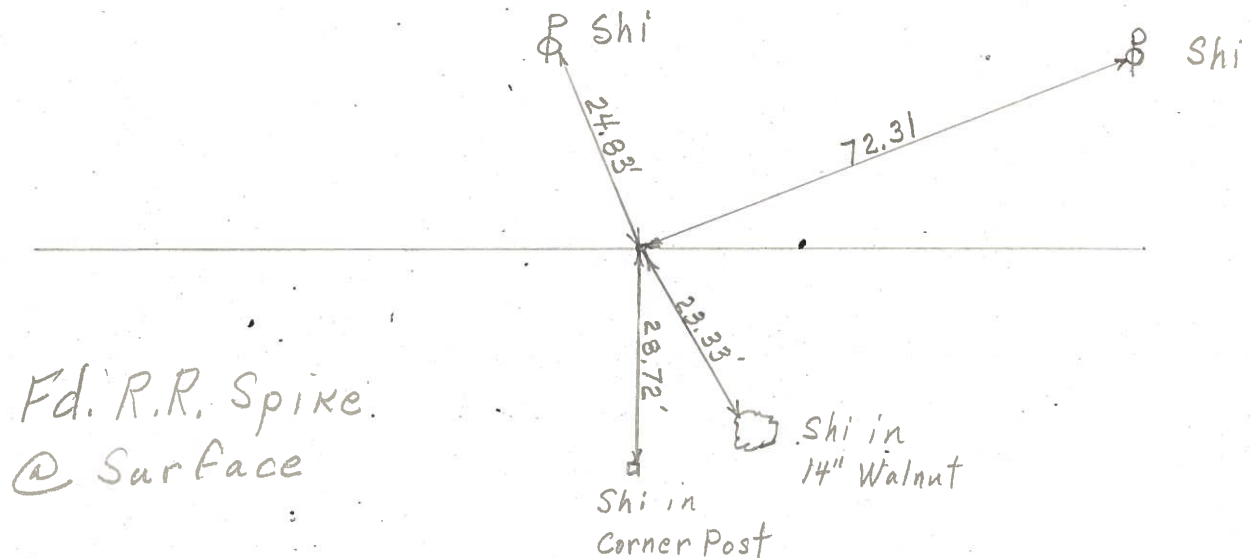

PERSONNEL	TITLE	PERSONNEL	TITLE	COUNTY	DATE	WEATHER	TEMP.
BURNSIDE				WOOD	5-25-71	CLOUDY	+60°
BOWERS				S. R. 582			
SMITH				SEC. 28			
HOLCOMBE							

DESCRIPTION	LEFT	CENTER LINE	RIGHT	JOB NO.
-------------	------	-------------	-------	---------

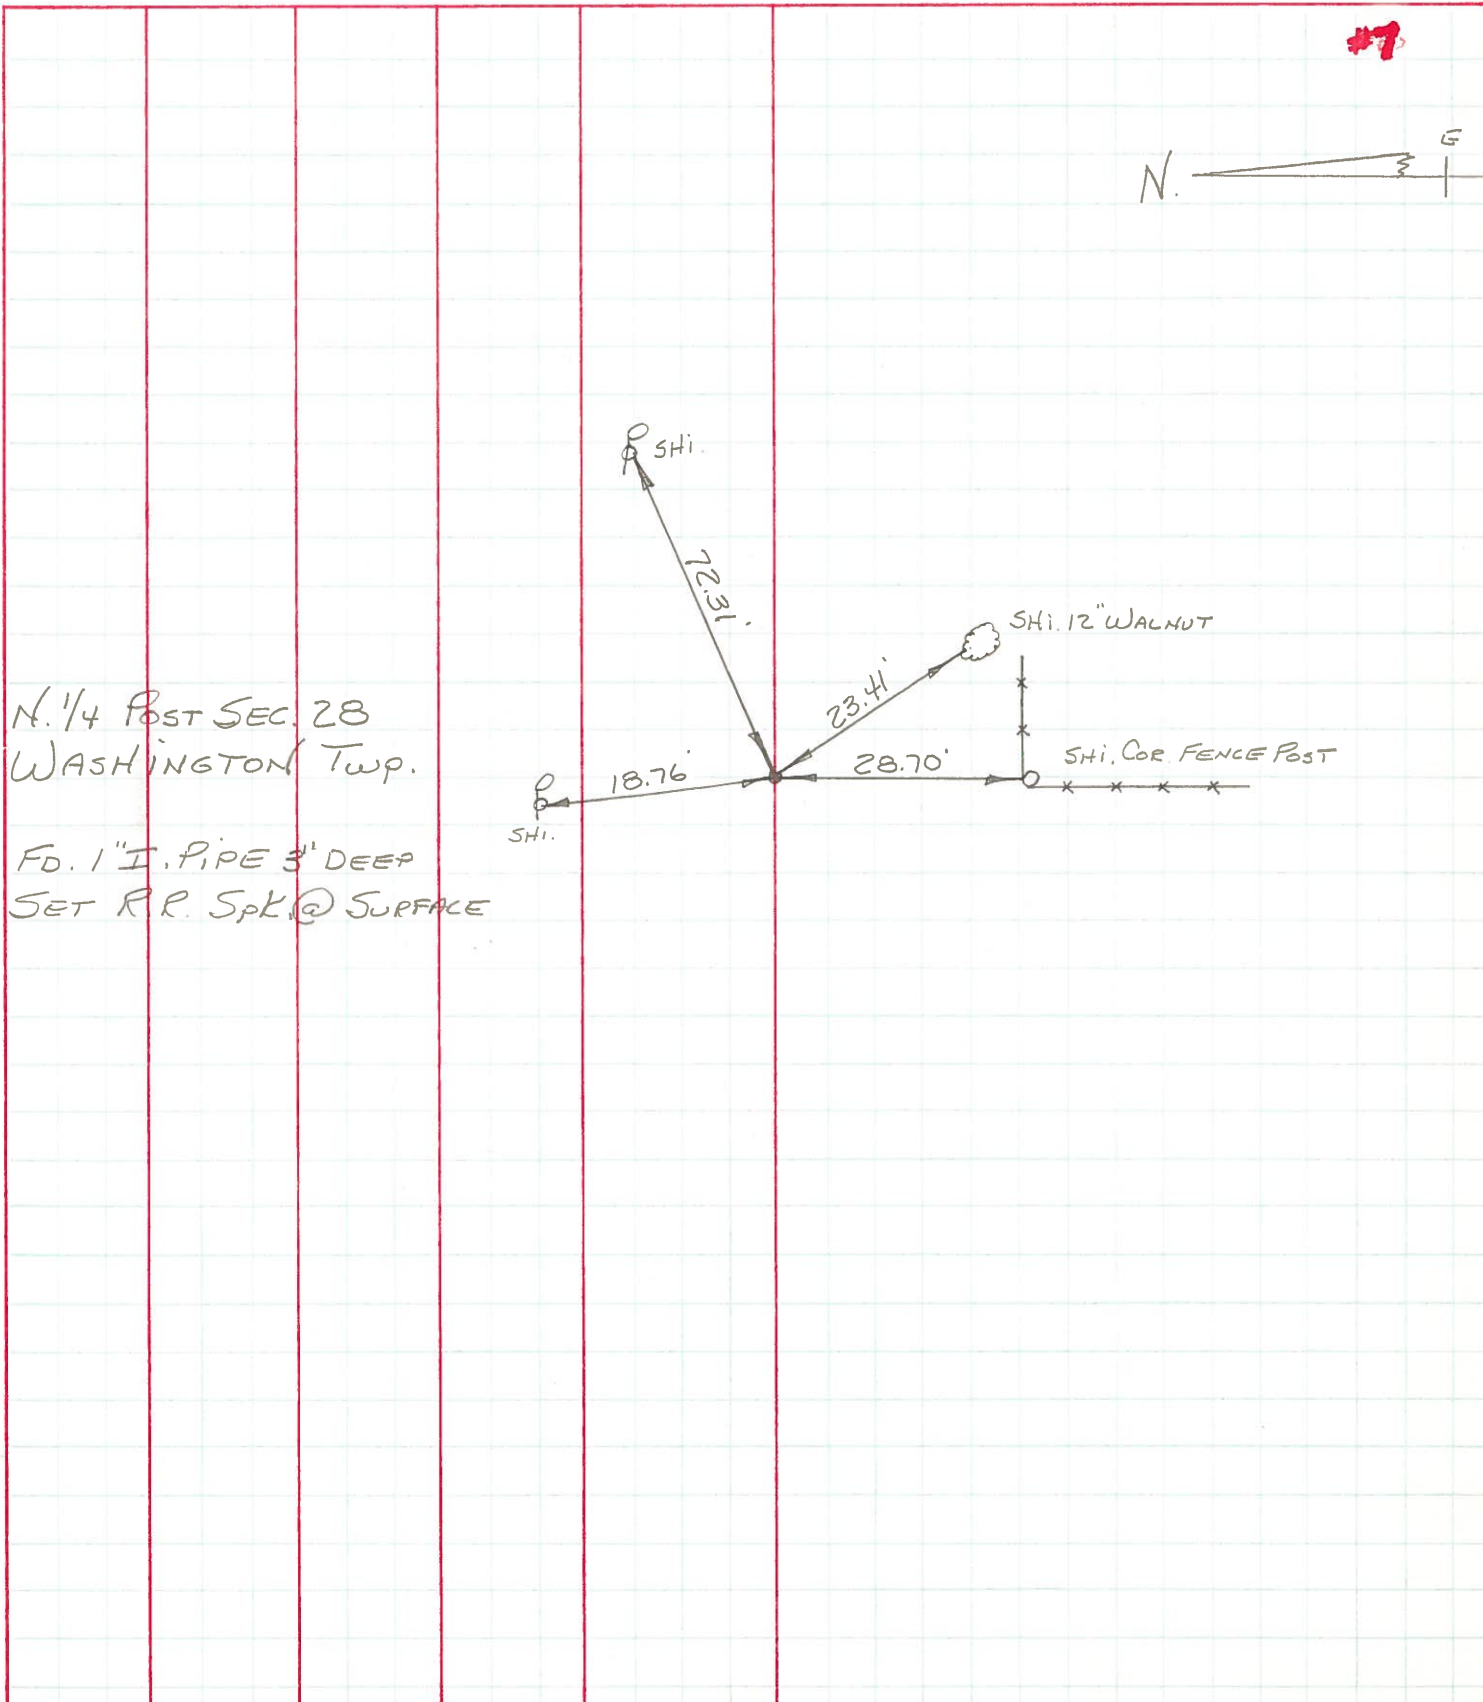

PERSONNEL	TITLE	PERSONNEL	TITLE	COUNTY	DATE
Schneider				Wood	6-12-67
Barbour				S. R. # 582	WEATHER Fair-Hot
Redding				SEC. 0.00-3.10	TEMP. 80°
Potts					

DESCRIPTION Ties for C. & O. 2 miles JOB NO. _____

