

O.D.O.T. DISTRICT 2 SURVEY OFFICE (USE ONLY)

PERSONNEL

REFERENCE NO. 9

SHEET 9 OF 25

NOTES MILLER
H.C. MILLER
R.C. BARRIERE
BLUBAUGH

DATE 8/6/24
WEATHER CLOUDY
TEMP. 75°

ROUTE SR 582
COUNTY WOOD
TOWNSHIP MIDDLETON
SECTION 21
T 6 N R 10 E

DWG BY BARRIERE PID 114849

TYPE MONUMENT MAG WASHER

ON SURFACE - BELOW ON

OFFSET $\angle$ PAVEMENT OF 582 EAST LT : RT
TO EDGE PAVEMENT

STATION: 123+33, 2.6' $\angle$ TO WEST, 7.4' W. OF $\angle$ NORTH

HORIZ.DATUM: NAD83 (2011)


GEOID: 18

GRID: NORTHING: 655408.881


EASTING: 1637200.454

LDP: NORTHING: 477049.791

EASTING: 147943.328

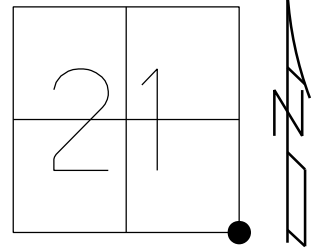

RECORD:
POINT NOT COVERED
8/2/04, MC
DNF, STAKE OUT
3/14/14
GPS, REF9
4/8/14, TMR
NOT COVERED
7/29/14, JMR
D.N.F. - TIES CROSSED FD SHI
12/7/23, TDN
SET MAG/WASH
REF9
12/8/23, JAM
FD MAG/WASH
8/6/24, JAM

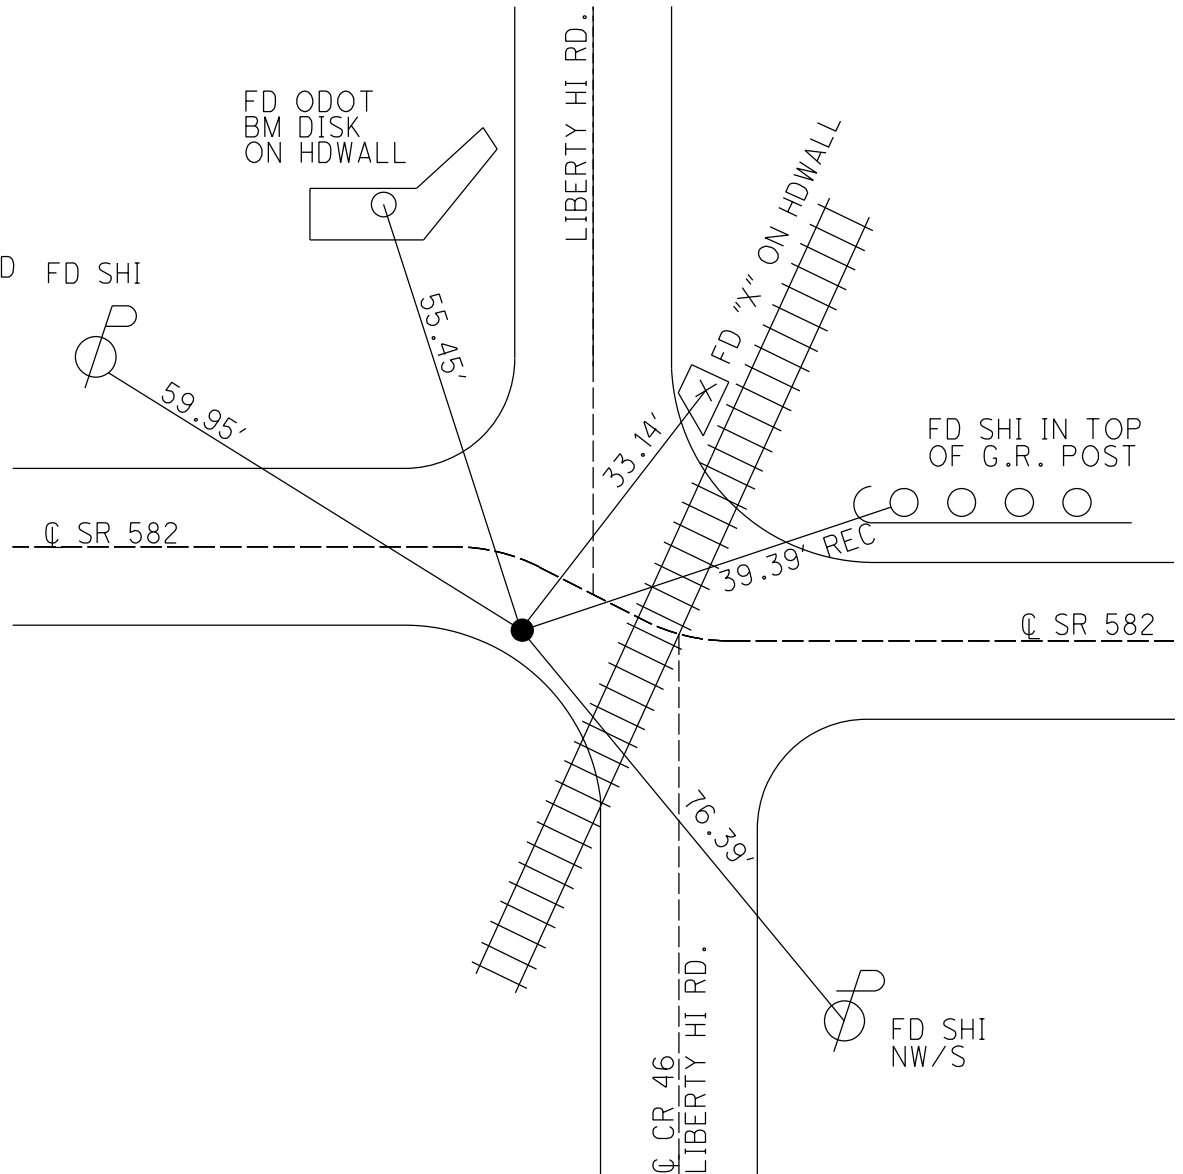

O.D.O.T. DISTRICT 2 SURVEY OFFICE (USE ONLY)

PERSONNEL

REFERENCE NO. 9 SHEET 9 OF 25

NOTES RHOADES
H.C. ROUSOS
R.C. GABLE
HOMAN

DATE 4/8/14
WEATHER FAIR
TEMP. 53°

ROUTE SR 582
COUNTY WOOD
TOWNSHIP MIDDLETON
SECTION 21
T 6 N R 10 E

TYPE MONUMENT SM.R.R.SPIKE



~~ON SURFACE~~ - BELOW 5"

LEFT - Q PAV'T - RIGHT OF 582 EAST

TO EDGE PAVEMENT

S.L.M. 123+33, 2.6' S. Q TO WEST, 7.4' W. OF Q NORTH

Grid: Northing: 655408.881 Easting: 1637200.454

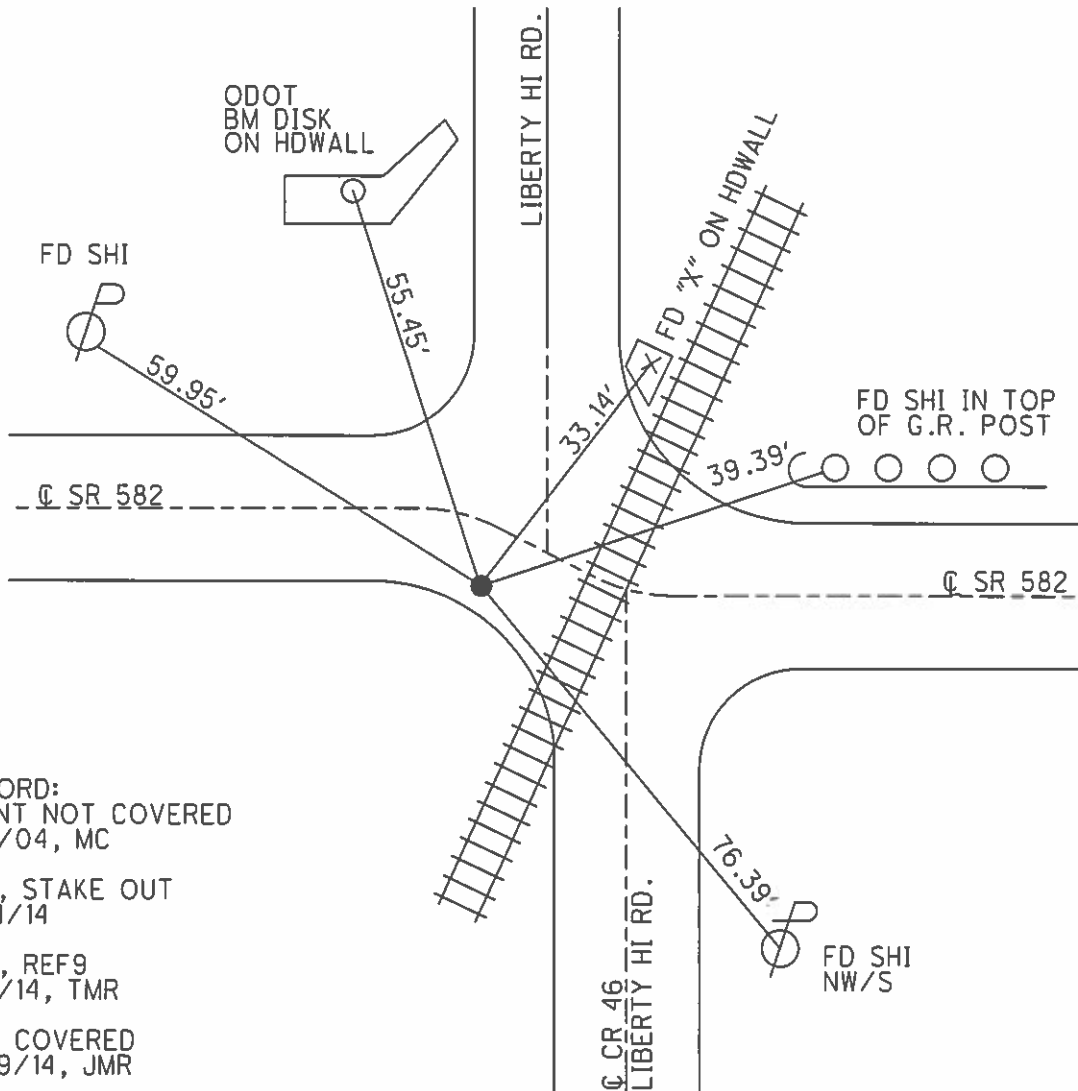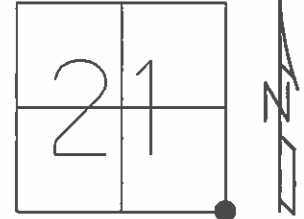

RECORD:
POINT NOT COVERED
8/2/04, MC

DNF, STAKE OUT
3/14/14

GPS, REF9
4/8/14, TMR

NOT COVERED
7/29/14, JMR

O.D.O.T. DISTRICT 2 SURVEY OFFICE

PERSONNEL

REFERENCE NO. 9

SHEET 7 OF 23

NOTES CANTERBURY RC

H.C. NUHFER

R.G. _____

BARNHISEL (DRAWN)

DATE 04/22/04

WEATHER cloudy Windy

TEMP. +50°

ROUTE S.R. 582

COUNTY Wood

TOWNSHIP MIDDLETON

SECTION 21

T 6 N R 10 E

TYPE MONUMENT Sm RR Spk

ON SURFACE - BELOW 5"


LEFT - ℄ PAVT. - RIGHT OF 582 EAST

— TO — EDGE PAVEMENT

S.L.M. 123+33


2.6' S. ℄ Pavt to West

7.4' W. OF ℄ NORTH

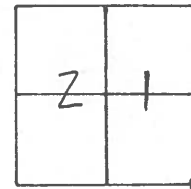

Record: Not Covered
8/02/04

POINT NOT COVERED
08/02/04
MC

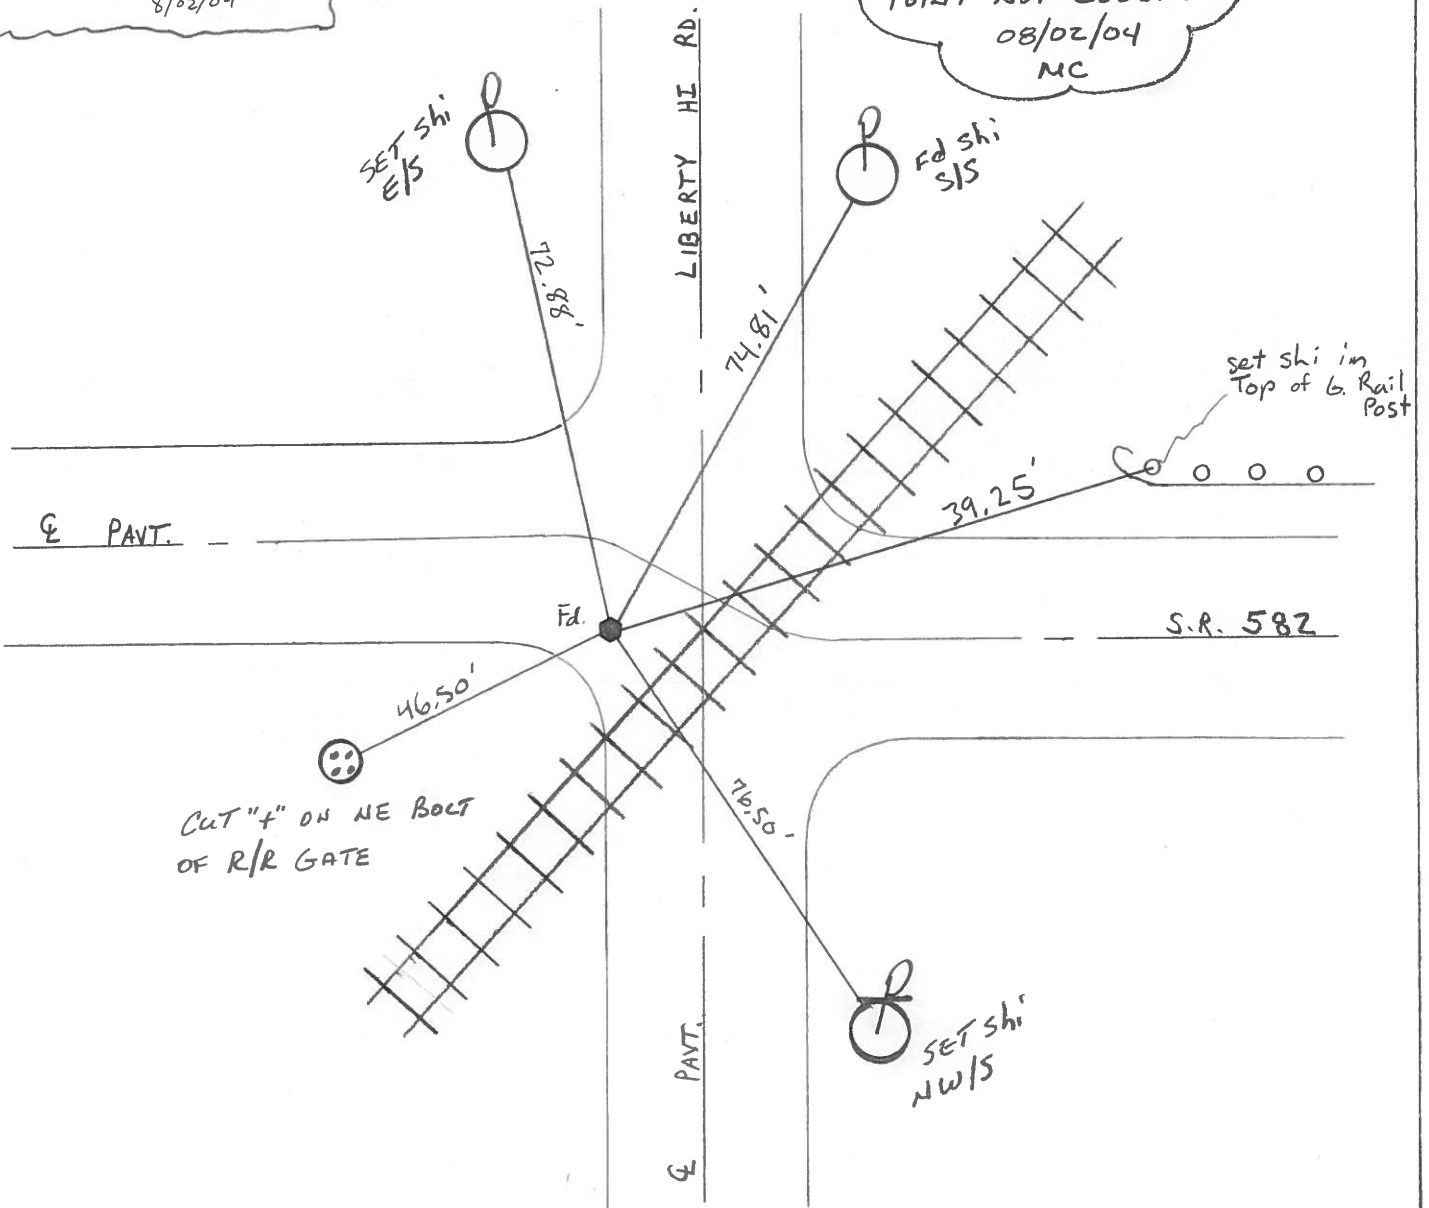

O.D.O.T. DISTRICT 2 SURVEY OFFICE

PERSONNEL

REFERENCE NO. 9

SHEET OF

NOTES BARNHISEL

H.C. HOFFMAN

DATE 3-27-86

ROUTE 582

R.C. Loehrke

WEATHER SUNNY

COUNTY WOOD

GRAMZA

TEMP. +35°

TOWNSHIP MIDDLETON

SECTION 21

T 6 N R 10 E



TYPE MONUMENT Sm RR Spk Set P.K. / washer 5-6-86 SWK

ON SURFACE - BELOW YES

LEFT - & PAV'T. - RIGHT EAST 582 - 8' W of & North


TO EDGE PAVEMENT

S.L.M. 123+33

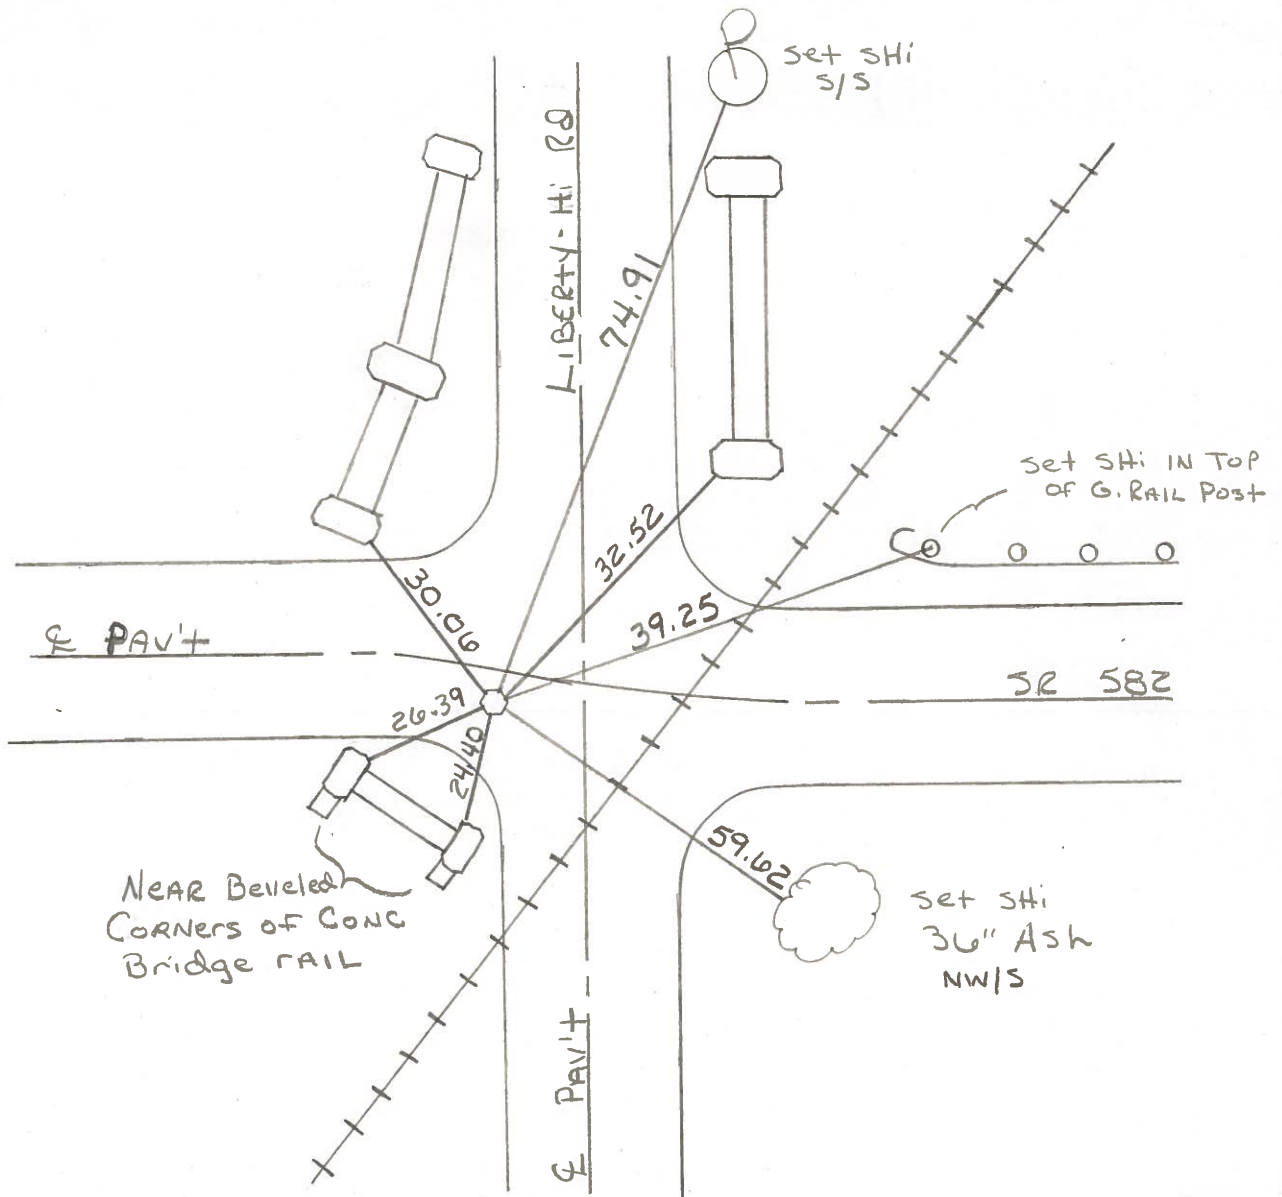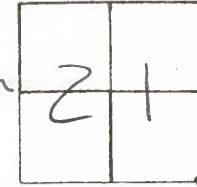


County Wood S.R. 582Date 5-14-1979Township WashingtonWeather ClearSection NW Corner Sec. 27Temp. 70°

T6N, R10E

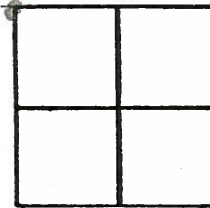Personnel SmithKnappeBowersMead

9

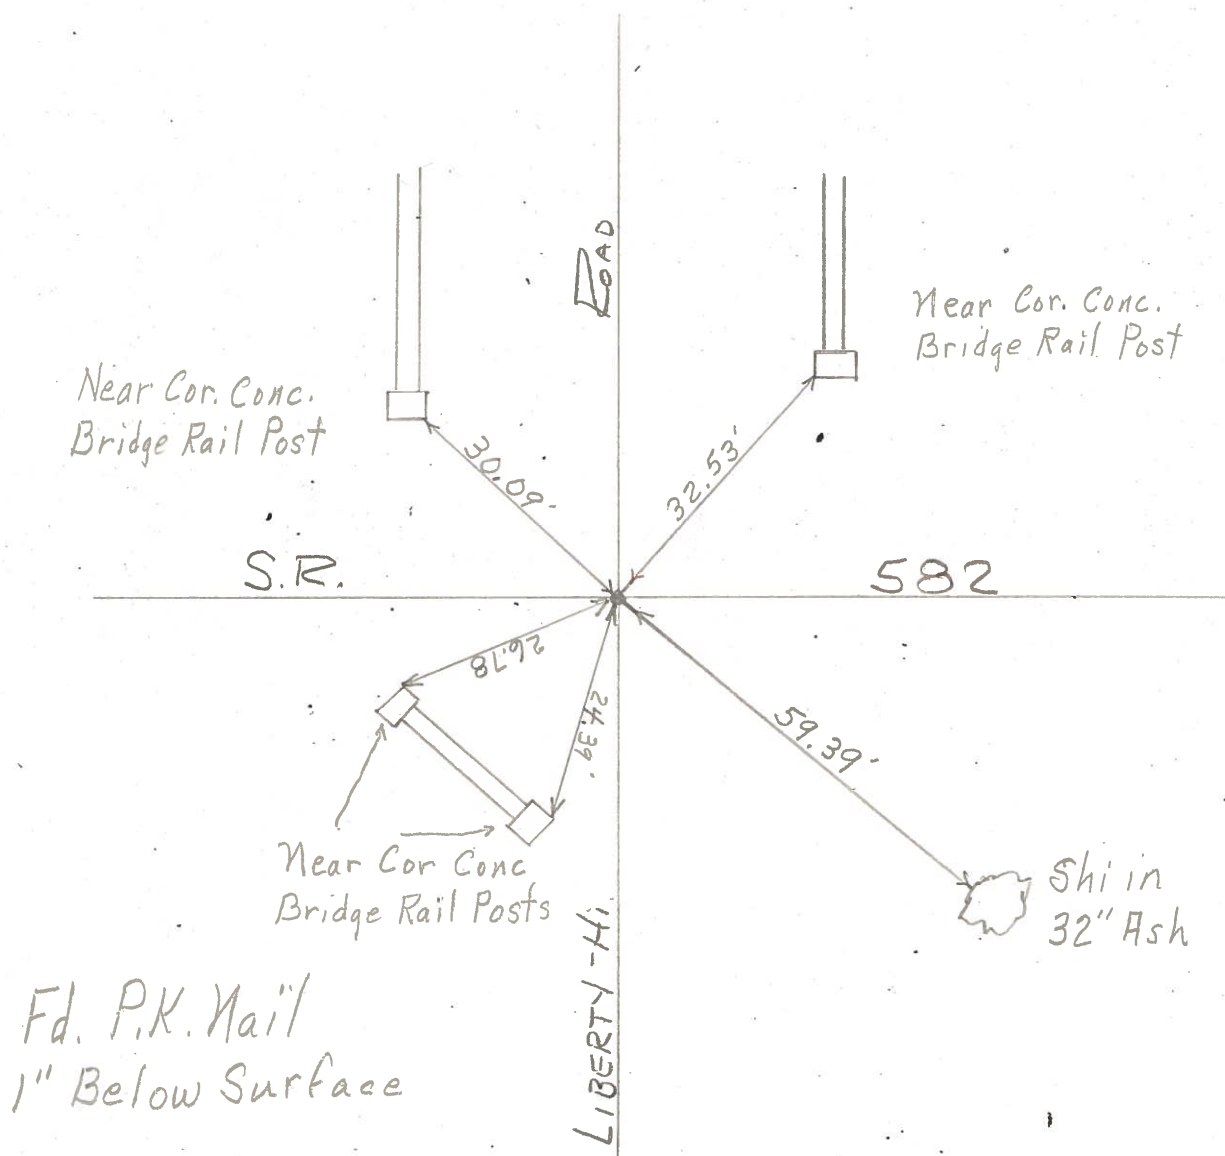

PERSONNEL	TITLE	PERSONNEL	TITLE
BURNSIDE			
BOWERS			
SMITH			
HOLCOMBE			

COUNTY WOODDATE 5-25-71S. R. 582WEATHER CLOUDYSEC. 27TEMP. +60°

DESCRIPTION

LEFT

CENTER LINE

RIGHT

JOB NO.

N.W. COR.
SEC. 27
MIDDLETON Twp.

FD. P.K. FROM
OLD WIT.

NEAR COR. CONC. BR. RAIL
POST

LIBERTY

NEAR COR. CONC. BR.
RAIL POST

32.53'

30.10'

59.37'

24.38'

26.80'

541.30"
ASH

Hi. ROAD

NEAR COR. CONC.

BRIDGE RAIL POSTS



PERSONNEL	TITLE	PERSONNEL	TITLE
Silvester			
Burnside			
Smith			

COUNTY Wood

DATE _____

S. R. 582

WEATHER _____

SEC. _____

TEMP. _____

DESCRIPTION with Ties for Section Corners

JOB NO. _____


LEFT

CENTER LINE

RIGHT

Shiner Set 4'E from w. Edge Pavmt
 E 1/4 Post Sec 20 Middleton Twp.
 Set Shiner ^{from} Old Survey from int. 1/4 Sec 20

Conc guard Rail
 E 1/4 Post Sec 21 Middleton Twp
 Ed Stone under Culvert from old wit.
 Set PK. Same on Road Surface

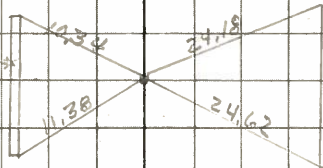

PERSONNEL TITLE PERSONNEL TITLE

COUNTY 1

DATE

Schneider

Barbour

Redding

P. H. S.

S. R. 58

WEATHER

SEC. 11

TEMP.

DESCRIPTION

Ties for

LEFT

CENTER LINE

RIGHT

JOB NO.

Sta. Twin 16' Asst

50.87

32.93

203+16

CON. POST

Fd. 1" Pipe

3" below surface

24.97

26.34

1" I. Pipe

Fd. 1" I. Pipe

4" below surface

SET R.R. Spk ON TOP

13

149+95

Fd. R.R. Spk

ON SURFACE

Top Flag

Sta. 16'

28.64

27.02

24.57

24.63

CON. POST

X X X

R.R. NAIL ON SURFACE

11

138+04

Fd. R.R. Spk

ON SURFACE

51.11'

29.38'

50.75'

5 #64

9

CONC. BR. RAIL

CONC. BR. RAIL

109+56

Fd. 1" Pipe

ON SURFACE

143.15'

133.79'

66.54'

8

PERSONNEL TITLE PERSONNEL TITLE

COUNTY

Wood

DATE

12-27-57

Sworden

4-4-60

S. R.

#582

WEATHER

SEC.

TEMP.

DESCRIPTION

LEFT

CENTER LINE

RIGHT

JOB NO.

N. 1/4 post of N.E. 1/4 of
Washington twp. Sec. 28
Fd. E.E. spike

O.K.

T.P.

S.E.

133.75'

P.P.

W.N.W.

143.23'

T.P.

W.S.W.

66.57'

Set Iron Pipe 4.3' W. of S. edge Rivt

#437

N.W. cor. sec. 27 Middleton
Twp. Liberty Hi. Rd.
Stone - E.E. spike

O.K.

9

Shiner in 24" Bash

S.E.

59.46'

E. angle point of S. abut. of

B&O. R.R. br. N.E.

43.20'

W. angle point of N. abut. of

culvert under B&O. S.W.

56.40'

Face of W. rail B&O. R.R.

perpendicular

10.03'

S.W. cor. conc. curb. E. railing N.E.

32.12'

S.E. cor. conc. curb. W. railing N.W.

29.60'

N.E. cor. conc. curb. S. railing S.W.

23.80'

N.W. cor. conc. curb. S. railing S.W.

26.40'

N.E. cor. conc. Hd. w. Sp. W.

50.45'

Iron pipe S. 1/4 Cor. Sec. 22
Middleton

O.K.

#440

||

Shiner in T.P.

N.W.

57.77'

57.80'

Shiner in 12" Elm New S.S.W.

27.30'

27.45'

Shiner in Anchor post S.

24.65'

24.50'

Shiner in 18" catalpa E.S.E.

63.24'

Shiner in Tele. Pole S.E.

44.25'