

O.D.O.T. DISTRICT 2 SURVEY OFFICE (USE ONLY)

PERSONNEL

REFERENCE NO. 11

SHEET 13 OF 25

NOTES MILLER
H.C. MILLER
R.C. BARRIERE
BLUBAUGH

DATE 8/6/24
WEATHER CLOUDY
TEMP. 75°

ROUTE SR 582
COUNTY WOOD
TOWNSHIP MIDDLETON
SECTION 22

DWG BY BARRIERE PID 114849

T 6 N R 10 E

TYPE MONUMENT MAG WASHER

ON SURFACE - BELOW ON

OFFSET Q PAVEMENT 7' LT : RT

3.2' TO RT EDGE PAVEMENT

STATION: 150+10

HORIZ.DATUM: NAD83 (2011)


GEOID: 18

GRID: NORTHING: 655337.098

EASTING: 1639873.605

LDP: NORTHING: 477013.301

EASTING: 150617.371

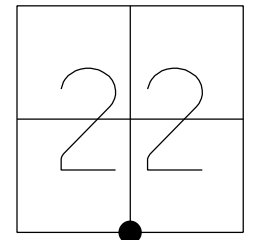

FLAG POLE
1' UP


CUT "+"
OF M.H.
RIM E/S

FD "+" TOP
S. BOLT ON
BONNET F.H.

FD SHI
S/S

SET SHI
16" MAPLE

SET MAG/WASHER
8/2/04, MC
FND MAG/WASHER
GPS, REF11
3/14/14, DCH
SET MAG/WASHER
7/29/14, EBW
GPS, NEWREF11
7/29/14, JMR
FD MAG/WASH
REF11
12/8/23, JAM
FD MAG/WASH
8/6/24, JAM


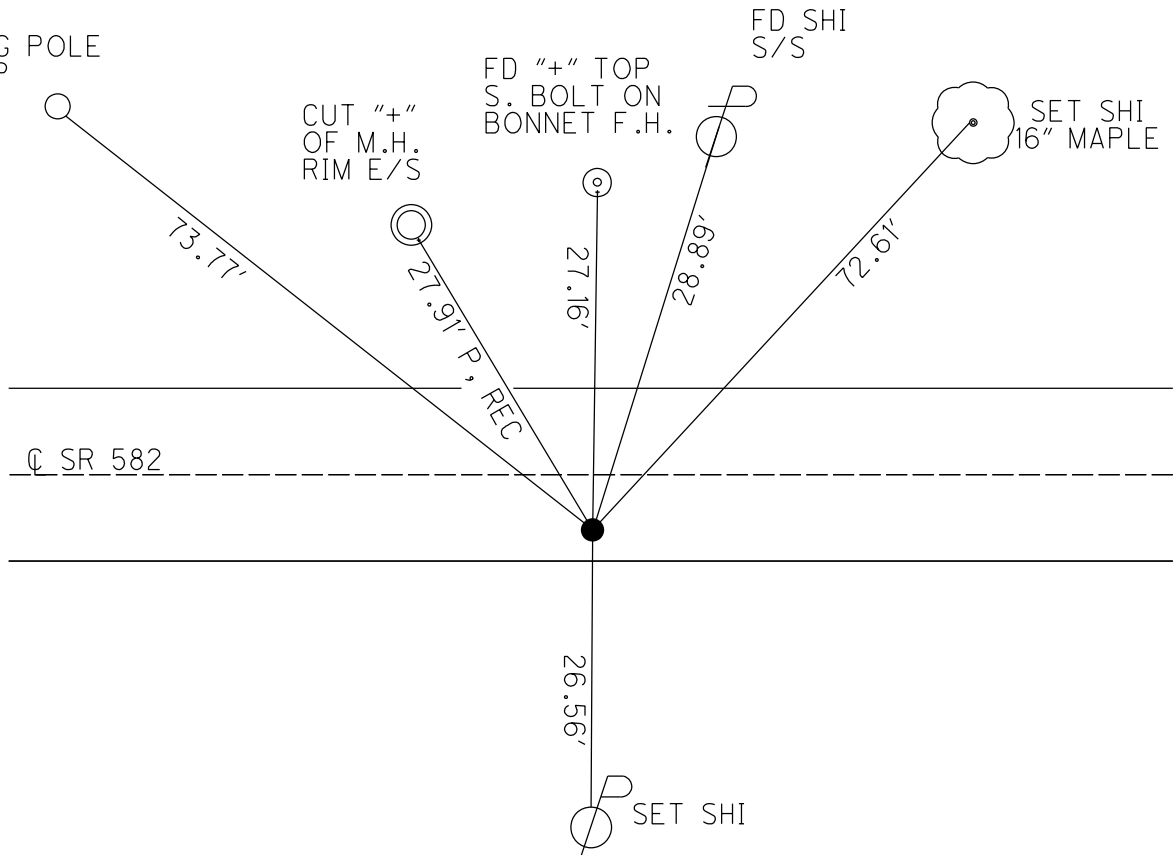


O.D.O.T. DISTRICT 2 SURVEY OFFICE (USE ONLY)

PERSONNEL	REFERENCE NO. <u>11</u>	SHEET <u>13</u> OF <u>25</u>
NOTES	DATE <u>4/8/14</u>	ROUTE <u>SR 582</u>
H.C. <u>RHOADES</u>	WEATHER <u>FAIR</u>	COUNTY <u>WOOD</u>
R.C. <u>HOMAN</u>	TEMP. <u>53°</u>	TOWNSHIP <u>MIDDLETON</u>
<u>ROUSOS</u>		SECTION <u>22</u>
<u>GABLE</u>		T <u>6</u> N R <u>10</u> E

TYPE MONUMENT MAG/WASHER
~~ON SURFACE~~ - BELOW 1/8"
~~LEFT~~ - Q PAV'T - RIGHT 7.0'
3.2' TO RT EDGE PAVEMENT
 S.L.M. 150+10

Grid: Northing: 655337.098 Easting: 1639873.605

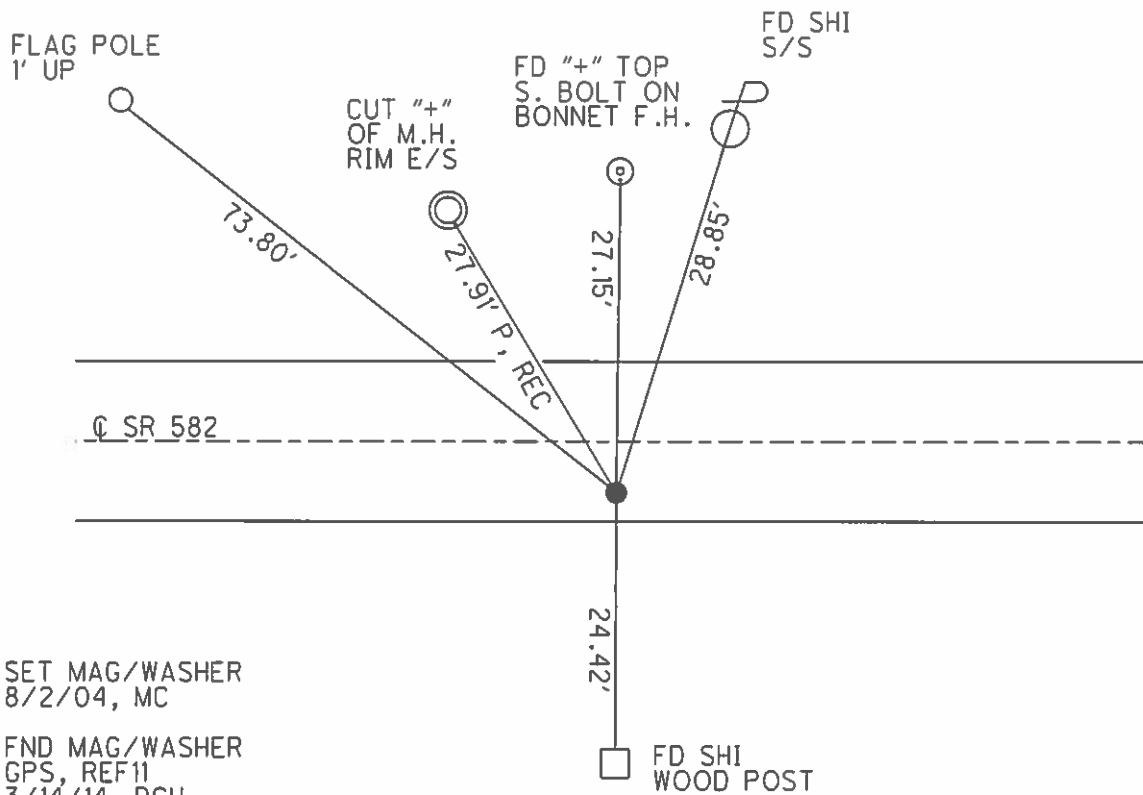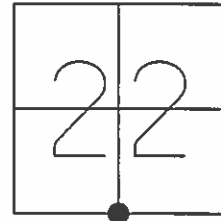

SET MAG/WASHER
8/2/04, MC

FND MAG/WASHER
GPS, REF11
3/14/14, DCH

SET MAG/WASHER
7/29/14, EBW

GPS, NEWREF11
7/29/14, JMR

O.D.O.T. DISTRICT 2 SURVEY OFFICE

PERSONNEL

REFERENCE NO. 11 SHEET 10 OF 23

NOTES BARNHISEL

H.C. HOFFMAN

R.C. Loch RKE

DRAWN (Joe Kolehmainen)

DATE 4-22-04

WEATHER Sunny Cloudy

TEMP. + 50°

ROUTE S.R. 582

COUNTY Wood

TOWNSHIP MIDDLETON

SECTION 22

T 6 N R 10 E


TYPE MONUMENT SM. R.R. SPK

ON SURFACE ~~BELOW~~ Yes


~~LEFT~~ - CL PAV'T. - RIGHT 7.0

3.2 TO RT. EDGE PAVEMENT

S.L.M. 150 + 10

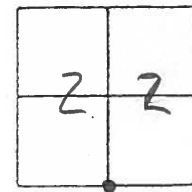

Set MAG/Washer
8/2/04 M.C.

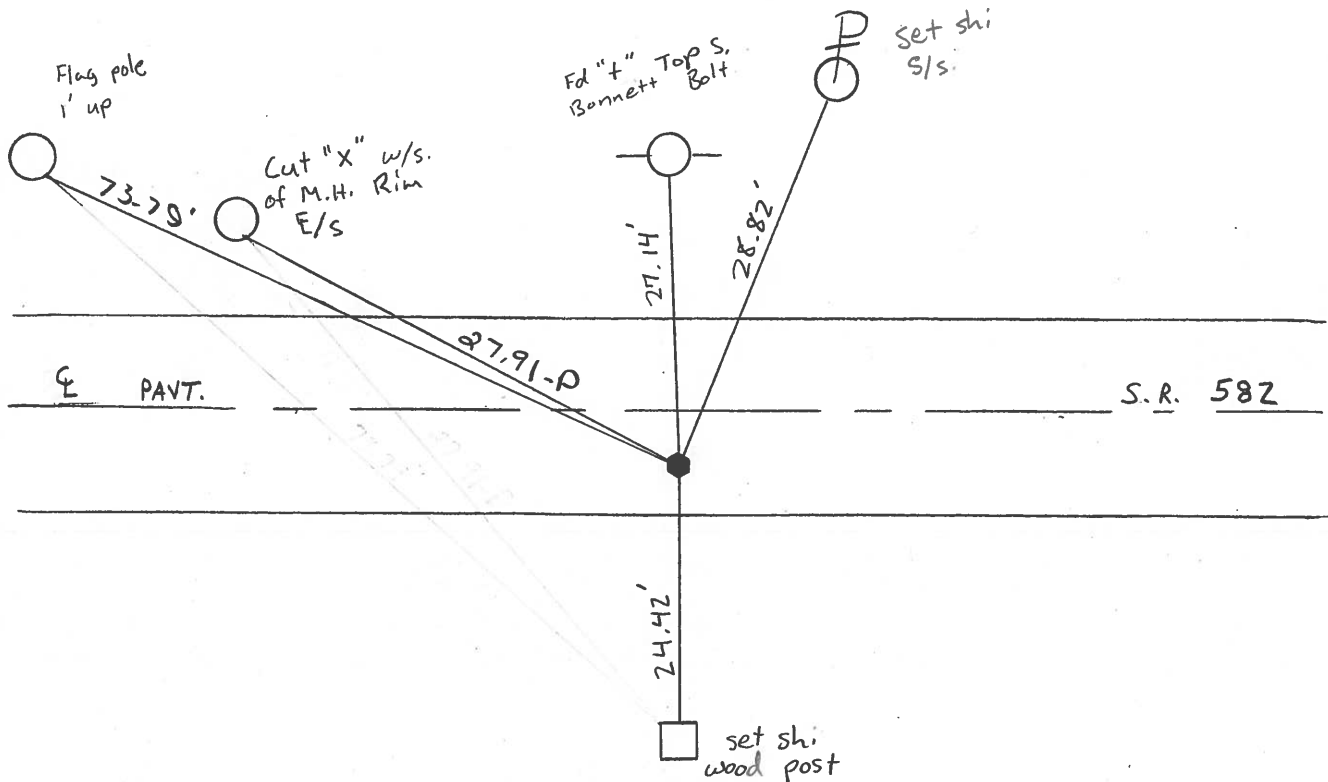

O.D.O.T. DISTRICT 2 SURVEY OFFICE

PERSONNEL

REFERENCE NO. # 11

SHEET OF

NOTES BARNHISEL

H.C. HOFFMAN

R.C. Loehke

DATE 9-6-89

WEATHER SUNNY

TEMP. +70°

ROUTE S.R. 582

COUNTY WOOD

TOWNSHIP Middleton

SECTION 22

T. 6 N. R. 10 E


TYPE MONUMENT P.K. NAIL

ON SURFACE - BELOW 4"


LEFT - CL PAV'T. - RIGHT 6.1

3.2 TO R+ EDGE PAVEMENT

S.L.M. 149 + 72

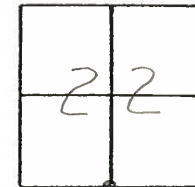

Set Sm RR Spk
11-8-89
ynB

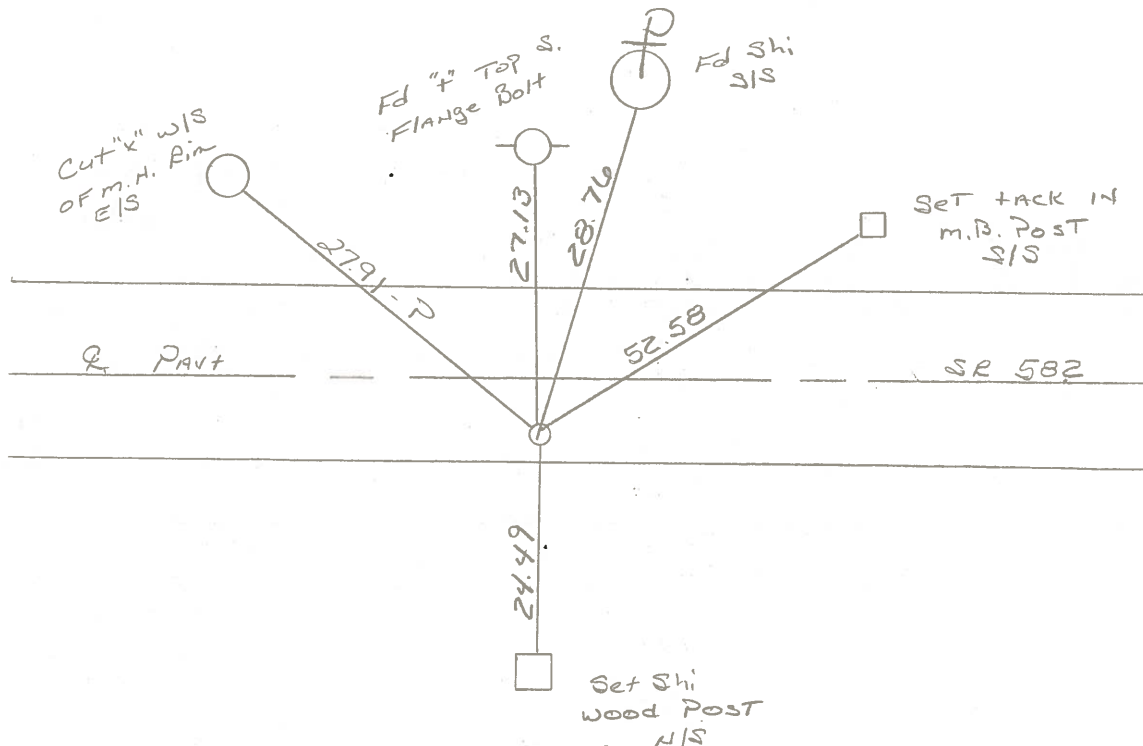

Q.D.O.T. DISTRICT 2 SURVEY OFFICE

Sht. ____ of ____

County WOOD S.R. 582

Date 7-30-80

Township MIDDLETON

Weather _____

Section 22

Temp. _____


T6N, R10E

Personnel BURNSIDE


SMITH

BOWERS

HOLCOMBE

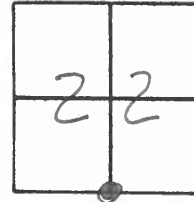

#11

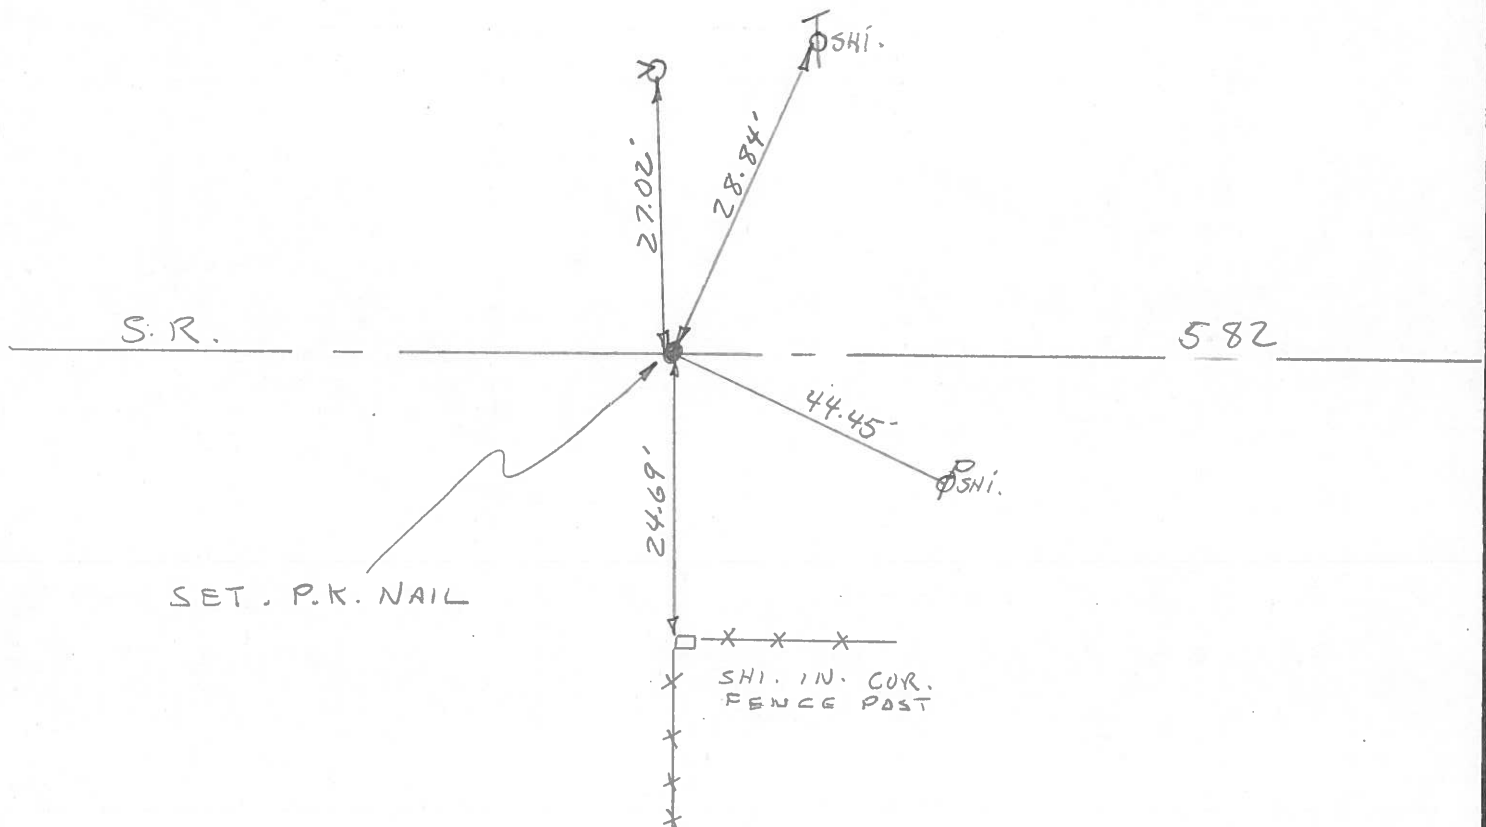


County Wood S.R. 582Township MIDDLETONSection 22

T6N, R10E


Personnel HOFFMANLOCHERKEHOUSEHOLDER R.C.BARNHISEL H.C.

#11

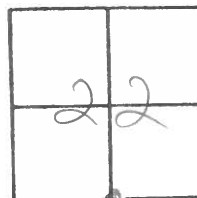Date 6-1-84Weather P. CLEARTemp. +70°

Fd P.K. Nail $1\frac{1}{2}$ " Below Surface
 ALSO Fd P.K. Nail SHANK ON EAST SIDE of P.K. Nail

5.9' RT. of & Post
 4.2' TO RT. EP.
 16.8' TO LT. EP.

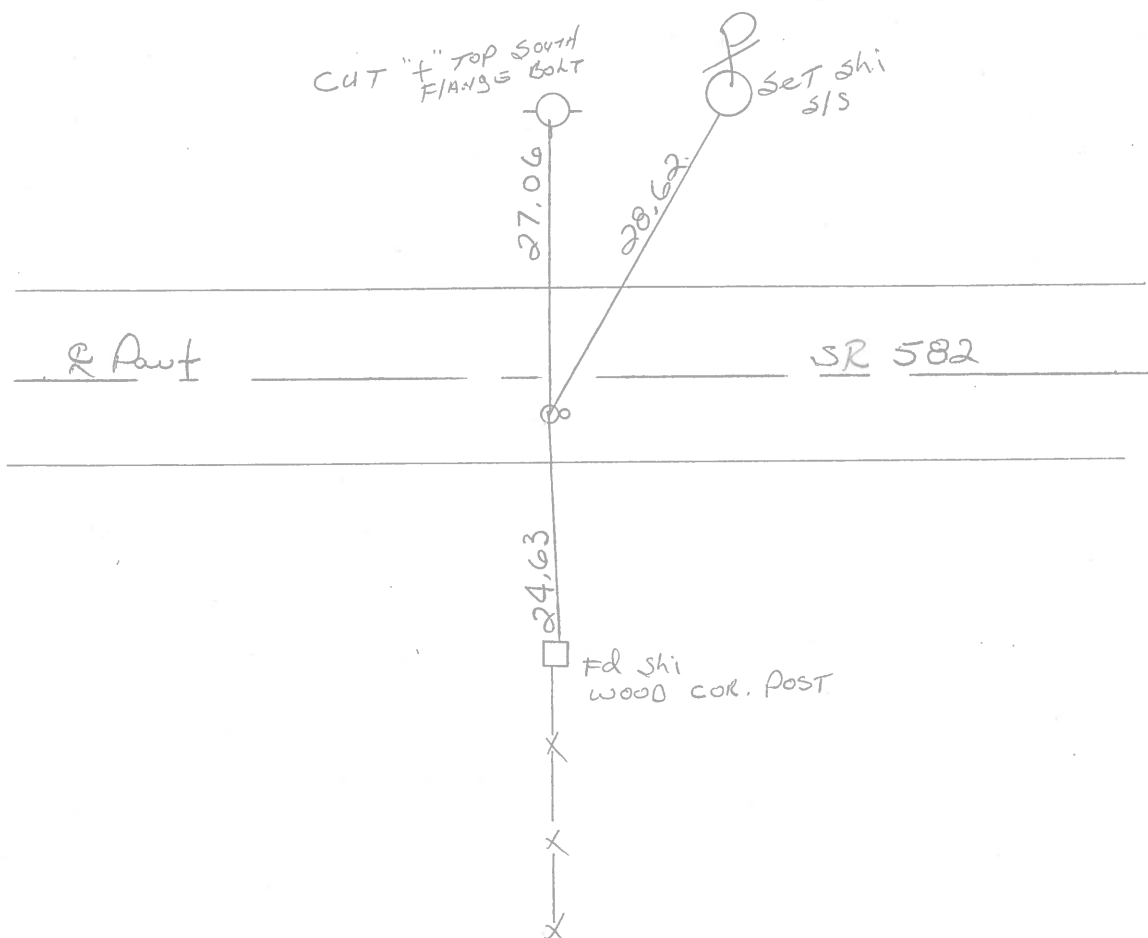

ALL COPIED

SHEET NO.

PERSONNEL	TITLE	PERSONNEL	TITLE
1		1	
2		2	
3		3	
100		100	

BURNSIDE

Smith

BOWERS

How come?

COUNTY Wood

DATE 5-28-71

S. R. 582

WEATHER Clear

SEC.

TEMP. +63°

DESCRIPTION.

LEFT

CENTER LINE

RIGHT

JOB NO.

FD. 1" I. Ripe

4" DEEP

SET R.P. Spk @

SURFACE

6500' ± EAST OF S.R. 64

FO. P.K. MAIL ON

SURFACE

1200' ± EAST OF
S.P. 64

S.P. 64

Set P, K. Nail

7-30-80

1. $\frac{1}{2}$ 5/11

SHi. Twin
16" ASA

511i

541 ϕ

TOP FLANGE
FINE 11-10.

541

ЭН. Вр. Ренес
Вет

See S. R. 64 Feb 10
S. R. 562


GODIED ✓

SHEET NO. 1


PERSONNEL	TITLE	PERSONNEL	TITLE	COUNTY	DATE	WEATHER	TEMP.
BURNSIDE				WOOD	5-28-71	CLEAR	+65°
SMITH				S. R. 582			
BOWERS				SEC.			
HOLCOMBE							

DESCRIPTION	LEFT	CENTER LINE	RIGHT	JOB NO.
-------------	------	-------------	-------	---------

FD. 1" I. PIPE
4" DEEP
SET R. R. Spk @
SURFACE
6500' ± EAST OF S. R. 64

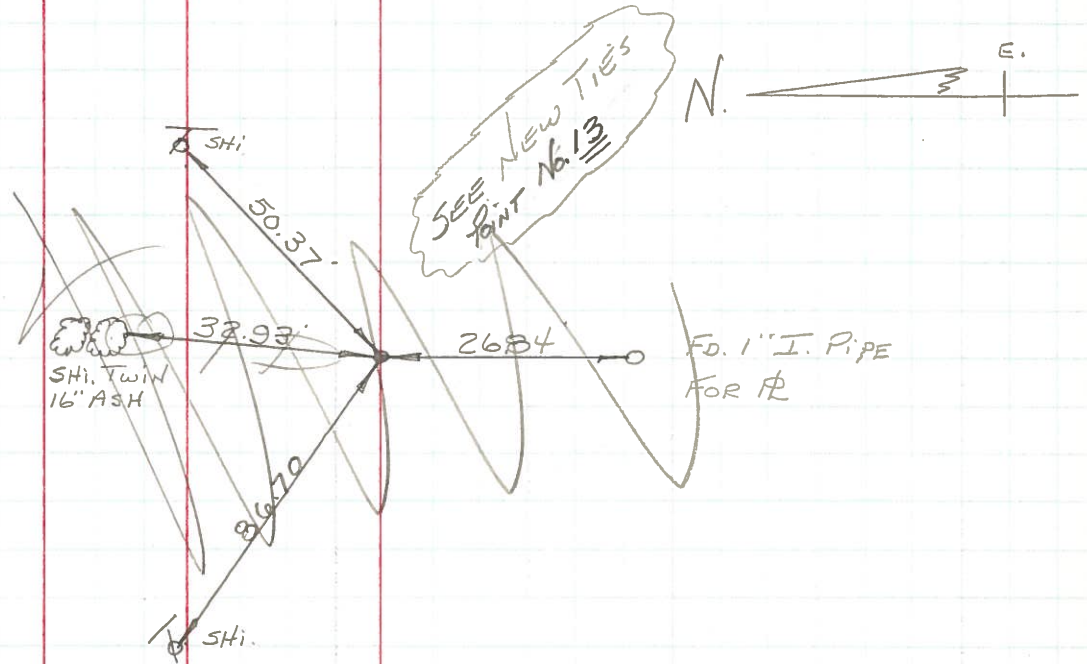

FD. P.K. NAIL ON
SURFACE
1200' ± EAST OF
S. R. 64

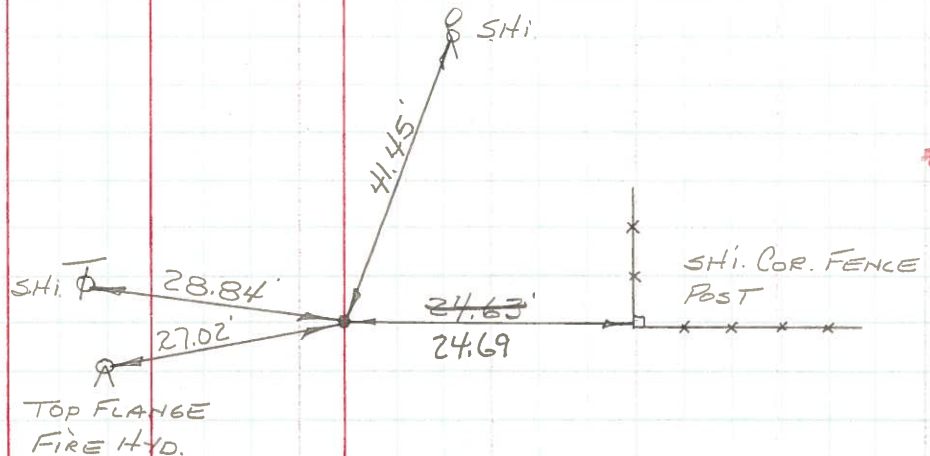


SEE S. R. 64 FOR #10 ON

203+16
138+04
65+12

SHEET NO. 2

PERSONNEL	TITLE	PERSONNEL	TITLE	COUNTY	DATE
Schneider				Wood	6-12-67
Barbour				S. R. 582	WEATHER Fair-Hot
Redding				SEC. 0.00-3.10	TEMP. 90°
Bo Hs					

DESCRIPTION Ties for control into JOB NO. _____

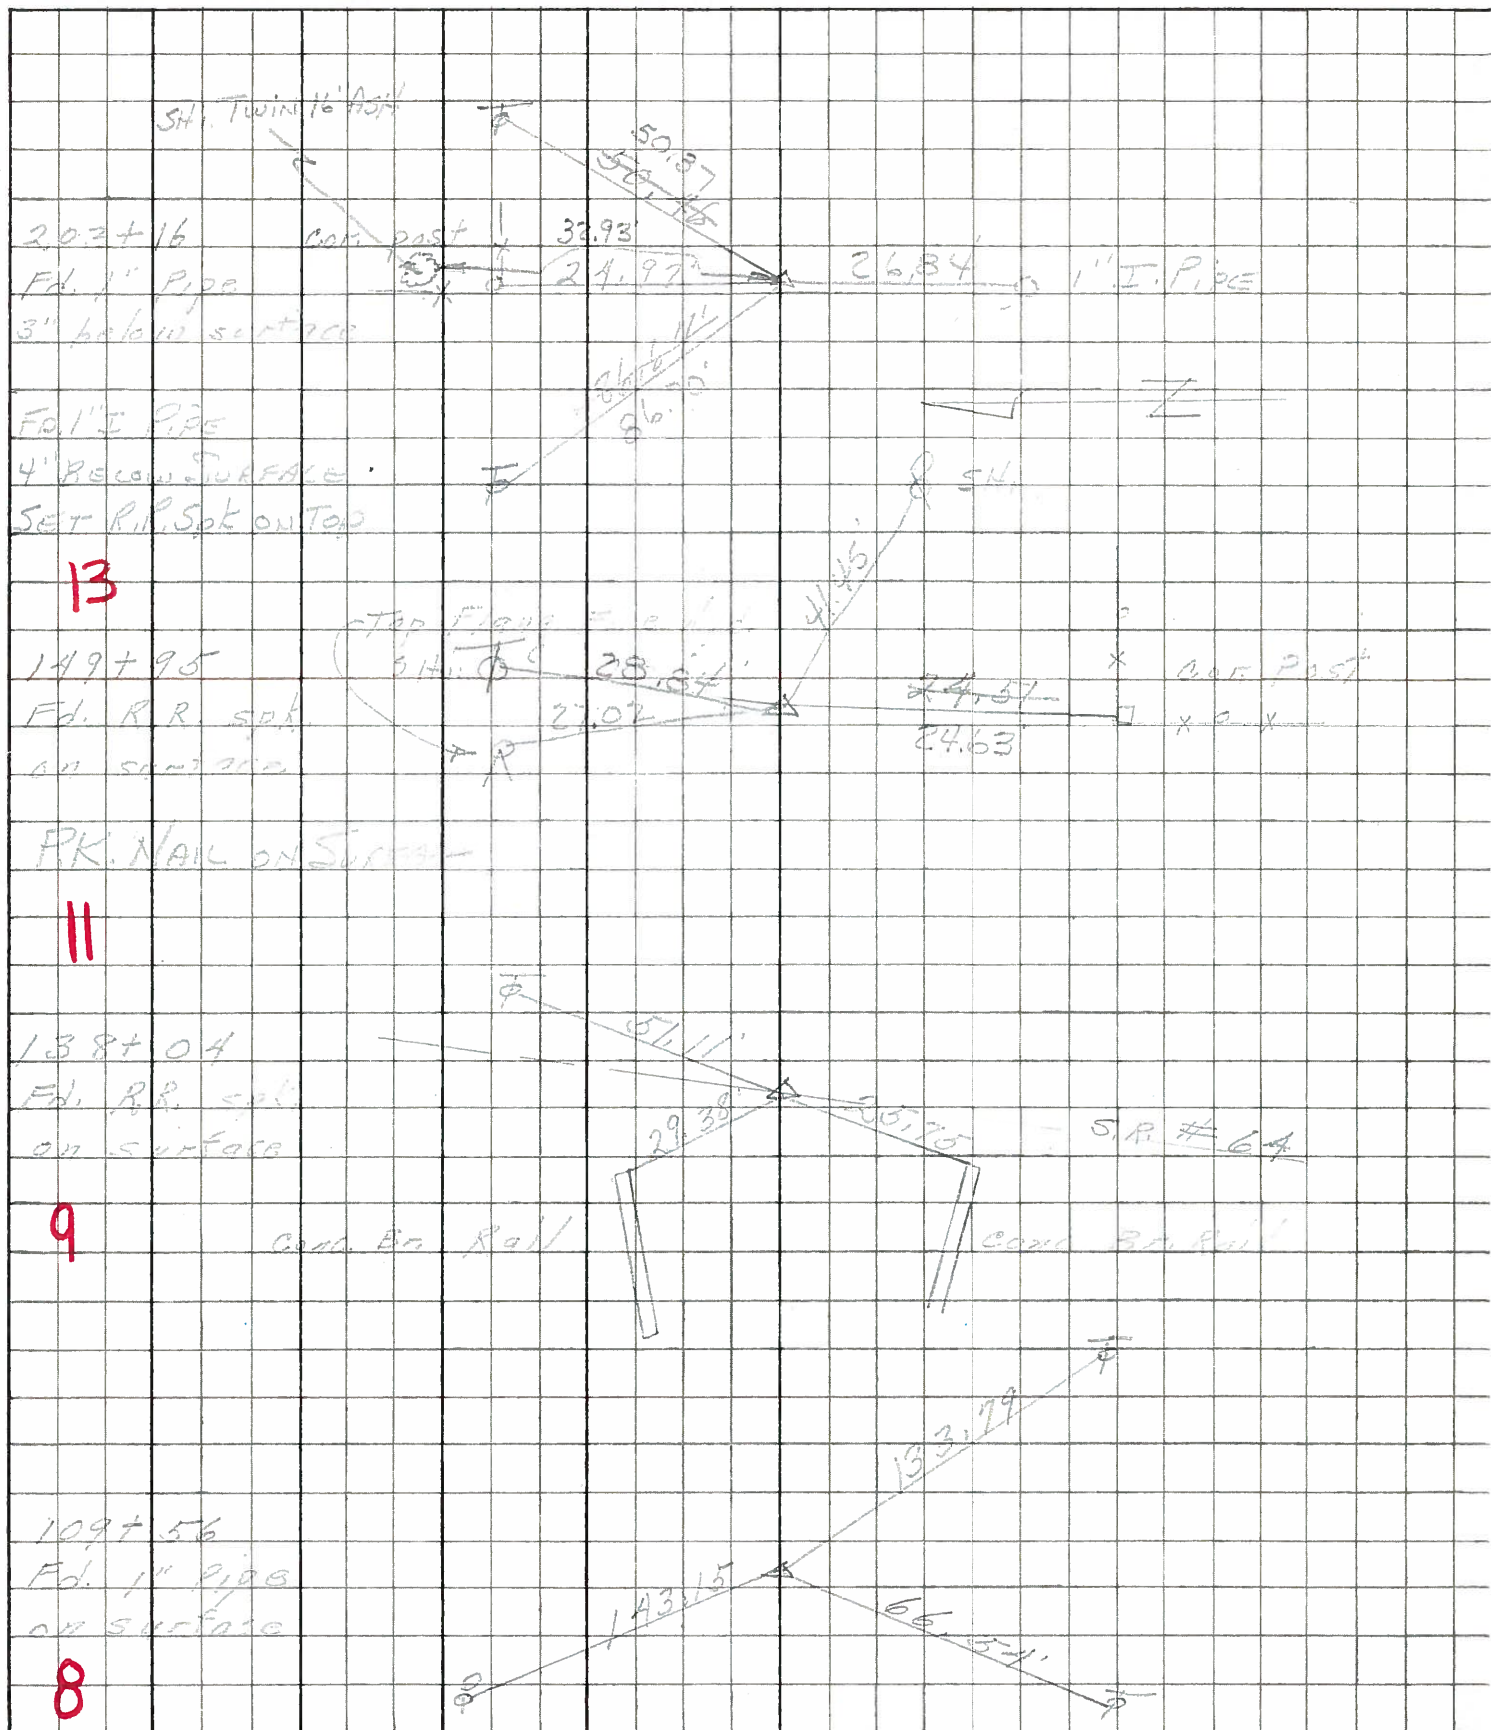

PERSONNEL	TITLE	PERSONNEL	TITLE

COUNTY WoodDATE 12-27-57Smorden 4-4-60S. R. #582

WEATHER

SEC.

TEMP.

DESCRIPTION

LEFT

CENTER LINE

RIGHT

JOB NO.

N. 1/4 post of N.E. 1/4 of
Washington twp. Sec. 28
Fol. E.E. spike
Set Iron Pipe 4.3' W. of S. edge Part

#437

O.K.

T.P.

S.E. 133.75

P.P.

W.N.W. 143.23

T.P.

W.S.W. 66.57

N.W. cor. sec. 27 Middleton
Twp. Liberty Hi. Rd.
Stone - E.E. spike

9

#438

O.K.

Shiner in 24" B. ash S.E. 59.46

S. angle point of S. abut. of
B&O. E.R. br. N.E. 43.20W. angle point of N. abut. of
culvert under B&O. S.W. 56.40Face of W. rail B&O. E.E.
perpendicular 10.03'

S.W. cor. conc. curb. E. railing N.E. 32.12

S.E. cor. conc. curb. W. railing N.W. 29.60

N.E. cor. conc. curb. S. railing S.W. 23.80

N.W. cor. conc. curb. S. railing S.W. 26.40

N.E. cor. conc. Hdwl. S of W. 50.45

Iron pipe S. 1/4 Cor. Sec. 22
Middleton

#440

||

O.K.

Shiner in T.P. N.W. 57.77'

Shiner in 12" Elm New S.S.W. 27.30 27.45

Shiner in Anchor post S. 24.65 24.50

Shiner in 18" catalpa E.S.E. 63.29

Shiner in Tele. Pole S.E. 44.25