

O.D.O.T. DISTRICT 2 SURVEY OFFICE (USE ONLY)

PERSONNEL

REFERENCE NO. 13

SHEET 15 OF 25

NOTES MILLER
H.C. MILLER
R.C. BARRIERE
BLUBAUGH

DATE 8/6/24
WEATHER CLOUDY
TEMP. 75°

ROUTE SR 582
COUNTY WOOD
TOWNSHIP MIDDLETON
SECTION 23

DWG BY BARRIERE PID 114849

T 6 N R 10 E

TYPE MONUMENT MAG WASHER

ON SURFACE - BELOW 0.5" BELOW

OFFSET Q PAVEMENT 3.0 ~~LT~~ : RT

7.7' TO RT EDGE PAVEMENT

STATION: 203+00

HORIZ.DATUM: NAD83 (2011)


GEOID: 18

GRID: NORTHING: 655196.693


EASTING: 1645199.835

LDP: NORTHING: 476943.122

EASTING: 155945.340

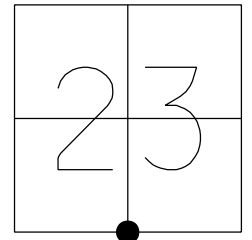

SET MAG/WASHER
8/2/04, MC
FND MAG/WASHER
GPS, REF13
3/14/14, DCH
SET MAG/WASHER
7/29/14, EBW
GPS, NEWREF13
7/29/14, JMR
FD MAG/WASH
REF13
12/8/23, JAM
FD TONE, DID NOT UNCOVER
8/6/24, JAM

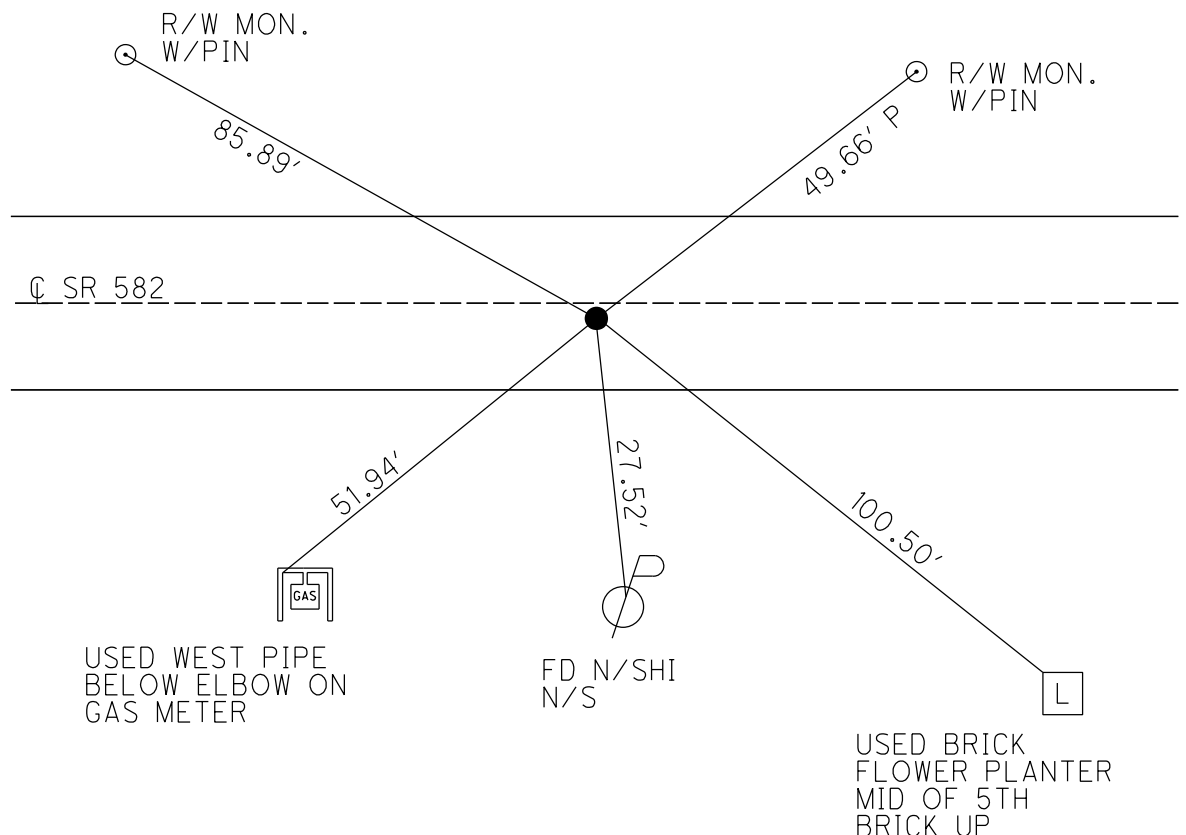


O.D.O.T. DISTRICT 2 SURVEY OFFICE (USE ONLY)

PERSONNEL	REFERENCE NO. <u>13</u>	SHEET <u>15</u> OF <u>25</u>
NOTES	DATE <u>4/8/14</u>	ROUTE <u>SR 582</u>
H.C. <u>RHOADES</u>	WEATHER <u>FAIR</u>	COUNTY <u>WOOD</u>
R.C. <u>HOMAN</u>	TEMP. <u>53°</u>	TOWNSHIP <u>MIDDLETON</u>
<u>ROUSOS</u>		SECTION <u>23</u>
<u>GABLE</u>		T <u>6</u> N R <u>10</u> E

TYPE MONUMENT MAG NAIL
 ON SURFACE - ~~BELOW~~ ON
~~LEFT~~ - C PAV'T - RIGHT 3.0'
7.7' TO RT EDGE PAVEMENT
 S.L.M. 203+00

Grid: Northing: 655196.693 Easting: 1645199.835

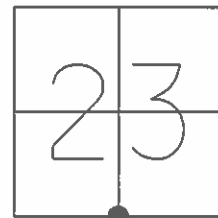


SET MAG/WASHER
8/2/04, MC

FND MAG/WASHER
GPS, REF13
3/14/14, DCH

SET MAG/WASHER
7/29/14, EBW

GPS, NEWREF13
7/29/14, JMR

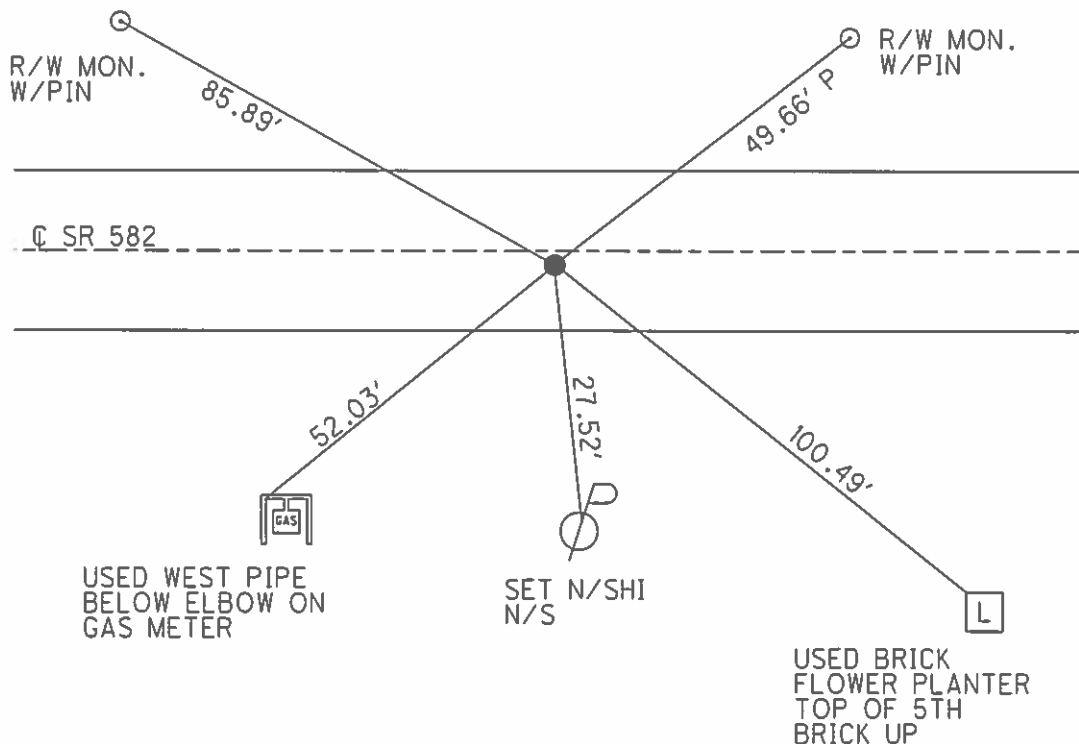

O.D.O.T. DISTRICT 2 SURVEY OFFICE

PERSONNEL

REFERENCE NO. 13

SHEET 12 OF 23

NOTES M. Canterbury

H.C. M. Barnhisel

R.C. M. Canterbury

DATE 4-26-04

WEATHER clear

TEMP. +50° F

ROUTE S.R. 582

COUNTY Wood

TOWNSHIP MIDDLETON

SECTION 23

T 6 N R 10 E


TYPE MONUMENT Mag Nail

~~ON SURFACE~~ - BELOW below


~~NEED TO DRAW~~ - (RIGHT) 2.2' Rt.

7.7' TO Rt. EDGE PAVEMENT

S.L.M. 203+00

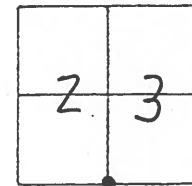

Reset Mag/Wash.
8-2-04
M.C.

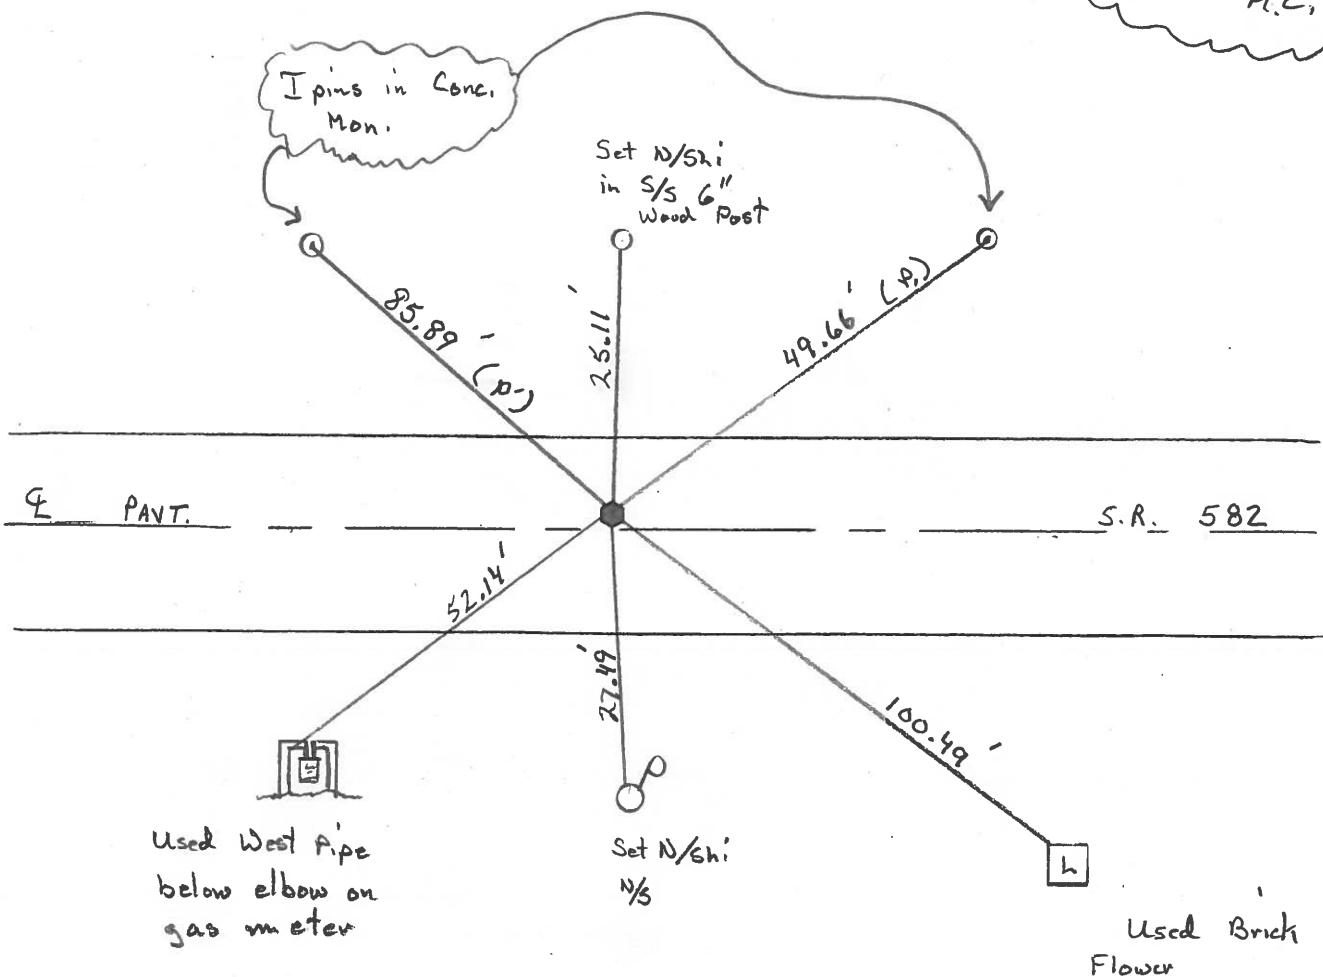

O.D.O.T. DISTRICT 2 SURVEY OFFICE

PERSONNEL

REFERENCE NO. 13

SHEET OF

NOTES BARNHISEL

H.C. HOFFMAN

R.C. LOEHRKE

DATE 9-6-89

WEATHER clear

TEMP. +70°

ROUTE S.R. 582

COUNTY WOOD

TOWNSHIP MIDDLETON

SECTION 23

T 6 N R 16 E


TYPE MONUMENT Sm RR Spk

ON SURFACE - BELOW yes

LEFT - C PAV'T. - RIGHT 1.0


9.1 TO Rt EDGE PAVEMENT

S.L.M. 203+01

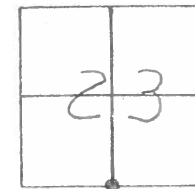

Set PK & Washer
11-8-89
MB

IRON PINS
IN CONC MONS

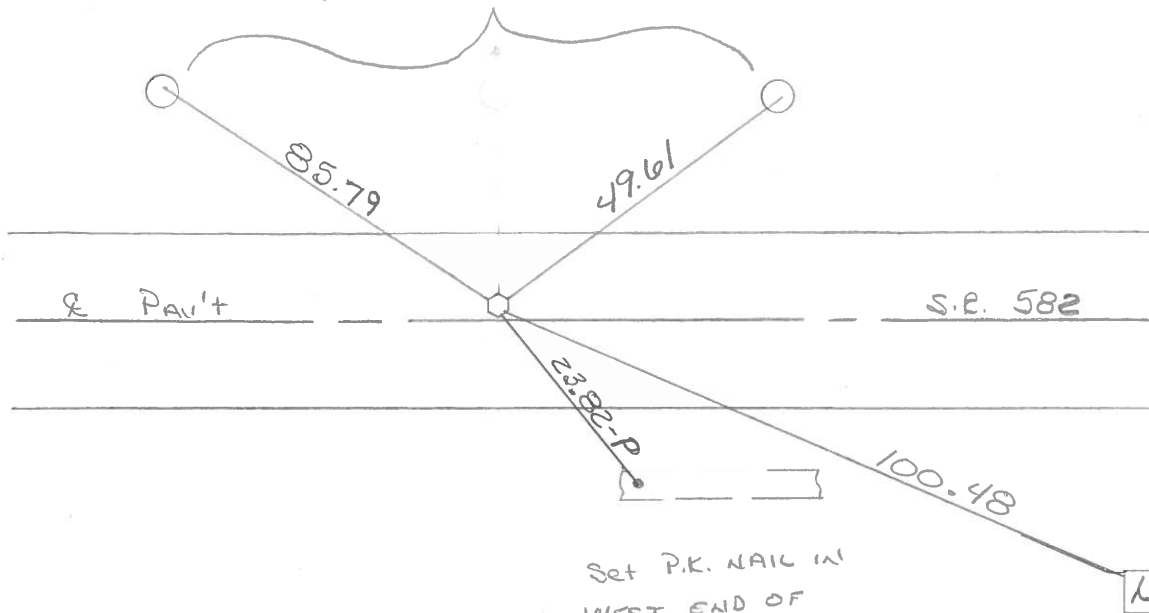

Set P.K. NAIL IN
WEST END OF
" CMP

USED BRICK Flower
Pot & Light Base
OF B.C. DRENNON Rds.

"Middle of 3rd Brick"
down from cap.

Q.D.O.T. DISTRICT 2 SURVEY OFFICE

Sht. ____ of ____

County WOOD S.R. 582

Township MIDDLETON

Section 23

T&N, RIDE

Personnel BURNSIDE

SMITH


BOWERS

MEAD

Date 11-7-74

Weather CLEAR

Temp. 52°

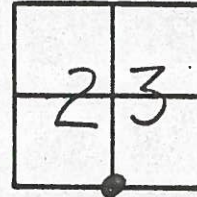


#13

OK-5-20-81
FD, SPK. ON & E
1" DEEP

S-HOFFMAN

Set small RR
SPK 8-28-81

11.8' NEP
10.2' SEP
0.8' S of E

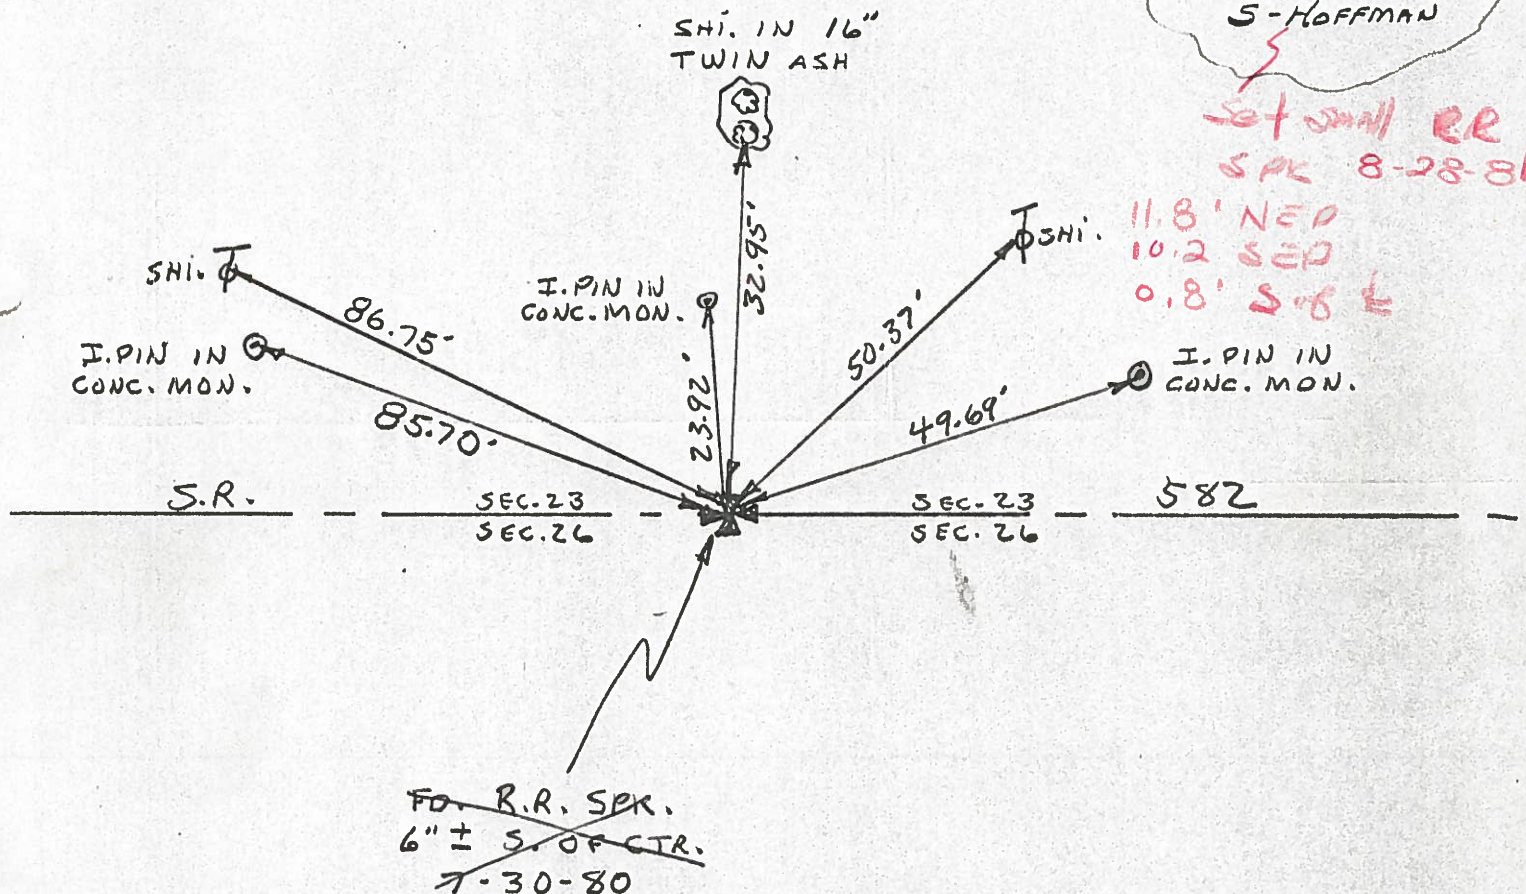


Q.D.O.T. DISTRICT 2 SURVEY OFFICE

Sht. ____ of ____

County WOOD S.R. 582Township MIDDLETONSection 23

T6N, R10E

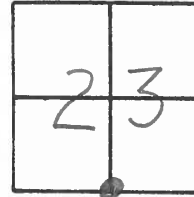
Personnel BURNSIDESMITHBOWERSMEADDate OK-5-20-81
11-7-74Weather CLEARTemp. 52°

#13

OK-5-20-81
FD. SPK. ON & E
1" DEEP.
S-HOFFMAN


SHI. IN 16"
TWIN ASH

SET SMALL R.R. SPK.
8-28-81

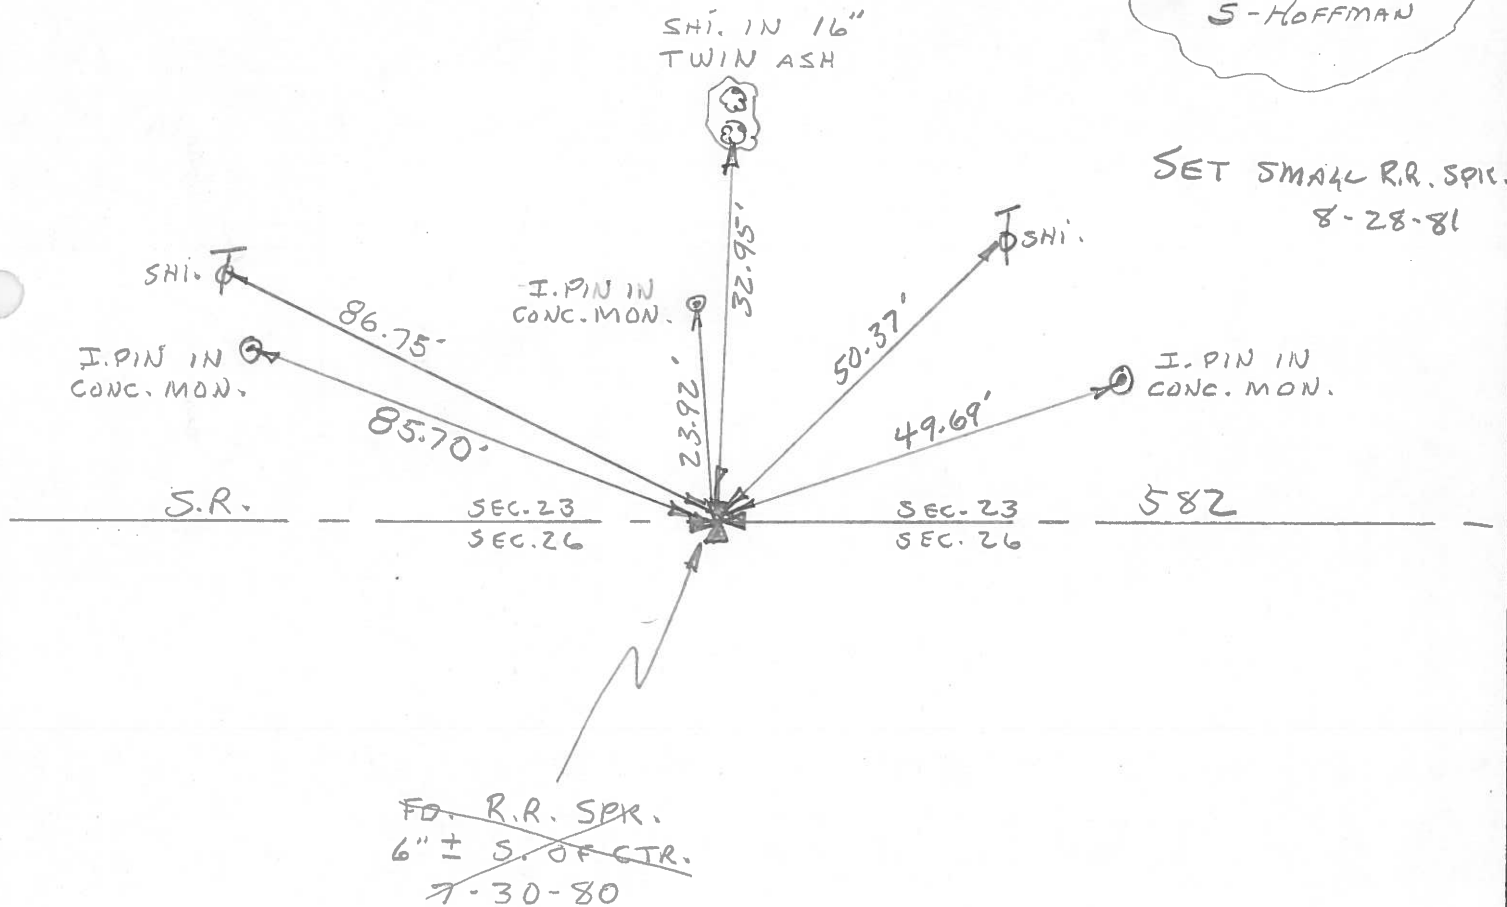

PERSONNEL	TITLE	PERSONNEL	TITLE	COUNTY	DATE	WEATHER	TEMP.
BURNSIDE				WOOD	11-7-74	CLEAR	+52°
SMITH				S. R. 582			
BOWERS				SEC. 1/4 COR. SEC. 23, 26			
MEAD							

DESCRIPTION CONTROL TIES LEFT CENTER LINE RIGHT JOB NO. _____

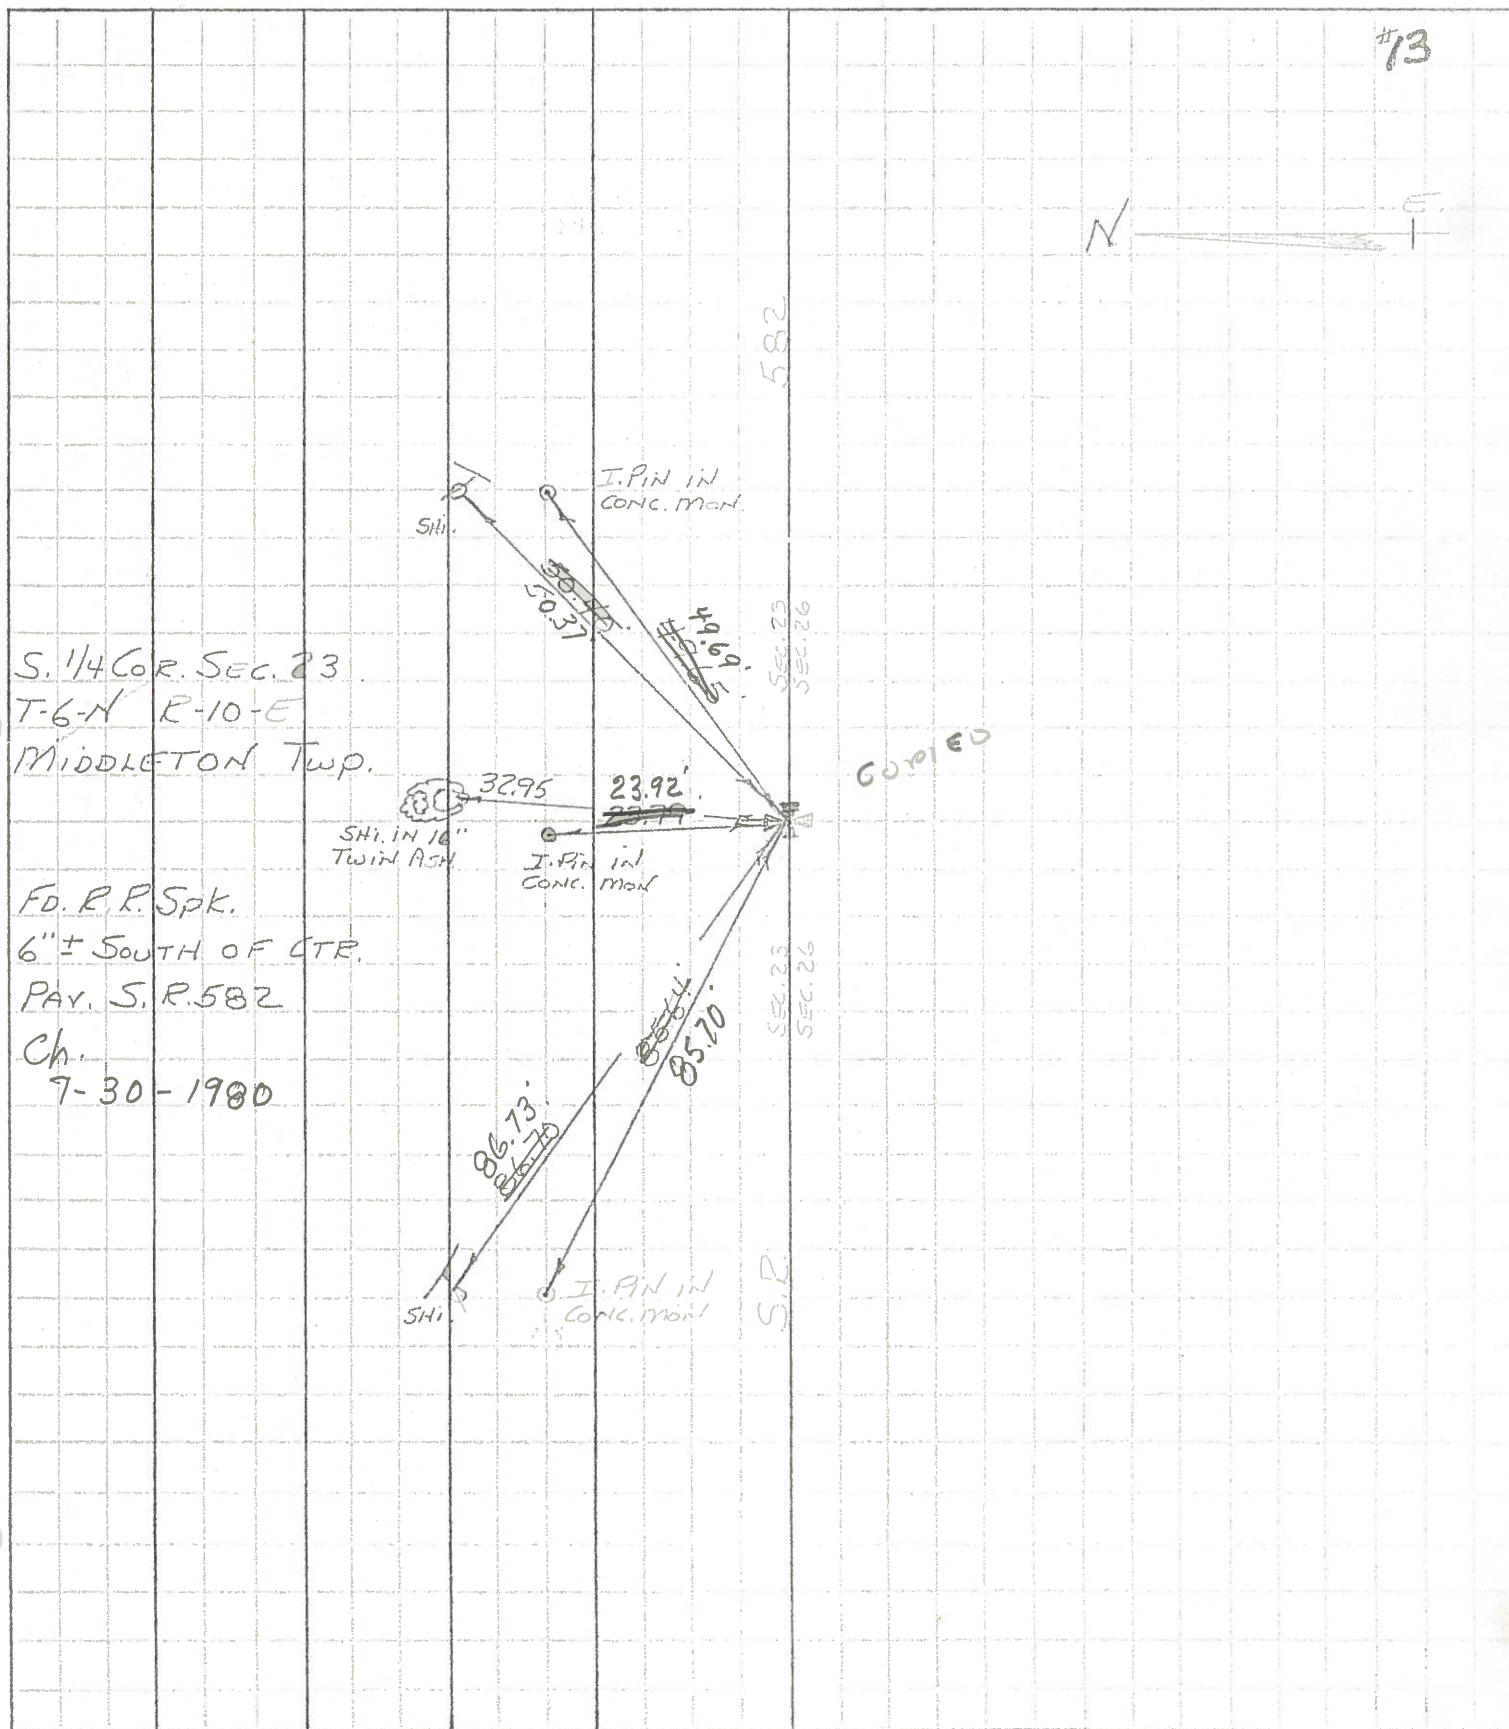

PERSONNEL	TITLE	PERSONNEL	TITLE
BURNSIDE			
SMITH			
BOWERS			
MEAD			

COUNTY WOOD DATE 11-7-74
 S. R. 582 WEATHER CLEAR
 SEC. 1/4 COR. SEC. 23, 26 TEMP. +52°

DESCRIPTION CONTROL TIES


LEFT

CENTER LINE

RIGHT

JOB NO.

#13

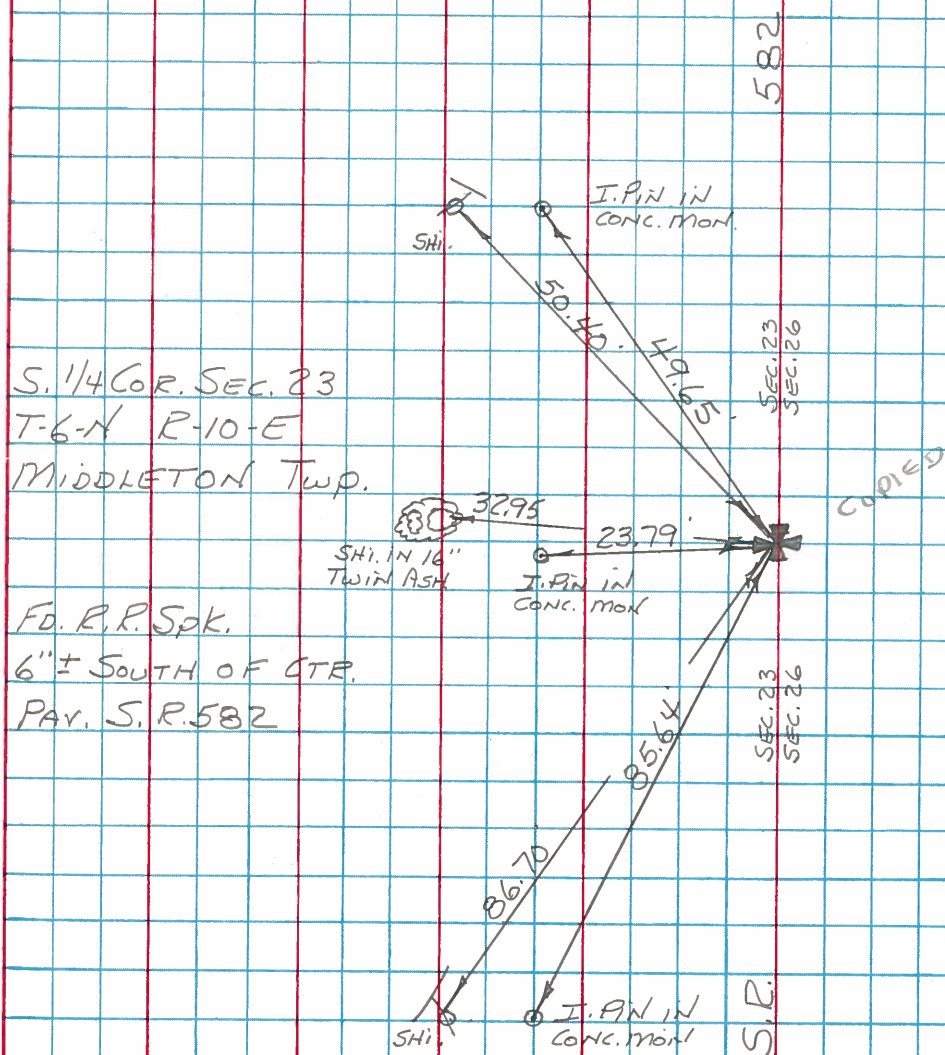


203+16
138+04
65.12

SHEET NO. 2

PERSONNEL	TITLE	PERSONNEL	TITLE	COUNTY	DATE
Schneider				Wood	
Barbour				S. R. 582	WEATHER
Redding				SEC. 0	TEMP.
Bofts					

DESCRIPTION Ties + 1 2 3 JOB NO.

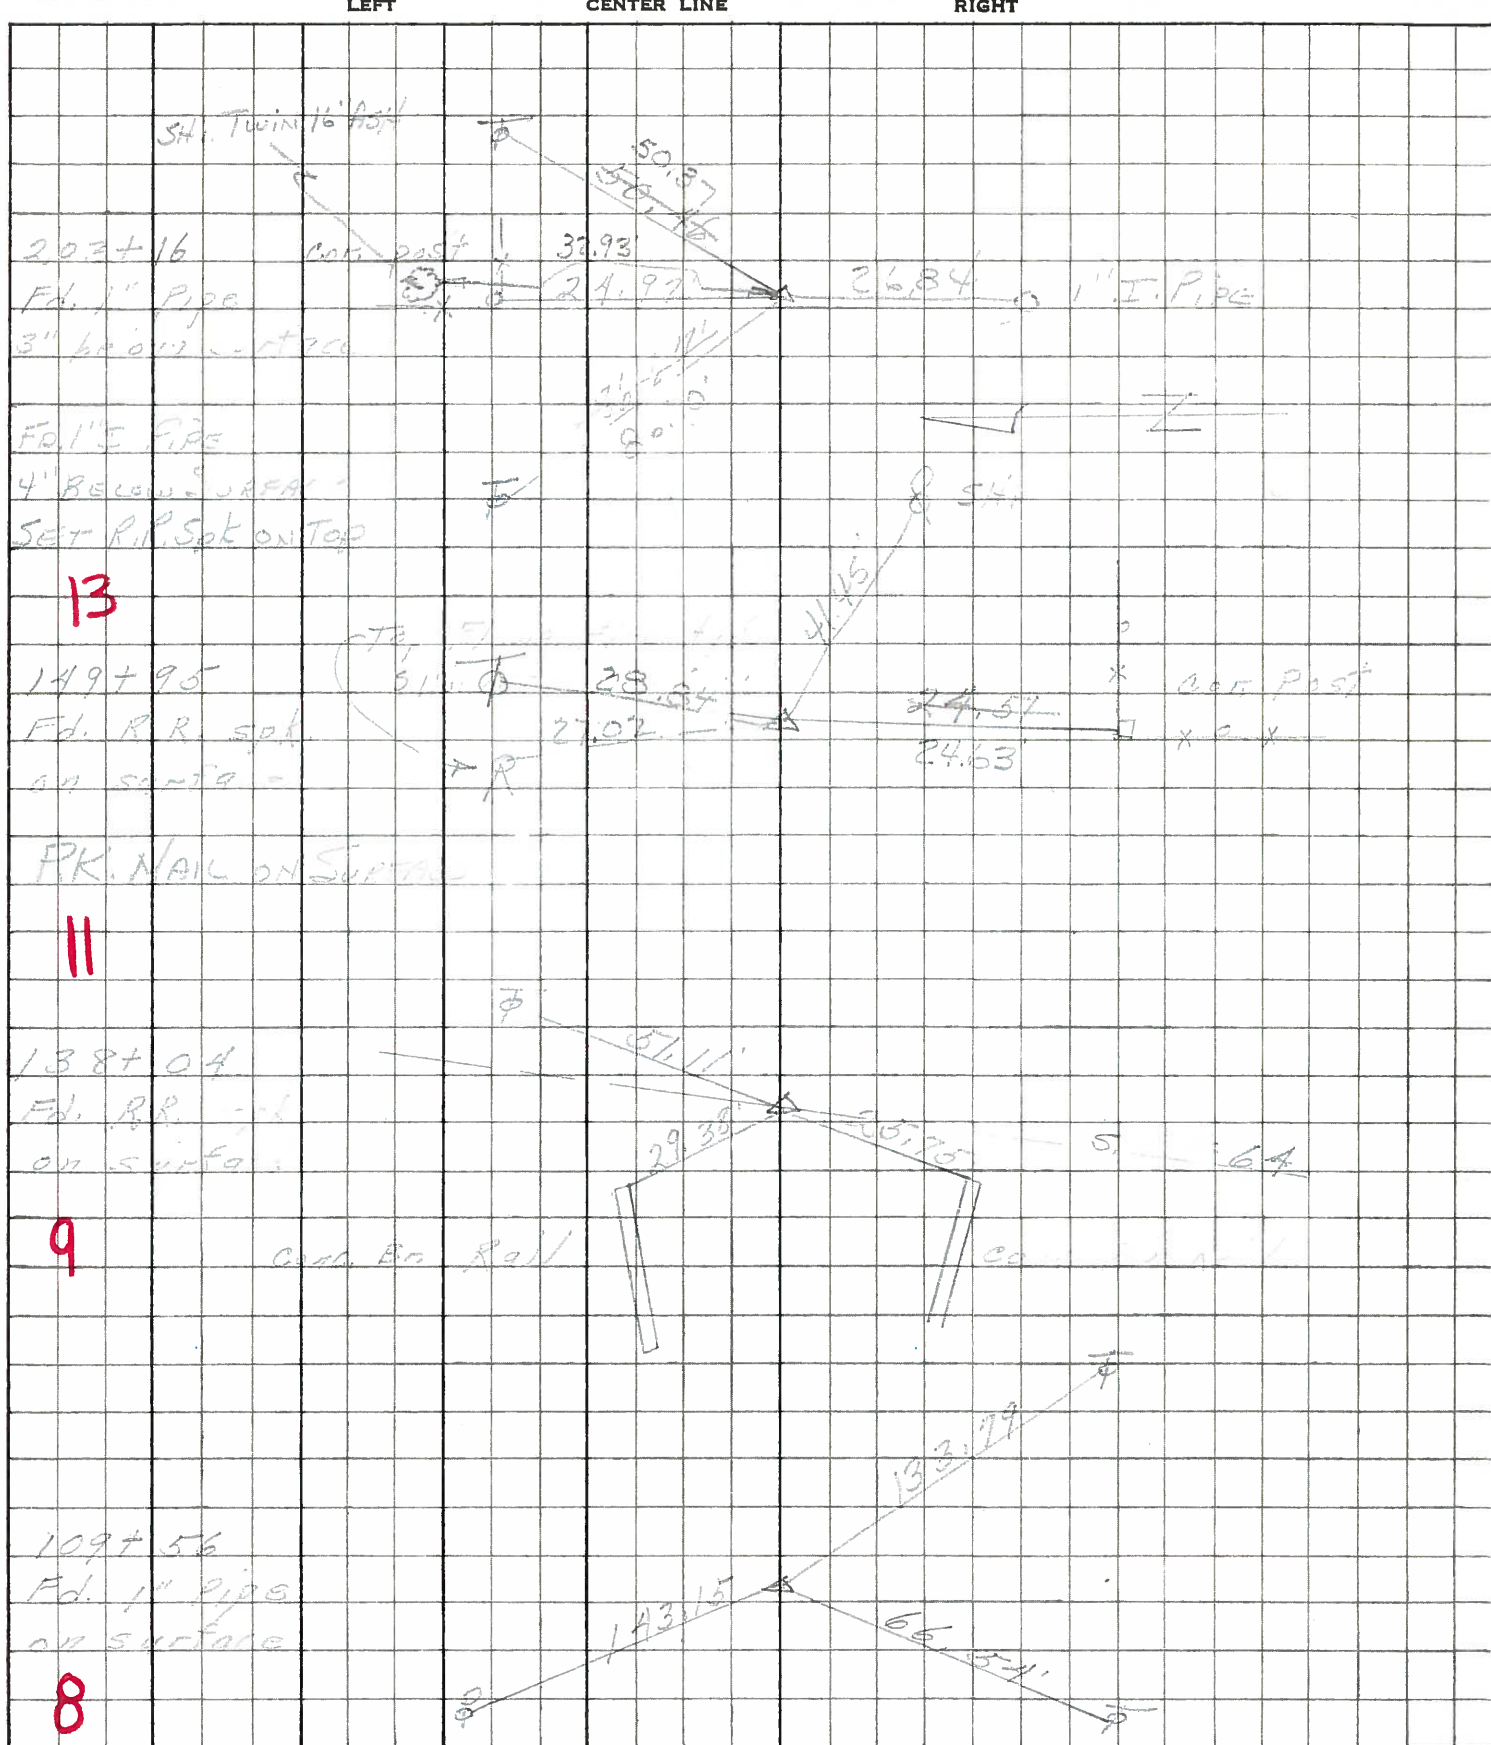

191

SHEET NO. 3

PERSONNEL TITLE PERSONNEL TITLE

COUNTY Wood

DATE 12-27-57

Smorden 4-4-60

S. R. #582

WEATHER

SEC.

TEMP.

DESCRIPTION

LEFT


CENTER LINE

RIGHT

JOB NO.

N. 1/4 of sec. 26
Middleton twp.
Iron pipe

15' twin
Ash

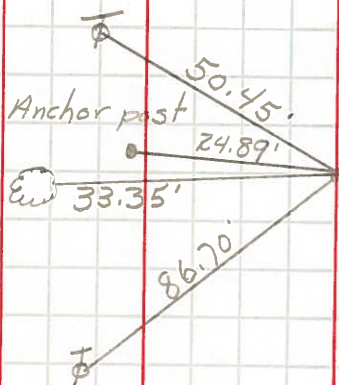

O.K.

13

#442

Hull Prairie Rd.
Stone - Iron pin - on line
with W. edge of pav't.
to S. & with S. edge of
pav't. to E.

stonewit.

O.K.

Pin wit.

Angle about	N.W.	16.50'
Angle about	S.W.	15.20'
Inside cor. conc. railing	S.W.	14.30'
S.E. cor. br. curb	N.W.	23.0'
Shiner in T.P.	N.E.	34.70'

14

#442-A

Pargill's Rd.
Ed. iron pipe

O.K.

Shiner in power brace pole	S.W.	24.45'
Shiner in T.P.	28.35' S.E.	28.46'
S.W. cor. N. culvert	N.W.	28.26'
E. cor. of wingwall	N.E.	23.50'
Shiner in Brace Pole	S.W.	24.75'
Shiner in Tele. Pole	N.E.	70.20'

16

#444