

# O.D.O.T. DISTRICT 2 SURVEY OFFICE (USE ONLY)

PERSONNEL

REFERENCE NO. 15

SHEET 17 OF 25

NOTES MILLER  
H.C. MILLER  
R.C. BARRIERE  
BLUBAUGH

DATE 8/6/24  
WEATHER CLOUDY  
TEMP. 75°

ROUTE SR 582  
COUNTY WOOD  
TOWNSHIP MIDDLETON  
SECTION 25

DWG BY BARRIERE PID 114849

T 6 N R 10 E

TYPE MONUMENT MAG/WASHER

~~ON SURFACE~~ - BELOW 0.5"

OFFSET Q PAVEMENT 8.0' ~~LT~~ : RT

2' TO RT EDGE PAVEMENT

STATION: 229+64

HORIZ.DATUM: NAD83 (2011)


GEOID: 18

GRID: NORTHING: 655110.046

EASTING: 1647860.010

LDP: NORTHING: 476891.512


EASTING: 158606.568

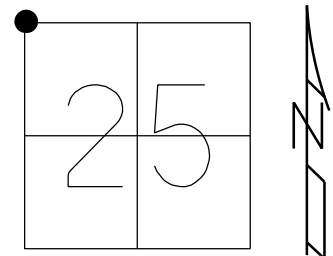

RS.#14028

FD N/SHI  
SE/S

SET N/SHI  
SW/S

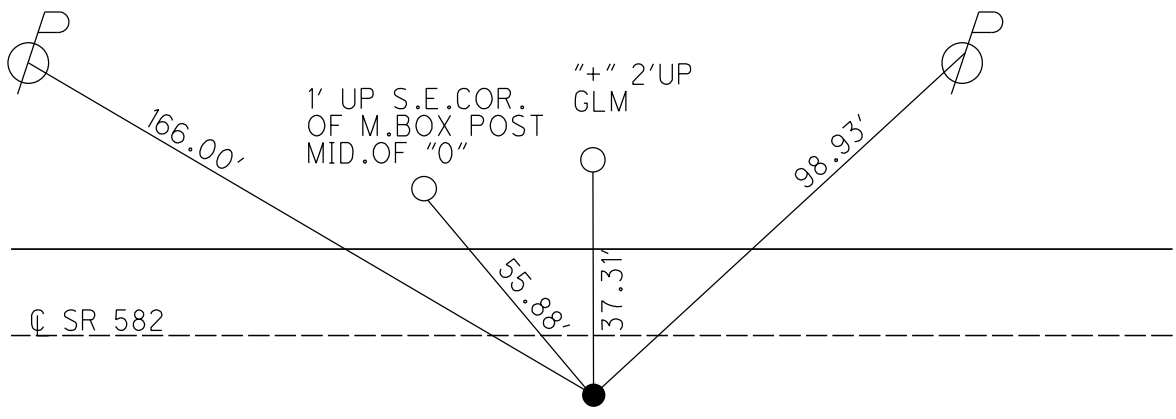


SET MAG/WASHER  
7/30/04, MC  
FND MAG/WASHER  
GPS, REF15  
3/14/14, DCH  
SET MAG/WASHER  
GPS, NEWREF15  
7/29/14, EBW  
FD MAG/WASH  
REF15  
12/8/23, JAM  
FD TONE, DID NOT UNCOVER  
8/6/24, JAM

# O.D.O.T. DISTRICT 2 SURVEY OFFICE (USE ONLY)

|                    |                         |                              |
|--------------------|-------------------------|------------------------------|
| PERSONNEL          | REFERENCE NO. <u>15</u> | SHEET <u>17</u> OF <u>25</u> |
| NOTES              | DATE <u>4/9/14</u>      | ROUTE <u>SR 582</u>          |
| H.C. <u>ROUSOS</u> | WEATHER <u>CLEAR</u>    | COUNTY <u>WOOD</u>           |
| R.C. <u>HOMAN</u>  | TEMP. <u>45°</u>        | TOWNSHIP <u>MIDDLETON</u>    |
| <u>GABLE</u>       |                         | SECTION <u>25</u>            |
|                    |                         | T <u>6</u> N R <u>10</u> E   |

TYPE MONUMENT MAG/WASHER  
 ON SURFACE - ~~BELOW~~ ON  
~~LEFT~~ - Q PAV'T - RIGHT 8.0'  
2.0' TO RT EDGE PAVEMENT  
 S.L.M. 229+64

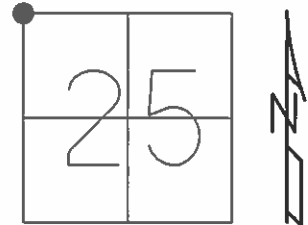

Grid: Northing: 655110.046 Easting: 1647860.010

RS.#14028

SET N/SHI  
SE/S



165.98'

1' UP S.E.COR.  
OF M.BOX POST  
MID.OF "0"



55.79'

Q SR 582

SET N/SHI  
SW/S



96.89'

SET MAG/WASHER  
7/30/04, MC

FND MAG/WASHER  
GPS, REF15  
3/14/14, DCH

SET MAG/WASHER  
GPS, NEWREF15  
7/29/14, EBW

# O.D.O.T. DISTRICT 2 SURVEY OFFICE

PERSONNEL

REFERENCE NO. 15

SHEET 14 OF 23

NOTES M.L.

H.C. M.B.

R.C. M.L.

DATE 4-26-04

WEATHER pt cloudy

TEMP. + 55°

ROUTE S.R. 582

COUNTY WOOD

TOWNSHIP MIDDLETON

SECTION 25

T 6 N R 10 E

Drawn (Joe Kolehmainen)


TYPE MONUMENT P.K./washer

ON SURFACE - ~~BELOW~~ Yes

~~LEFT~~ - & PAVT. RIGHT 8.0' RT


2.0 TO RT. EDGE PAVEMENT

S.L.M. 229+64

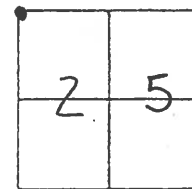

Reset Mag  $\frac{1}{2}$  Washer  
7/30/04

MB

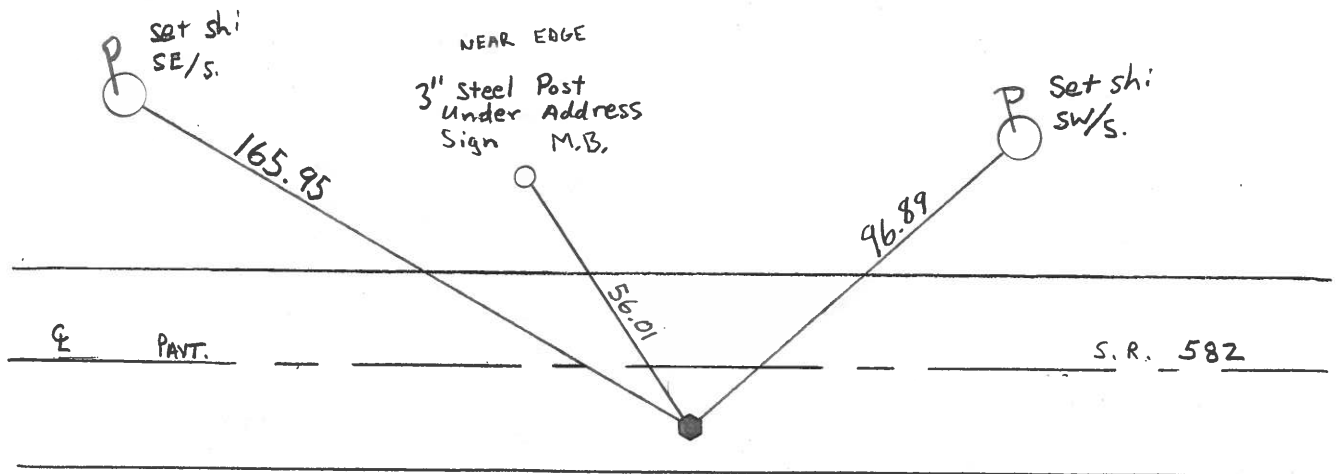

# O.D.O.T. DISTRICT 2 SURVEY OFFICE

PERSONNEL

REFERENCE NO. 15

SHEET      OF     

NOTES BARNHISEL

H.C. HOFFMAN

R.C. Lochake

DATE 9-6-89

WEATHER P+ cloudy

TEMP. +70°

ROUTE S.E. 582

COUNTY Wood

TOWNSHIP Middleton

SECTION 25

T. 6 N. R. 10 E.


TYPE MONUMENT Sm RR Spk

ON SURFACE - ~~BELOW~~ yes


LEFT - ~~C~~ PAV'T. - RIGHT 6.6

3.3 TO R+ EDGE PAVEMENT

S.L.M. 229 + 62.81

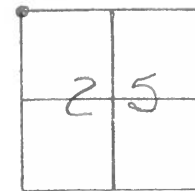


Set PK & Washere  
11-8-89  
YMB

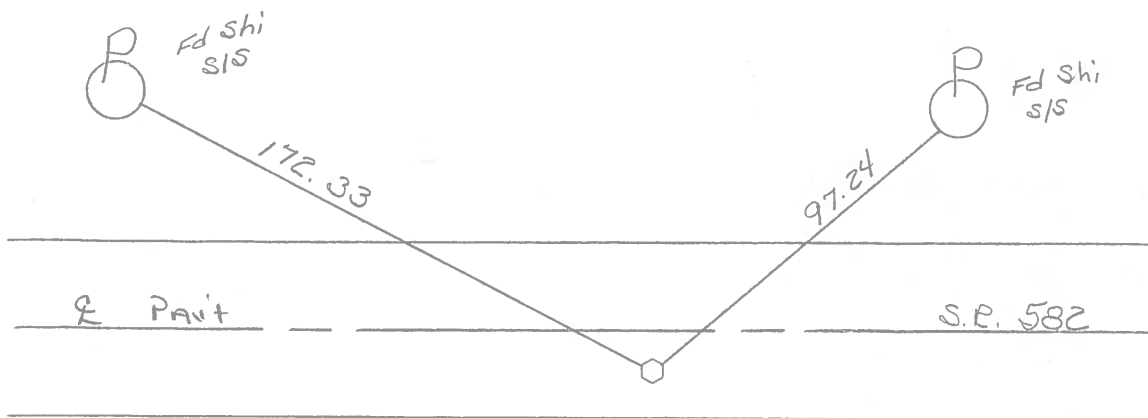


County WOOD S.R. 582Date 11-19-81Township MIDDLETONWeather overcastSection 25Temp. +45°T<sub>6</sub>N, R<sub>10</sub>EPersonnel HOFFMANHouseholderLoehrke

#15

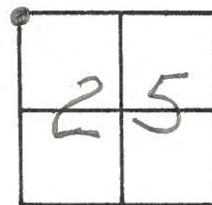

Fd. R.R. SPK 4 1/2" below surface  
6.6' S. of & Pavt 582  
4.4' N. of S.F.P.

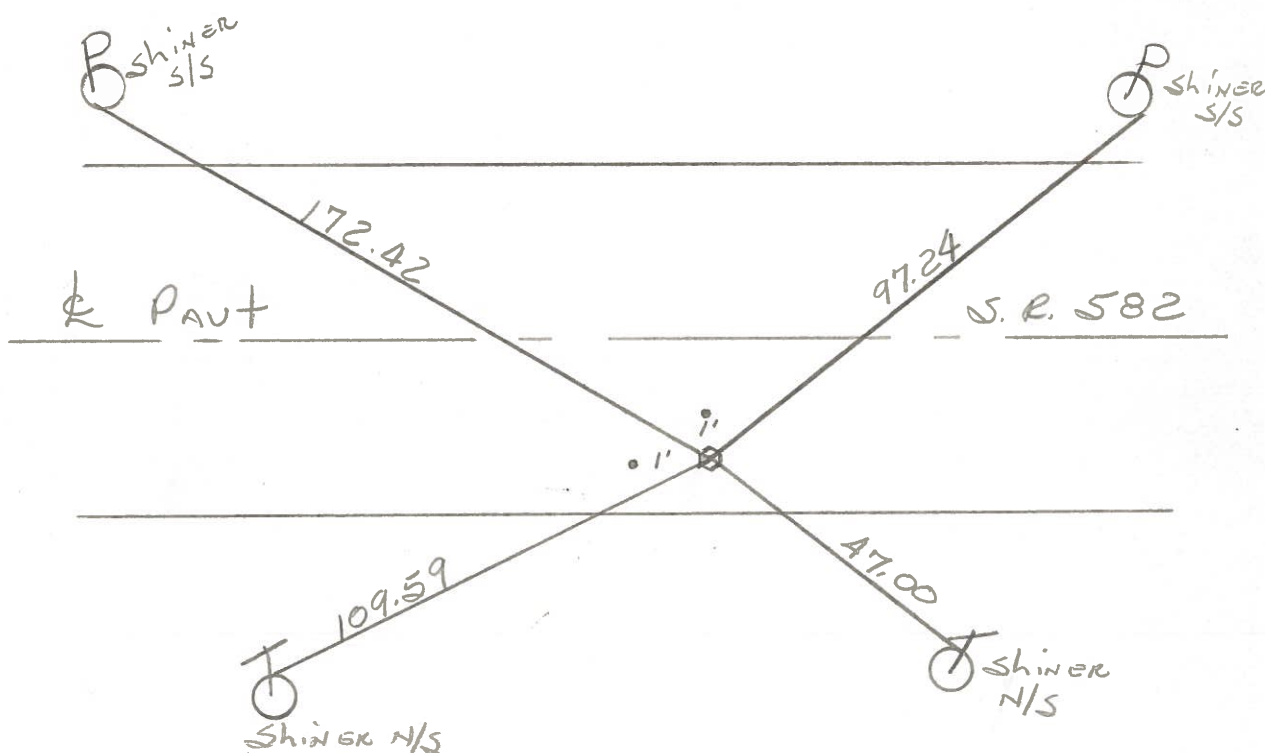

Set small R.R. SPK @ SURFACE 11-19-81