

O.D.O.T. DISTRICT 2 SURVEY OFFICE (USE ONLY)

PERSONNEL

REFERENCE NO. 24

SHEET 1 OF 21

NOTES JAMES

DATE 4/23/19

ROUTE SR 582

H.C. LEU

WEATHER WINDY

COUNTY WOOD

R.C. JAMES

TEMP. 67°

TOWNSHIP MIDDLETON

SECTION 28

DWG BY BALBAUGH

PID 81000

T 6 N R 11 E

TYPE MONUMENT MAG NAIL

ON SURFACE - ~~BELOW~~ ON

OFFSET $\mathcal{C}$ PAVEMENT 8.8' ~~LT~~ : RT

0.8' TO RT EDGE PAVEMENT


STATION: 398+30.01

HORZ.DATUM: NAD83 (2011)


GEOID: 2012A

GRID: NORTHING: 654471.348

EASTING: 1664657.649

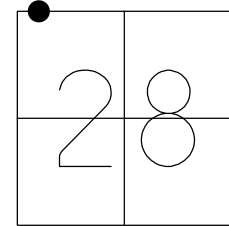

RECORD:
FD P.K./WASHER
4/14/05, MC
SET MAG/WASHER
8/23/05, MDB
FD MAG/WASHER
REF24
4/14/15, JLL
SET MAG/WASHER
4/8/20, JLL

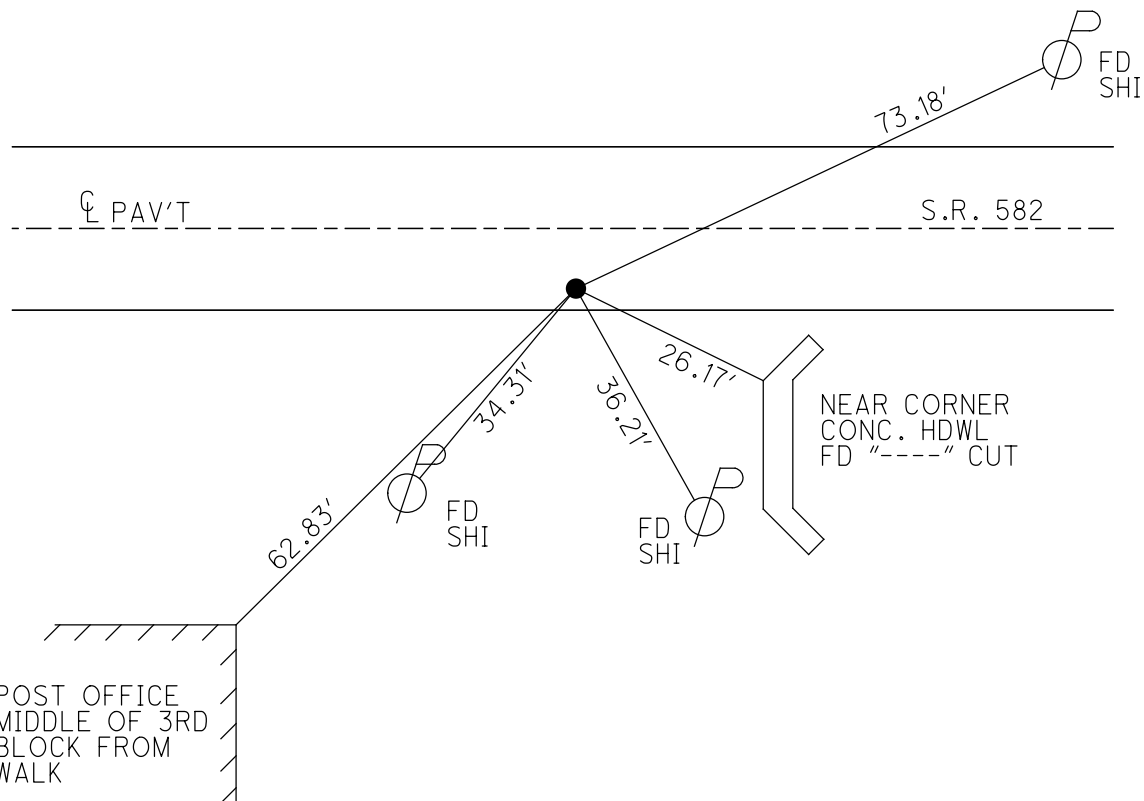

O.D.O.T. DISTRICT 2 SURVEY OFFICE

PERSONNEL

REFERENCE NO. 24

SHEET 1 OF 20

NOTES BARNHISEL

DATE 04/15/05

ROUTE S.R. 582

H.C. CANTERBURY

WEATHER CLEAR

COUNTY WOOD

R.C. BARNHISEL

TEMP. +45°

TOWNSHIP MIDDLETON

SECTION 28

T 6 N R 11 E

TYPE MONUMENT PK NAIL/WASHER

ON SURFACE - ~~BELOW~~ YES


~~LEFT~~ Q PAV'T - RIGHT 8.8'

0.8' TO RT EDGE PAVEMENT

S.L.M. 398+39

GRID: NORTHING:

EASTING:

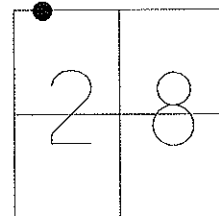

RESET MAG NAIL & WASHER
08/23/05
MDB

FD SHI.
SE/S



66.48'

Q PAV'T

FD SHI.
SW/S



73.18'

S.R. 582

26.21'

62.87'

34.28'

FD SHI.
N/S




36.24'

NEAR CORNER
CONC. HDWL
FD "-----" CUT

SET SHI.
SW/S



POST OFFICE
BETWEEN 3RD-
4TH BLOCK

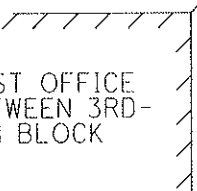

O.D.O.T. DISTRICT 2 SURVEY OFFICE

PERSONNEL

REFERENCE NO. 24

SHEET 1 OF 21

NOTES BARNHISEL

DATE 04/15/05

ROUTE S.R. 582

H.C. CANTERBURY

WEATHER CLEAR

COUNTY WOOD

R.C. BARNHISEL

TEMP. +45°

TOWNSHIP MIDDLETON

SECTION 28

T 6 N R 11 E


TYPE MONUMENT PK NAIL / WASHER

ON SURFACE ~~- BELOW~~ YES


~~LEFT~~ - Q PAV'T - RIGHT 8.8'

0.8' TO RT EDGE PAVEMENT

S.L.M. 398+39

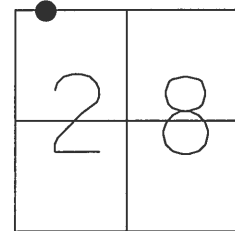

RESET MAG NAIL & WASHER
08/23/05
MDB

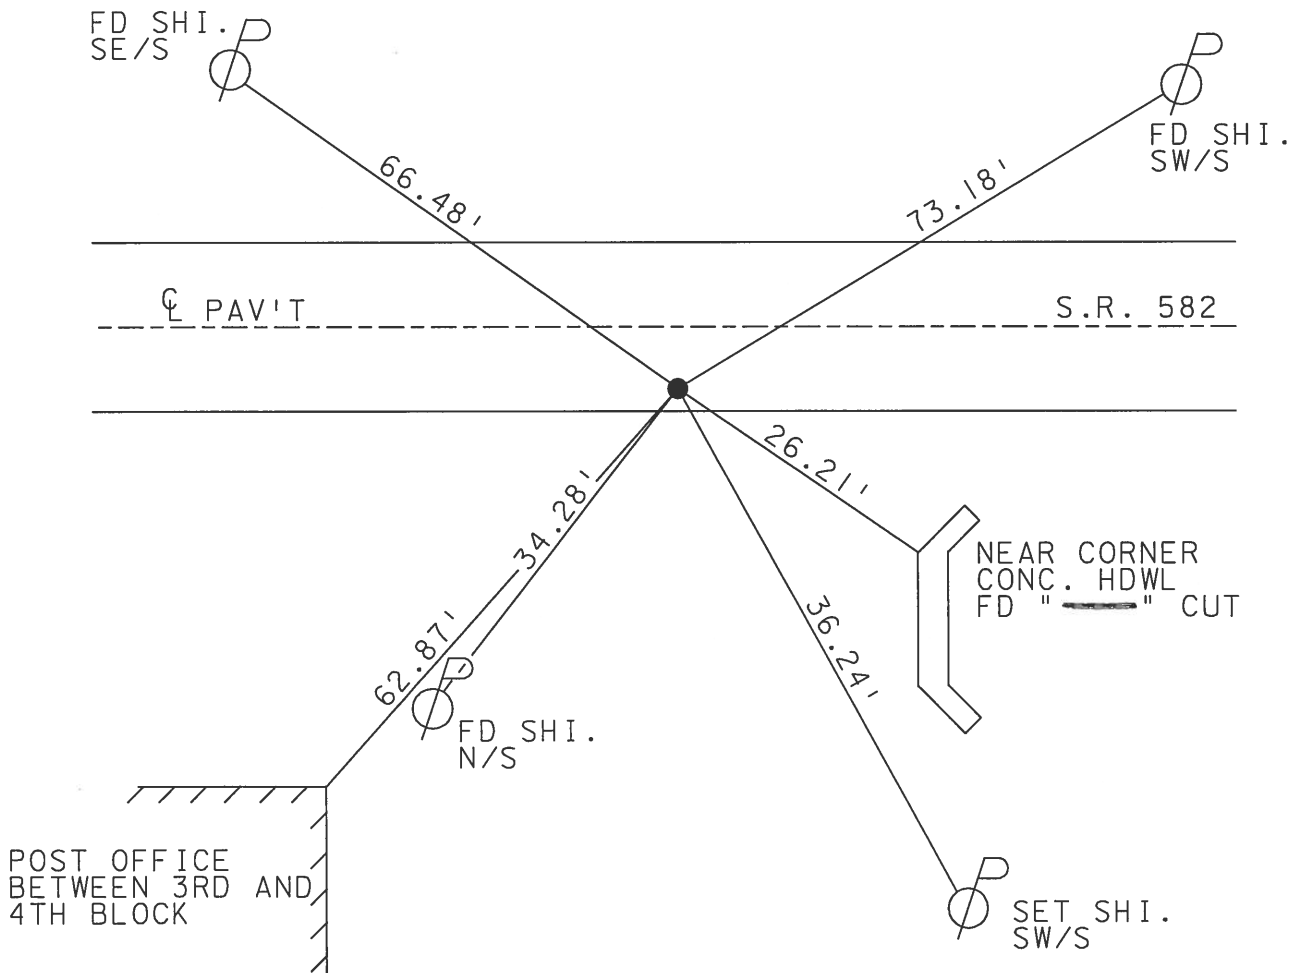

O.D.O.T. DISTRICT 2 SURVEY OFFICE

PERSONNEL

REFERENCE NO. 24

SHEET _____ OF _____

NOTES LOENRKE

H.C. HOFFMAN

R.C. STEINHAYSER

BARNHISEL

DATE 7-12-90

WEATHER cloudy

TEMP. + 65°

ROUTE S.R. 582

COUNTY Wood

TOWNSHIP MIDDLETON

SECTION 78

T 6 A B 11 E


TYPE MONUMENT P.K. Na; 1

ON SURFACE - BELOW Yes


LEFT - & PAW'T. - RIGHT 8.8

0.8 TO R+ EDGE PAVEMENT

S.L.M. 398 + 39

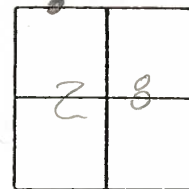

SET P.K./Washer
10-25-90
MB

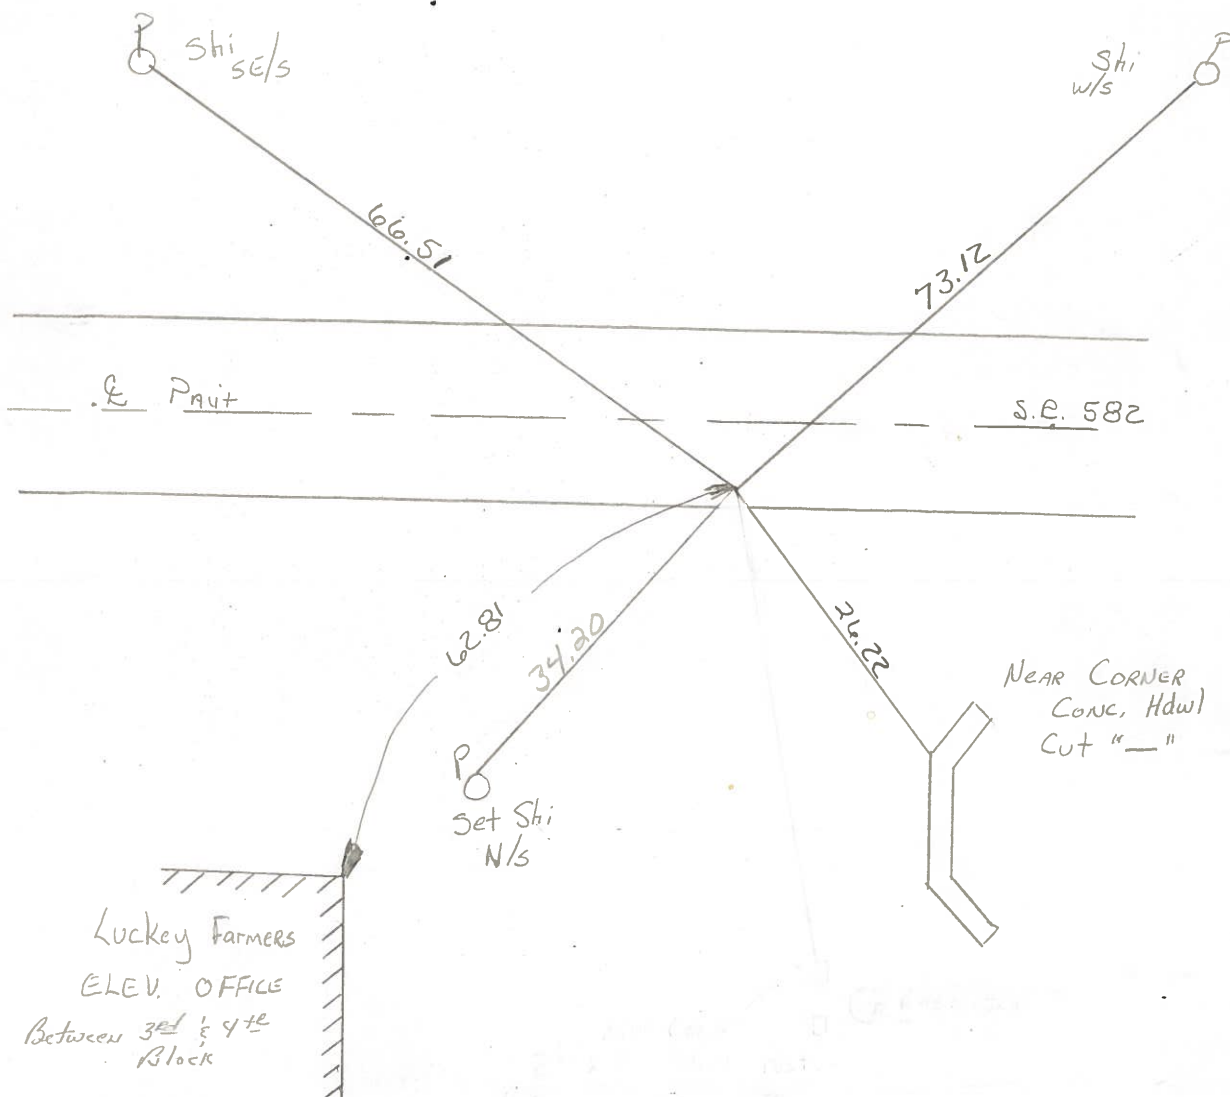

Q.D.O.T. DISTRICT 2 SURVEY OFFICE

SHEET 1 OF 34

County Wood S.R. 582

Township Middleton

Section 28

T N, R E

Personnel I. Stone

P. Neuser


R. Michalak

D. Curtis


Date 13 July 83

Weather Warm

Temp. 85

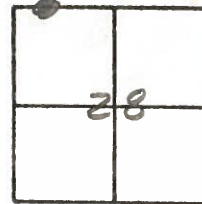

24

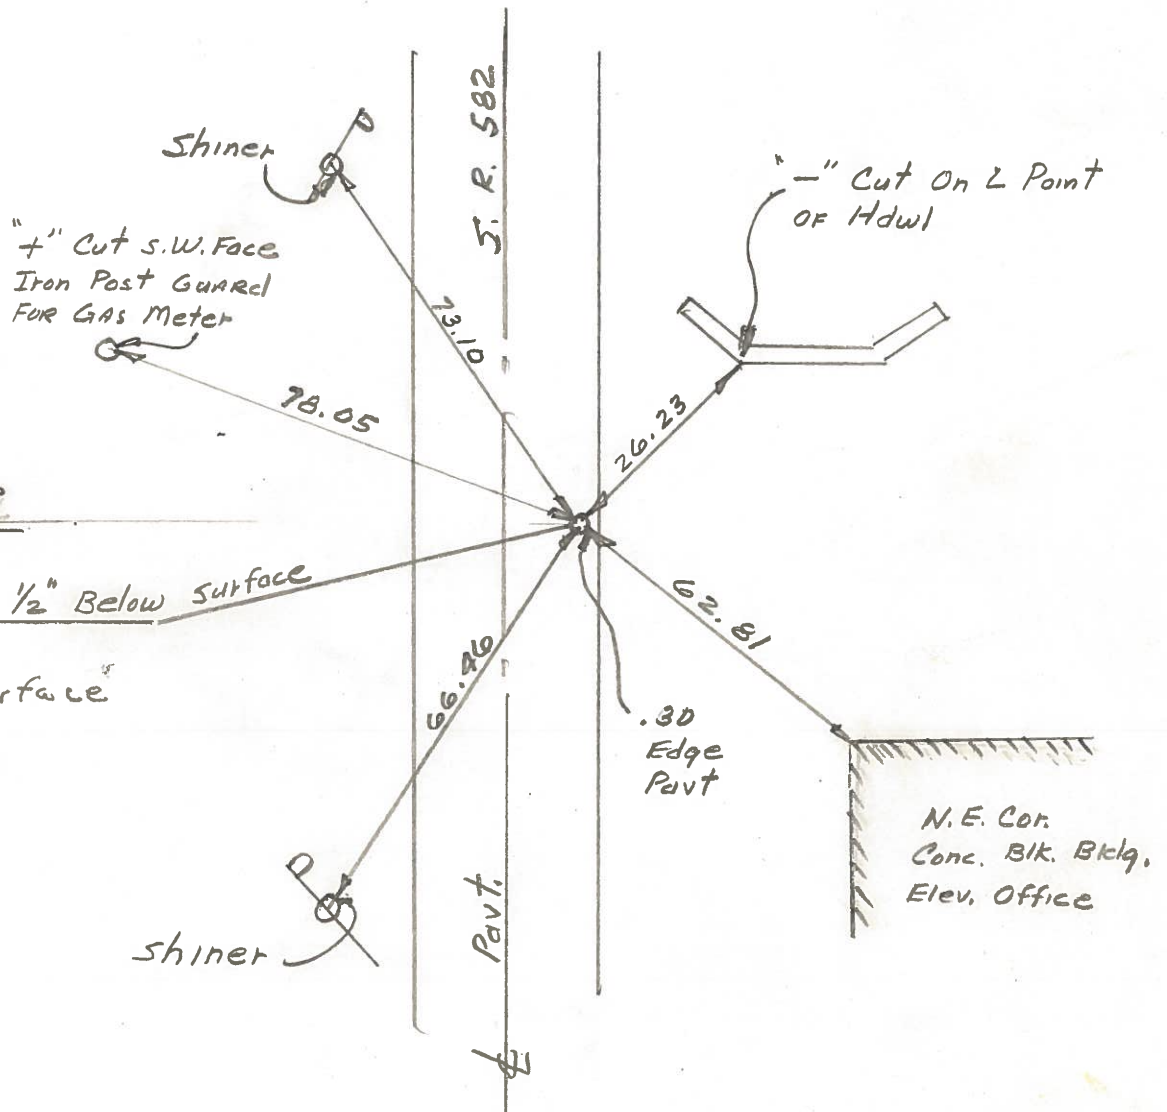

Sta. 398 + 59

Fd. P.K. Nail 1/2" Below surface

P.K. nail to surface

Q.D.O.T. DISTRICT 2 SURVEY OFFICE

SHEET 1 OF 34

County Wood S.R. 582

Township Middleton

Section 28

T N, R E

Personnel 1. Stone

P. Neuser


R. Michalak

D. Curtis


Date 13 July 83

Weather Warm

Temp. 85

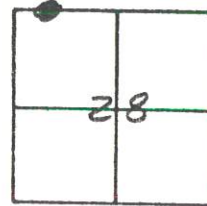

24

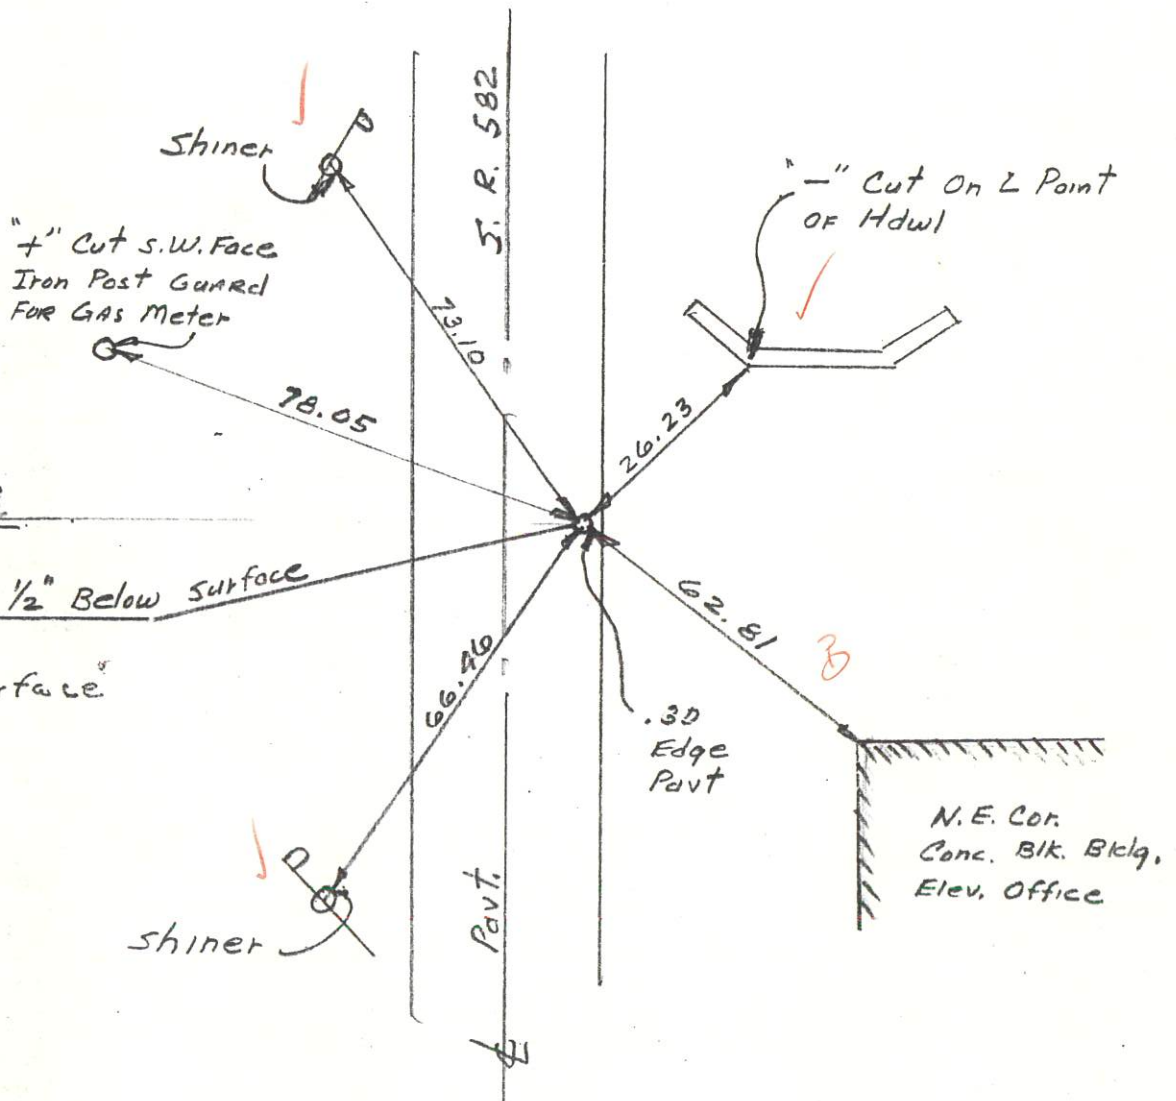

Q.D.O.T. DISTRICT 2 SURVEY OFFICE

SHEET _____ OF _____

County Wood S.R. 582

Township Middleton

Section 28

T6N, R11E

Personnel Hoffman

#24


F

Crew

Date 5-6-82

Weather clear - windy

Temp. +75°

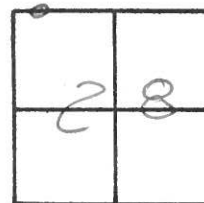

Fd. P.K. Nail 1/2" below surface

9.0' Rt. of & PAUT

0.7' TO S.E.P.

SLM sta ± 397+72

