

O.D.O.T. DISTRICT 2 SURVEY OFFICE

PERSONNEL

REFERENCE NO. 25

SHEET 2 OF 20

NOTES BARNHISEL

DATE 04/15/05

ROUTE S.R. 582

H.C. CANTERBURY

WEATHER CLEAR

COUNTY WOOD

R.C. BARNHISEL

TEMP. +45°

TOWNSHIP MIDDLETON

SECTION 28

T 6 N R 11 E

TYPE MONUMENT PK NAIL/WASHER

ON SURFACE - ~~BELOW~~ YES


~~LEFT~~ - Q PAV'T - RIGHT 7.4'

1.9' TO RT EDGE PAVEMENT


S.L.M. 402+36, 16' west of ctr-line pav't north

GRID: NORTHING:

EASTING:

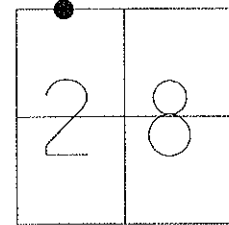

RESET MAG NAIL & WASHER
08/23/05
MDB

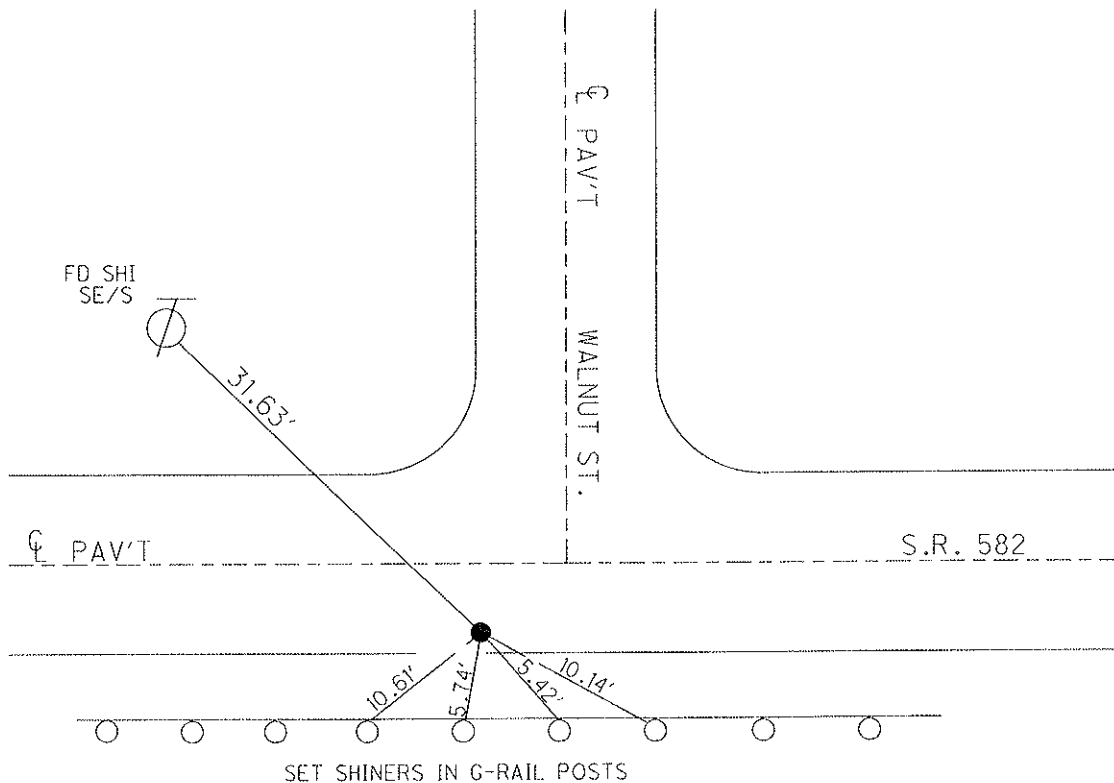

O.D.O.T. DISTRICT 2 SURVEY OFFICE

PERSONNEL

REFERENCE NO. 25

SHEET 2 OF 21

NOTES BARNHISEL

DATE 04/15/05

ROUTE S.R. 582

H.C. CANTERBURY

WEATHER CLEAR

COUNTY WOOD

R.C. BARNHISEL

TEMP. +45°

TOWNSHIP MIDDLETON

SECTION 28

T 6 N R 11 E

TYPE MONUMENT PK NAIL/WASHER


ON SURFACE - ~~BELOW~~ YES

~~LEFT~~ - Q PAV'T - RIGHT 7.4'


1.9' TO RT EDGE PAVEMENT

S.L.M. 402+36

16' west of ctr-line pav't north

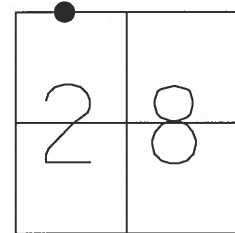

RESET MAG NAIL & WASHER
08/23/05
MDB

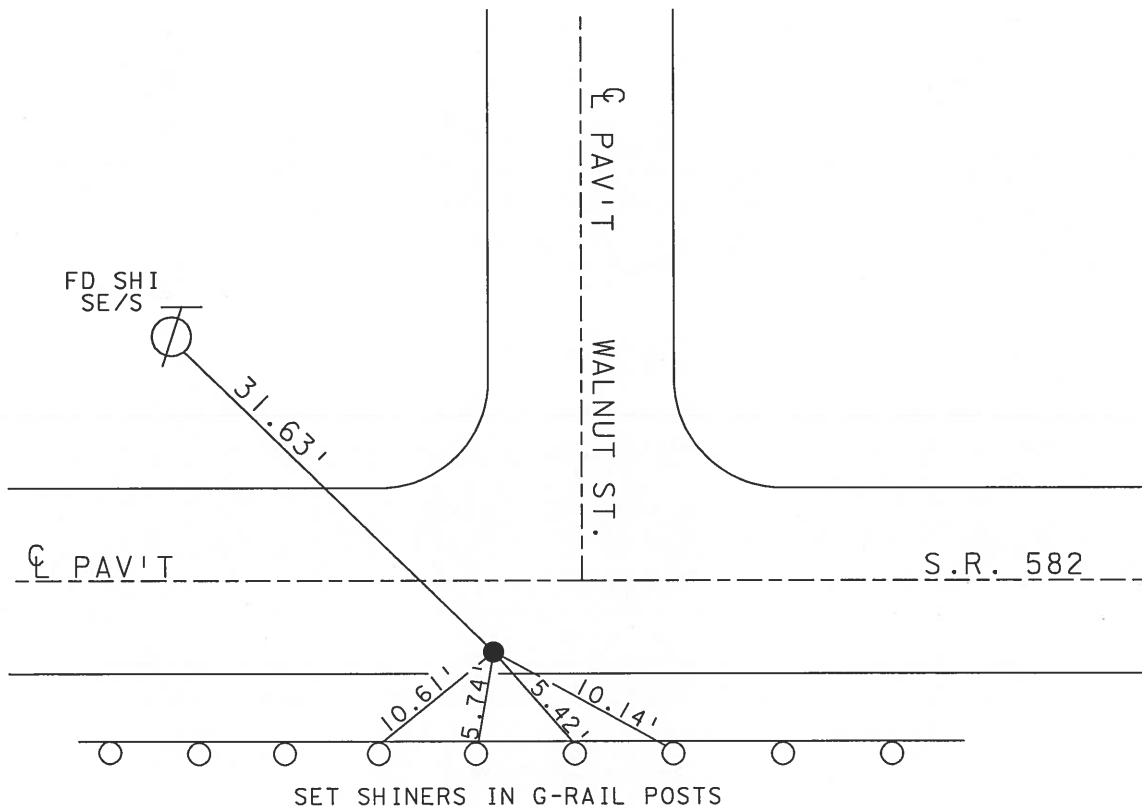

O.D.O.T. DISTRICT 2 SURVEY OFFICE

PERSONNEL

REFERENCE NO. 25

SHEET OF

NOTES Loehake

H.C. HOFFMAN

R.C. STEINHAUSER

BACHMISEL

DATE 7-12-90

WEATHER cloudy

TEMP. +65°

ROUTE S.R. 582

COUNTY WOOD

TOWNSHIP MIDDLETON

SECTION 28

T 6 N R 11 E


TYPE MONUMENT PK Nail

ON SURFACE - BELOW Yes

LEFT - CL PAVT. - RIGHT 6.1


1.7 TO RT EDGE PAVEMENT

S.L.M. 402+36

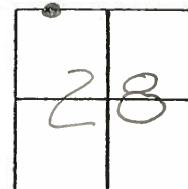

Pt. is "IN LINE" WITH
Power Poles to NORTH.

Set P.K. / Washer
10-25-90
MB

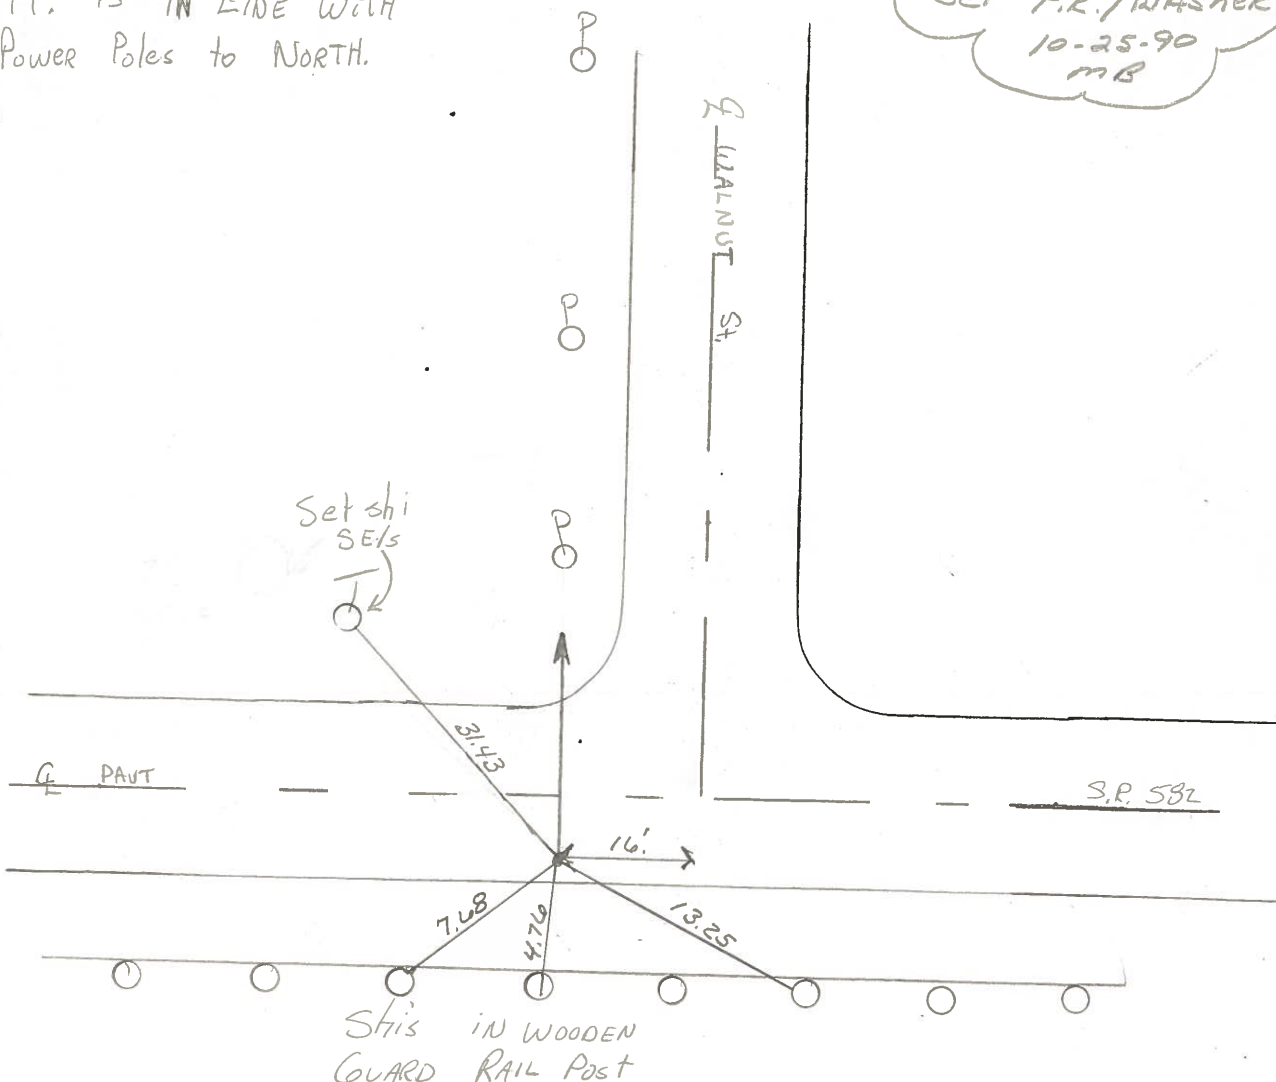

Q.D.O.T. DISTRICT 2 SURVEY OFFICE

SHEET 2 OF 2

County Wood S.R. SB2

Date 13 July 83

Township Middleton


Weather Windy

Section 28

Temp. 85°

T N, R E

Personnel 1. Stone

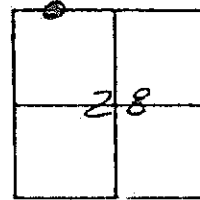


P. Neuse

R. Michalak

D. Curtis

25

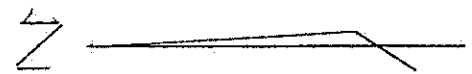

Shiner In
12" Maple

SB2

W Walnut St Pavt 7

91.84

1.90 S. Edge Pavt.

Sta. 402+60 ± f Walnut St W. P/L

Fd. P.K. Nail 2" Below Surface

7.55

Shiner In Guard Rail Pavt

69.61

31.50

Shiner In
15" Cottonwood

Shiner

Pavt.

P.K. nail to surface

PERSONNEL TITLE PERSONNEL TITLE

COUNTY WoodDATE April, 17, 1969S. R. #582WEATHER Pt. Cloudy & WindySEC. From I-75 to SR#199TEMP. +75°


DESCRIPTION

Ties to Control points.JOB NO. 027300

LEFT

CENTER LINE

RIGHT

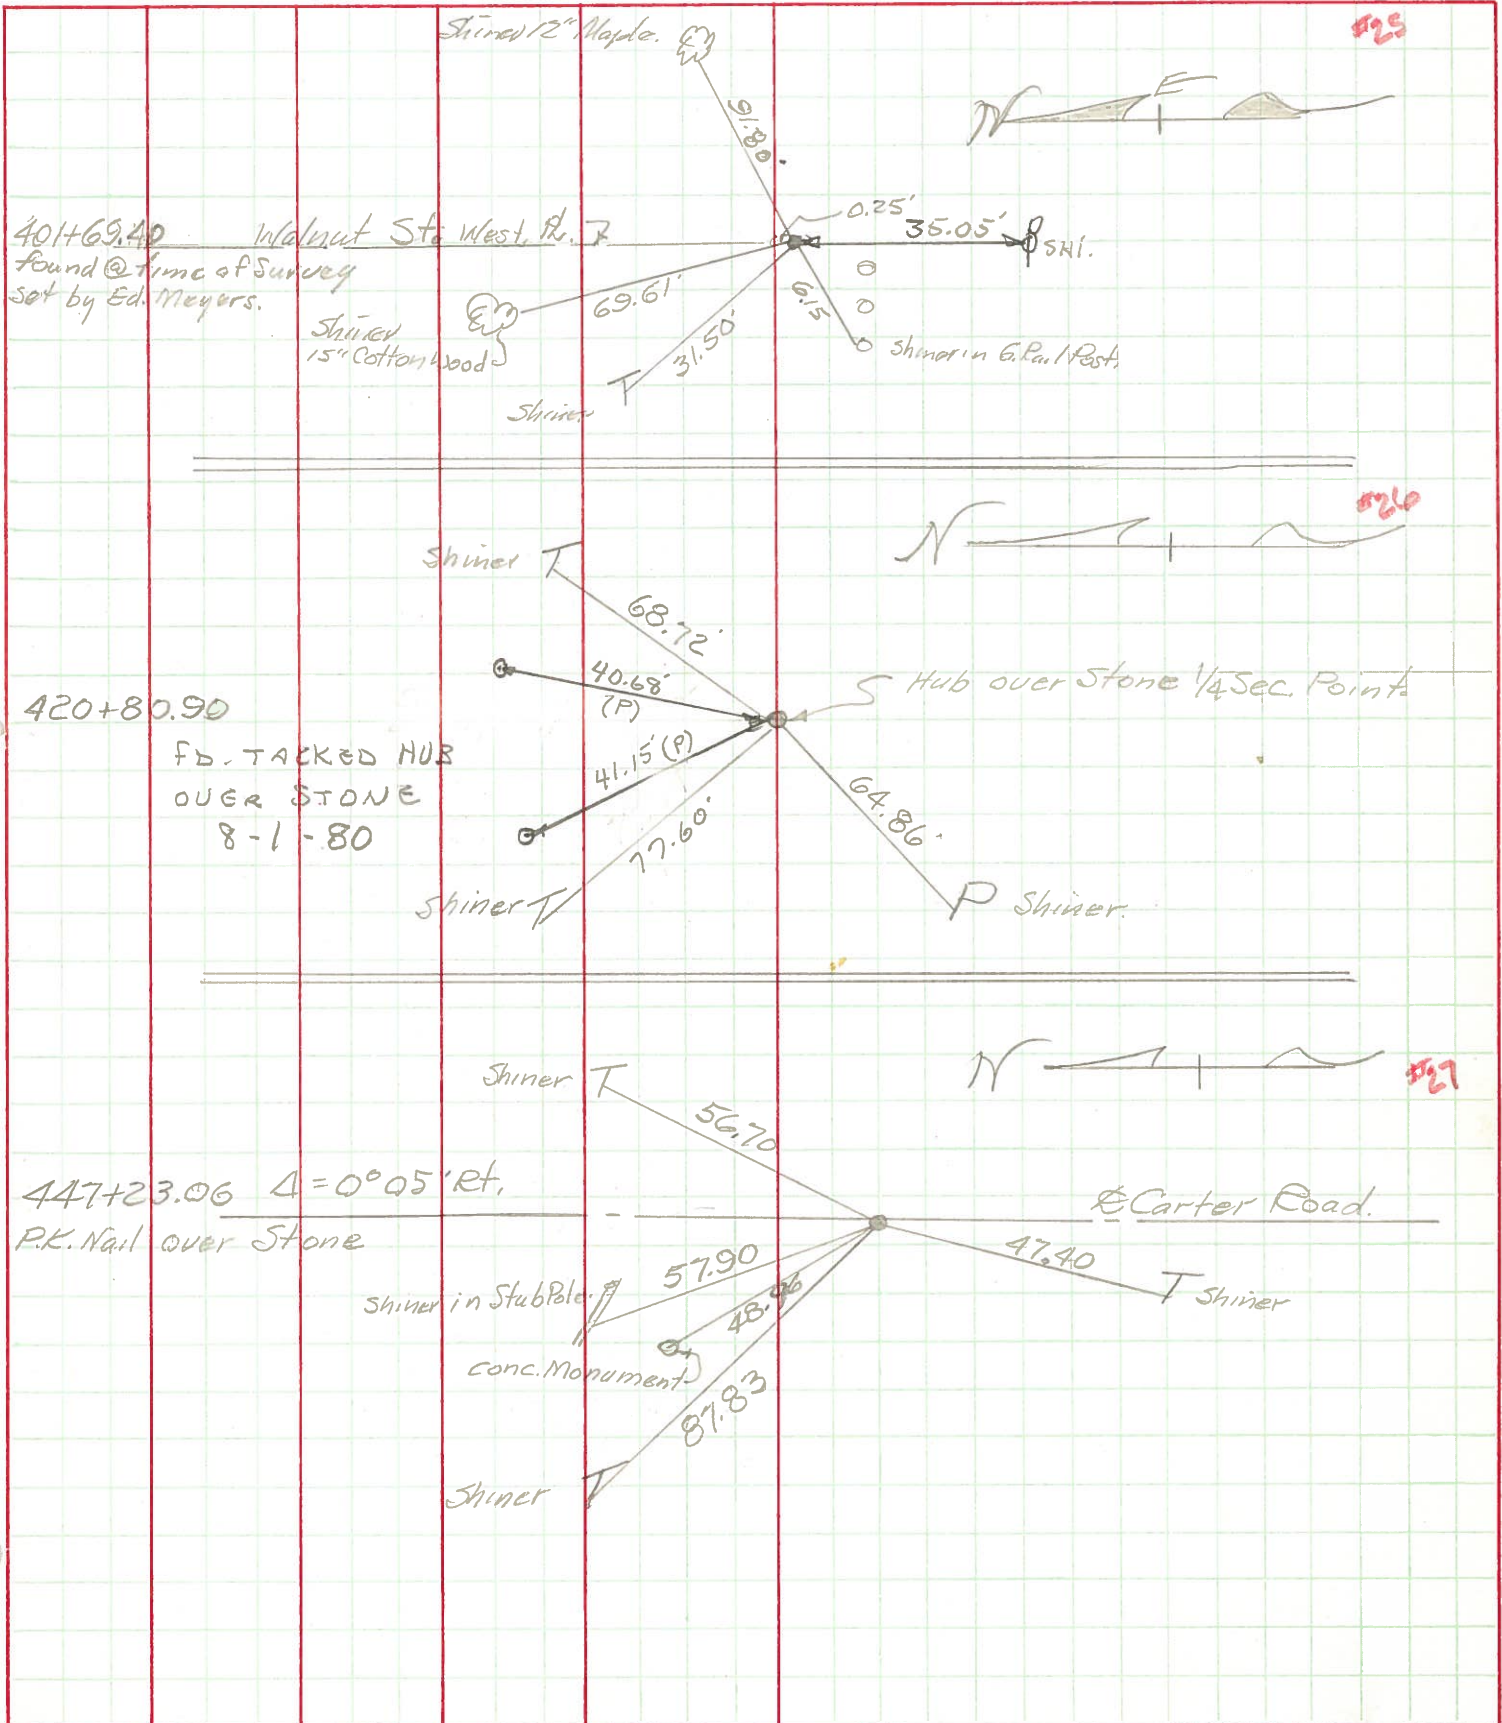

PERSONNEL TITLE PERSONNEL TITLE

Morrison

Holcombe

Smith

Burnside

COUNTY *Wood*

DATE *April 12, 1980*

S. R. # *582*

WEATHER *Pl. Cloudy 6-10*

SEC. *From T-75 to SP#100*

TEMP *47.5°*

DESCRIPTION

Truss to Central station

JOB NO. *027500*

LEFT

CENTER LINE

RIGHT

