

O.D.O.T. DISTRICT 2 SURVEY OFFICE (USE ONLY)

PERSONNEL

REFERENCE NO. 27

SHEET 6 OF 21

NOTES_____NIESE

DATE 12/4/19ROUTE SR 582

H.C. LEU

WEATHER CLOUDY

COUNTY WOOD

R.C. NASON

TEMP. _____

TOWNSHIP MIDDLETONSECTION 28DWG BY BALBAUGH

PID 81000

T_6_N R_11_E

TYPE MONUMENT MAG NAIL OVER BRASS TABLET

ON SURFACE - ~~BELOW~~ ON

OFFSET C PAVEMENT 11.4' ~~17'~~ : RT


____TO____EDGE PAVEMENT

STATION: 447+79.85

HORZ.DATUM: NAD83 (2011)

GEOID: 2012A

GRID: NORTHING: 654344.834

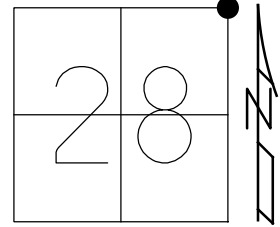EASTING: 1669605.536

RECORD:

SET BRASS TABLET

8/6/93, BVD

FD DRILLH/BRASS TABLET

4/15/05, MC
ED BRACCA TA

FD BRASS TABLET

8/23/05

FD DRILLH/BRASS TABLET
B5507


REF27

4/14/15, JLL

FD DRILLH/BRASS TABLET

REF27

5/8/19, JLL

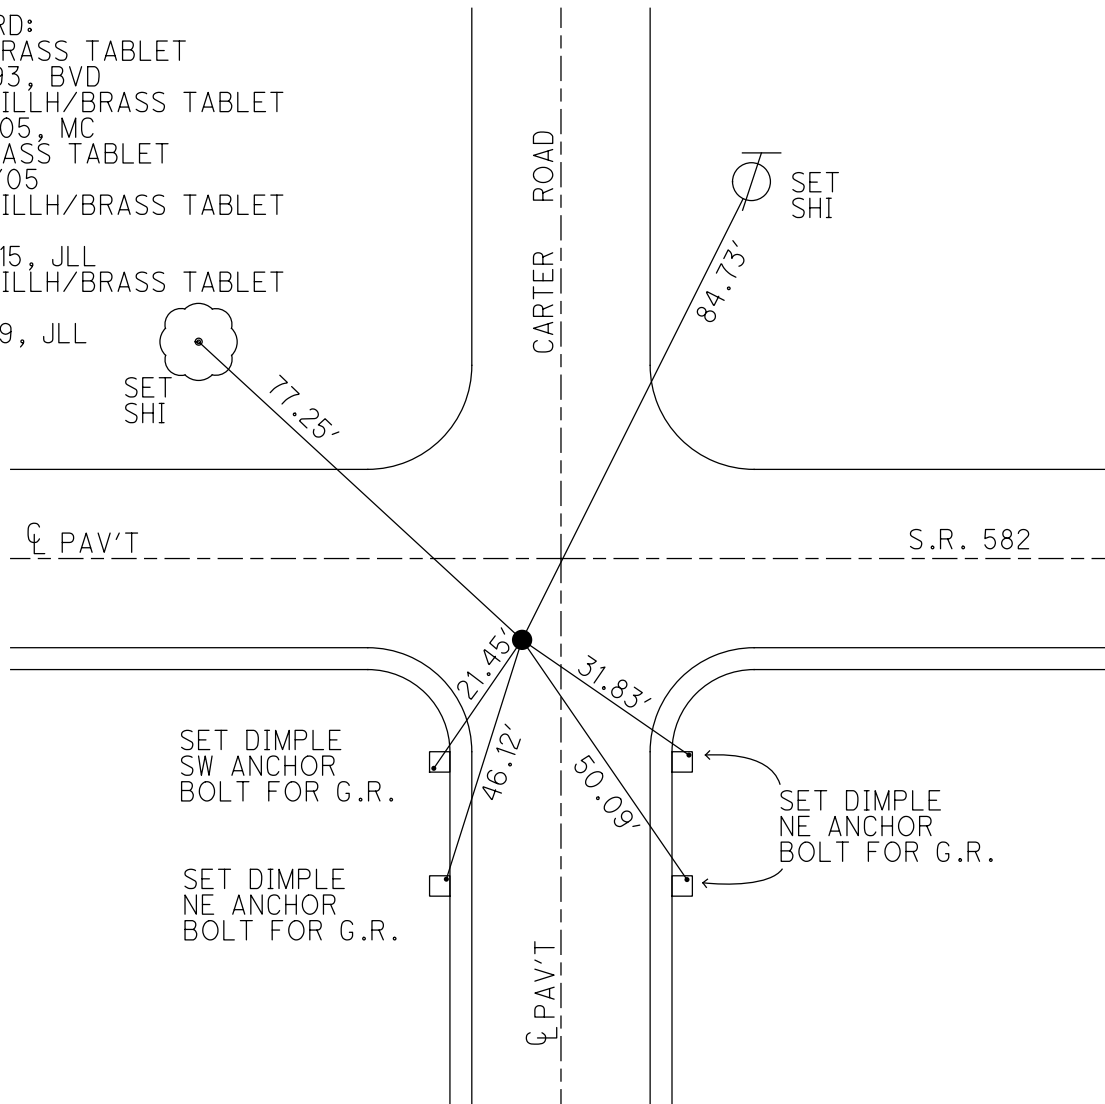

O.D.O.T. DISTRICT 2 SURVEY OFFICE

PERSONNEL

REFERENCE NO. 27

SHEET 5 OF 20

NOTES BARNHISEL

DATE 04/15/05

ROUTE 582

H.C. CANTERBURY

WEATHER CLEAR

COUNTY WOOD

R.C. BARNHISEL

TEMP. +50°

TOWNSHIP MIDDLETON

SECTION 28

T 6 N R 11 E

TYPE MONUMENT DRILL HOLE/BRASS TABLET

ON SURFACE - BELOW YES


~~LEFT~~ - Q PAV'T - RIGHT 11.4'

TO EDGE PAVEMENT

S.L.M. 447+92, 8' WEST OF Q N&S

GRID: NORTHING:


EASTING:

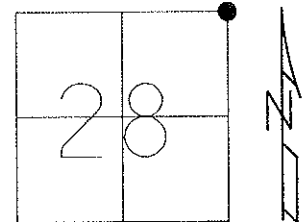

RECORD:

NOTE: SET BRASS TABLET IN
CONC. APPROACH SLAB DURING
CONST. 08/06/93
BOB VAN DUSEN

TABLET NOT DISTURBED
LOCATED IN BRIDGE DECK
08/23/05

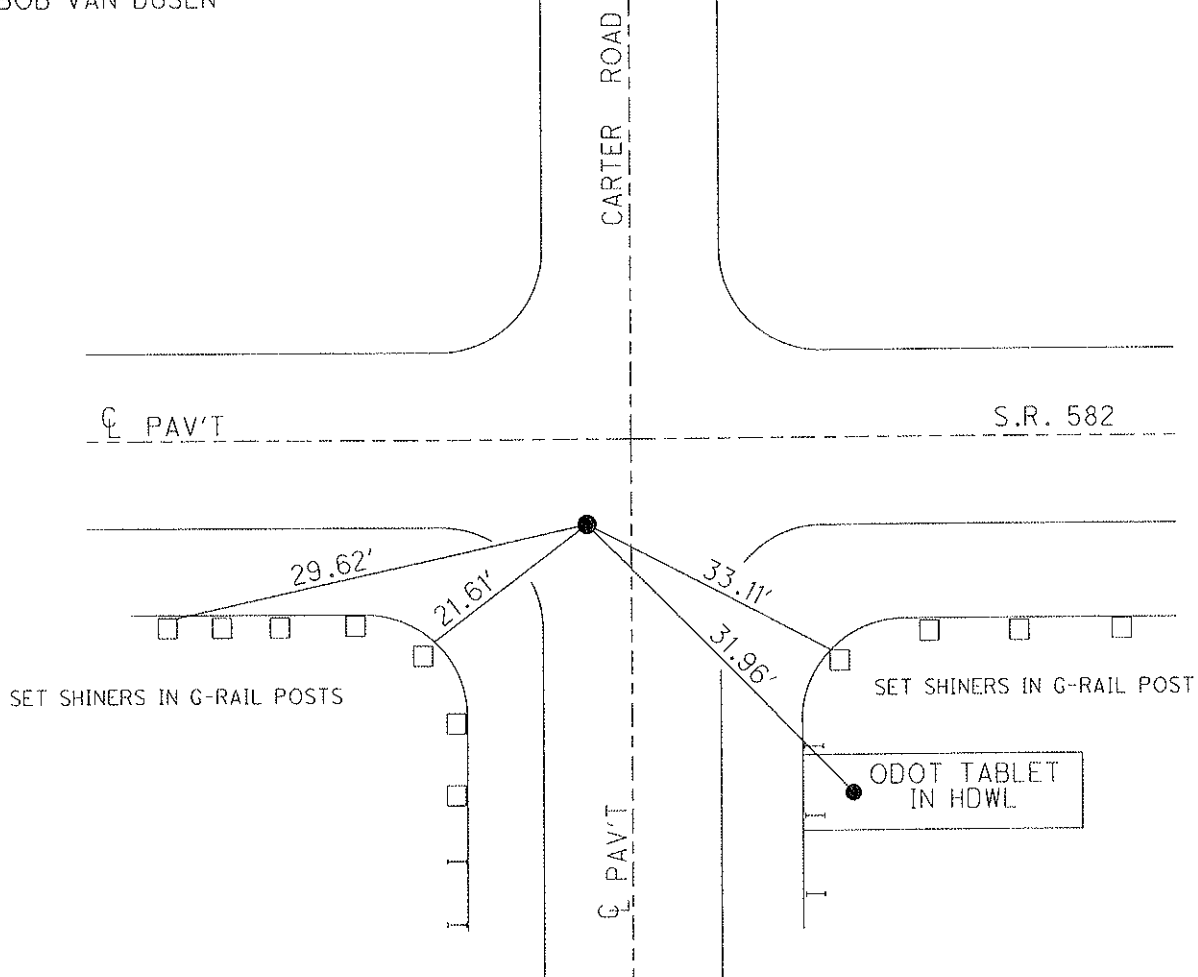

O.D.O.T. DISTRICT 2 SURVEY OFFICE

PERSONNEL

REFERENCE NO. 27

SHEET 6 OF 21

NOTES BARNHISEL

DATE 04/15/05

ROUTE 582

H.C. CANTERBURY

WEATHER CLEAR

COUNTY WOOD

R.C. BARNHISEL

TEMP. +50°

TOWNSHIP MIDDLETON

SECTION 28

T 6 N R 11 E


TYPE MONUMENT DRILL HOLE/BRASS TABLET

ON SURFACE - ~~BELOW~~ YES

~~LEFT~~ - CL PAV'T - RIGHT 11.4'

TO EDGE PAVEMENT


S.L.M. 447+92 8' WEST OF CL. N&S

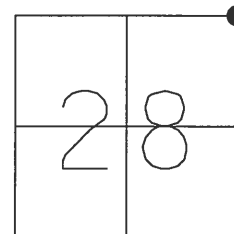

RECORD:

NOTE: SET BRASS TABLET IN
CONC. APPROACH SLAB DURING
CONST. 08/06/93
BOB VAN DUSEN

TABLET NOT DISTURBED
LOCATED IN BRIDGE DECK
08/23/05

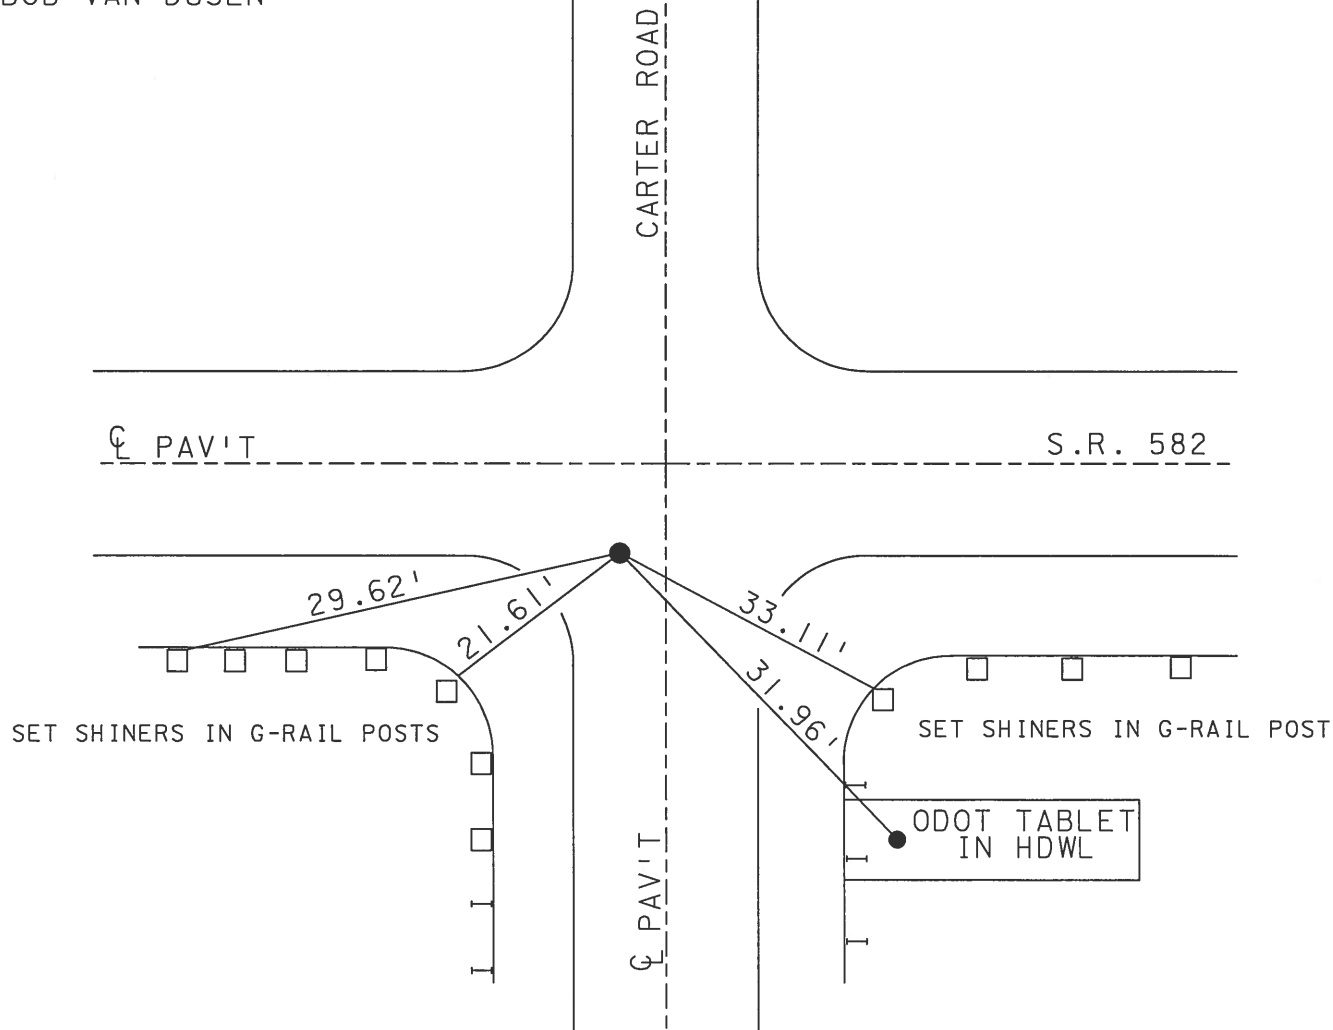

O.D.O.T. DISTRICT 2 SURVEY OFFICE

PERSONNEL _____

REFERENCE NO. 27

SHEET _____ OF _____

NOTES VAN DUSEN

H.C. CORDES

DATE 9-10-93

ROUTE 582

R.C. BARNHISEL

WEATHER PTLY CLOUDY

COUNTY WOOD

TEMP. +65° F

TOWNSHIP MIDDLETON

SECTION 28

T. 6 N. R. 11 E

"DRILL HOLE"
SET IN


TYPE MONUMENT BRASS TABLET

ON SURFACE - BELOW YES


LEFT - & PAV'T. - RIGHT 11.4

- TO - EDGE PAVEMENT

S.L.M. 447+92 6.0' W. OF E NORTH SOUTH

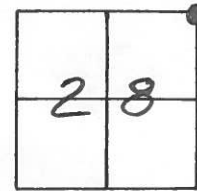


NOTE: SET BRASS TABLET
IN CONC. APPROACH
SLAB DURING CONST.
8-6-93
BYD

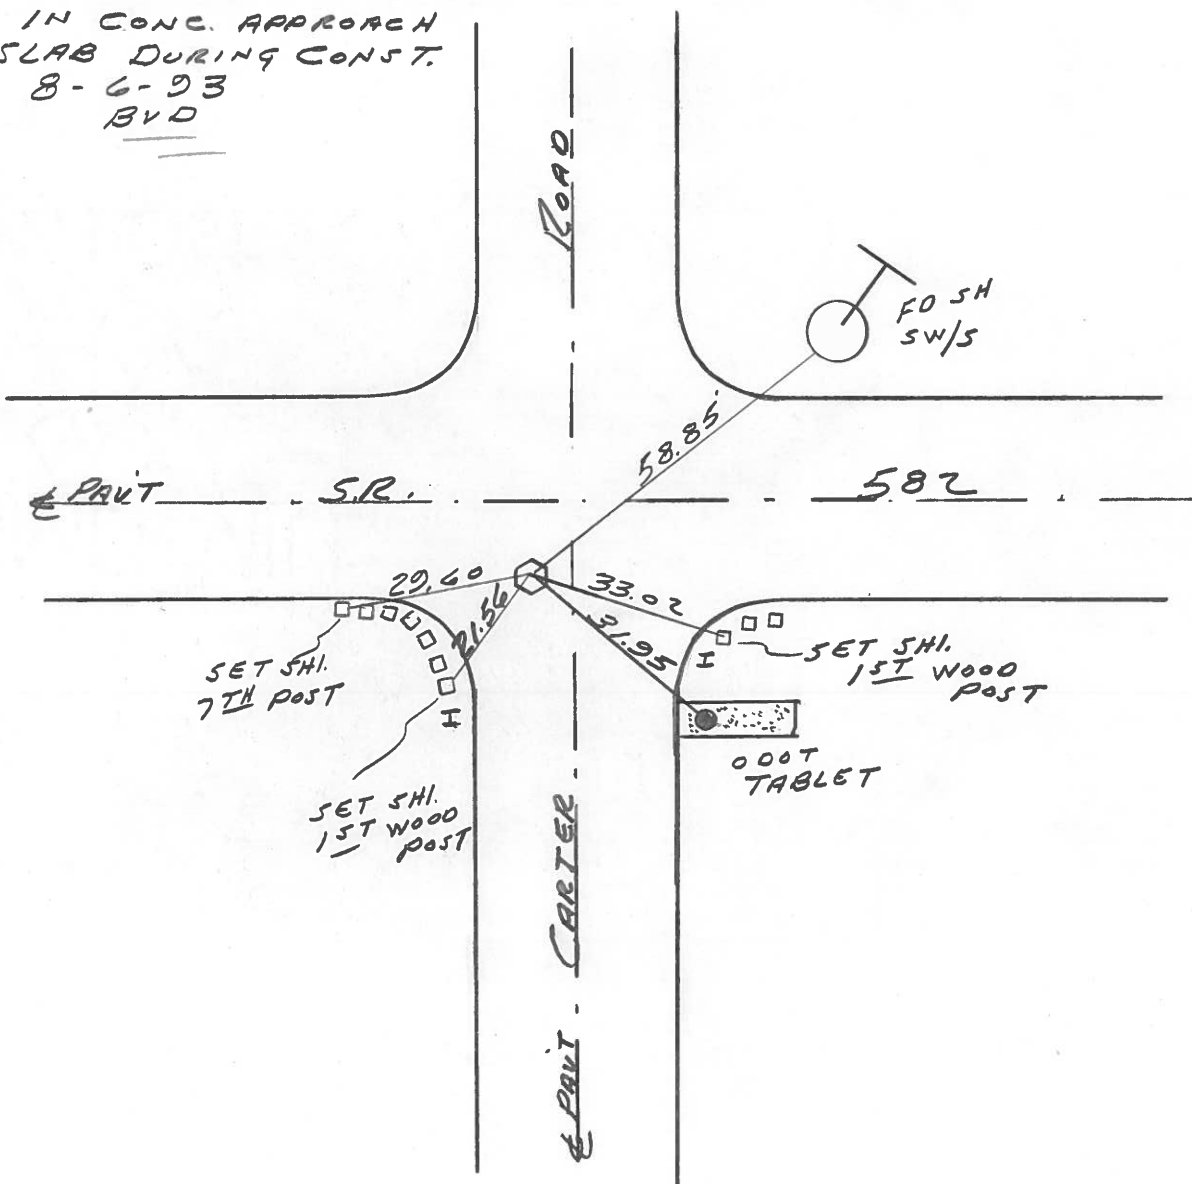

4 of 21.

27

Town 6 N Range 11 E
1/4 Corner of Sections 22, 27 Webster
21, 28 Midd.
 Kind of Monument Stone Remarks Set sm.
Re-rad N. side (stone is 2.5' deep)
 FOUND SEP BY County
 N. & S. Road Carter F. B. P.
 E. & W. Road S.E. 582 F. B. P.
10 PKS. N.E. & N.W.

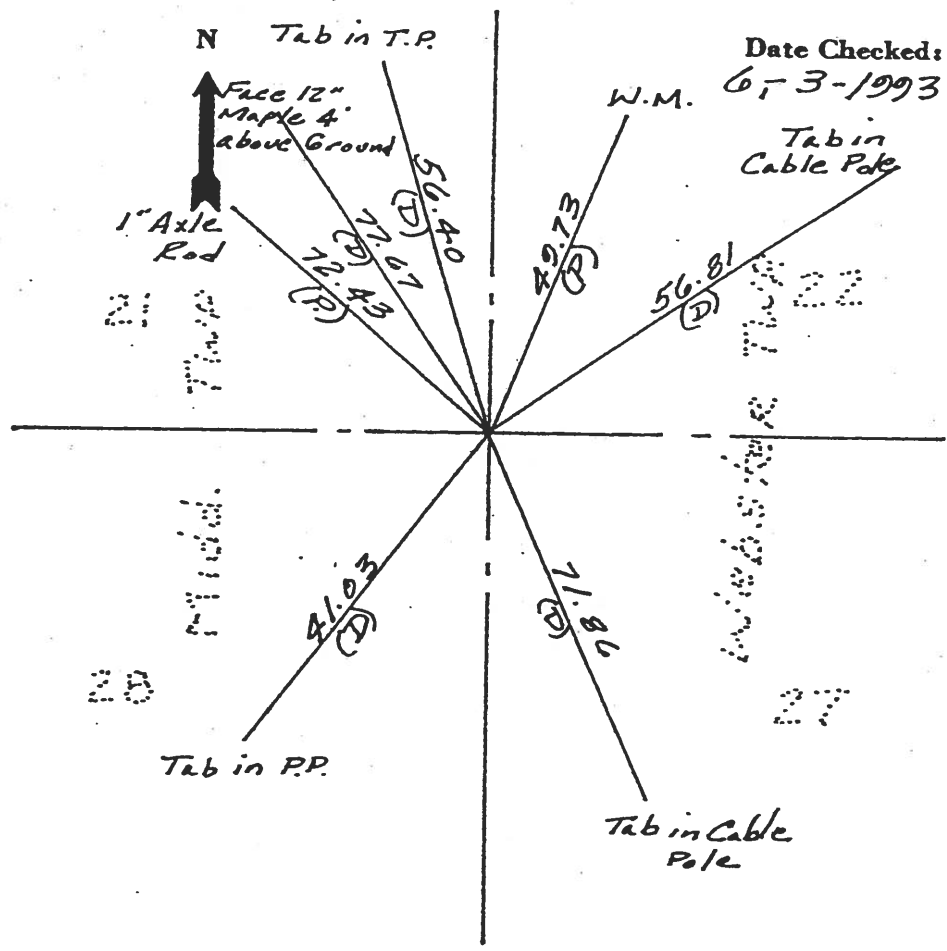

O.D.O.T. DISTRICT 2 SURVEY OFFICE

PERSONNEL

REFERENCE NO. 27

SHEET OF

NOTES LOERKE

H.C. HOFFMAN

R.C. STEINHAUSER

BAENTHSEL

DATE 7-12-90

WEATHER cloudy

TEMP. +65°

ROUTE SR 582

COUNTY WOOD

TOWNSHIP MIDDLETON

SECTION 28

T 6 N R 11 E

TYPE MONUMENT P.K. Nail


ON SURFACE - BELOW Yes

LEFT - CL PAV'T. - RIGHT 10.7

— TO — EDGE PAVEMENT

S.L.M. 447 + 92

6.0 W. OF & NORTH

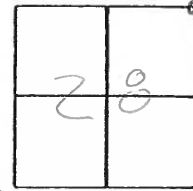

Set P.K. / Washer
10-25-90
MB

Ref mon

Set shi
sw/s

S.R. 582

26.33

67.57-P-

Ref
mon

Set Shi
3rd GUARD
RAIL Post

Set Shi
3rd G. RAIL Post
w/s

2 Pavt.

56.47


56.85

14.26


Fd
sh
6/s

2 PAVT

CARTER Rd.

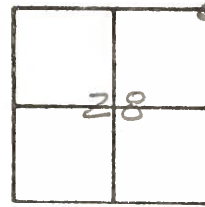County Wood S.R. 582Township MiddletonSection 28T N, R EPersonnel I. StoneP. NeuserR. MichalaleD. CurtisDate 13 July 83Weather WarmTemp. 85°

27

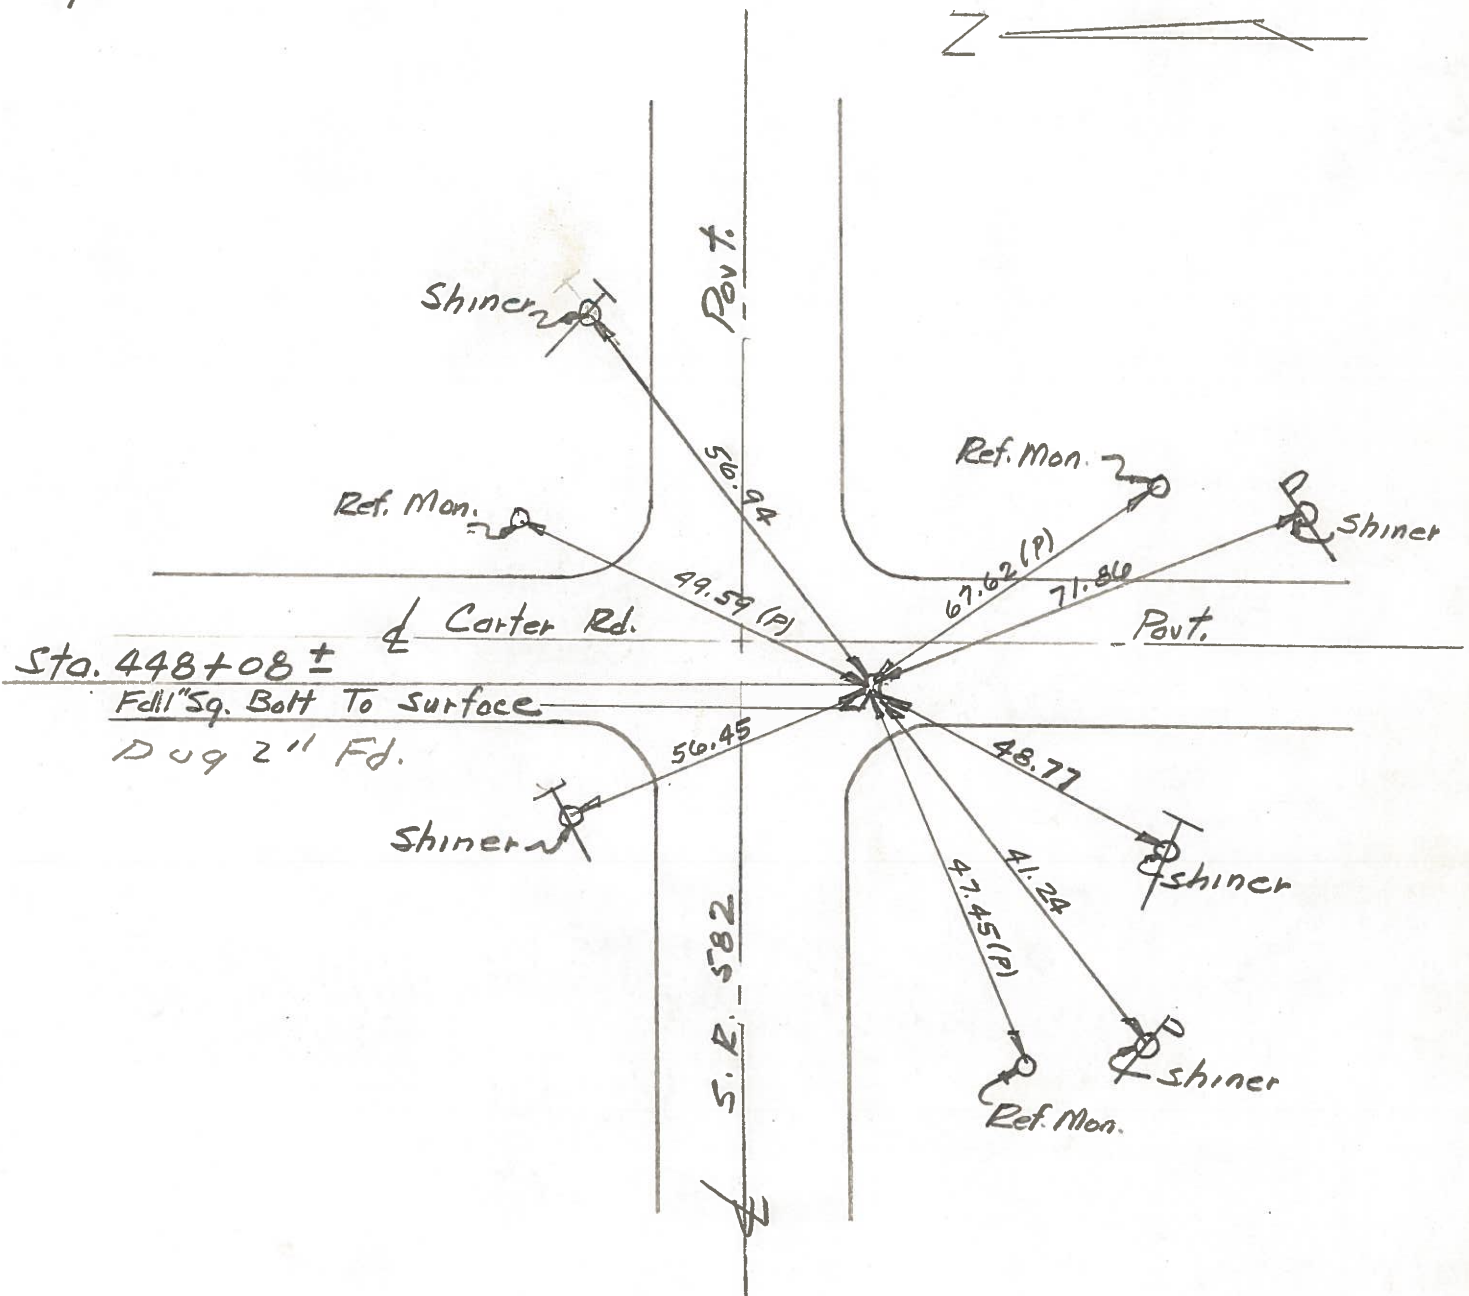

Q.D.O.T. DISTRICT 2 SURVEY OFFICE

SHEET 4 OF

County Wood S.R. 582

Date 13 July 83

Township Middleton


Weather Windy

Section 28

Temp. 85°

T N, R E



Personnel I. Stone
P. Neuser
R. Michalske
D. Curtis

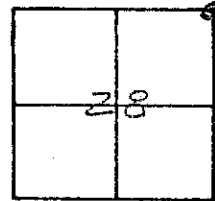

27

447 492

PK 0 SURFACE

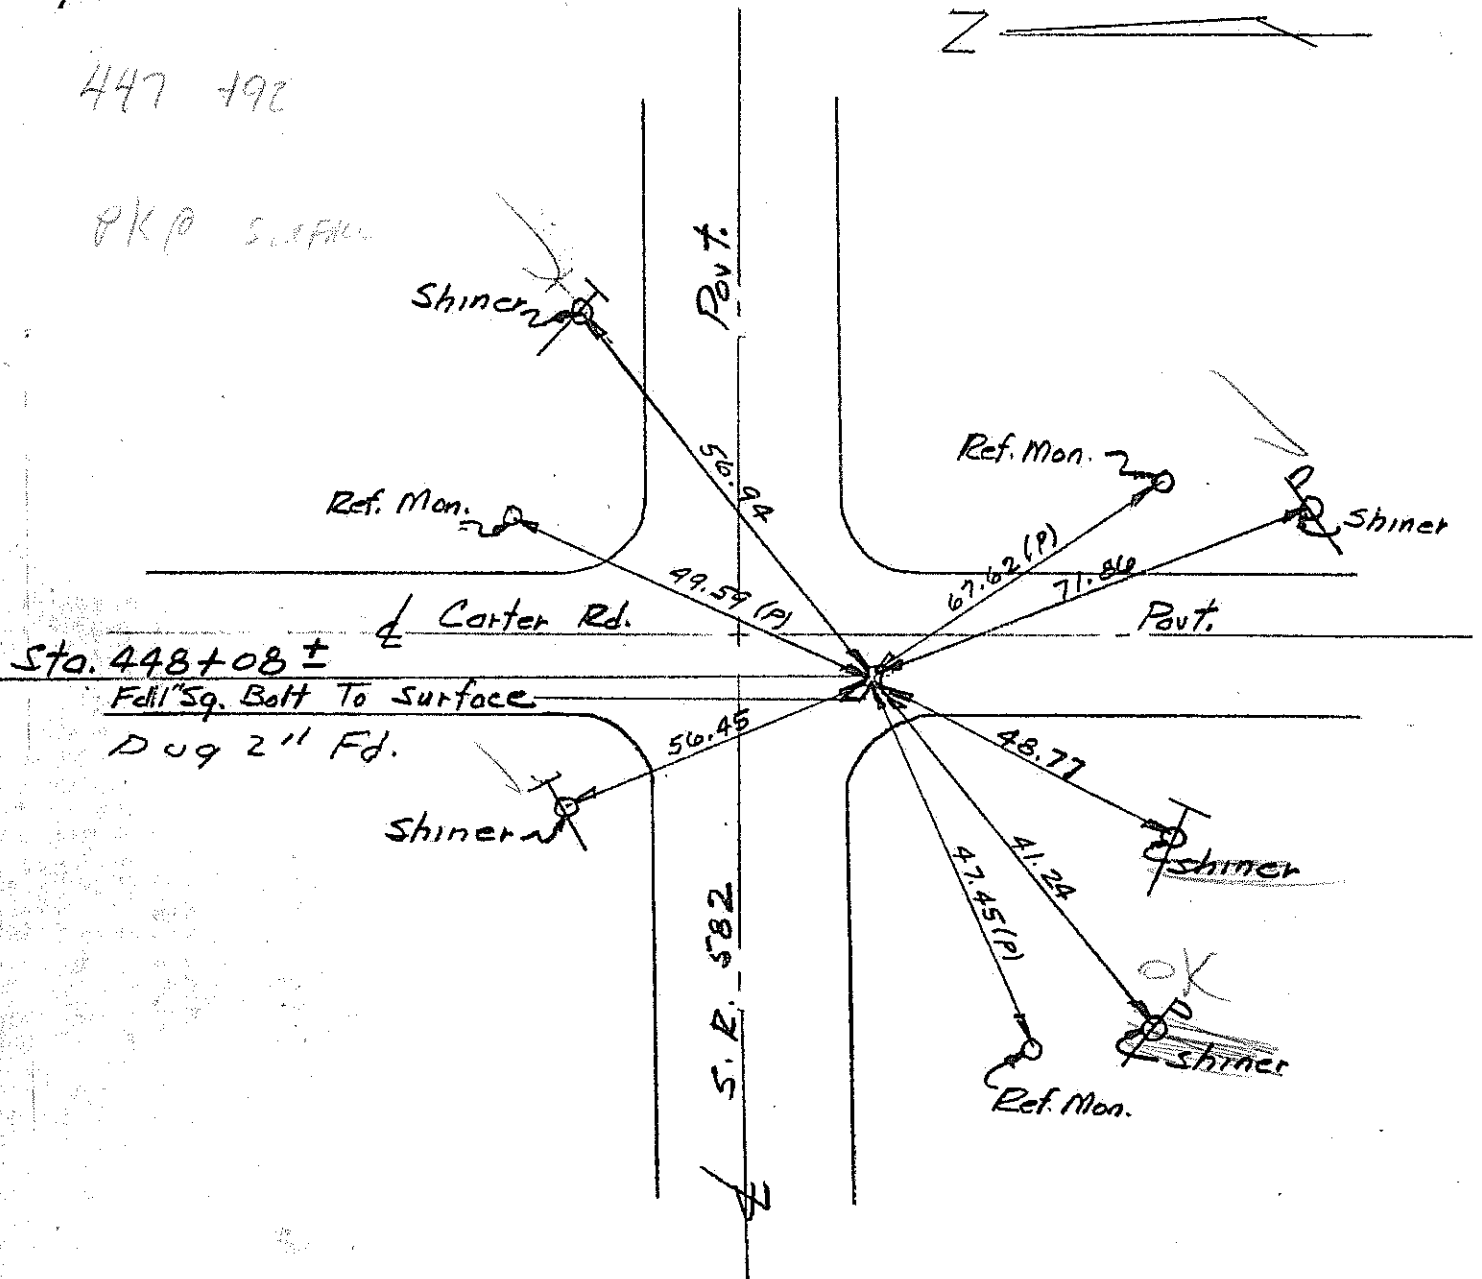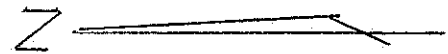

County Wood S.R. 582

Township MIDDLETON

Section 28

T6N, R11E

Personnel Hoffman

Loehrke


Householder

27

Date 6-22-82


Weather clear

Temp. +65°

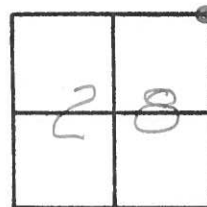


Fd. "□" HEAD BOLT @ surface
11.0' S. of & Pavt SR 582
5.8' W. of & Pavt Carter Rd.

SLM sta 447+23.06

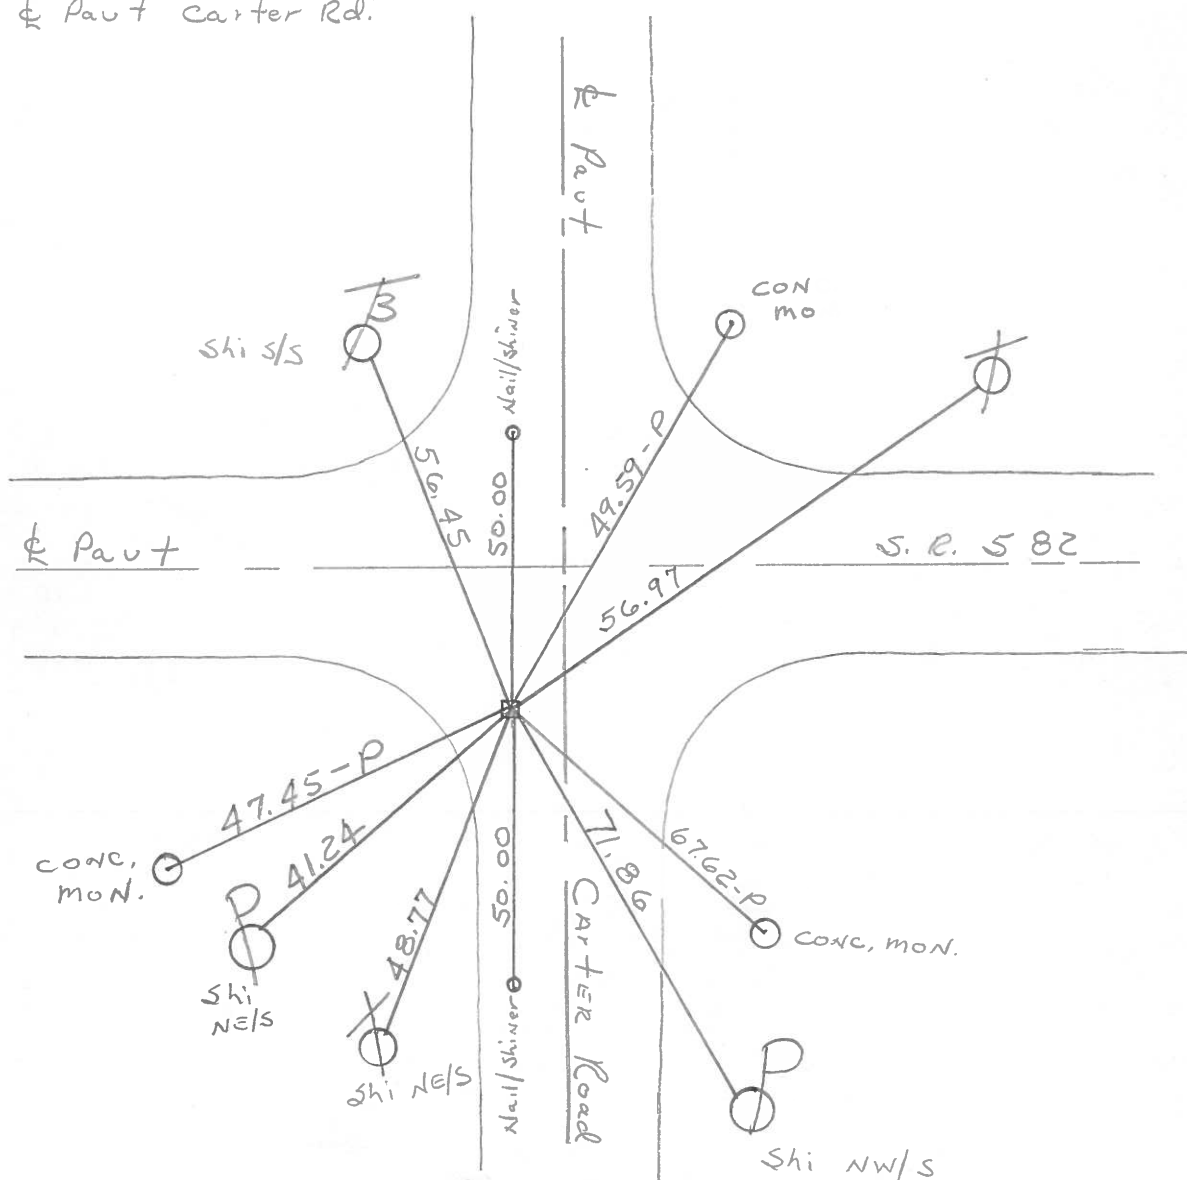

PERSONNEL	TITLE	PERSONNEL	TITLE	COUNTY	DATE
Silvester				4	
Burnside				S. R.	WEATHER
Smith				SEC.	TEMP.

DESCRIPTION with ties for Sec LEFT CENTER LINE RIGHT JOB NO. _____

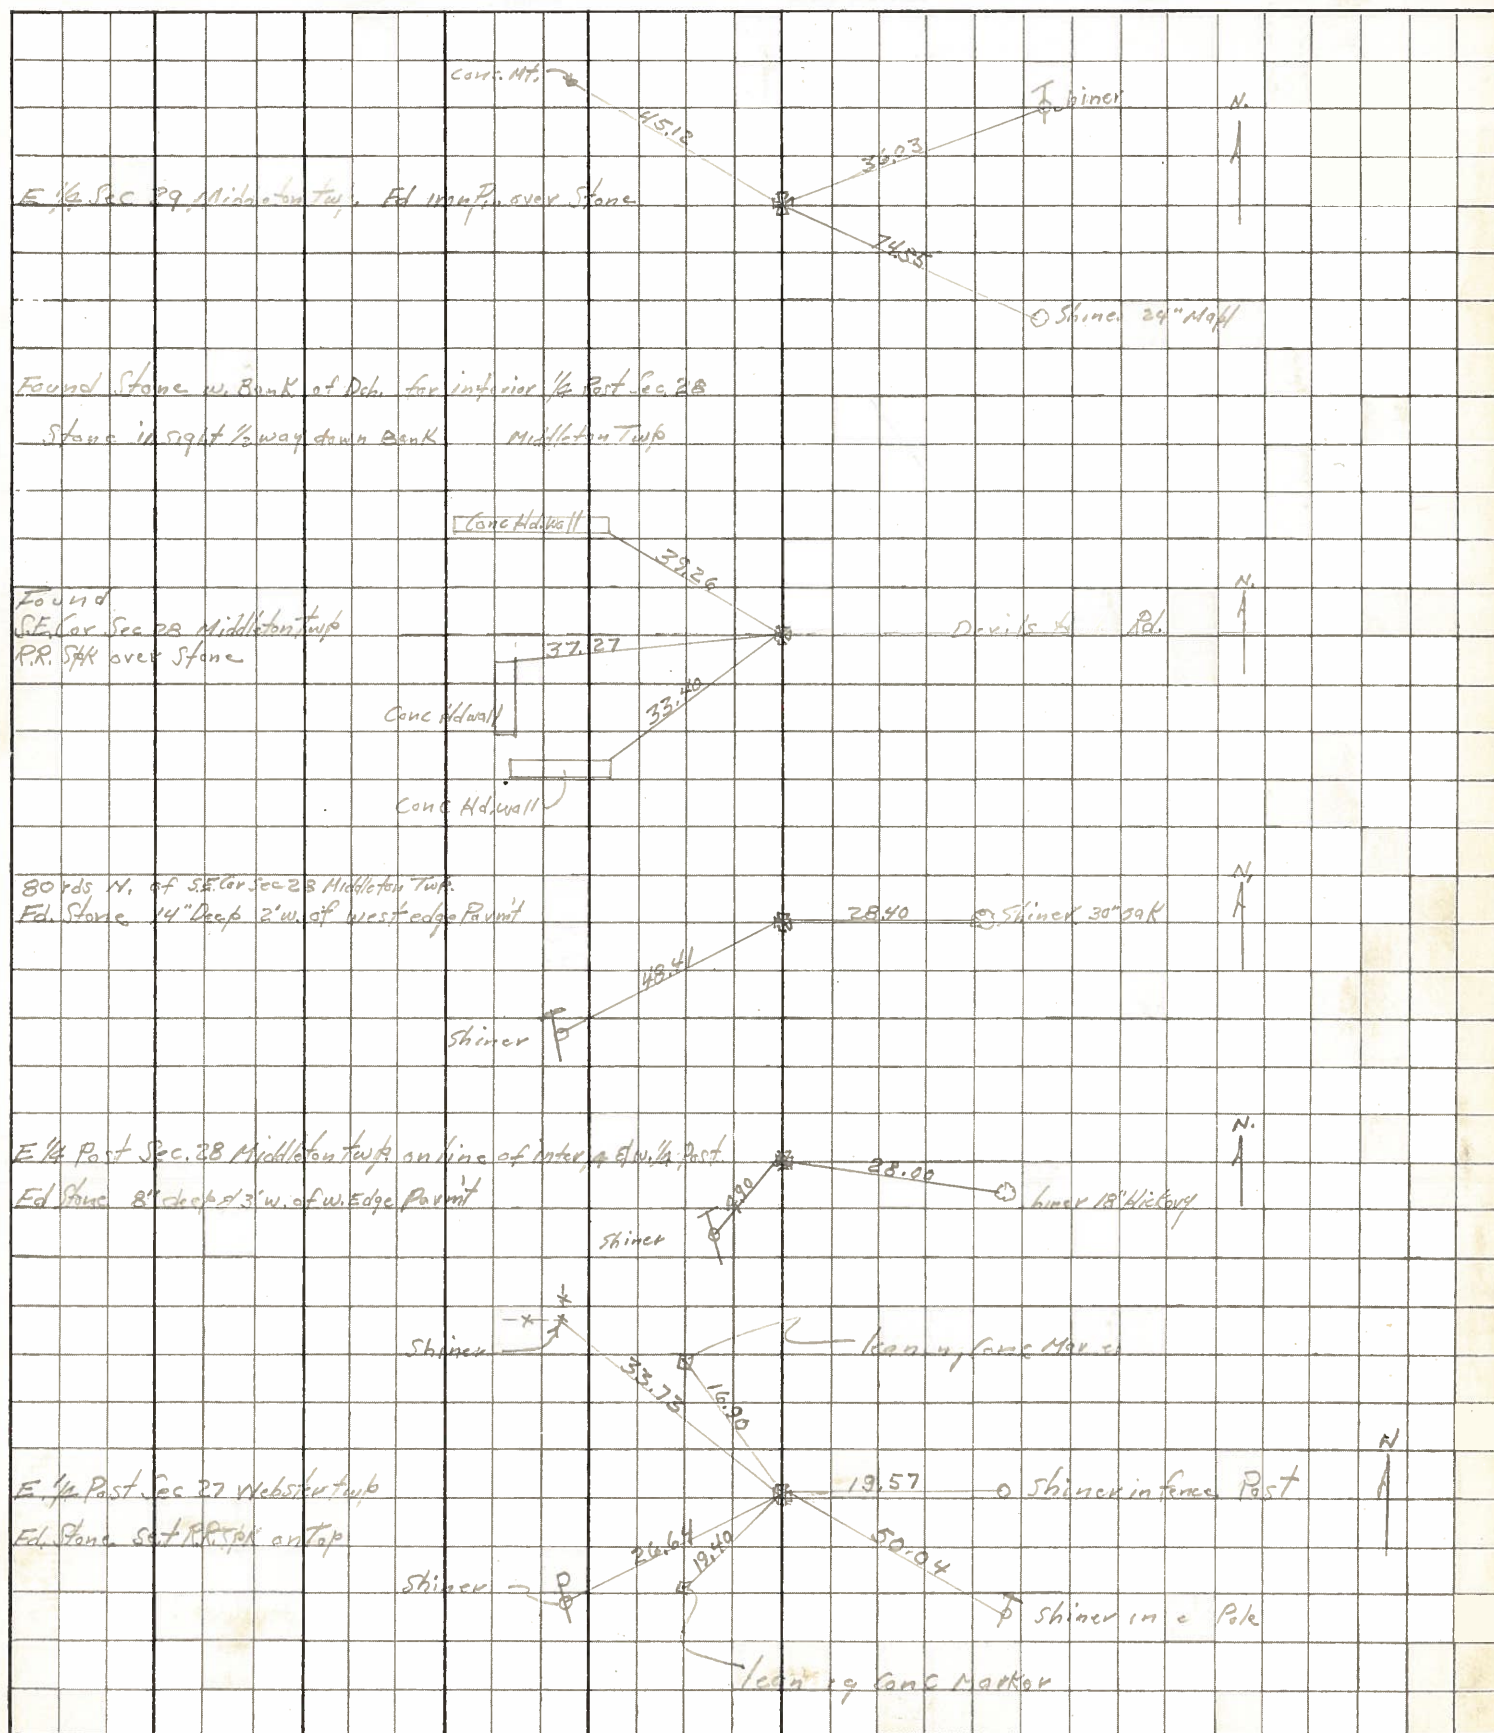


PERSONNEL TITLE PERSONNEL TITLE

COUNTY Wood DATE April 17, 1969S. R. #582 WEATHER Pt. Cloudy & WindySEC. From I-75 to SR#159 TEMP +75°DESCRIPTION Ties to Control points. JOB NO. 027300

LEFT

CENTER LINE

RIGHT

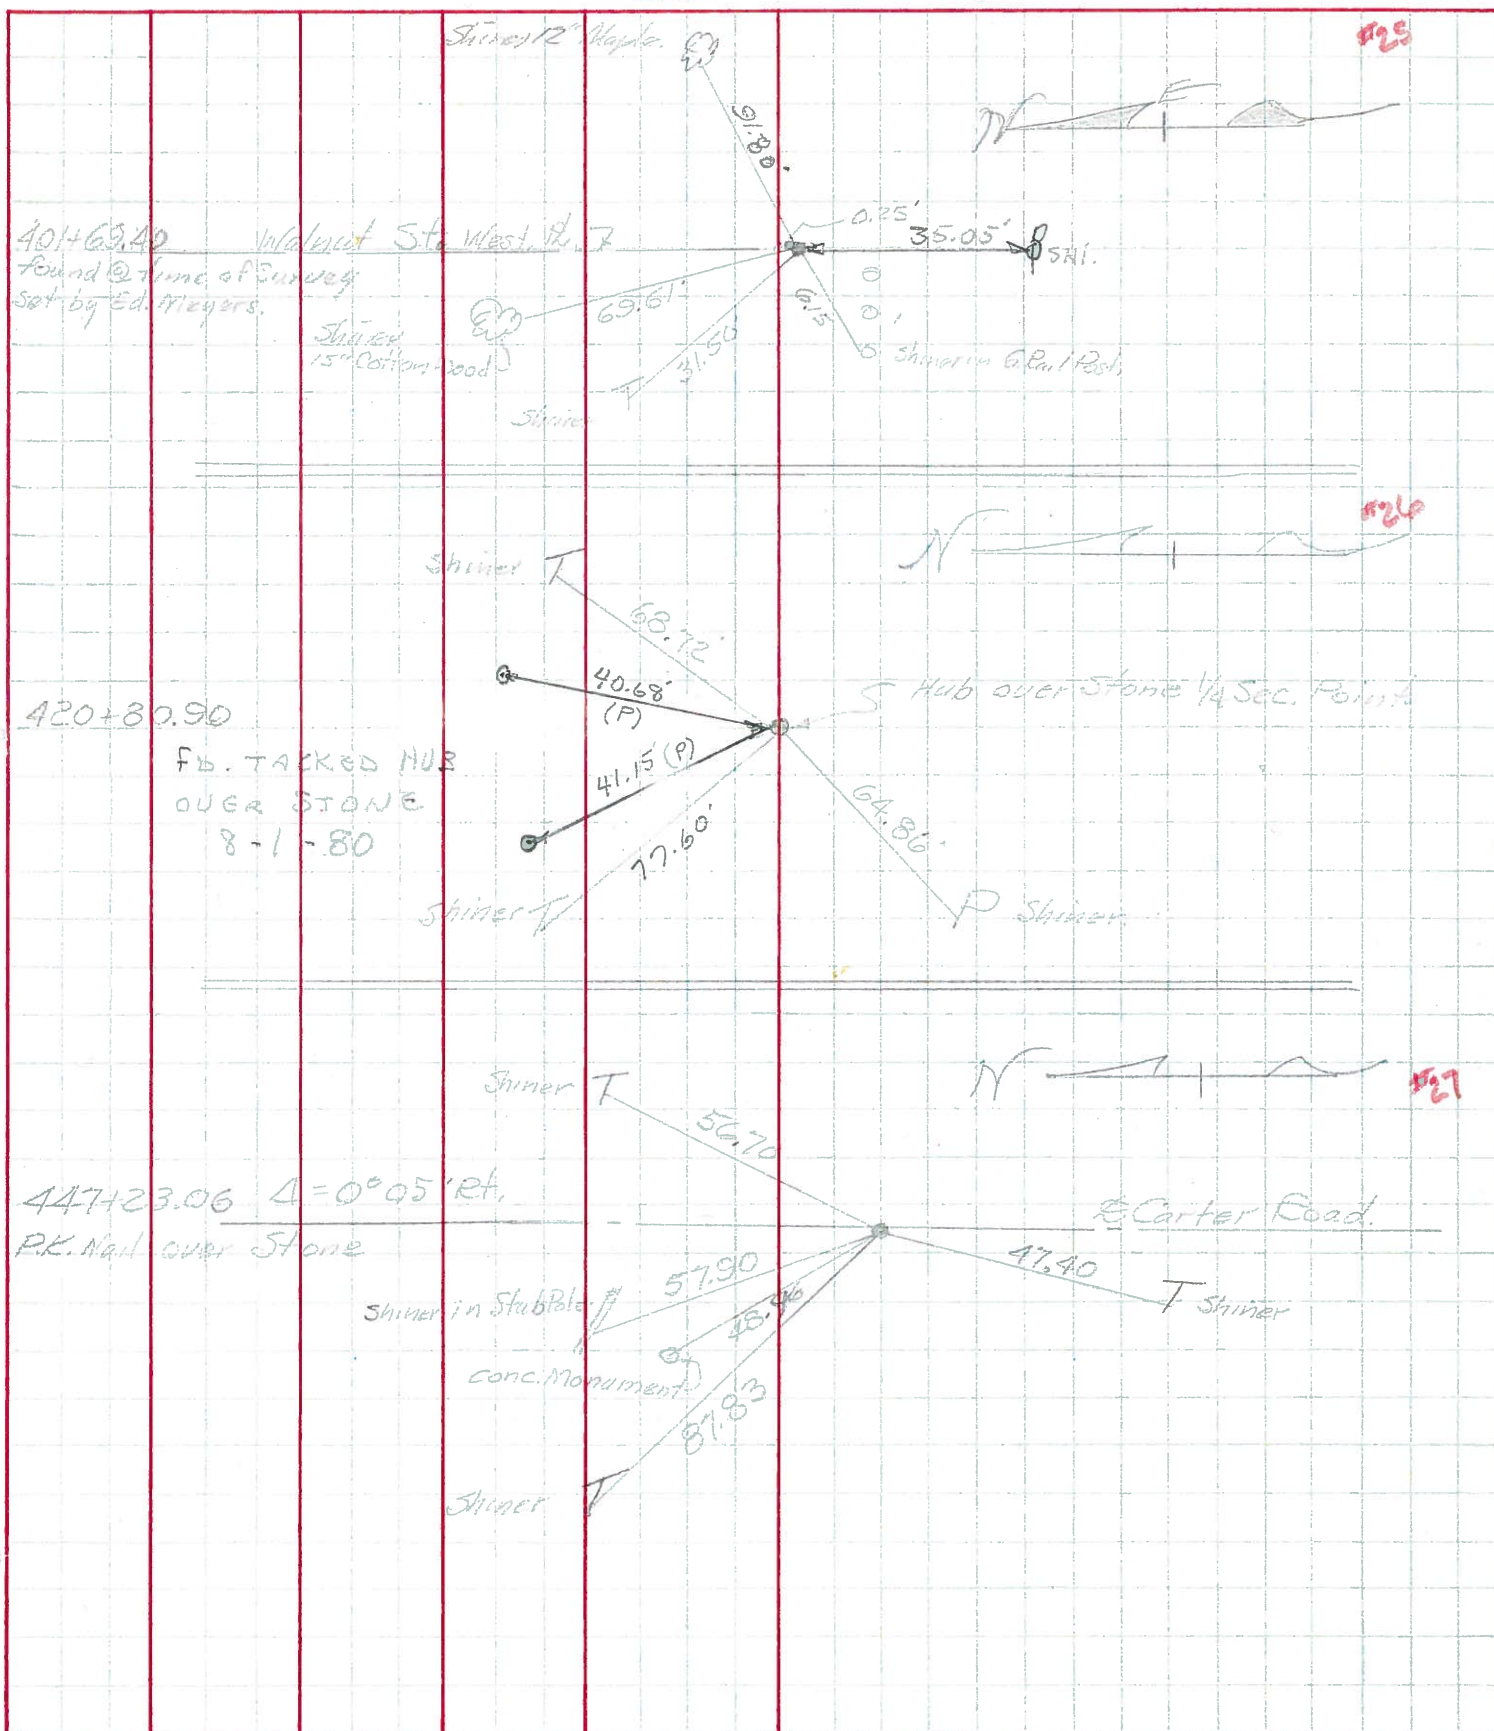

PERSONNEL TITLE PERSONNEL TITLE

COUNTY

Wood

DATE

12-27-57

S. R.

#582

Sworden 4-4-60

WEATHER

SEC.

TEMP.

DESCRIPTION

LEFT

CENTER LINE

RIGHT

JOB NO.

S. 1/4 post sec. 21 Middleton
twp.Iron stake-Stone under
Guard rail on line fence N.

O.K.

Shiner in Guard rail post E. 4.1'

Shiner in Guard rail post W. 3.8'

Shiner in 20" apple N.E. 90.24

Shiner in T.P. N.E. 68.49

Anchor Cor. post N. 28.70

#450

Stone
(Did not find)

12-6-54

S.W. Bridge Girder 9.25'

S.W. Bridge Girder 15.50

#451

CARTER ROAD

DECLINE IN

PERSONNEL

TITLE

PERSONNEL

TITLE

COUNTY

DATE

S. R.

WEATHER

SEC

TEMP


DESCRIPTION.

LEFT

CENTER LINE

RIGHT

JOB NO.

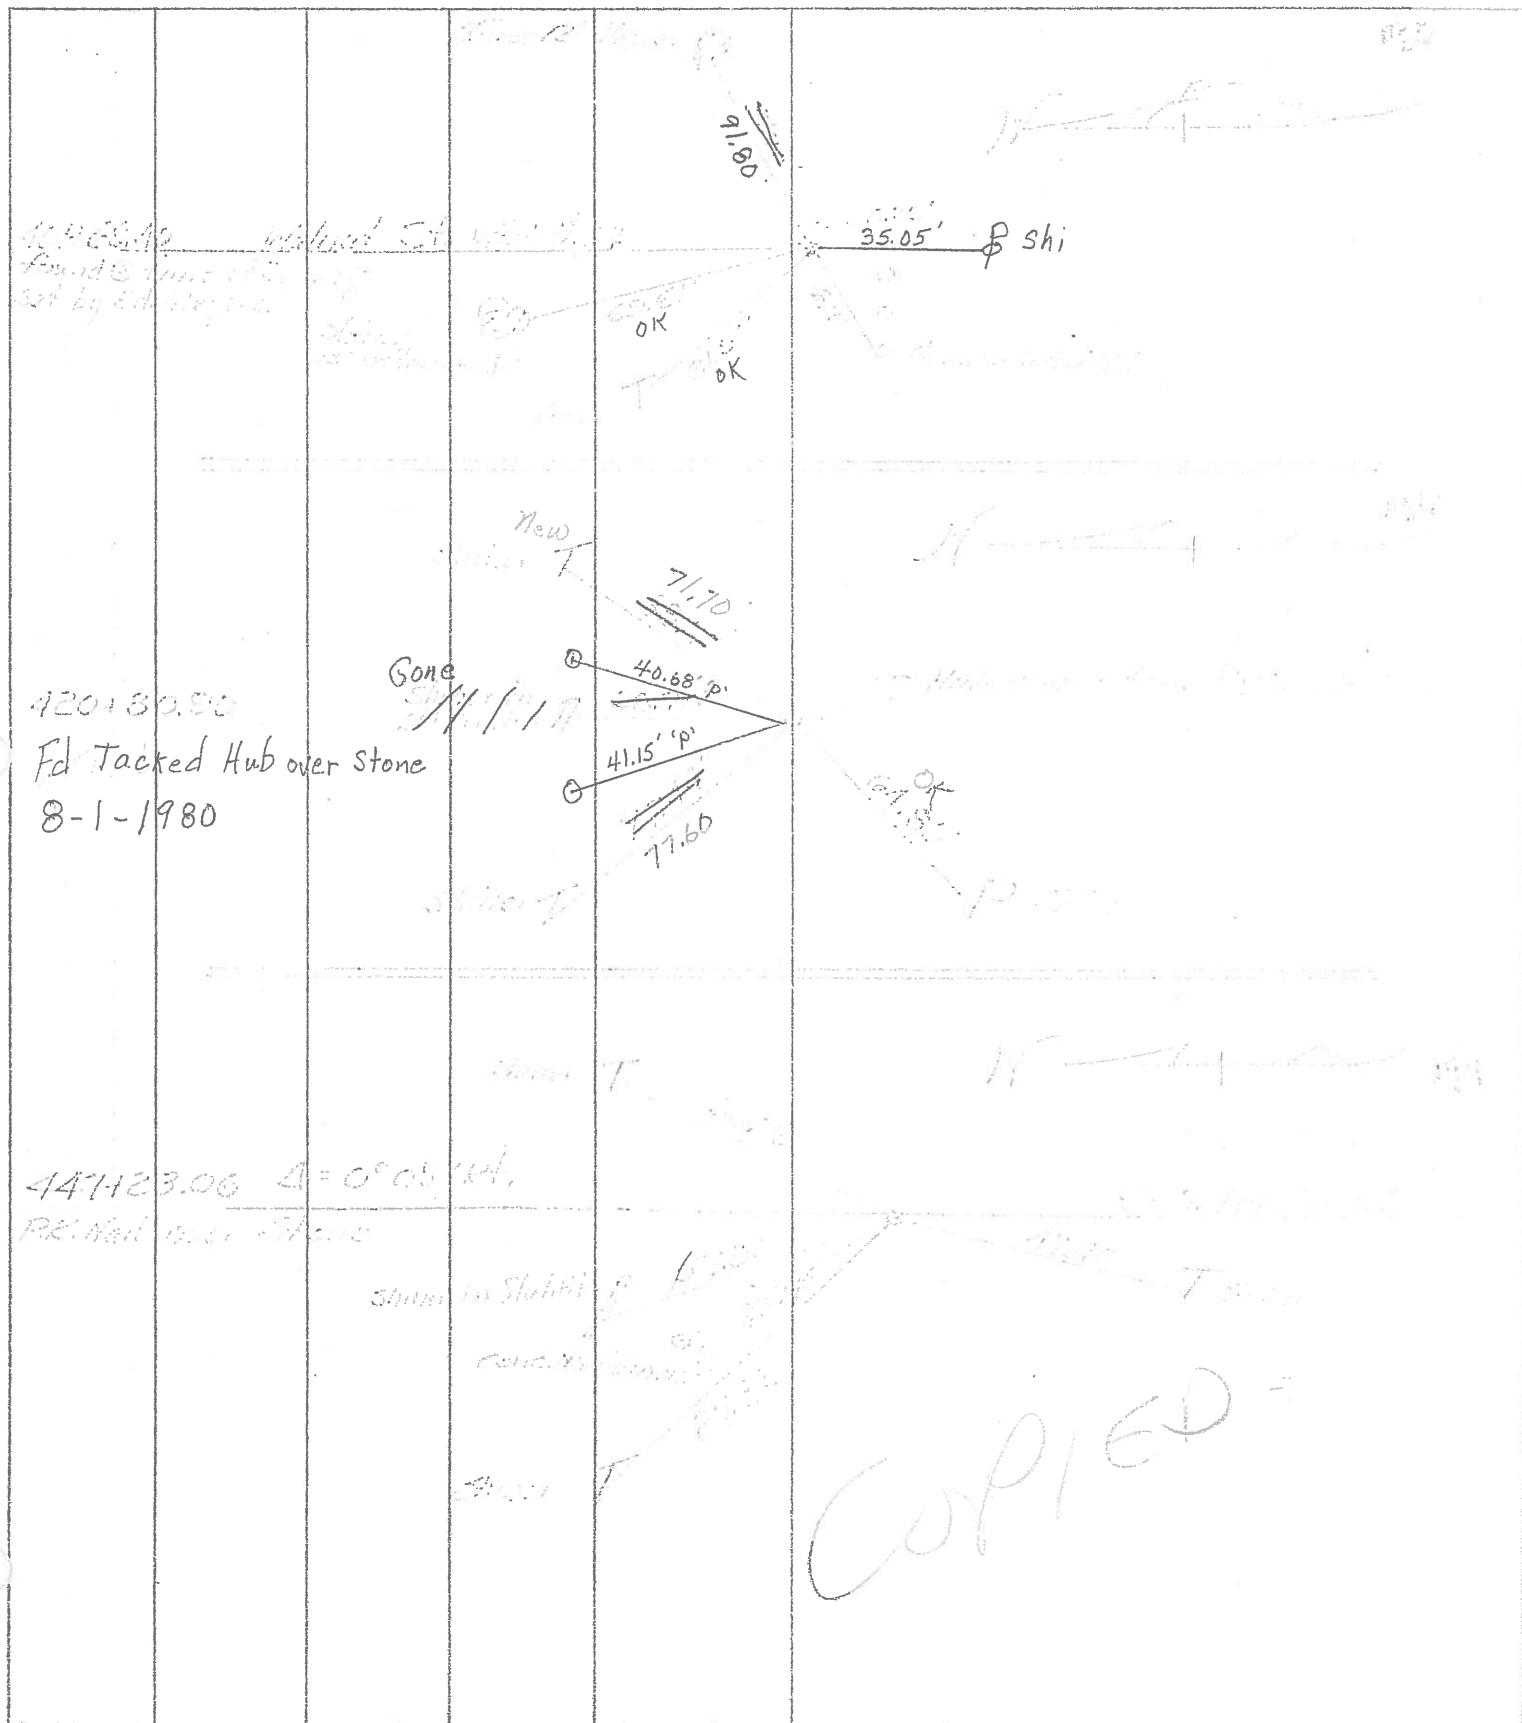

40.68
41.15