

O.D.O.T. DISTRICT 2 SURVEY OFFICE (USE ONLY)

PERSONNEL

REFERENCE NO. 29

SHEET 8 OF 21

NOTES LEU

DATE 4/15/15

ROUTE SR 582

H.C. WESTFALL

WEATHER SUNNY

COUNTY WOOD

R.C. LEU

TEMP. 41°

TOWNSHIP WEBSTER

SECTION 26

DWG BY BALBAUGH

PID 81000

T 6 N R 11 E

TYPE MONUMENT MAG/WASHER

ON SURFACE - ~~BELOW~~ ON

OFFSET Q PAVEMENT 8.8' ~~LT~~ : RT

— TO — EDGE PAVEMENT


STATION: 500+78.48

HORZ.DATUM: NAD83 (2011)


GEOID: 2012A

GRID: NORTHING: 654208.168

EASTING: 1674902.094

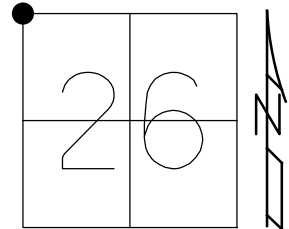

RECORD:
FD P.K.NAIL
4/19/05, MC
SET MAG/WASHER
8/23/05, MDB
FD MAG/WASHER
REF29
4/15/15, JLL
FD MONBOX
W/ 1" IPIN
NEWREF29
11/14/19, JLL

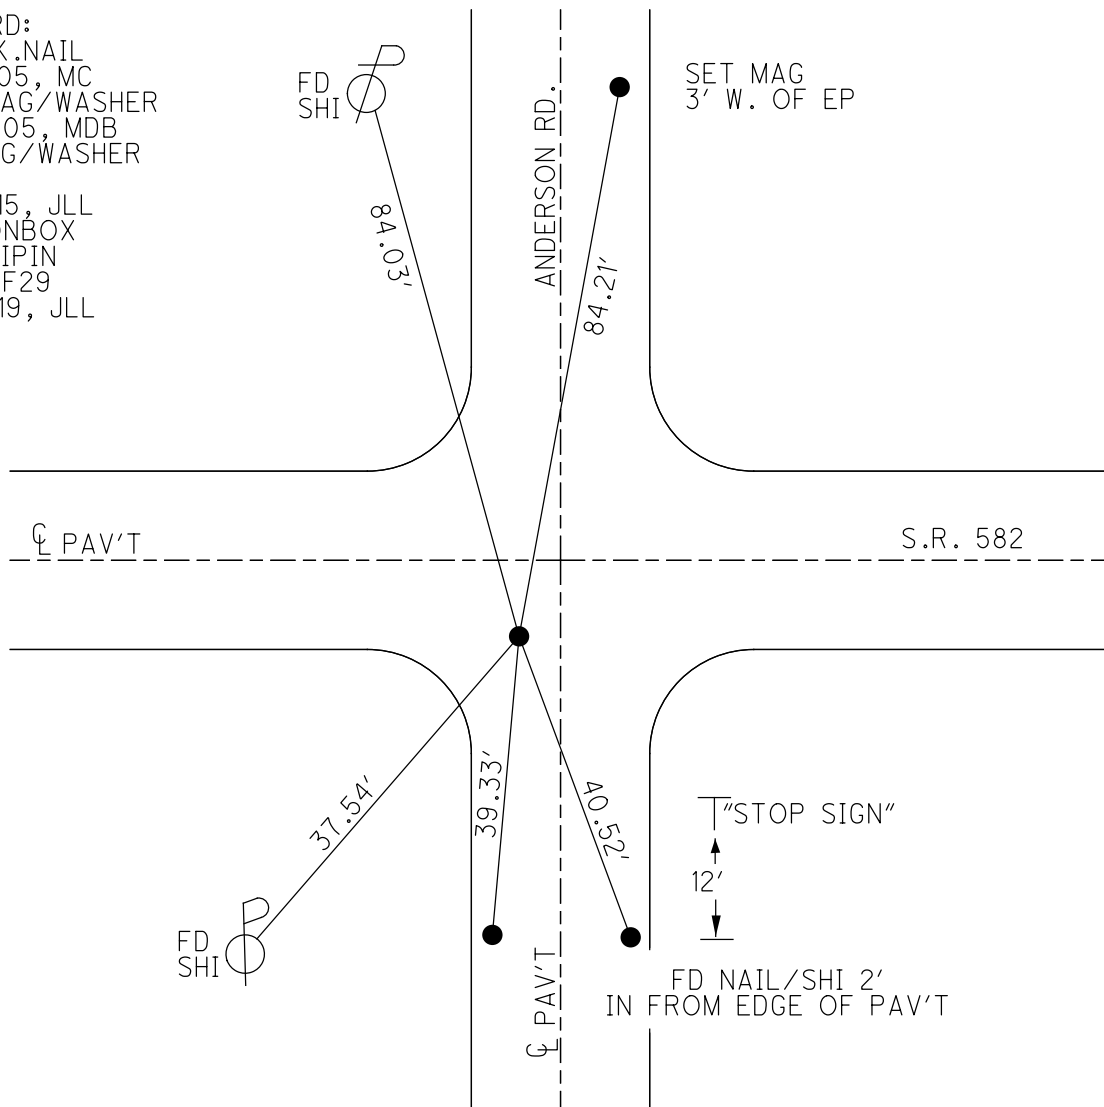

O.D.O.T. DISTRICT 2 SURVEY OFFICE

PERSONNEL

REFERENCE NO. 29


SHEET 7 OF 20

NOTES BARNHISEL
H.C. CANTERBURY
R.C. MIKLOVIC

DATE 04/19/05
WEATHER CLOUDY
TEMP. +55°


ROUTE S.R. 582
COUNTY WOOD
TOWNSHIP WEBSTER
SECTION 26
T 6 N R 11 E

TYPE MONUMENT PK NAIL
ON SURFACE - ~~BELOW~~ YES
~~LEFT~~ - Q PAV'T - RIGHT 8.8'
TO EDGE PAVEMENT
S.L.M. 500+94, 5' WEST OF Q NORTH

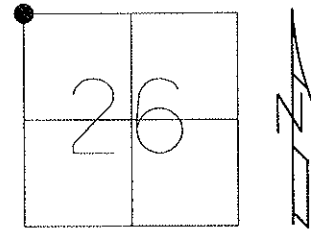

GRID: NORTHING: EASTING:

RESET MAG NAIL & WASHER
08/23/05
MDB

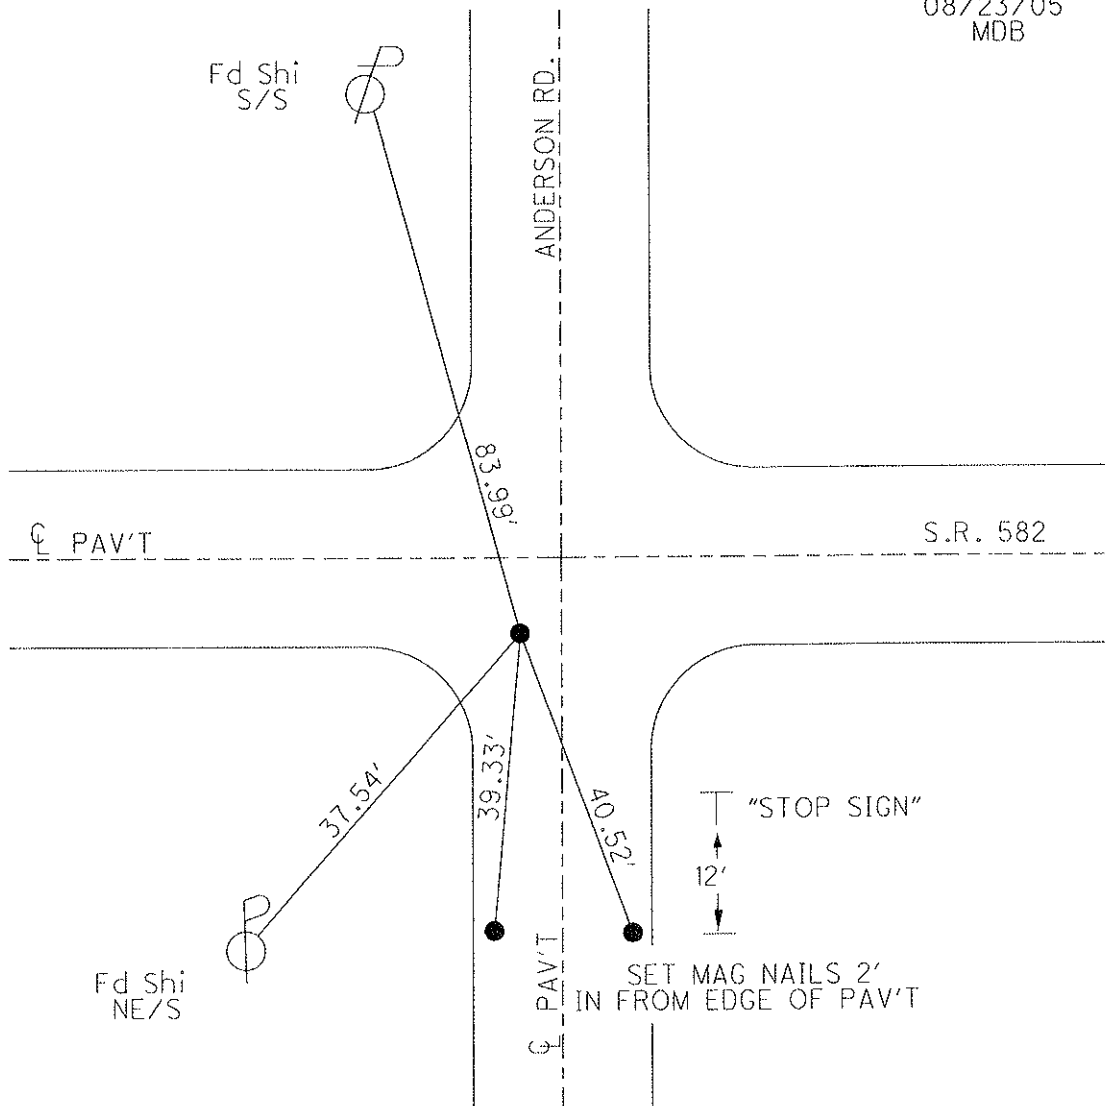

O.D.O.T. DISTRICT 2 SURVEY OFFICE

PERSONNEL

REFERENCE NO. 29

SHEET 8 OF 21

NOTES BARNHISEL

DATE 04/19/05

ROUTE S.R. 582

H.C. CANTERBURY

WEATHER CLOUDY

COUNTY WOOD

R.C. MIKLOVIC

TEMP. +55°

TOWNSHIP WEBSTER

SECTION 26

T6N R11E

TYPE MONUMENT _____ PK NAIL _____


ON SURFACE - ~~BELOW~~ YES

~~LEFT~~ - C PAV'T - RIGHT 8.81


TO — EDGE PAVEMENT

S.L.M. 500+94

5' WEST OF CL. NORTH

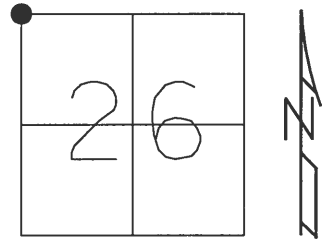

RESET MAG NAIL & WASHER
08/23/05
MDB

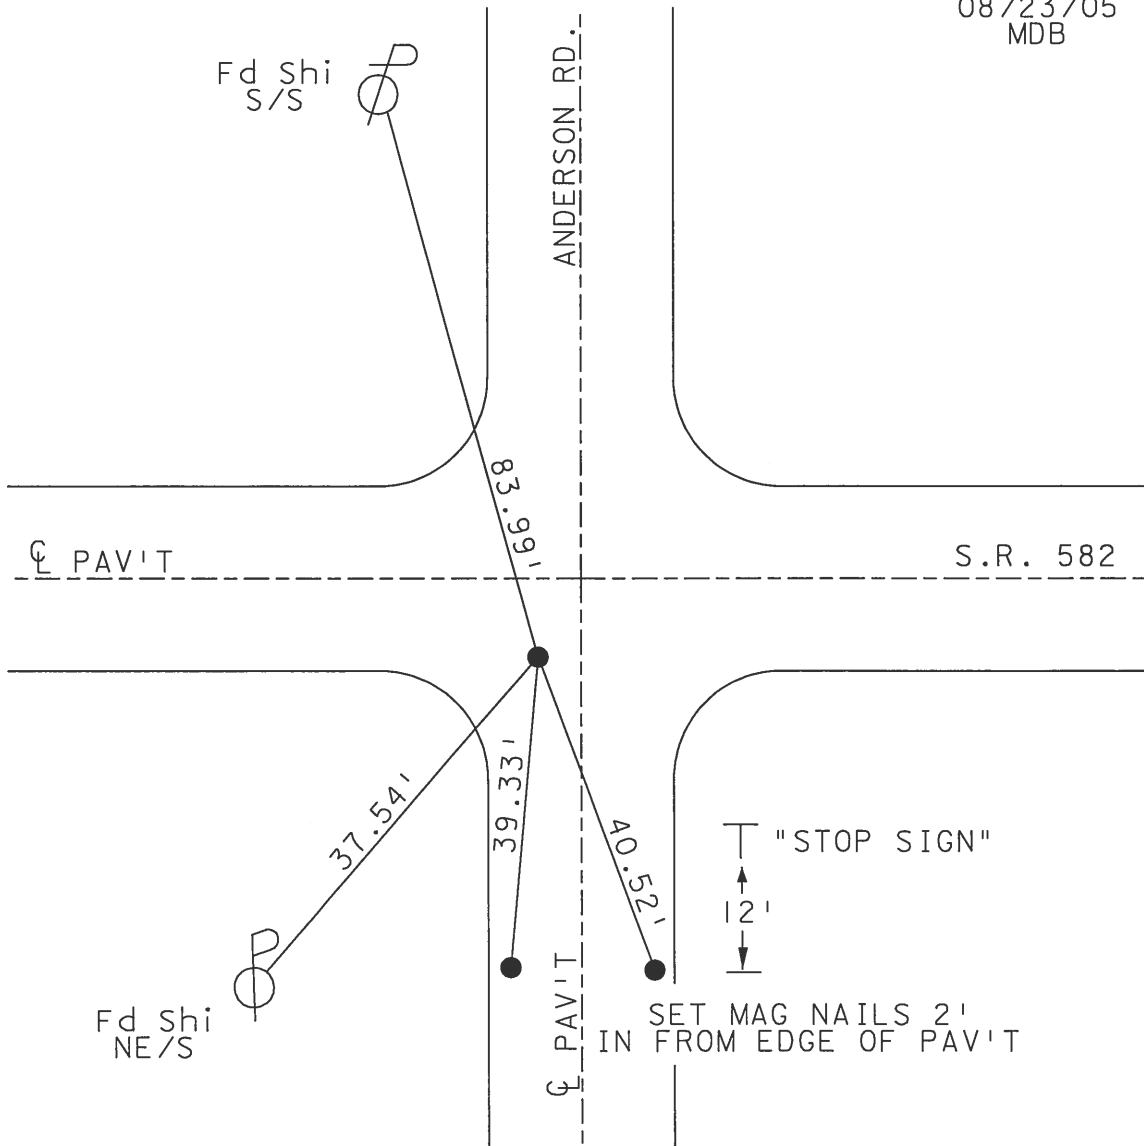

O.D.O.T. DISTRICT 2 SURVEY OFFICE

PERSONNEL

REFERENCE NO. 29

SHEET OF

NOTES LOHRKE

H.C. HOFFMAN

DATE 7-12-90

ROUTE SR 582

R.C. STEINHAUSE

WEATHER cloudy

COUNTY Ward

TEMP. +65°

TOWNSHIP WEBSTER

BAENHUSEL

SECTION 26

T.B. N R 11 E

TYPE MONUMENT 1/2" I. Rod


ON SURFACE - BELOW 1"

LEFT - CL PAV'T. - RIGHT 8.5

 TO EDGE PAVEMENT

S.L.M. 500+94

5' W. OF CL NORTH

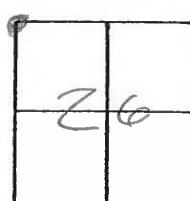

SET PK. / Washer
10-25-90
MB

Set
Sh
2/5

27

84.02

CL PAVT

Set
Sh
6

TELE.
BOXES

8"x8" WOODEN
Post GUARDING
Tele. EQUIPMENT

57.15

46.52

55.81

Set Sh's
in Post of
SE & SW CORNERS

CL PAVT


SR 582

37.56

P


Fd Sh
NE/S

ANDERSON Rd

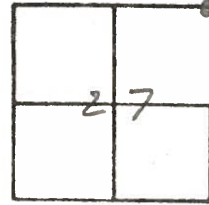County Wood S.R. 582Township WebsterSection 27T N, R EPersonnel J. StoneP. NeuserR. MichalskeD. CurtisDate 13 July 83Weather WindyTemp. 85°

SLM STA. 501+09

REF. NO. 29

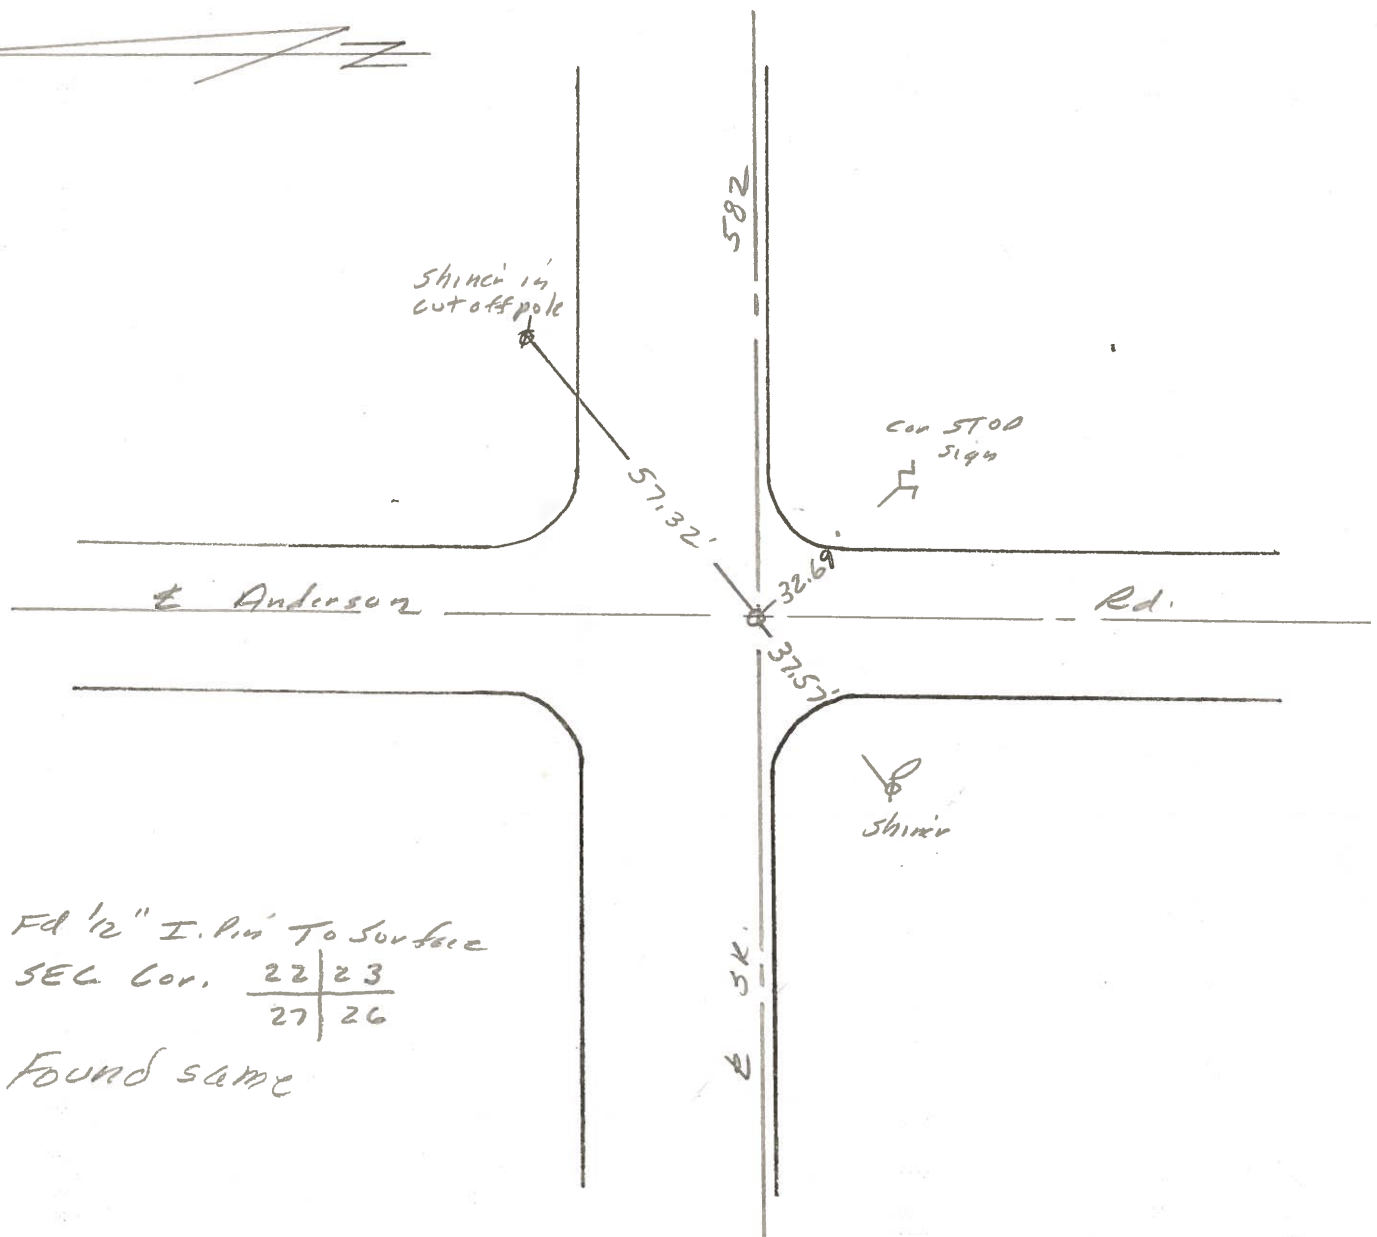

Q.D.O.T. DISTRICT 2 SURVEY OFFICE

SHEET 6 OF

County Wood S.R. 582

Date 13 July 83

Township Webster


Weather Windy

Section 27

Temp. 85°

T N, R E

Personnel L. Stone

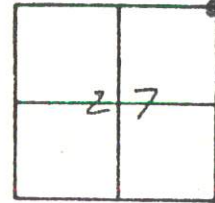


P. Neuser

R. Michalak

D. Curtis


SLM STA. 501+09

REF. NO. 29

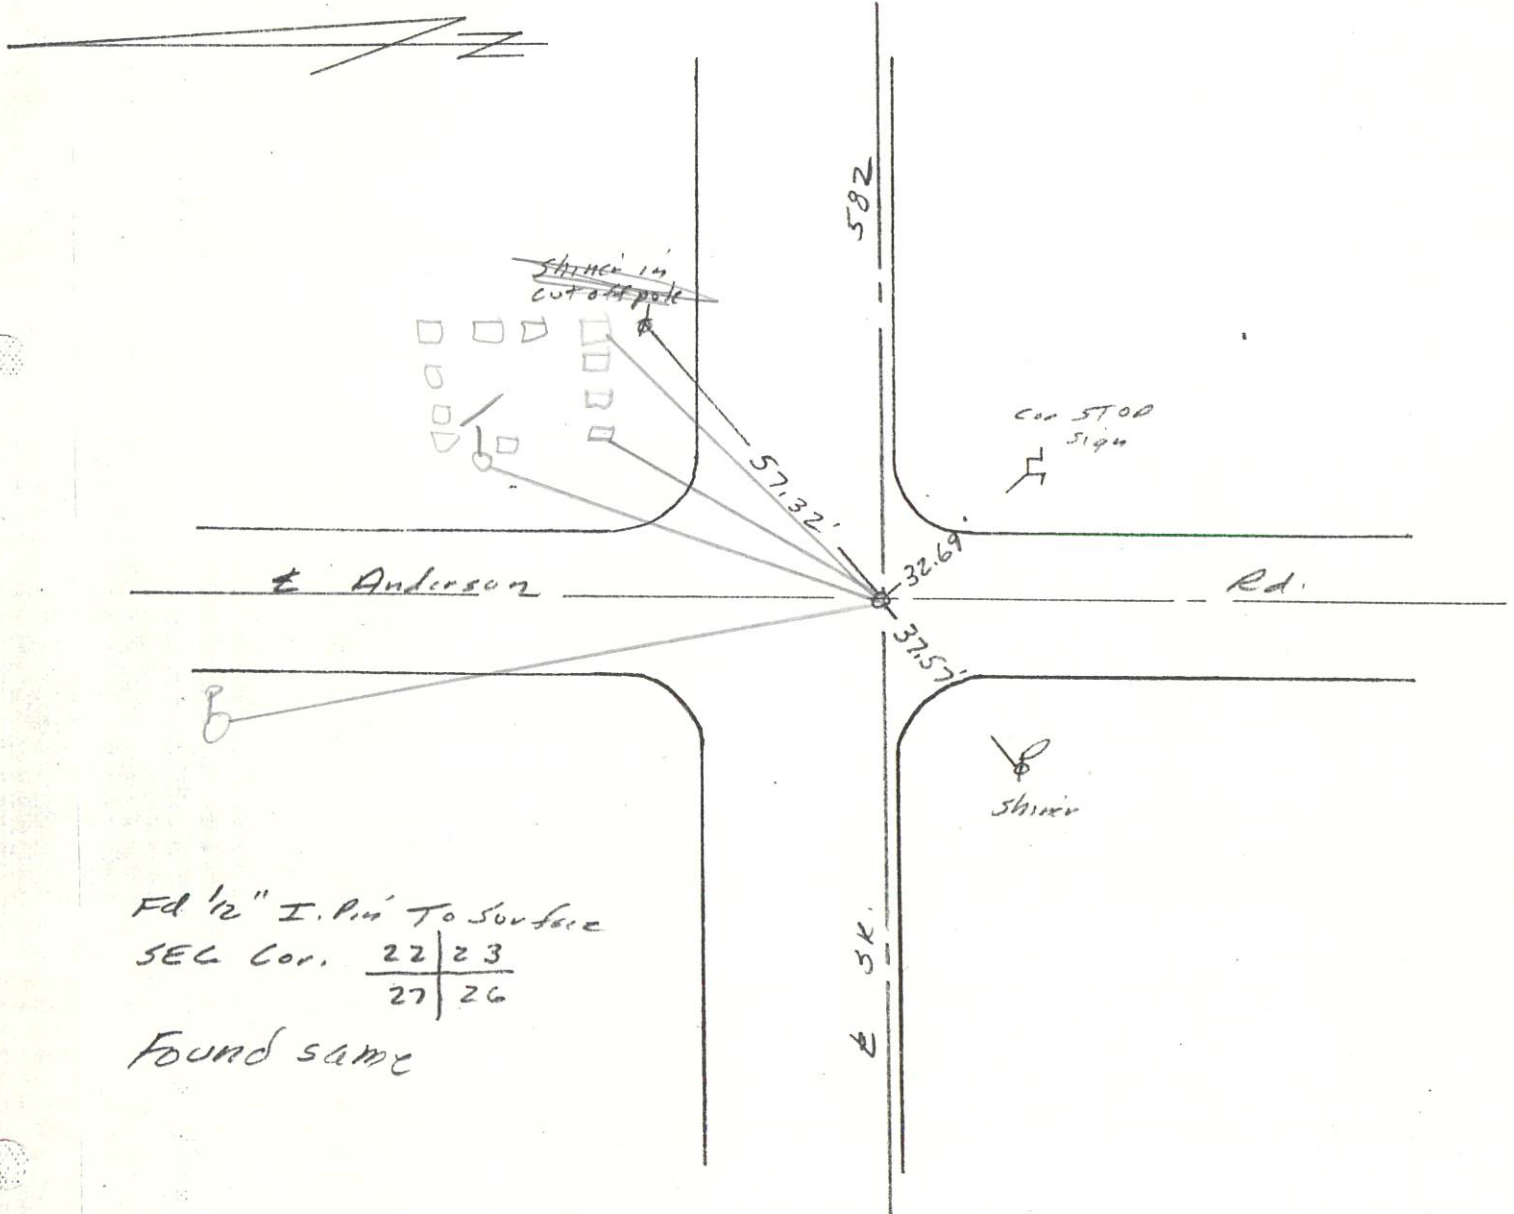

PERSONNEL	TITLE	PERSONNEL	TITLE	COUNTY	DATE
Silvester				4	
Burnside				S. R.	WEATHER
Smith				SEC.	TEMP.

DESCRIPTION *with ties for Sec* LEFT CENTER LINE RIGHT JOB NO.

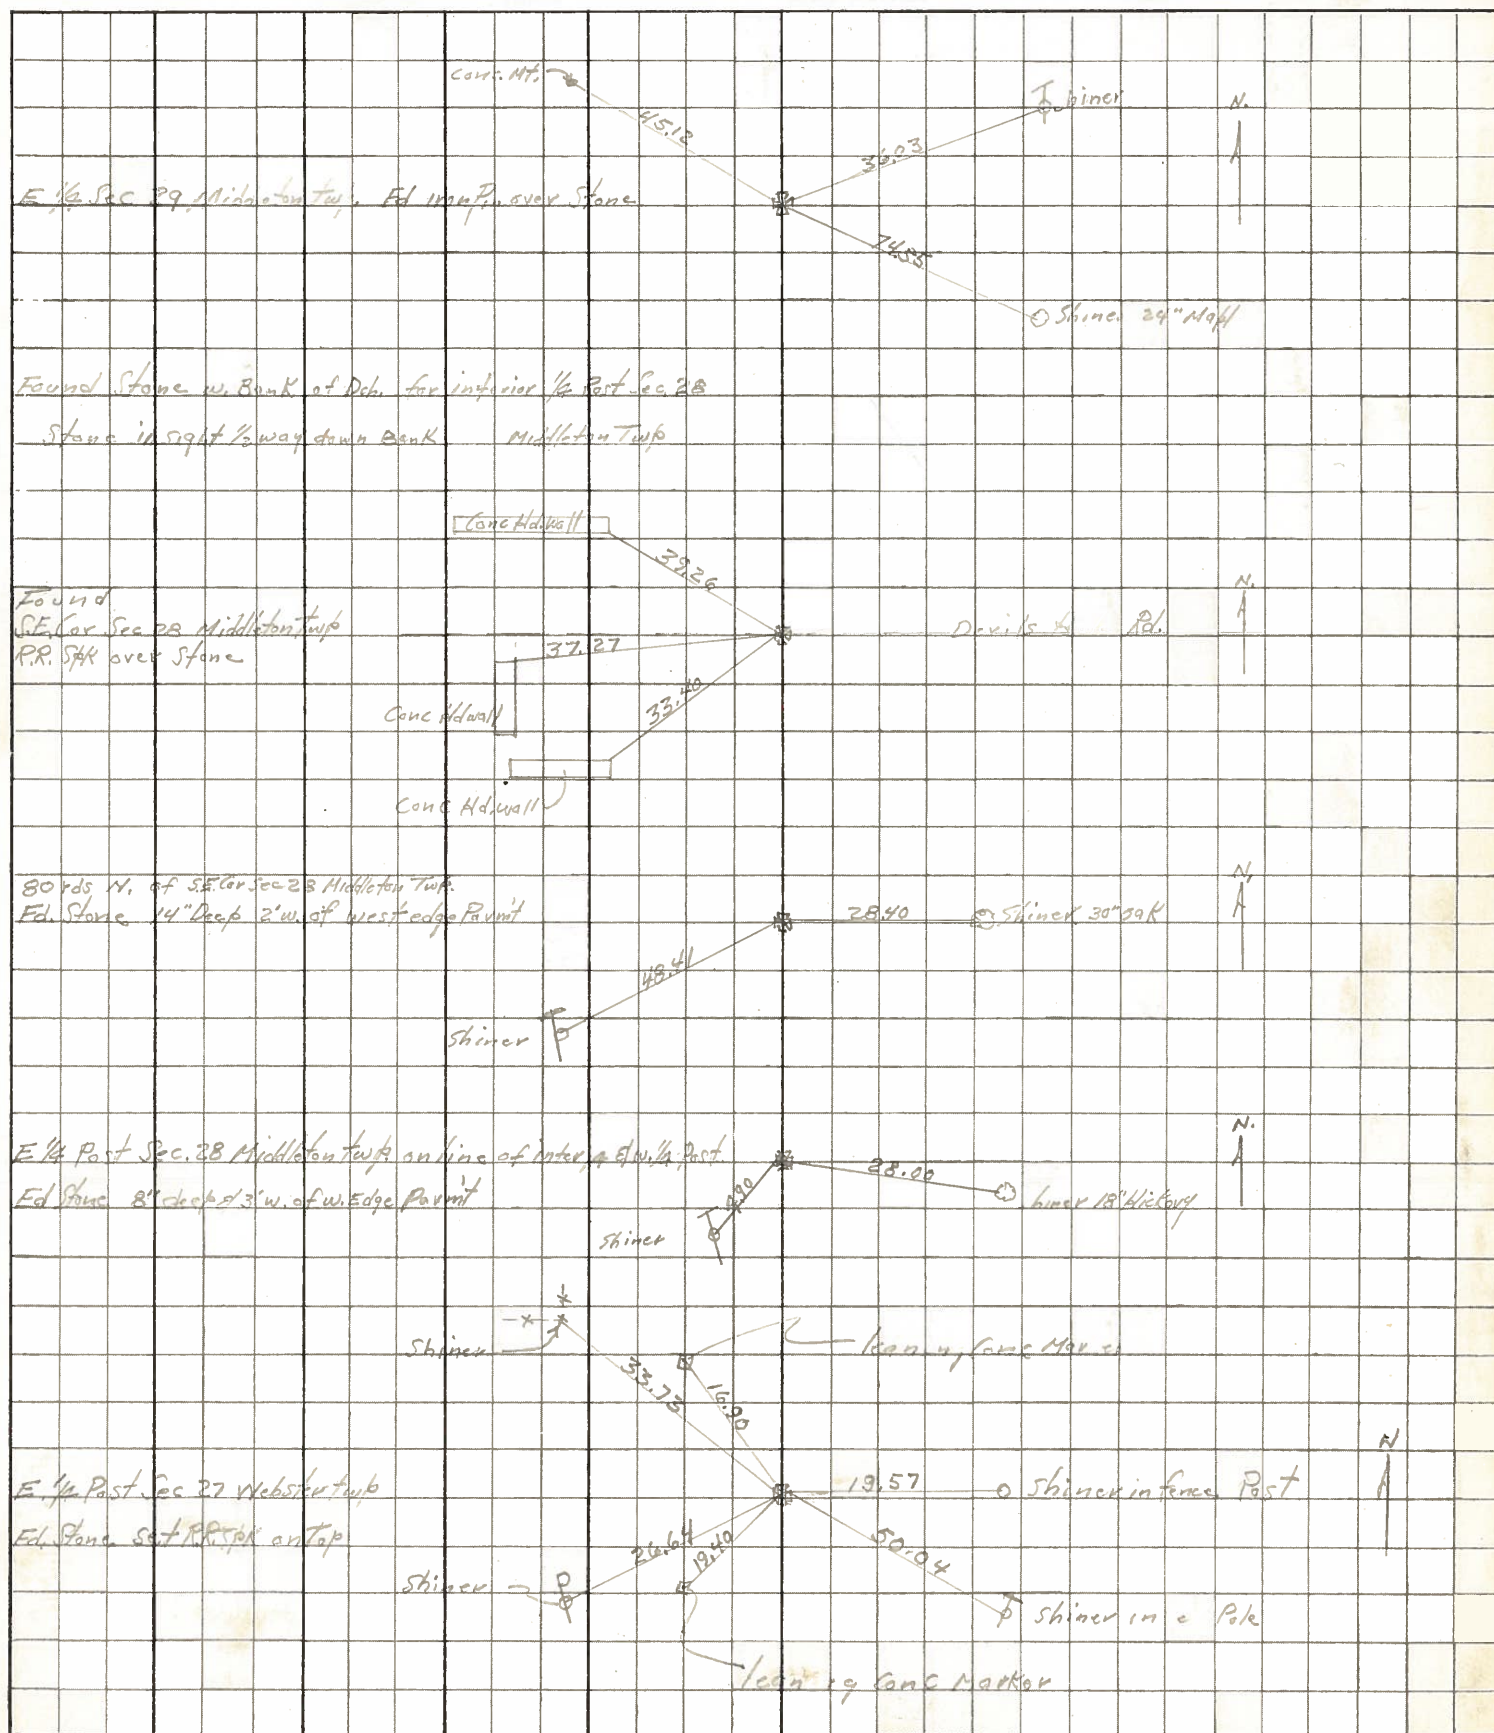

PERSONNEL TITLE PERSONNEL TITLE

COUNTY WoodDATE April, 17, 1969S. R. #582WEATHER CloudySEC. From 775 to SR #199TEMP. +75°


DESCRIPTION

Ties to Control PointsJOB NO. 027300

LEFT

CENTER LINE

RIGHT

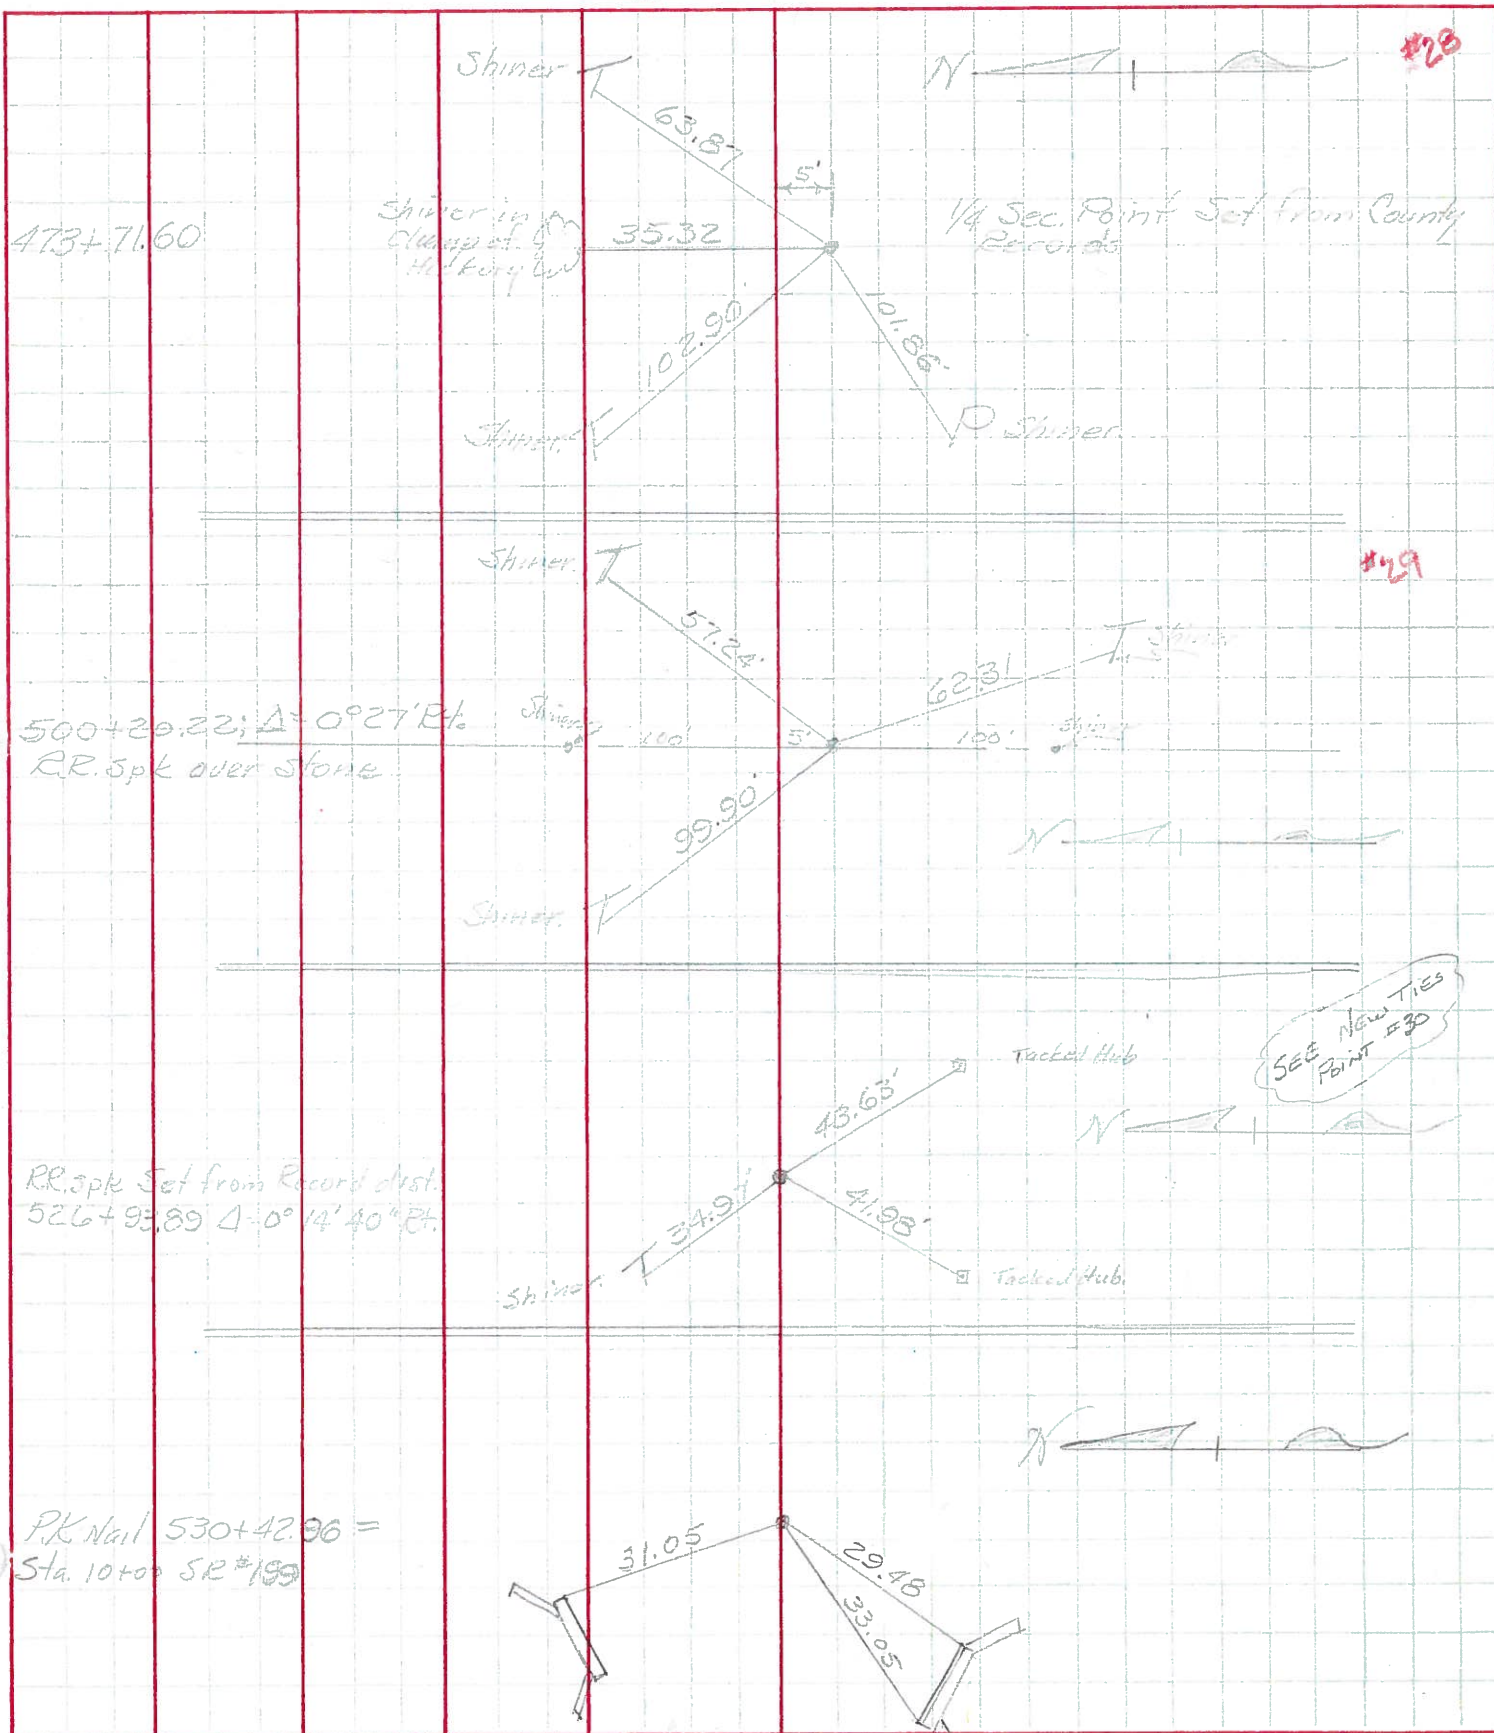

PERSONNEL TITLE PERSONNEL TITLE

COUNTY Wood DATE Aug 15 1968

S. R. 1000 WEATHER 11

SEC 1000 TEMP 75

DESCRIPTION Top of Capital Hill JOB NO. 1000

LEFT CENTER LINE RIGHT

