

O.D.O.T. DISTRICT 2 SURVEY OFFICE (USE ONLY)

PERSONNEL

REFERENCE NO. 34

SHEET 15 OF 21

NOTES MILLER
H.C. MILLER
R.C. BARRIERE

DATE 10/1/24
WEATHER CLOUDY
TEMP. 71°

ROUTE SR 582
COUNTY WOOD
TOWNSHIP WEBSTER
SECTION 30

DWG BY PRESTON-COLVIN PID PAVING TRAIN

T 6 N R 11 E

TYPE MONUMENT MAG SHANK

ON SURFACE - ~~BELOW~~ ON

OFFSET Q PAVEMENT 0.8' ~~LT~~ : RT

10.3' TO LT EDGE PAVEMENT

STATION: 636+76.8

HORIZ.DATUM: NAD83 (2011)


GEOID: NAVD88 2018

GRID: NORTHING: 653873.549

EASTING: 1690446.417

LDP: NORTHING: 476191.728

EASTING: 199272.026

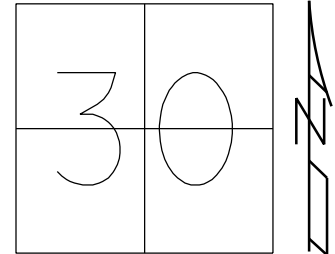


RESET MAG & WASHER
09-02-2005 M.D.B.

FND MAG & WASHER
GPS, REF 34
03-11-14, T.M.R.

FND MAG & WASHER
GPS REF 34
06-16-2015

FD MAG SHANK
REF34
10/1/24, JAM

FD MAG SHANK
10/10/24, TDN

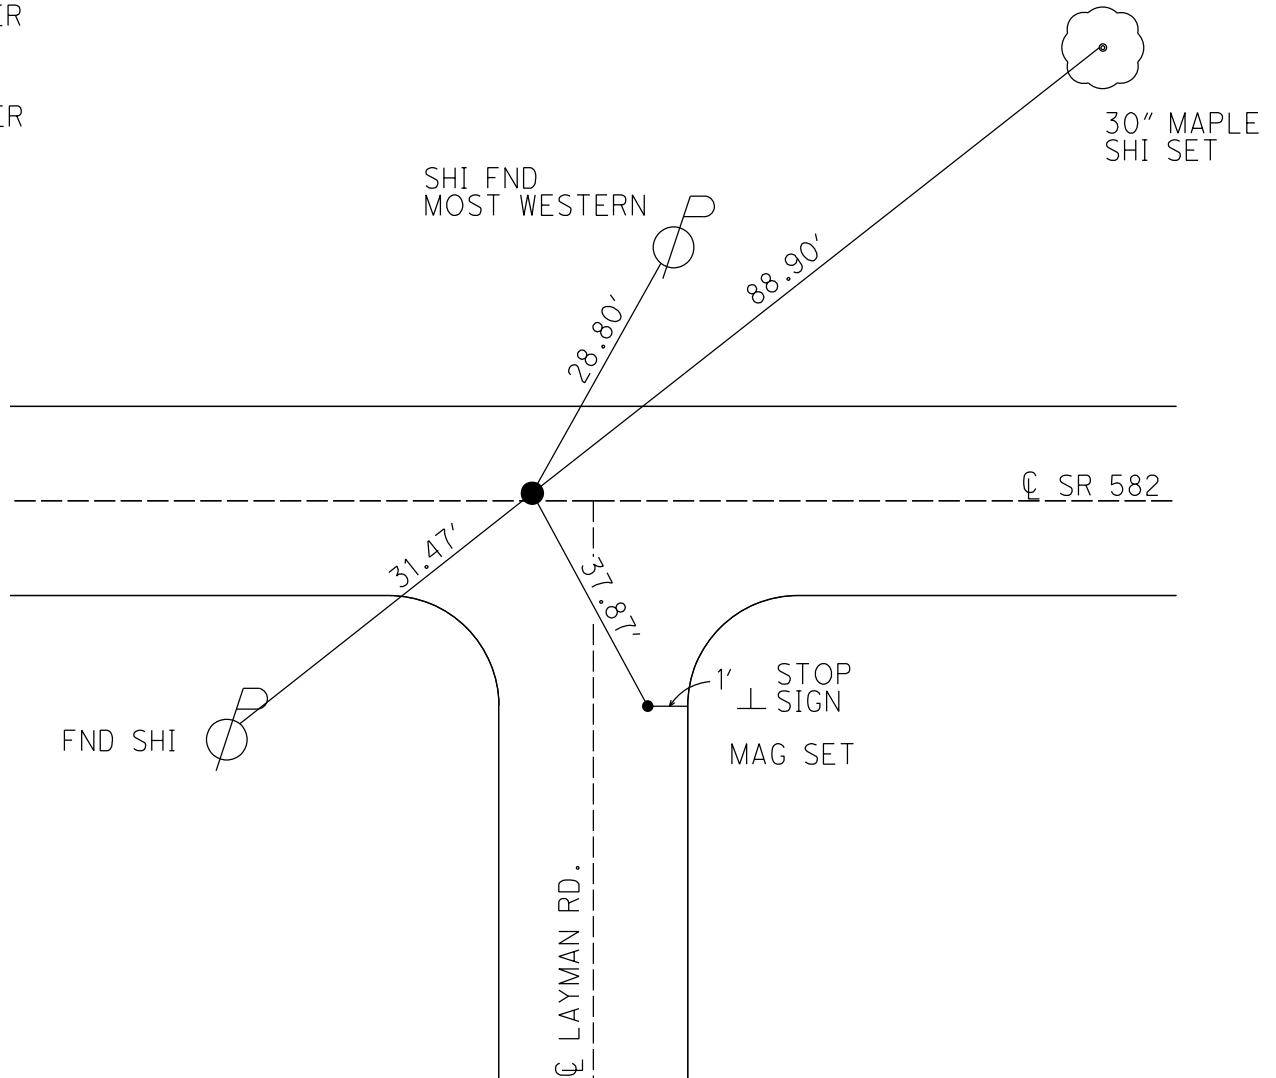

O.D.O.T. DISTRICT 2 SURVEY OFFICE (USE ONLY)

PERSONNEL

REFERENCE NO. 34

SHEET 14 OF 20

NOTES O'DONNELL

DATE 06-16-2015

ROUTE SR 582

H.C. O'DONNELL

WEATHER CLOUDY

COUNTY WOOD

R.C. RHOADES

TEMP. 71°

TOWNSHIP WEBSTER

SECTION 30

T 6 N R 11 E

TYPE MONUMENT PK NAIL


ON SURFACE - ~~BELOW~~ ON

~~LEFT~~ - ℄ PAV'T - RIGHT 0.8'

10.3' TO LT EDGE PAVEMENT

S.L.M. 636+76.8


Grid: Northing: 653873.549 Easting: 1690446.417

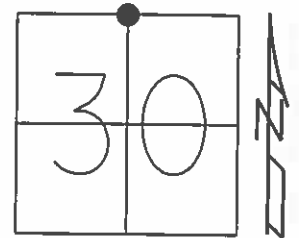

RESET MAG & WASHER
09-02-2005 M.D.B.

FND MAG & WASHER
GPS, REF 34
03-11-14, T.M.R.

FND MAG & WASHER
GPS REF 34
06-16-2015

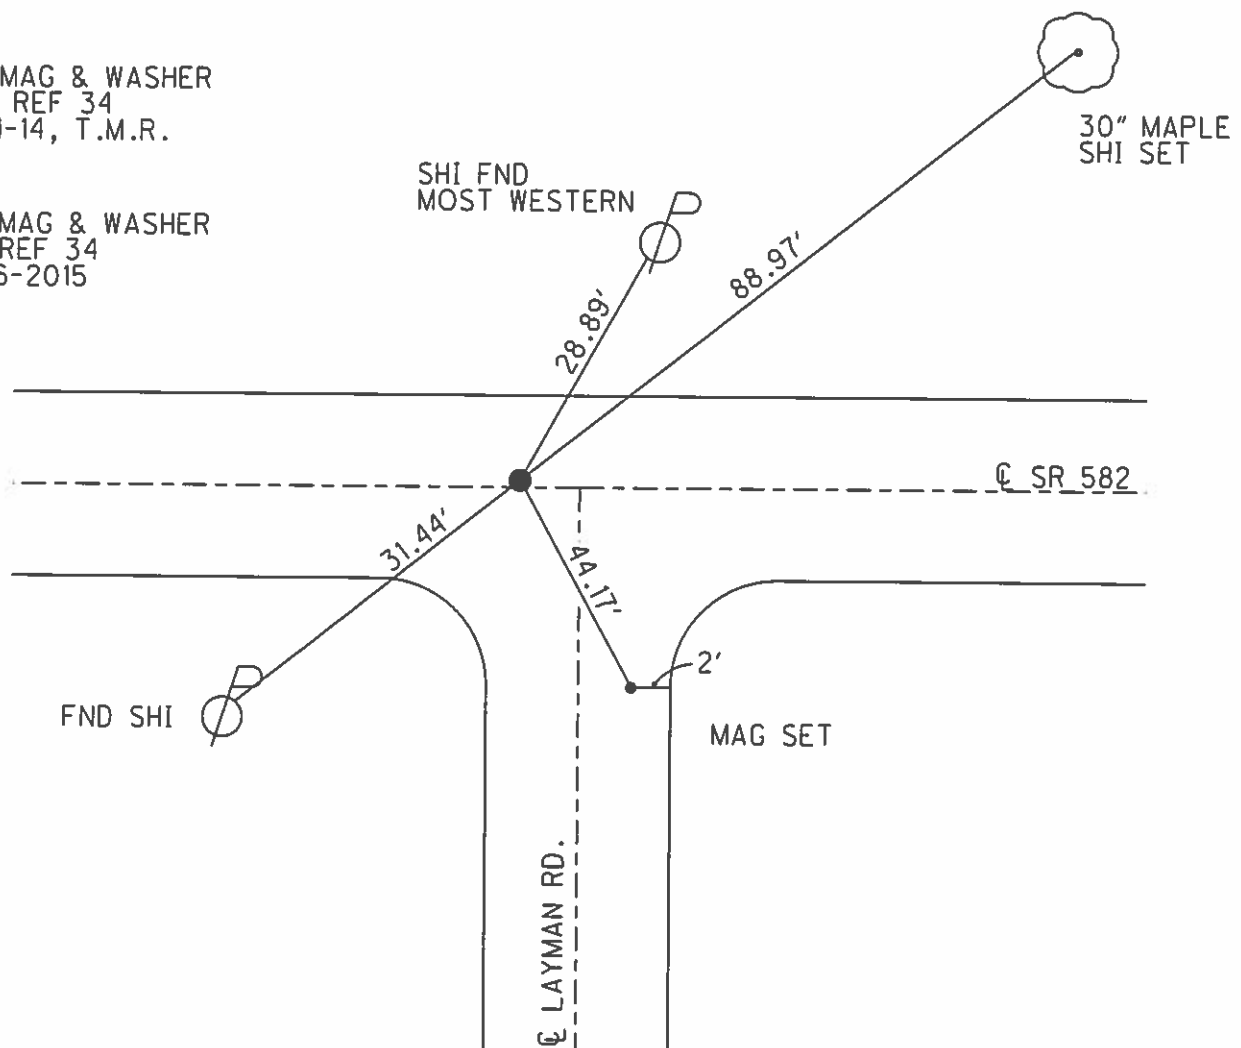

O.D.O.T. DISTRICT 2 SURVEY OFFICE

PERSONNEL

NOTES BARNHISEL
H.C. CANTERBURY
R.C. MIKLOVIC

REFERENCE NO. 34

DATE 05/20/05
WEATHER CLOUDY
TEMP. +60°

SHEET 14 OF 20

ROUTE S.R. 582
COUNTY WOOD
TOWNSHIP WEBSTER
SECTION 30
T 6 N R 11 E

TYPE MONUMENT PK NAIL

ON SURFACE - ~~BELOW~~ YES


~~LEFT~~ - Q PAV'T - RIGHT 0.8'

10.3' TO LT EDGE PAVEMENT


S.L.M. 637+17

GRID: NORTHING:

EASTING:

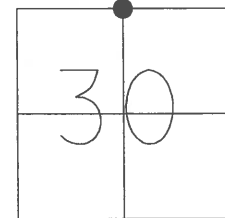

RESET MAG NAIL & WASHER
09/02/05
MDB

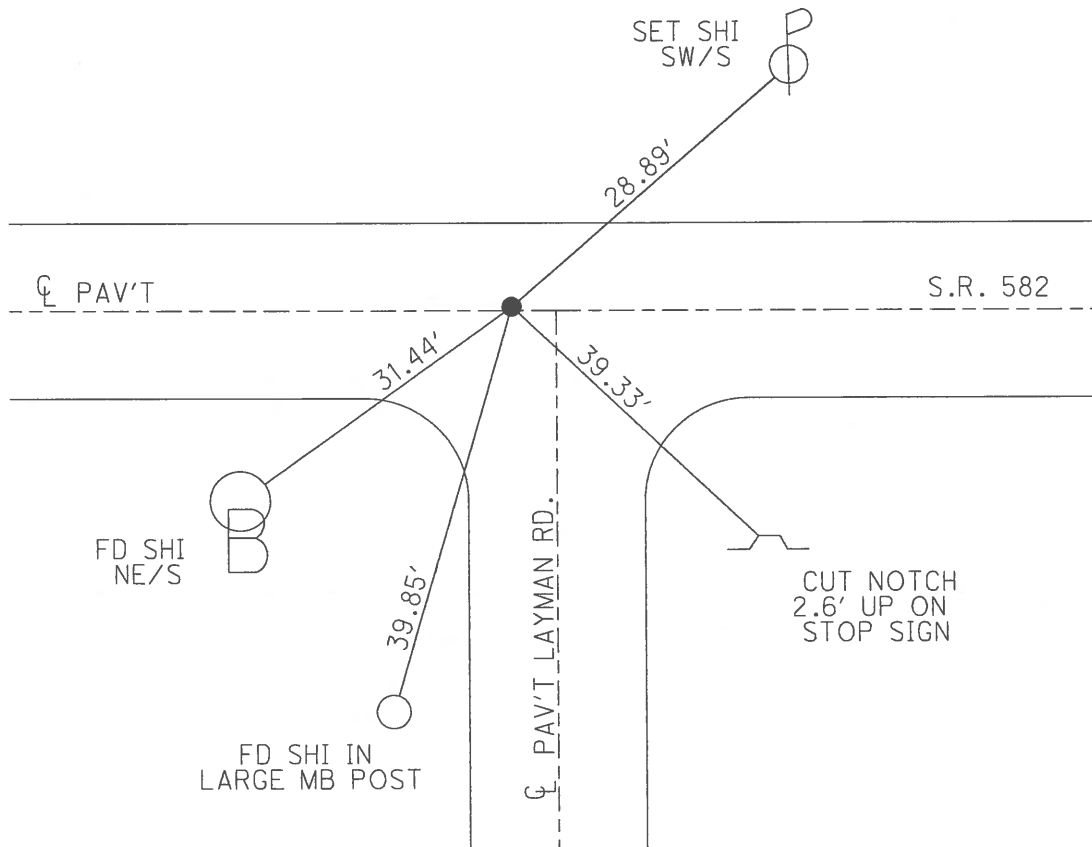

O.D.O.T. DISTRICT 2 SURVEY OFFICE

PERSONNEL

REFERENCE NO. 34

SHEET OF

NOTES LOCHKE

H.C. HOFFMAN

R.C. STEINHAUSER

BARNHISEL

DATE 7-12-90

WEATHER CLOUDY

TEMP. +70°

ROUTE S.R

COUNTY Wood

TOWNSHIP Webster

SECTION 30

T 6 N R 12 E


TYPE MONUMENT IRON PIN

~~ON SURFACE~~ - BELOW 1 1/2"


~~LEFT - C~~ PAVT. - RIGHT 0.6'

10.9 TO Lt EDGE PAVEMENT

S.L.M. 637 + 17

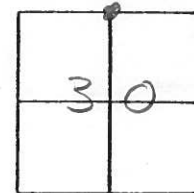

Set P.K. / Washer
10-25-90
mB

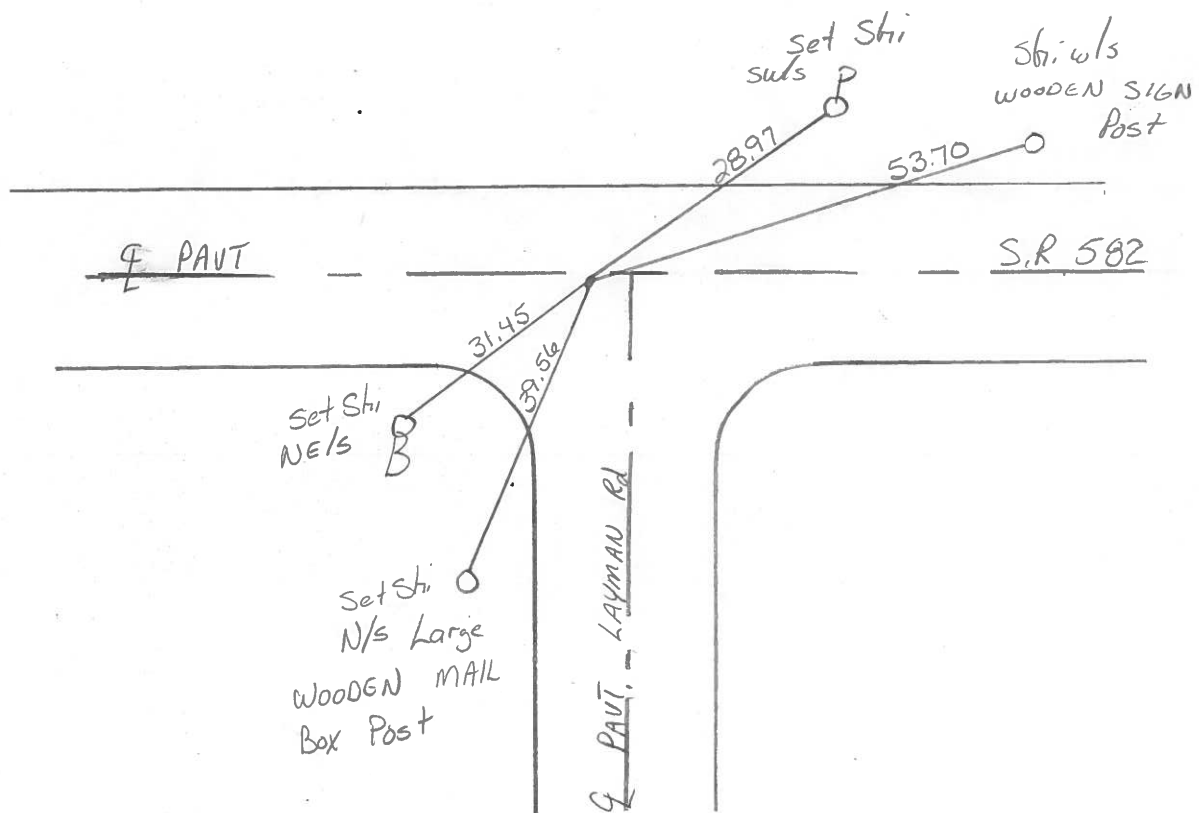

Q.D.O.T. DISTRICT 2 SURVEY OFFICE

SHEET 11 OF

County Wood S.R. 582

Township Webster

Section 19

T N, R E

Personnel 1. Stone

P. Newser


R. Michalak

D. Curtis

Date 12 July 83

Weather Warm

Temp. 85°

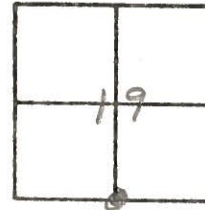

56 M Sta. 637 +23

REF. NO. 34

Egg Sign
post
Shiner

Shiner

Stop Sign


Layman Rd.

Shiner

Fd. RR Spk. To Surface
5 1/4 Cor. Sec. 19

11.2' to N edge put.

1249 24 Found

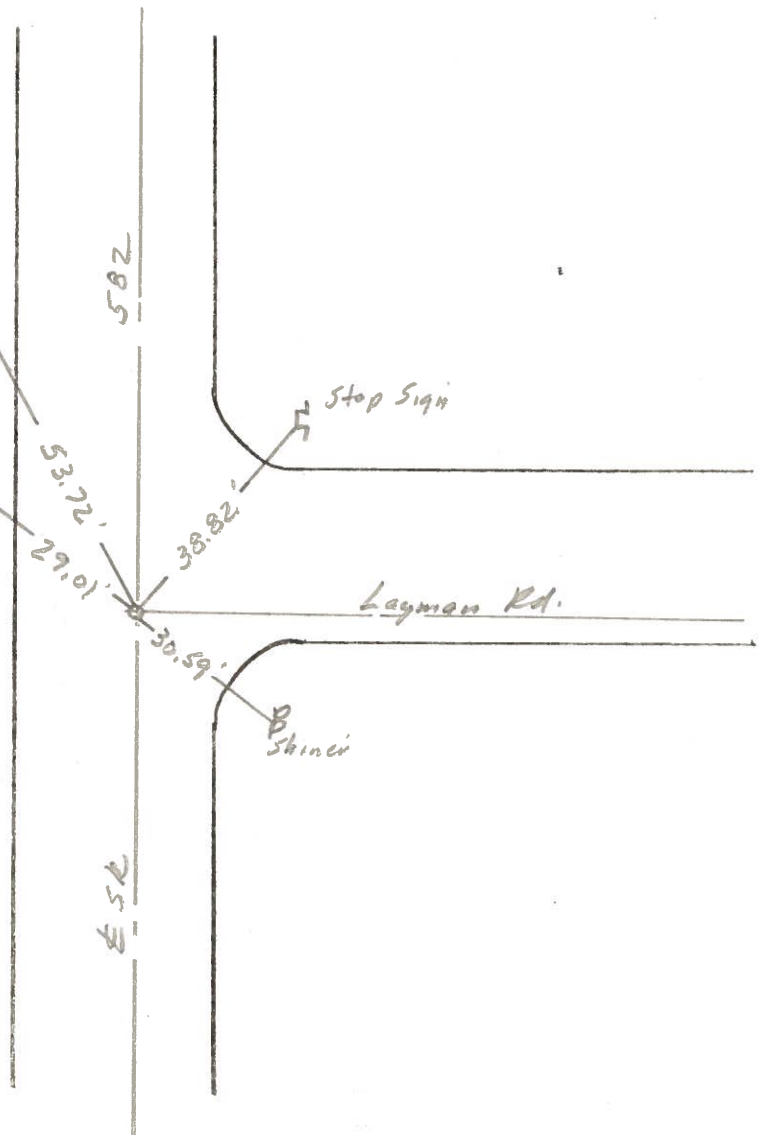

Q.D.O.T. DISTRICT 2 SURVEY OFFICE

SHEET 11 OF

County Wood S.R. 582

Date 12 July 83

Township Webster


Weather Warm

Section 19

Temp. 85°

T N, R E

Personnel 1. Stone

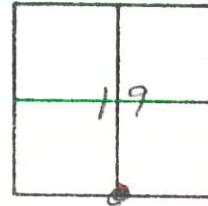

P. Newser

R. Michalak

D. Curtis

56 M Sta. 637 +23

REF. NO. 34

17

5.0 W 4 LAYMAN

0.6 S of 4 PAUL

10.9 to Lt EP

Egg Sign

OK Post

Shiner

Shiner

53.72'

29.01'

582

Stop Sign

38.82'

Layman Rd.

30.59'

Shiner

lg MAIL

Box Post

582

1 1/2"

SM.

Fd. RR Spk. To surface

5 1/4 Cor. Sec. 19

11.2' to Nedge put.

2 by 2" Found

PERSONNEL TITLE PERSONNEL TITLE

COUNTY Wood. DATE April 17, 1969

S. R. #582 WEATHER Cloudy & Windy


SEC. 199 East TEMP. +70°

DESCRIPTION Ties to Control Points JOB NO. _____

LEFT

CENTER LINE

RIGHT

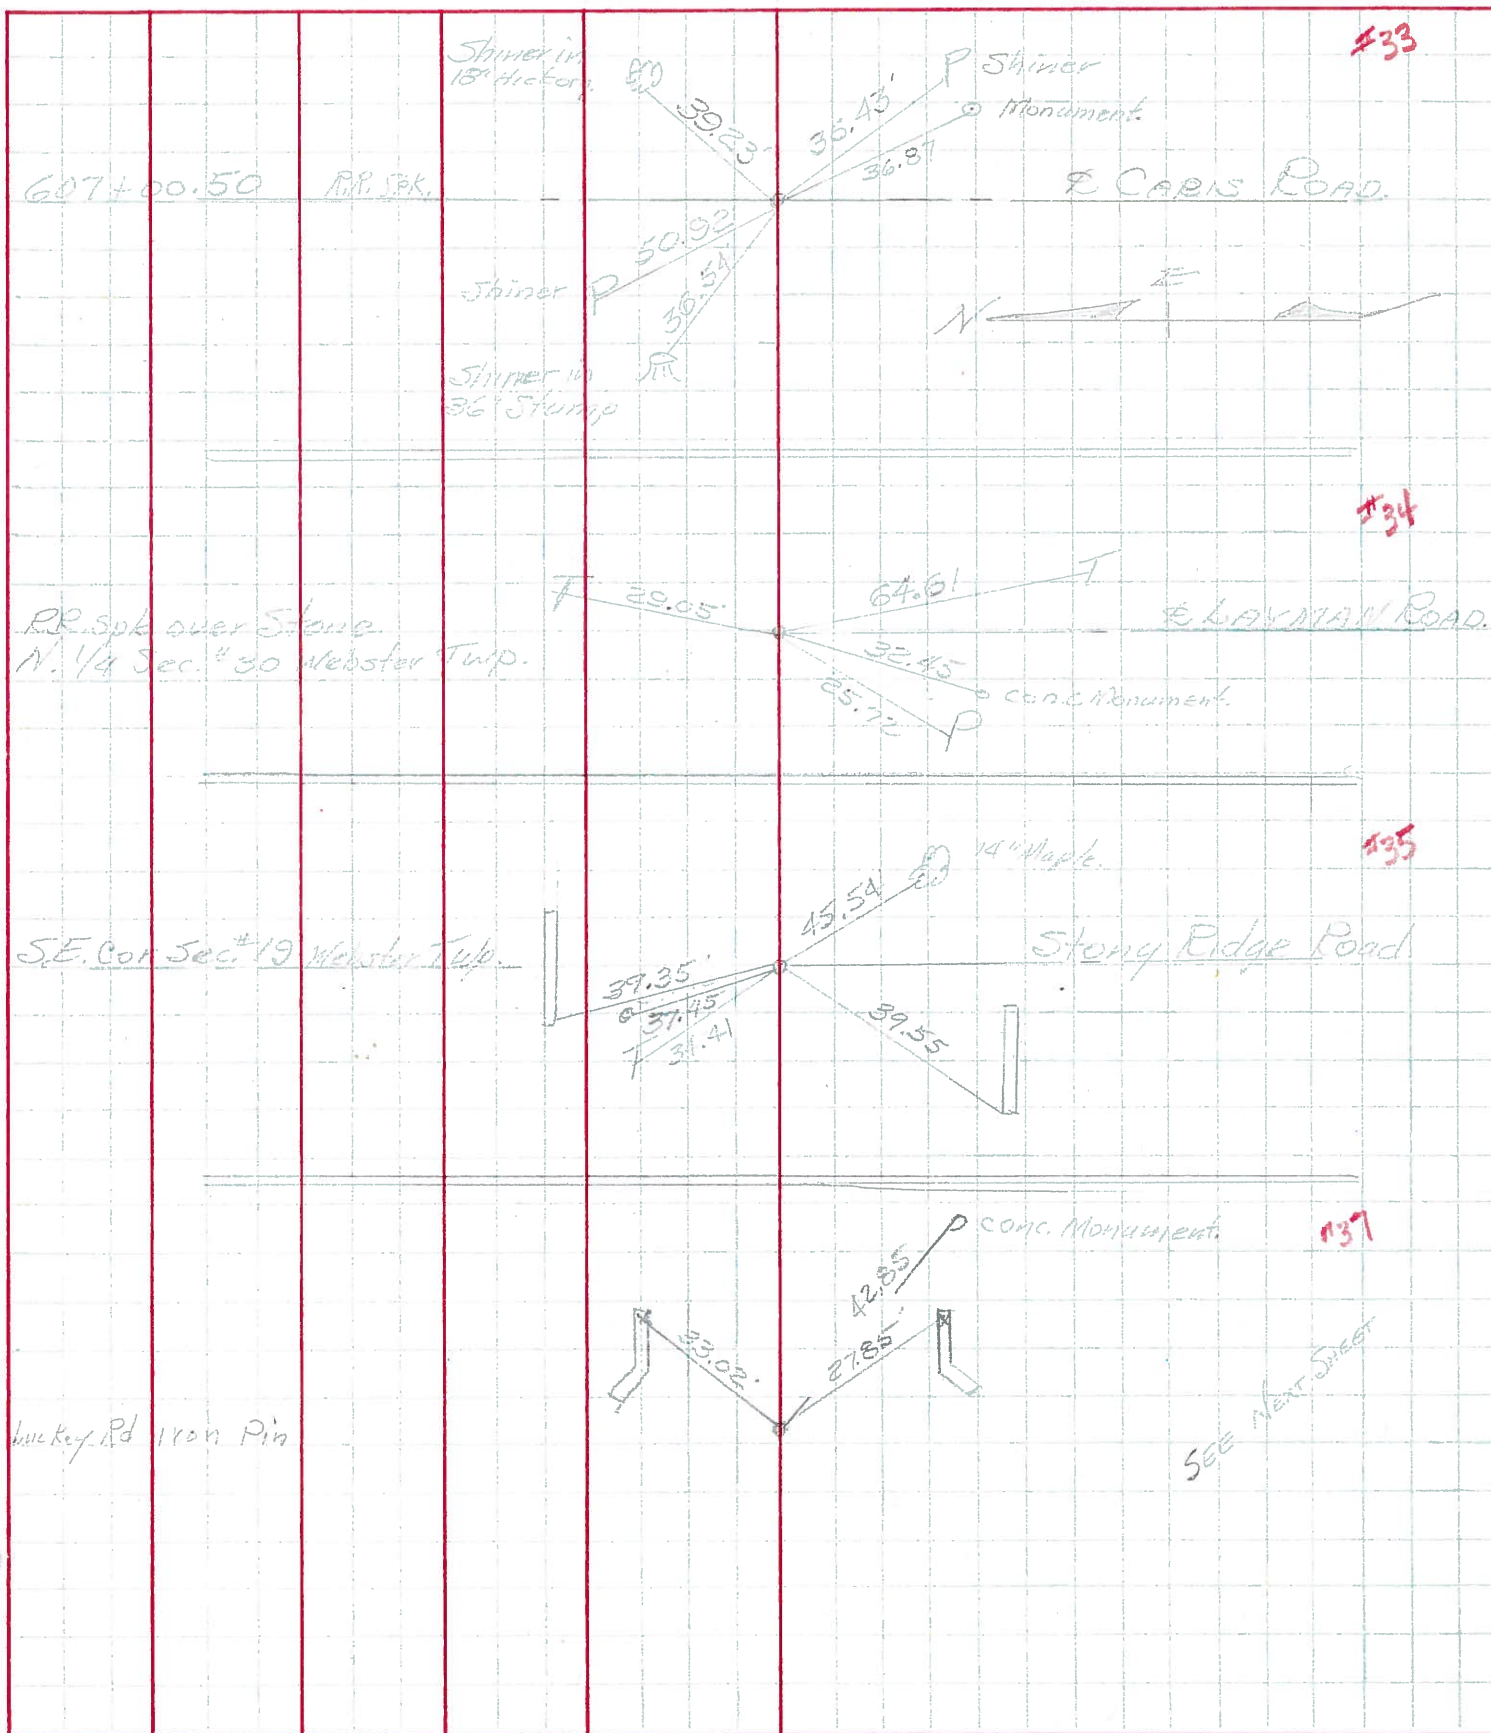

PERSONNEL TITLE PERSONNEL TITLE

COUNTY

Wood

DATE

12-27-57

S. R.

#582

WEATHER

SEC.

TEMP.

DESCRIPTION

LEFT

CENTER LINE

RIGHT

JOB NO.

Stone wit.

(10) Co. record (Caris ed)

R.R. Spk. (2" below part.) #456

9/14/65

33

S.E. cor. sec. 24-6-11

Webster Twp. Rd. Rk.

Stone 2.0' deep 9/14/65

(2) Co. record

42.50' S. of Caris Rd. Inter.

#456-A

33A

N. 1/4 post cor. 30 Webster

Twp. (Layman Rd.)

R.R. Spk. over Stone

R.R. Spk. (1" below part.)

9/14/65

#457

34

S.E. cor. sec. 19 Webster

Twp. (Stony Ridge rd.)

R.R. spike

R.R. Spk. (1" below part.)

9/14/65

#458

35

OK
C.K.New
CulvertOK
C.K.OK
C.K.OK
C.K.

Shiner in P. Pole S.S.E. 87.45'
 Shiner in 18" Hickory N.E. 39.22'
 Shiner in 36" Catalpa N.W. 36.50'
 End of W. Bridge Girder 13.46' 12.5'
 End of E. Bridge Girder 17.35' 17.6'
 Binc. Mon. S.E. 37.0'
 Shiner in P.P. N.W. 50.92' 50.92'
 Shiner in P.P. S.E. 36.45'
 S. point of S.E. wing 19.0'
 S. point of S.W. wing 13.6'
 Conc. monument N.E. 25.35'
 Conc. monument N.W. 12.8'
 Shi. in P. Pole S.S.E. 46.95'
 Shi. 18" Hickory N.N.E. 74.45'
 Shiner Tele. Pole S.E. 64.60'
 Binc. Mon. S.E. 48.9'
 Corner Mon. S.W. 32.45' 32.47'
 X in N.E. Cor. C.R. Twp. N.E. 21.40' 21.37'
 Shiner in P. Pole S.W. 25.67'
 Shiner in Tele Pole N.E. 28.75'
 Binc. marker N.W. 37.26'
 Round ditch marker S.W. 35.60'
 E. point conc. coping on S.E. wing S.W. 33.40' 45.1'
 N.W. Cor. Conc. coping on S bulkhead S.W. 39.57' 53.1'
 S.W. Cor. Conc. coping on N bulkhead N.W. 39.35'
 E. point conc. coping on N.E. wing N.W. 31.37'
 S.E. Shiner 14" Maple 45.55' 45.61'
 N.W. Shiner Tele. Pole 34.40'

PERSONNEL	TITLE	PERSONNEL	TITLE

COUNTY Wood DATE 12-27-57
Sorden 4-4-60
 S. R. #582 WEATHER _____
 SEC. _____ TEMP. _____

DESCRIPTION	LEFT	CENTER LINE	RIGHT	JOB NO.
Stone wit.		O.K.	Shiner in P. Pole S.S.E. 87.45'	
(10) - Co. record (Caris Rd)			Shiner in 18" Hickory N.E. 39.22'	
#456			Shiner in 36" Catalpa N.W. 36.50'	
33			N. end of W. Bridge Girder 13.40' 13.5'	
S.E. cor. sec. 24-6-11			N. end of E. Bridge Girder 17.35 17.6'	
Webster twp.			Conc. man. S.E. 37.0'	
Stone 2.0' deep			Shiner in P.P. N.W. 50.92' 50.95'	
(2) - Co. record		O.K.	S. point of S.E. wing 19.0	
#456			S. point of S.W. wing 13.5	
33A			Conc. monument N.E. 25.35	
N. 1/4 post sec. 30 Webster			Conc. monument N.W. 12.8'	
Twp. (Layman Rd.)				
E.E. spike over stone		O.K.	Shiner Tele. Pole S.E. 64.60'	
#457			Conc. man. S.E. 48.9	
34			Conc. man. S.W. 32.45 32.49	
S.E. cor. sec. 19 Webster			X in N.E. Cor. C.B. Top N.E. 21.40 21.39	
Twp. (Stony Ridge Rd.)			Shiner in P. Pole S.W. 25.67	
E.E. spike		O.K.	Shiner in Tele. Pole N.E. 28.75	
#458			Conc. marker N.W. 37.36	
35			Round ditch marker S.W. 35.68	
			E. point Conc. Coping on S.E. Wing S.W. 33.40	
			N.W. Cor. Conc. Coping on S bulkhead S.W. 39.57	
			S.W. Cor. Conc. Coping on N bulkhead N.W. 39.35	
			E. point Conc. Coping on N.E. Wing N.W. 31.37	
			S.E. Shiner 14" Maple 45.61'	
			N.W. Shiner Tele. Pole 34.40	