

O.D.O.T. DISTRICT 2 SURVEY OFFICE (USE ONLY)

PERSONNEL

REFERENCE NO. 35

SHEET 16 OF 21

NOTES MILLER

DATE 10/1/24

ROUTE SR 582

H.C. MILLER

WEATHER CLOUDY

COUNTY WOOD

R.C. BARRIERE

TEMP. 71°

TOWNSHIP WEBSTER

SECTION 29

DWG BY PRESTON-COLVIN PID PAVING TRAIN

T 6 N R 11 E

TYPE MONUMENT MAG/WASHER

ON SURFACE - ~~BELOW~~ ON

OFFSET $\varnothing$ PAVEMENT 2.5" ~~LT~~ : RT

9' TO LT EDGE PAVEMENT

STATION: 663+35.82

HORIZ.DATUM: NAD83 (2011)


GEOID: NAVD88 2018

GRID: NORTHING: 653854.021

EASTING: 1691169.064

LDP: NORTHING: 476206.86

EASTING: 201931.166

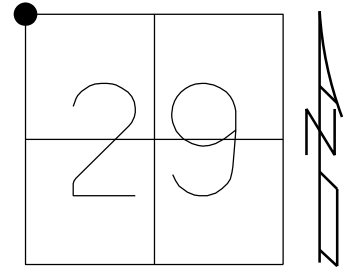


RESET MAG & WASHER
09-02-2005 M.D.B.

FND MAG & WASHER
GPS, REF 35
03-11-14, T.M.R.

FND MAG & WASHER
GPS REF 35
06-16-2015

FD MAG/WASHER
REF 35
10/1/24, JAM

FD MAG/WASHER
10/10/24, TDN

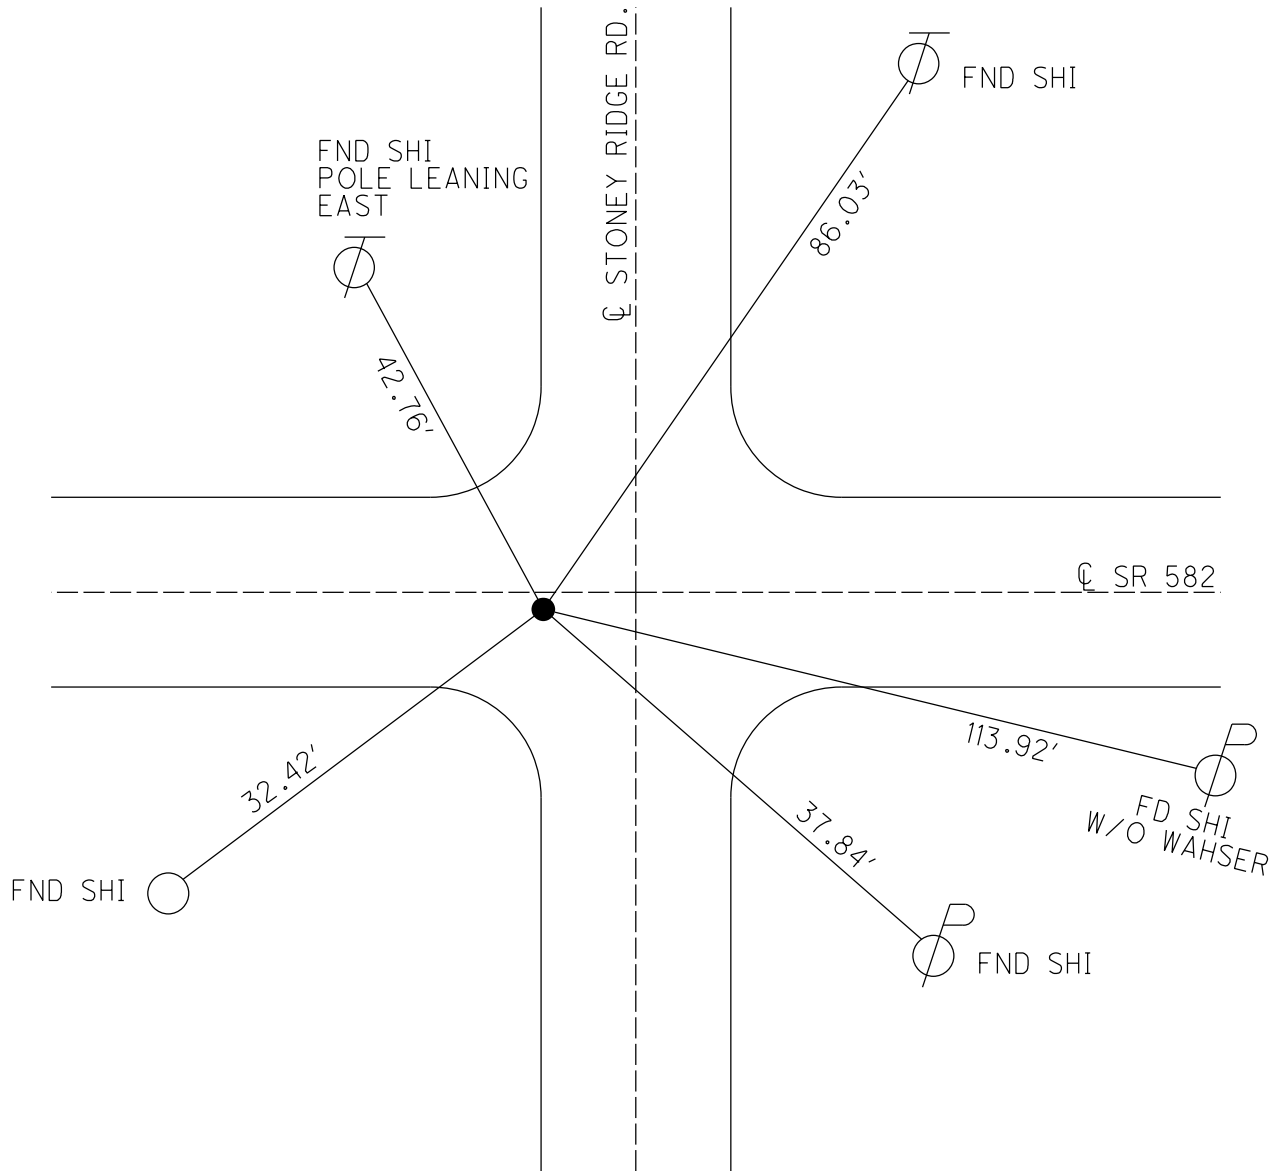

O.D.O.T. DISTRICT 2 SURVEY OFFICE (USE ONLY)

PERSONNEL

REFERENCE NO.

35

SHEET

15

OF

20

NOTES O'DONNELL

DATE

06-16-2015

ROUTE

SR 582

H.C. O'DONNELL

WEATHER

CLOUDY

COUNTY

WOOD

R.C. RHOADES

TEMP.

71°

TOWNSHIP

WEBSTER

SECTION

29

T 6 N

R 11 E

TYPE MONUMENT IPIN


~~ON SURFACE~~ - BELOW 2.5"

~~LEFT~~ - ℄ PAV'T - RIGHT 2.9', 9.0' W. OF ℄ S.

- TO - EDGE PAVEMENT

S.L.M. 663+35.82


Grid: Northing: 653854.021 Easting: 1691169.064

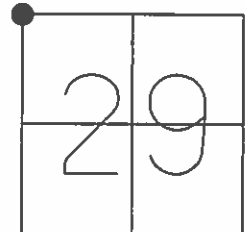

RESET MAG & WASHER
09-02-2005 M.D.B.

FND MAG & WASHER
GPS, REF 35
03-11-14, T.M.R.

FND MAG & WASHER
GPS REF 35
06-16-2015

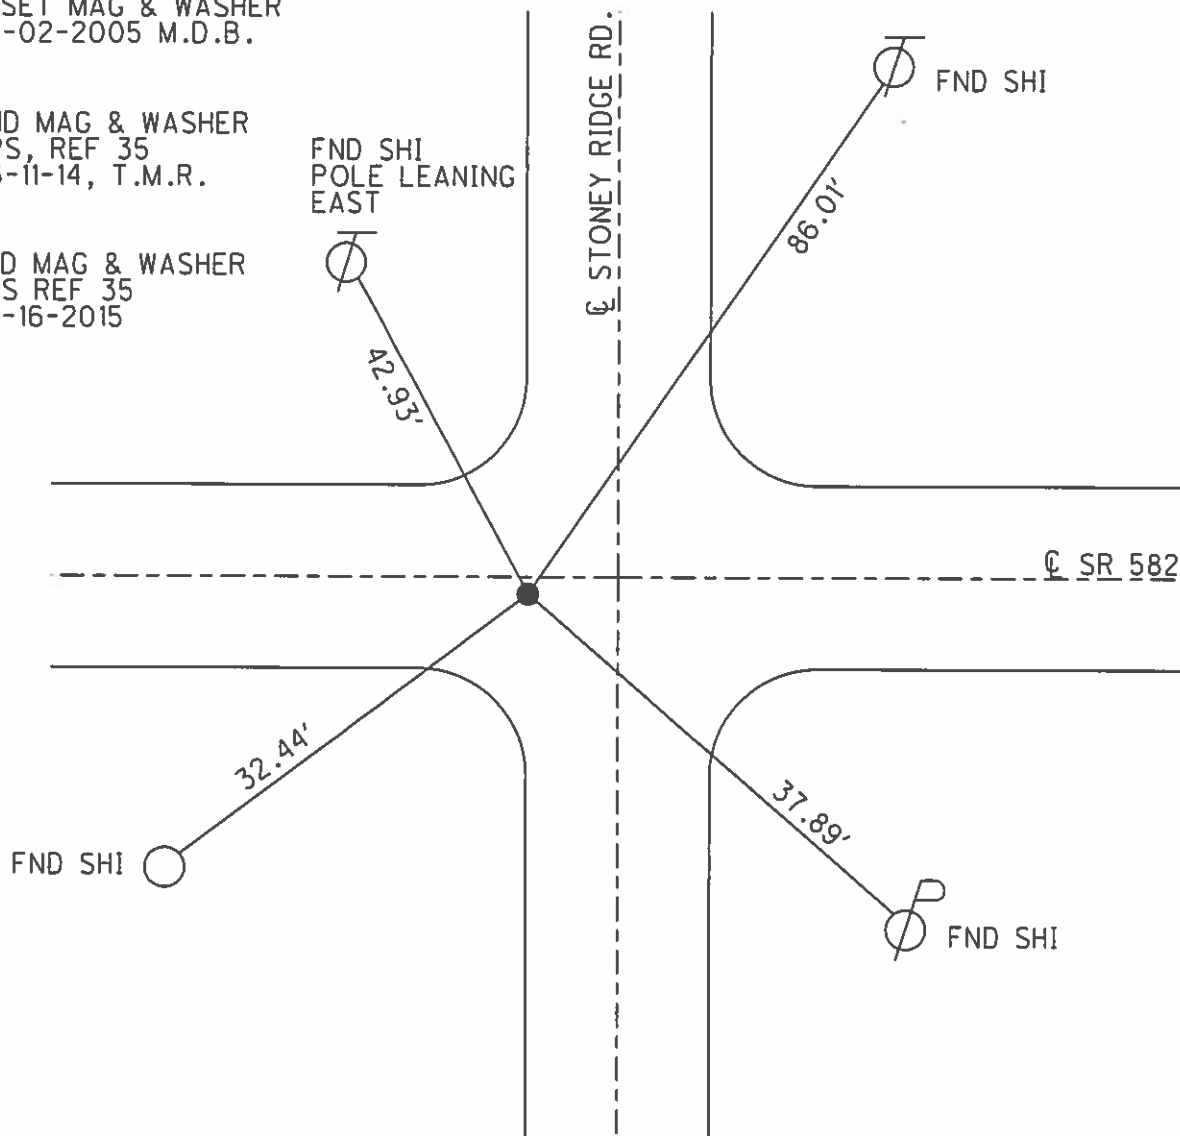

O.D.O.T. DISTRICT 2 SURVEY OFFICE

PERSONNEL

REFERENCE NO. 35

SHEET 15 OF 20

NOTES BARNHISEL

DATE 05/20/05

ROUTE S.R. 582

H.C. CANTERBURY

WEATHER CLOUDY

COUNTY WOOD

R.C. MIKLOVIC

TEMP. +60°

TOWNSHIP WEBSTER

SECTION 29

T 6 N R 11 E


TYPE MONUMENT IRON PIN

~~ON SURFACE~~ - BELOW 2.5"

~~LEFT~~ - C PAV'T - RIGHT 2.9'

TO EDGE PAVEMENT


S.L.M. 663+80, 9.0' W. OF C SOUTH

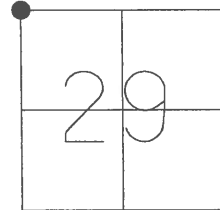

GRID: NORTHING:

EASTING:

RESET MAG NAIL & WASHER
09/02/05
MDB

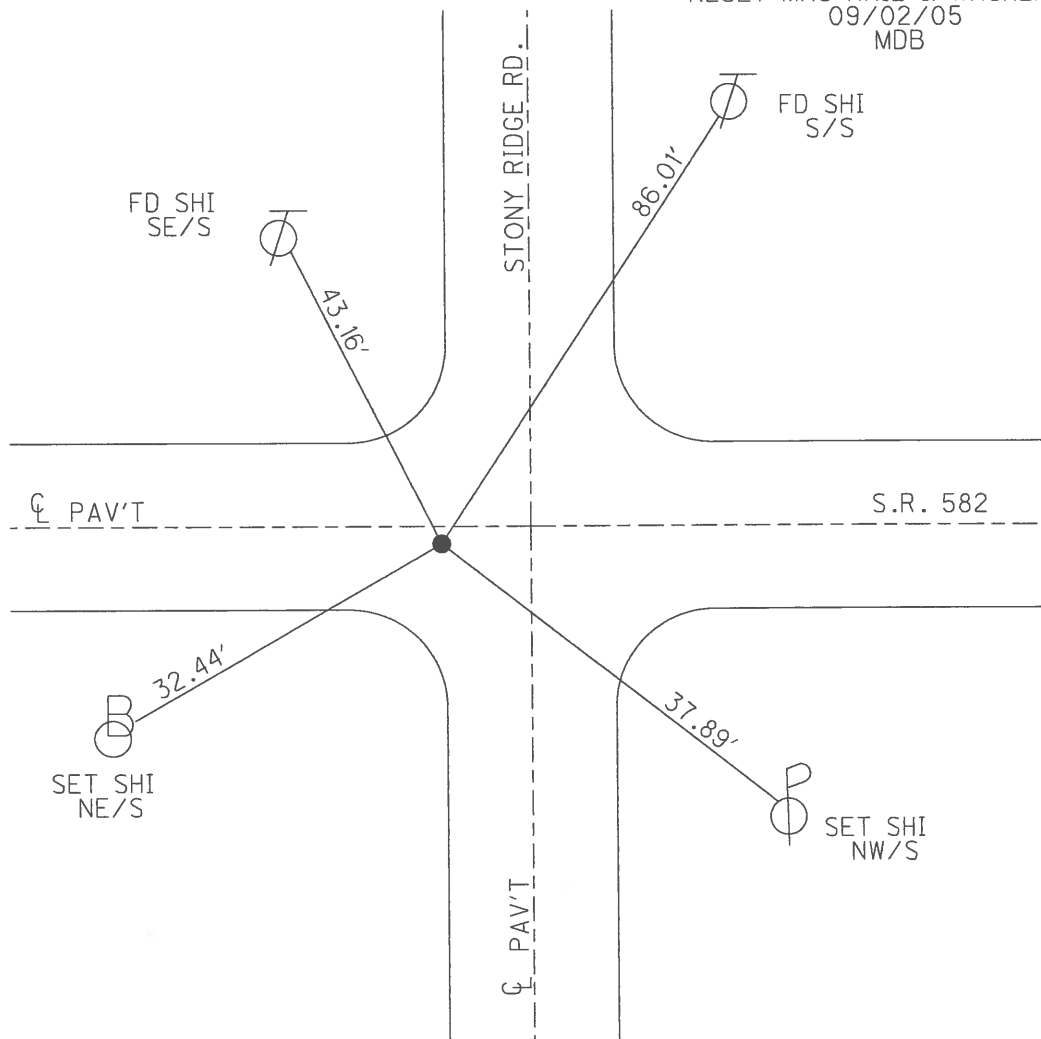

O.D.O.T. DISTRICT 2 SURVEY OFFICE

PERSONNEL

REFERENCE NO. 35

SHEET OF

NOTES LOCHRKE

H.C. HOFFMAN

R.C. STEINHAUSER

BARNHISEL

DATE 7-12-90

WEATHER CLOUDY / WINDY

TEMP. +70°

ROUTE S.R. 582

COUNTY WOOD

TOWNSHIP Webster

SECTION 29

T. 6 N. R. 12 E



TYPE MONUMENT IRON PIN

ON SURFACE - BELOW 1 1/2"

LEFT - & PAV'T. - RIGHT 2.9 / 9.0 W of & Rd

- TO - EDGE PAVEMENT

S.L.M. 663 +80

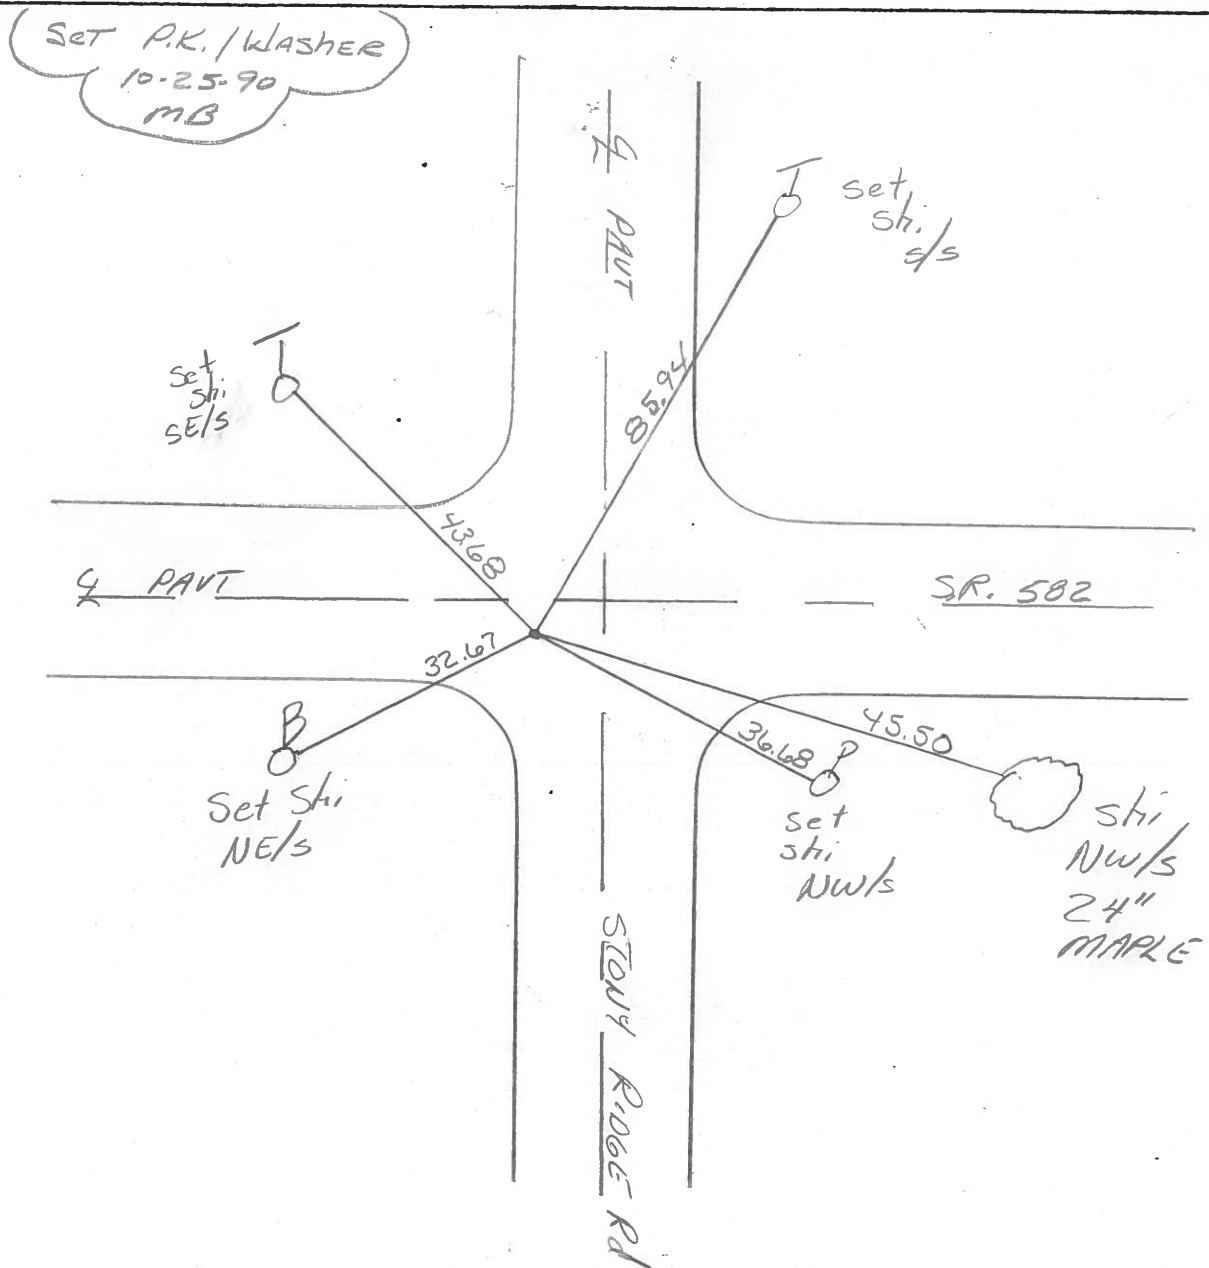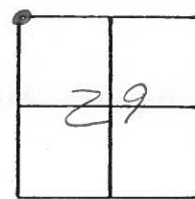

Q.D.O.T. DISTRICT 2 SURVEY OFFICE

SHEET 12 OF

County Wood S.R. 582

Township Webster

Section 19-20-29-30

T N, R E

Personnel I. Stone

P. Neusca

R. Michalak

D. Curtis

Date 12 July 83

Weather Warm


Temp. 85°

19	20
30	29



SLM Sta. 663+83

REF. NO. 35

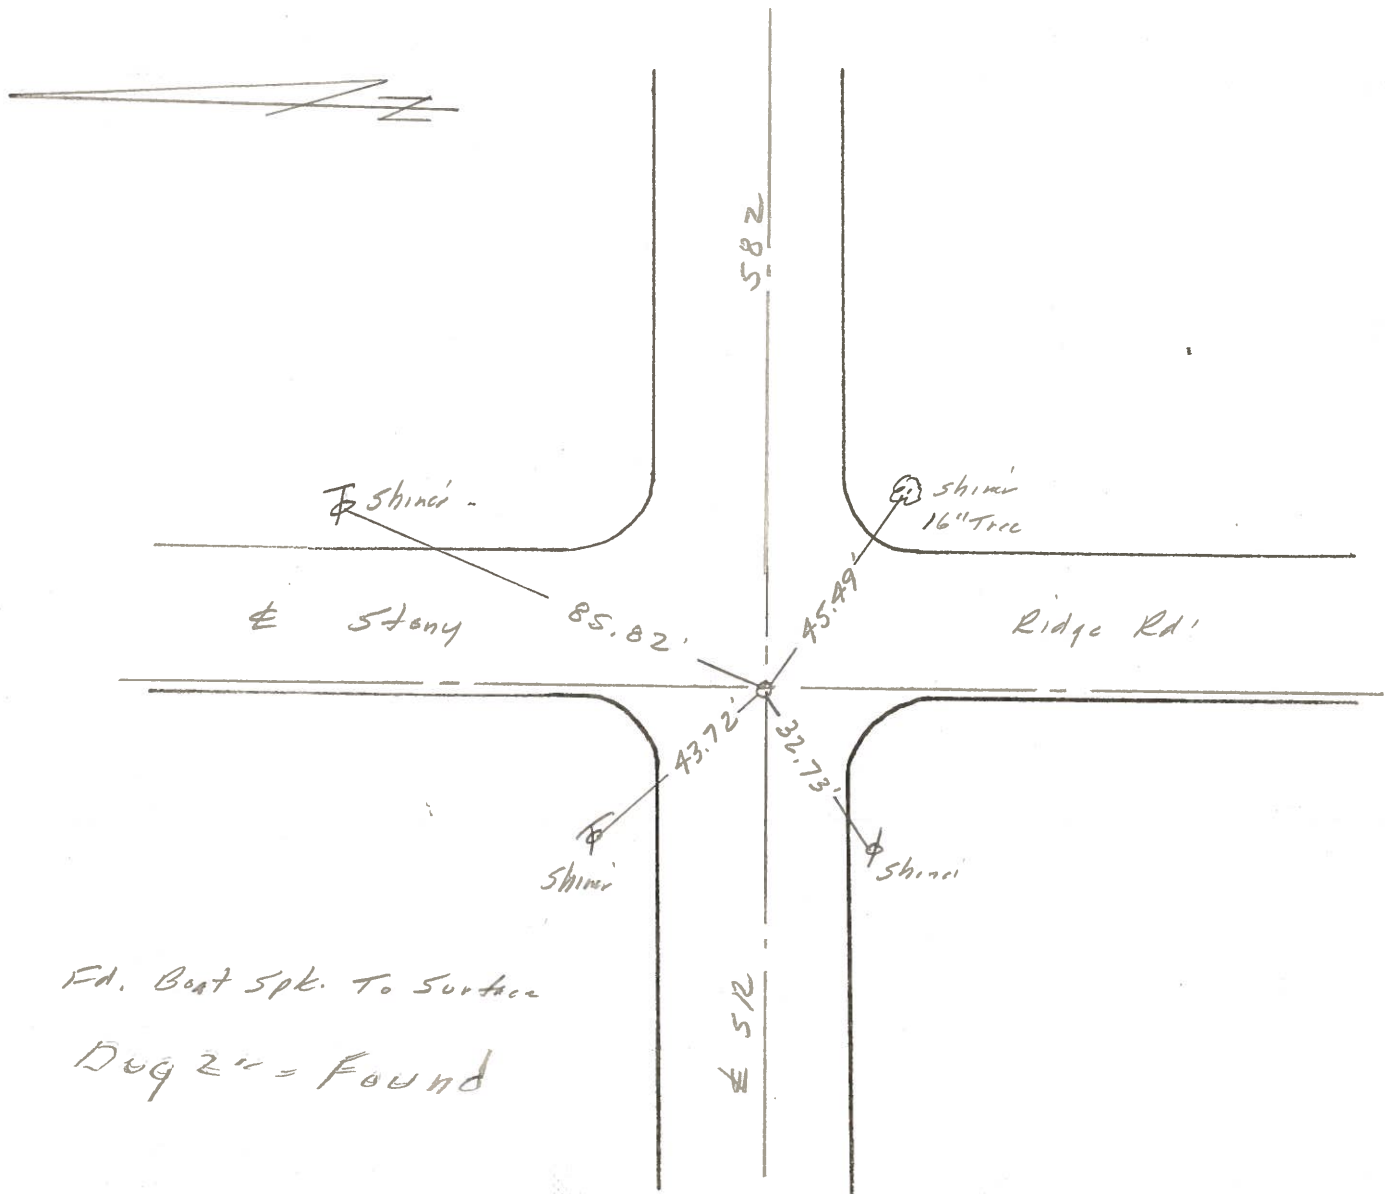

Fd. Boat Spk. To Surface

Dug 2' = Found

Q.D.O.T. DISTRICT 2 SURVEY OFFICE

SHEET 12 OF

County Wood S.R. 582

Date 12 July 83

Township Webster

Weather Warm

Section 19-20-29-30

Temp. 85°

T.N, R.E

Personnel I. Stone

P. Neuser

R. Michalak

D. Curtis

19	20
30	29



SLM Sta. 663+83

REF. NO. 35

140

2.9 Sol

9.0 W of S. Rd

Shiner

Stony

85.82

582

45.49

Ridge Rd

43.72

32.73

Shiner


Shiner

Ed. Best Spk. To Surface

Dug 2" = Found

512

PERSONNEL TITLE PERSONNEL TITLE

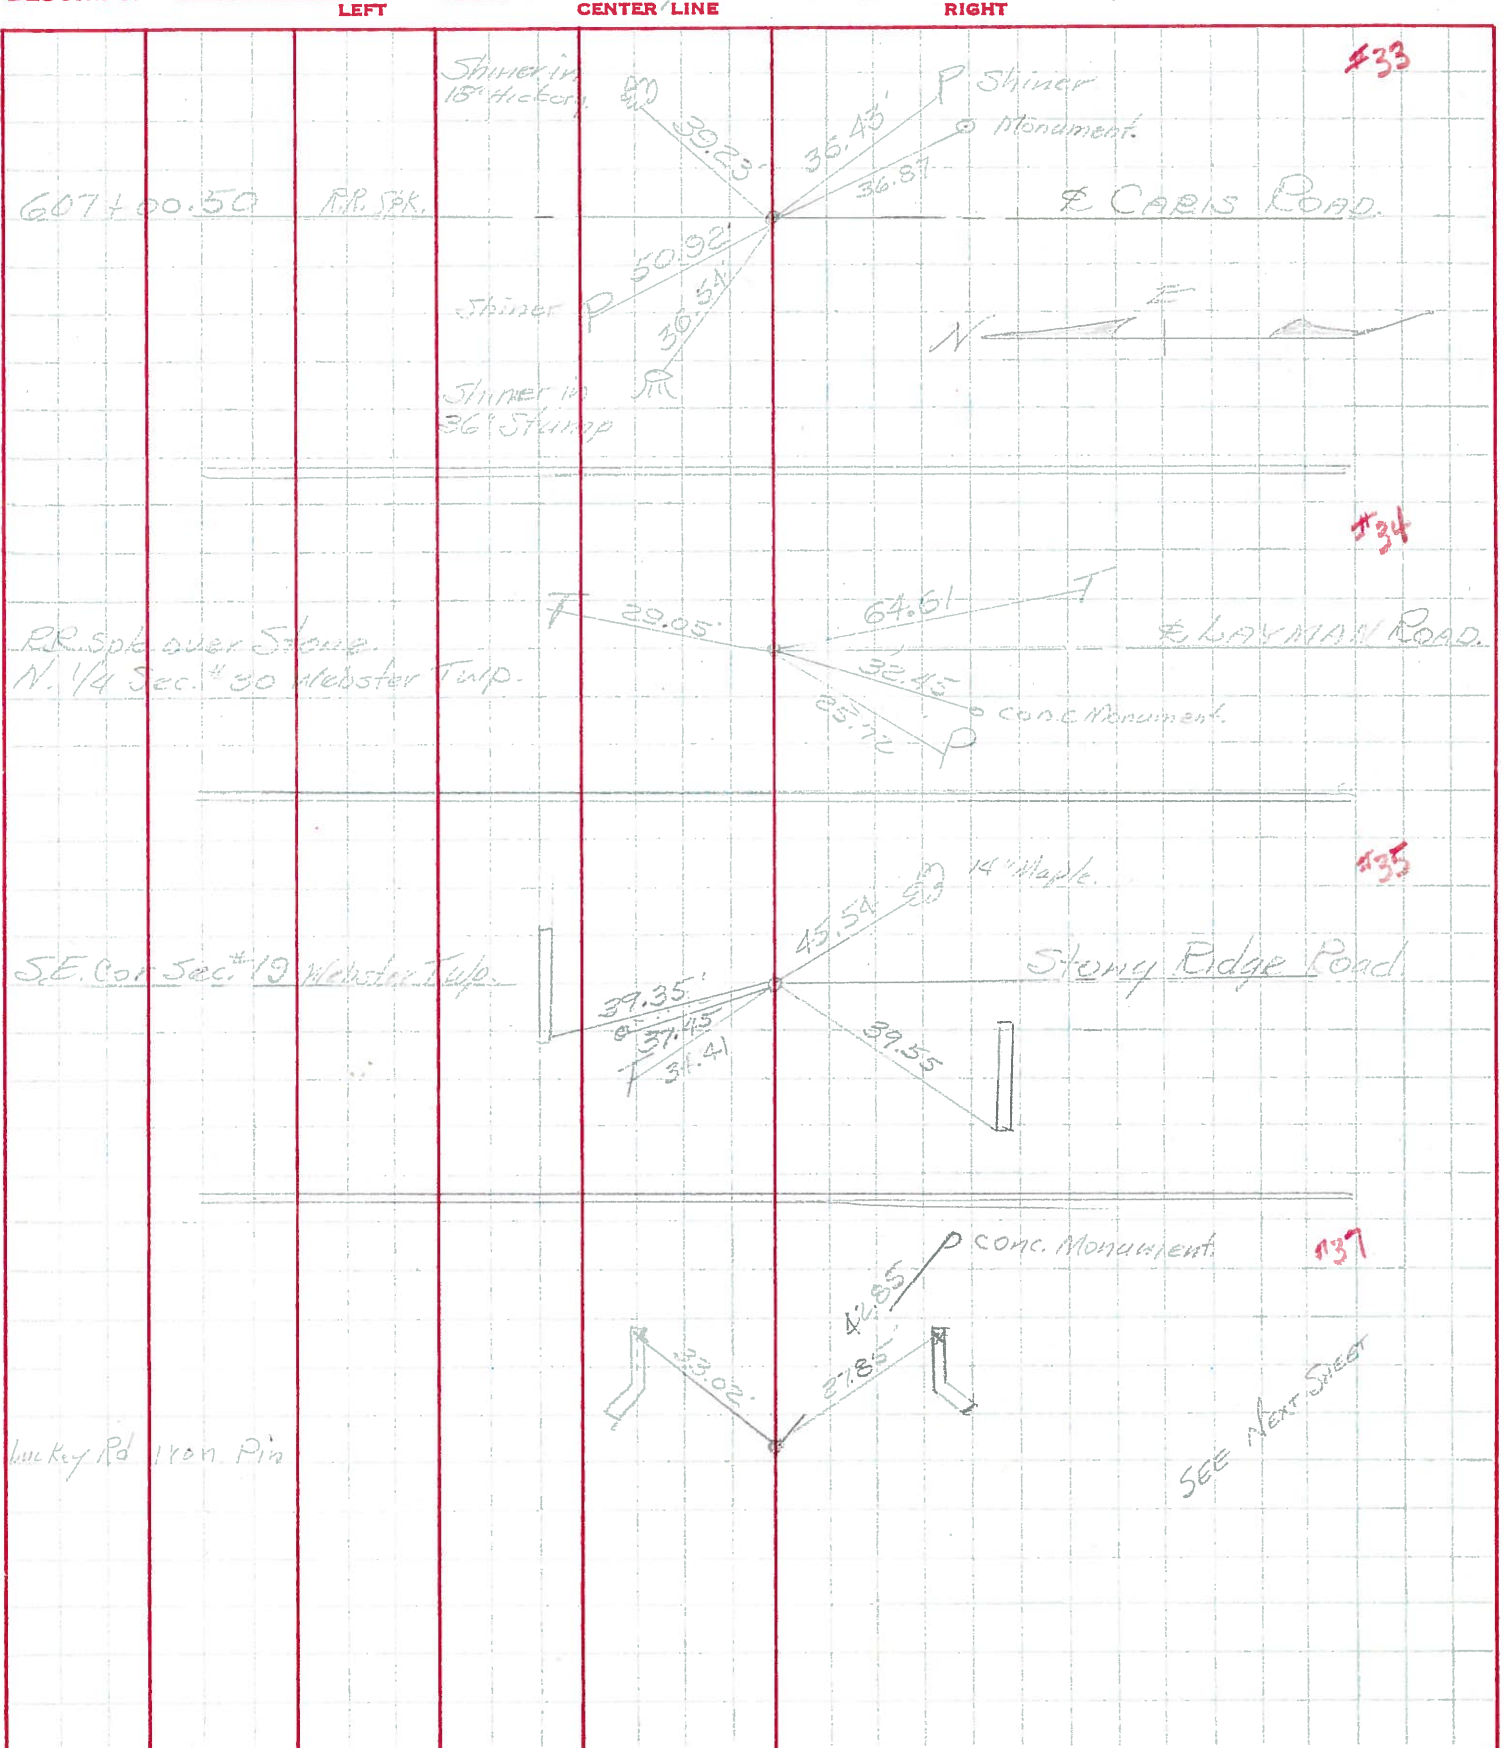COUNTY Wood. DATE April, 17, 1969S. R. #582 WEATHER Cloudy & WindySEC. 199 East TEMP. +70°DESCRIPTION Ties to Control Points JOB NO. _____

PERSONNEL	TITLE	PERSONNEL	TITLE	COUNTY	DATE
				Wood	12-27-57
				S. R. #582	Grorden 4-4-60
				SEC.	WEATHER
					TEMP.

DESCRIPTION	LEFT	CENTER LINE	RIGHT	JOB NO.
Stone wit.			Shiner in P. Pole S.S.E. 87.45'	
(10) Co. record (Caris Rd)		OK C.L.	Shiner in 18" Hickory N.E. 39.22'	
R.R. Spk. (2" below post.)	#456	New Culvert	Shiner in 36" Catalpa ^{Shiner} N.W. 36.50'	
9/14/65	33		W. end of W. Bridge Girder 13.40' 13.5'	
S.E. cor. sec. 24-6-11			W. end of E. Bridge Girder 17.35' 17.6'	
Webster twp. Ed. Rk.			3 in. man. S.E. 37.0'	
Stone 2.0' deep 9/14/65			Shiner in P.P. N.W. 50.92' 50.95'	
(2) Co. record			Shiner in P.P. S.E. 36.45'	
4250' S. of Caris Rd. Inter.			S. point of S.E. wing 19.0'	
#456-A			S. point of S.W. wing 13.5'	
33A			Conc. monument N.E. 25.35'	
N.W. post sec. 30 Webster			Conc. monument N.W. 12.8'	
Twp. (Layman Rd.)		OK C.L.	Sh. in P. Pole S.S.E. 46.45'	
R.R. Spk. over Conc			Sh. 13" Hickory N.N.E. 74.45'	
R.R. Spk. (1" below post.)			Shiner Tele. Pole S.E. 64.60'	
9/14/65	#457		3 in. man. S.E. 42.49'	
34			Corner man. S.W. 32.45' 32.47'	
S.E. cor. sec. 19 Webster			X in N.E. Cor. C.B. Top N.E. 21.40' 21.37'	
Twp. (Stony Edge Rd.)			Shiner in P. Pole S.W. 25.67'	
R.R. spike			Shiner in Tele Pole N.E. 28.75'	
R.R. Spk. (1" below post.)			Conc. marker N.W. 37.36' ^{40'}	
9/14/65	#458		Round ditch marker S.W. 35.58' ^{69'}	
35			E. point conc. coping on S.E. wing 33.45' ^{45'}	
			N.W. cor. conc. coping on S. bulkhead S.W. 39.57' ^{58'}	
			S.W. cor. conc. coping on N. bulkhead N.W. 39.35'	
			E. point conc. coping on N.E. wing N.W. 31.37'	
			S.E. Shiner 14" Maple 45.55' 45.61'	
			N.W. Shiner Tele. Pole 34.40'	

PERSONNEL	TITLE	PERSONNEL	TITLE

COUNTY WoodDATE 12-27-57Sorden 4-4-60S. R. #582

WEATHER

SEC.

TEMP.

DESCRIPTION

LEFT

CENTER LINE

RIGHT

JOB NO.

Stone wit.			Shiner in P. Pole S.S.E. 87.45'
(10) Co. record (Caris Rd)			Shiner in 18" Hickory N.E. 39.22'
#456			Shiner in 36" Catalpa N.W. 36.50'
33			N. end of W. Bridge Girder 13.40' + 3.5'
S.E. cor. sec. 24-6-11			N. end of E. Bridge Girder 17.35' + 7.6'
Webster twp.			Conc. man. S.E. 37.0'
Stone 2.0' deep			Shiner in P.P. N.W. 50.92' 50.95'
(2) Co. record			
#456			S. point of S.E. wing 19.0
33A			S. point of S.W. wing 13.5
N. 1/4 post sec. 30 Webster			Conc. monument N.E. 25.35
Twp. (Layman Rd.)			Conc. monument N.W. 12.8
E.R. spk. over stone			
#457			Shiner Tele. Pole S.E. 64.60
34			Conc. man. S.E. 48.9
S.E. cor. sec. 19 Webster			Conc. man. S.W. 32.45 32.44
Twp. (Stony Ridge Rd.)			X in N.E. Cor. C.B. Tap. N.E. 21.40 21.37
E.R. spike			Shiner in P. Pole S.W. 25.67
#458			Shiner in Tele. Pole N.E. 28.75
35			Conc. marker N.W. 37.36
S.E. cor. sec. 19 Webster			Round ditch marker S.W. 35.68
Twp. (Stony Ridge Rd.)			E. point conc. coping on S.E. Wing
E.R. spike			S.W. 33.40
#458			N.W. Cor. conc. coping on S
35			bulkhead S.W. 39.57
S.E. cor. sec. 19 Webster			S.W. Cor. Conc. coping on N
Twp. (Stony Ridge Rd.)			bulkhead N.W. 39.35
E.R. spike			E. point conc. coping on N.E
#458			wing N.W. 31.37
35			S.E. Shiner 14" Maple 45.61'
S.E. cor. sec. 19 Webster			N.W. Shiner Tele. Pole 34.40
Twp. (Stony Ridge Rd.)			
E.R. spike			