

O.D.O.T. DISTRICT 2 SURVEY OFFICE

PERSONNEL

REFERENCE NO. 40

SHEET 10 OF 29

NOTES HOMAN

DATE 4-27-10

ROUTE SR 582

H.C. HOMAN

WEATHER SUNNY

COUNTY WOOD

R.C. ROUSOS

TEMP. 40°

TOWNSHIP TROY

SECTION 28

T 6 N R 12 E

TYPE MONUMENT PK/WASHER


ON SURFACE - ~~BELOW~~ On Surface

LEFT - ~~C PAV'T~~ - ~~RIGHT~~ 7.2'

16.6' TO ^LRT EDGE PAVEMENT

S.L.M. 768+42.40

GRID: NORTHING: 652456.268 EASTING: 1698939.941

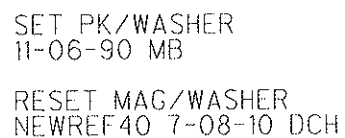

O.D.O.T. DISTRICT 2 SURVEY OFFICE

PERSONNEL

REFERENCE NO. 40

SHEET OF

NOTES LOEHKE

H.C. Hoffman

R.C. BARNHISEL

DATE 7-23-90

WEATHER pt Cloudy

TEMP. +75

ROUTE S.R. 582

COUNTY WOOD

TOWNSHIP TROY

SECTION 28

T. 6 N R. 12 E


TYPE MONUMENT Sm RR Spk

ON SURFACE - BELOW yes


LEFT- & PAV'T. - RIGHT 7.2

16.6 TO RT EDGE PAVEMENT

S.L.M. 769 + 35

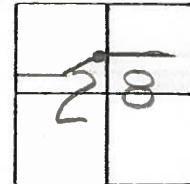

Set P.K. / Washer
11-6-90
MB

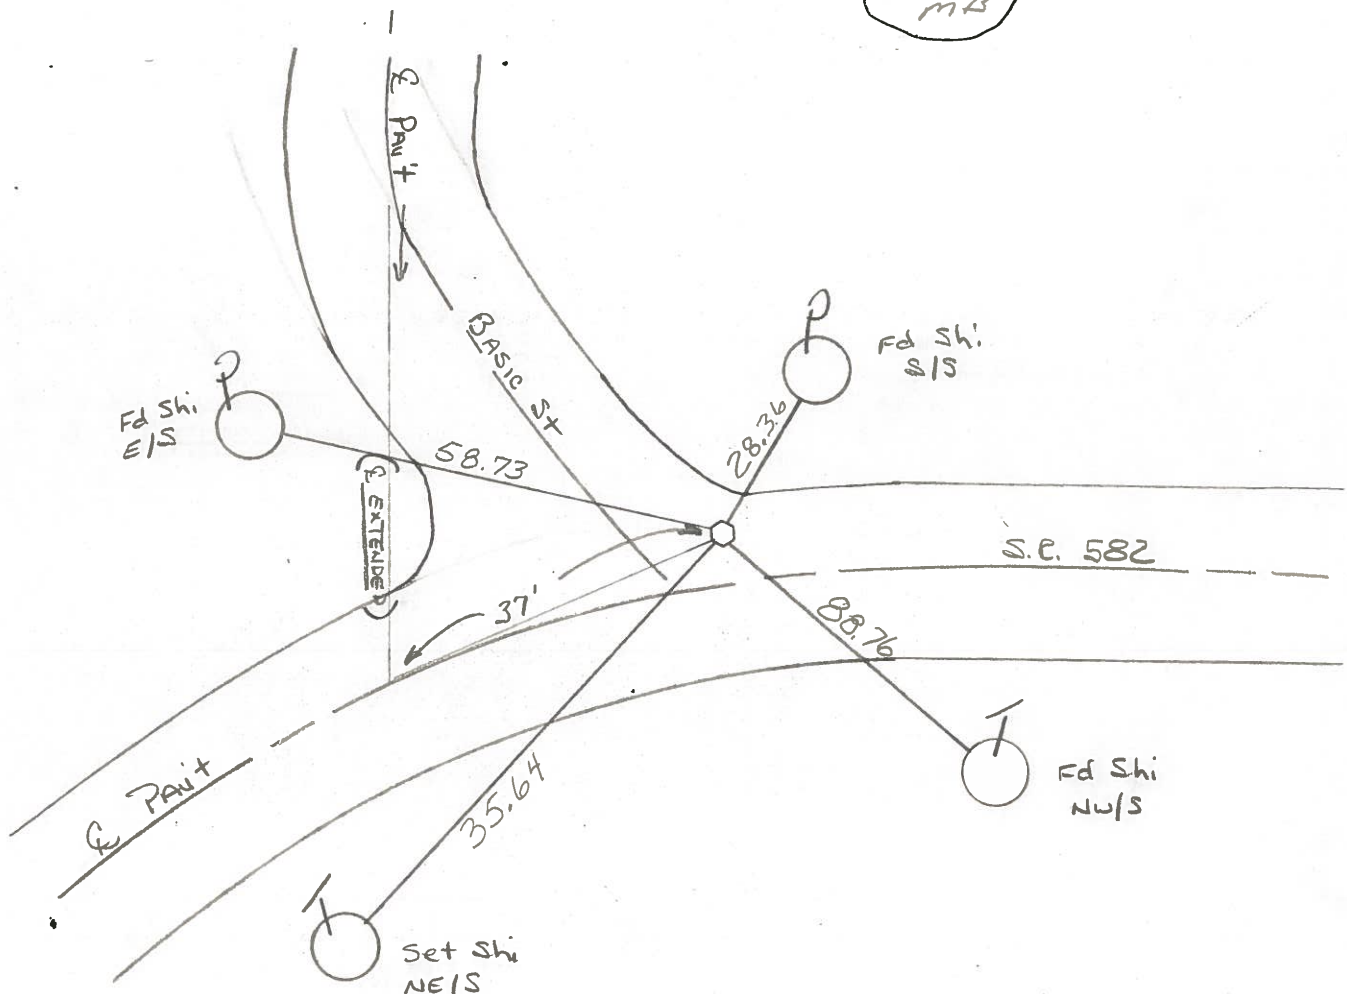

Q.D.O.T. DISTRICT 2 SURVEY OFFICE

SHEET 25 OF

County Wood S.R. 582

Township Troy

Section 28

T N, R E

Personnel I. Stone

P. Nusco


R. Michalak

D. Curtis

Date 13 July 83


Weather Warm

Temp. 85°

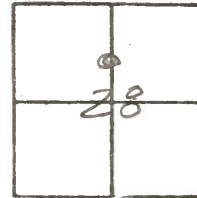

SLM STA. 769+26

REF. NO. 40

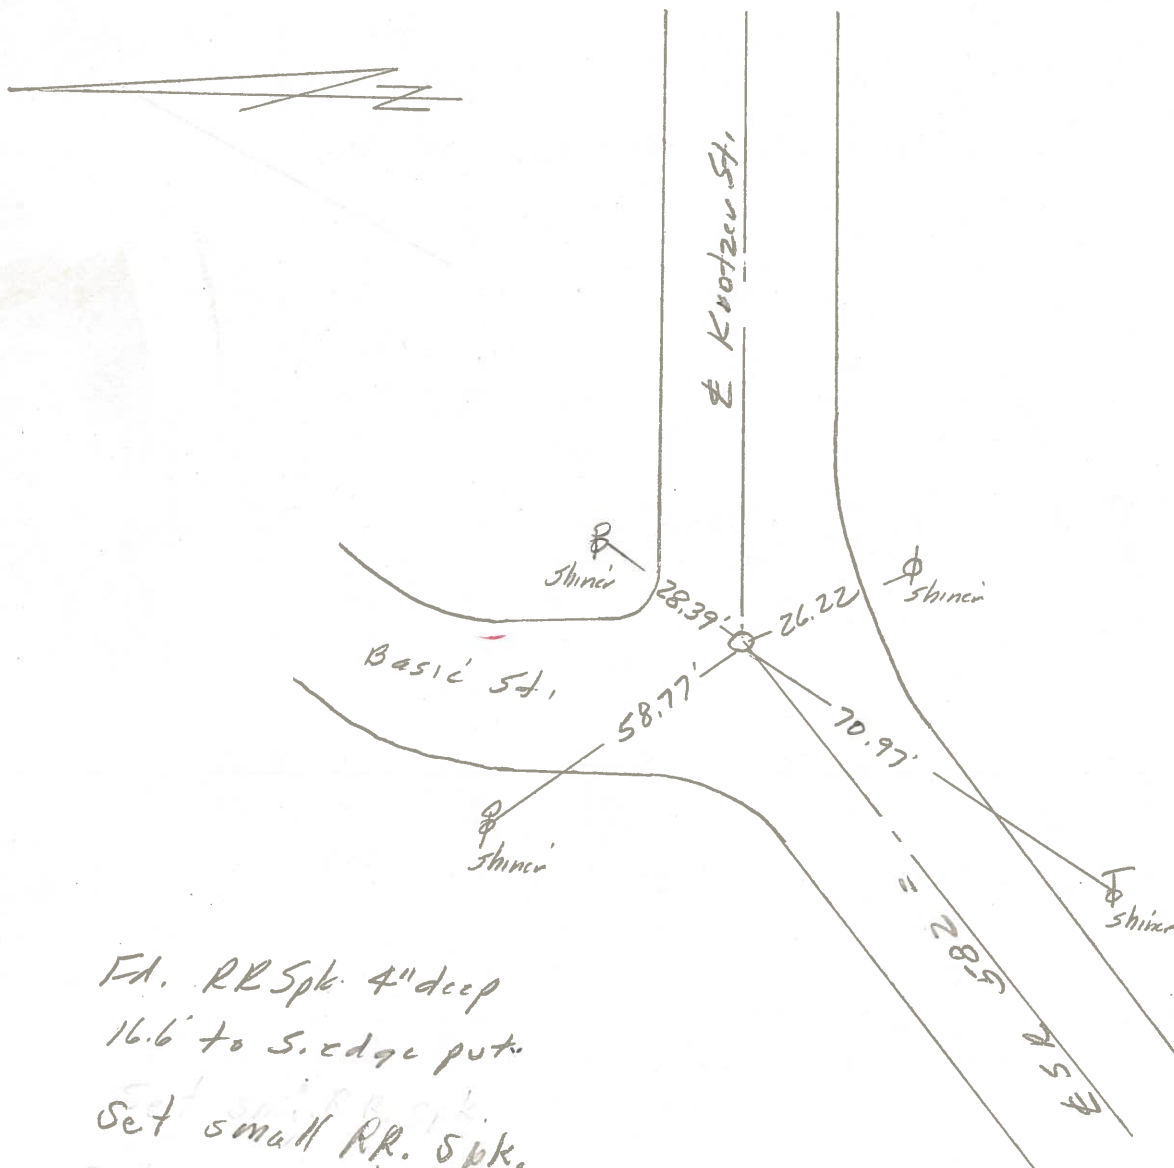

O.D.O.T. DISTRICT 2 SURVEY OFFICE

SHEET 25 OF

County Wood S.R. 582

Township Troy

Section 28


T.N, R.E

Personnel I. Stone
P. Neuse
R. Michalak
D. Curtis

Date 13 July 83


Weather W c m

Temp. 85°

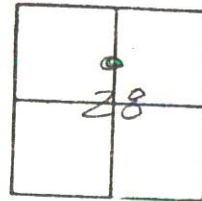

SLM STA. 769+26

REF. No. 70

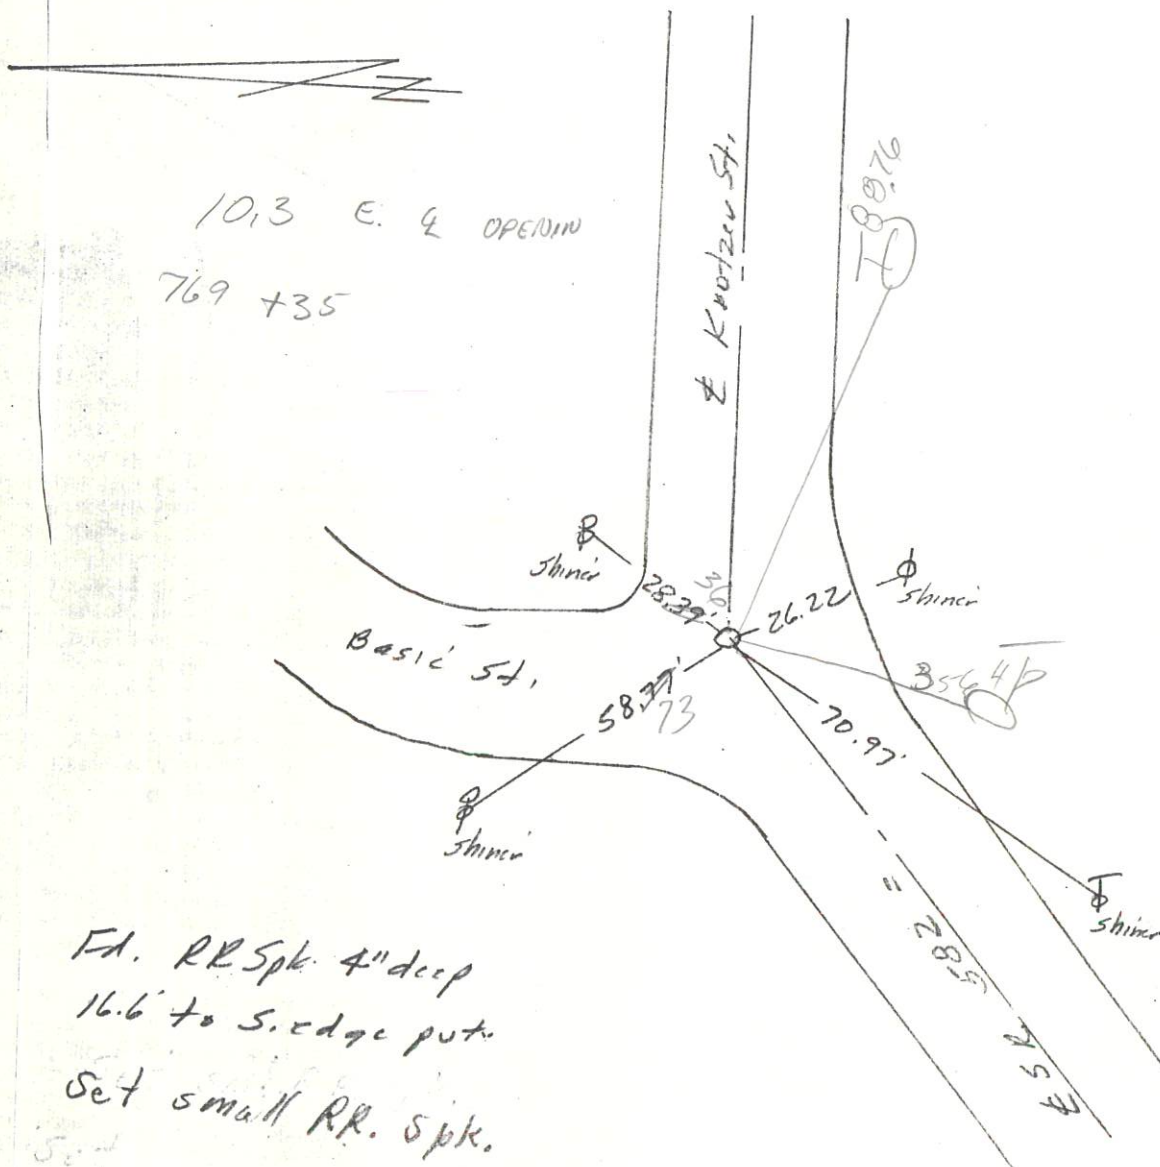

PERSONNEL _____

TITLE _____

PERSONNEL _____

TITLE _____

COUNTY WoodDATE April, 11, 1968S. R. # 582WEATHER ClearSEC. LuckeyTEMP. +55°DESCRIPTION Ties to Control Points.

JOB NO. _____

LEFT

CENTER LINE

RIGHT

768+80 ± SLM.

RR Spk.

P 25.40

26.20 P

P 26.59

68.45 T

Krotzer St.
582

Shiner.

P 22.85

26.55

Shiner in 18" Maple.

Iron pin.

31.56

56.26

Shiner in 18" Maple.

Shiner in 18" Maple.

Walnut Street.

Lime Street.

39B
Iron Pin.

43.56

47.64

Cherry Street.

Shiner.

P 24.43

27.60

50.80

50.60

Shiner in 22" Tree of Heaven.

Iron pin.

19.75

27.42

T Shiner

39A