

O.D.O.T. DISTRICT 2 SURVEY OFFICE

PERSONNEL

REFERENCE NO. 40 C

SHEET 13 OF 29

NOTES _____ HOMAN

DATE 4-27-10

ROUTE SR 582

H.C. HOMAN

WEATHER SUNNY

COUNTY WOOD

R.C. ROUSOS

TEMP. 40°

TOWNSHIP TROY

SECTION 28

T_6 N R_12 E

TYPE MONUMENT _____ PK Nail


ON SURFACE - ~~BELOW~~ On Surface

~~LEFT~~ - ~~C~~ PAV'T - RIGHT 8.3'

TO 2 EDGE PAVEMENT


S.L.M. 774+04.98, 9.3' East of PAV'T TO SOUTH

GRID: NORTHING: 652451.539 EASTING: 1699502.536

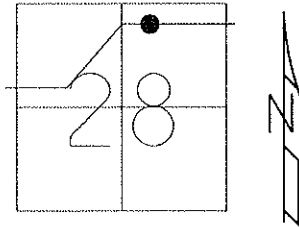

SET PK/WASHER
11-06-90 MB

RESET MAG/WASHER
40-C=NEWREFC40
7-08-10 DCH

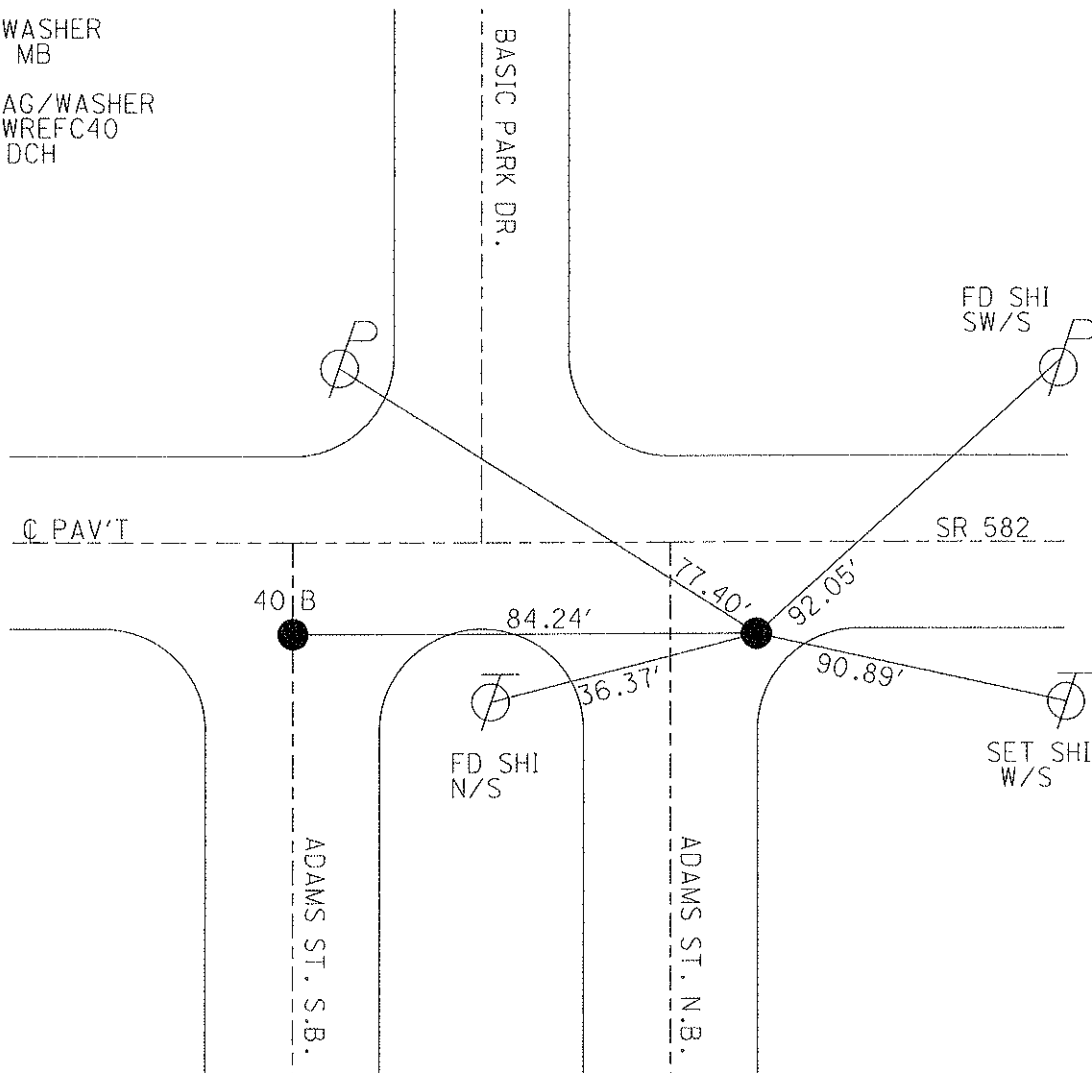

O.D.O.T. DISTRICT 2 SURVEY OFFICE

PERSONNEL

REFERENCE NO. 40B & 40C

SHEET _____ OF _____

NOTES Locharke

H.C. Hoffman

R.C. BARNHISEL

DATE 7-23-90

WEATHER A Cloudy

TEMP. +75

ROUTE S.R. 582

COUNTY WOOD

TOWNSHIP TROY

SECTION 28

T. 6 N. R. 12 E.


TYPE MONUMENT P.K. Nails

ON SURFACE - BELOW _____

LEFT - & PAV'T. - RIGHT "A" 8.8 "B" 8.3

18.0 TO Lt EDGE PAVEMENT "B" 9.3 E & PAVT to South

S.L.M. 774+12 774+96

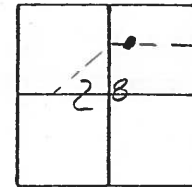



At "A" Ref No. 40 B

At "B" Ref No 40c


Between 84.23

Set P.K. / Washer
11-6-90
MB

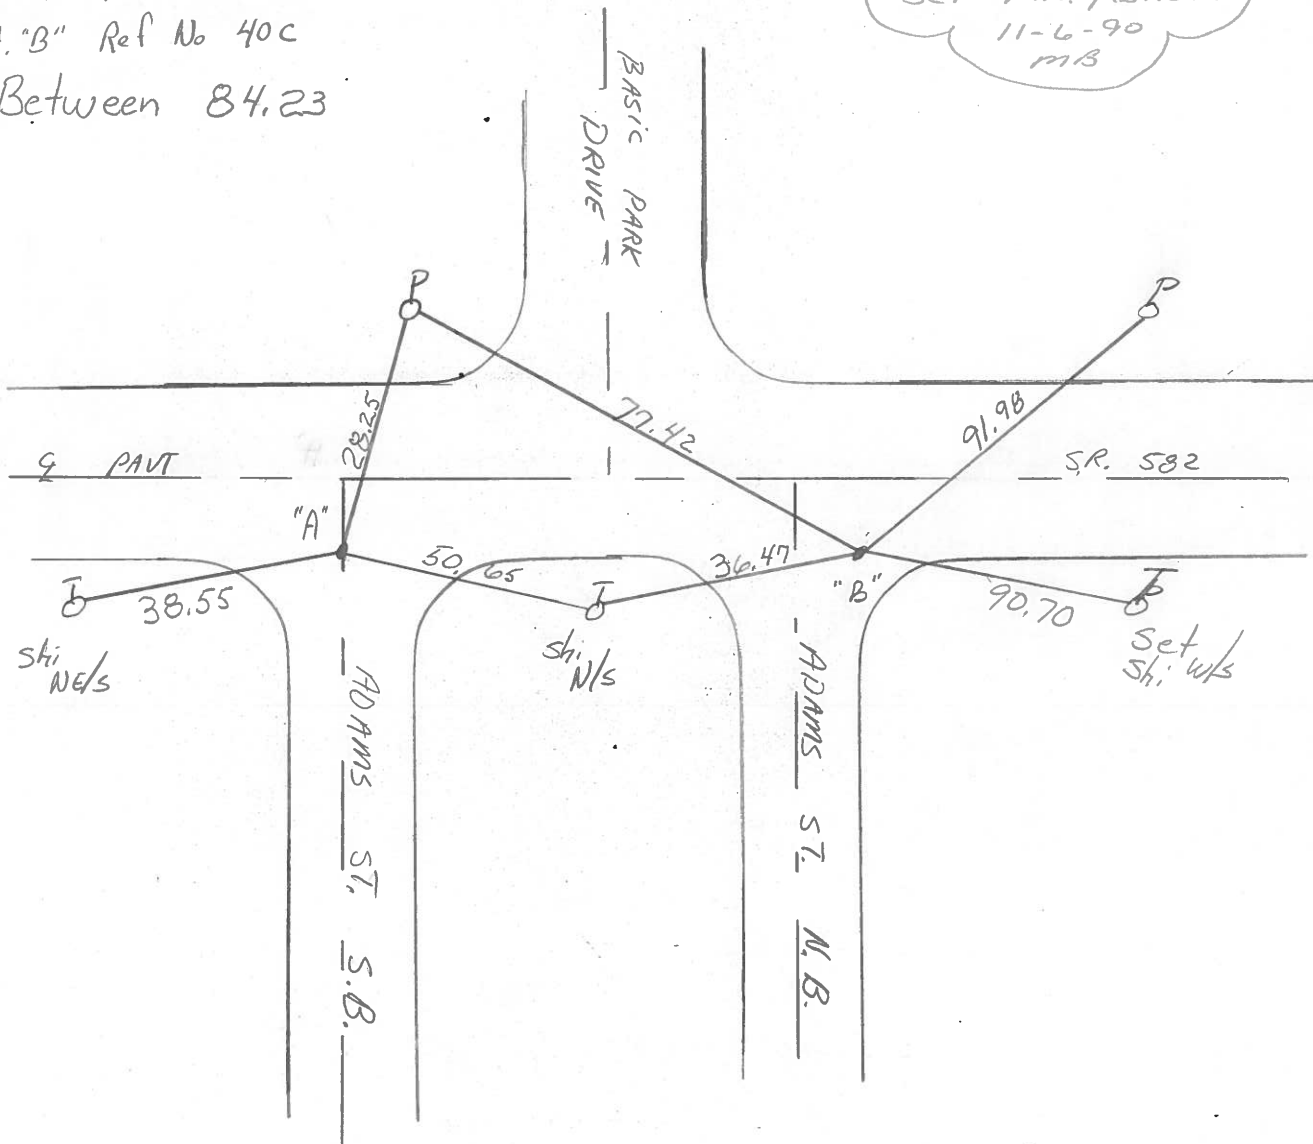

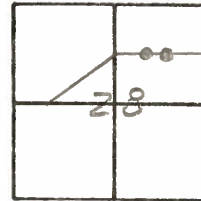County Wood S.R. 582Township TroySection 28T N, R EPersonnel L. StoneP. NeuserR. MichalekD. CurtisDate 13 July 83Weather WarmTemp. 87°

SLM STA.

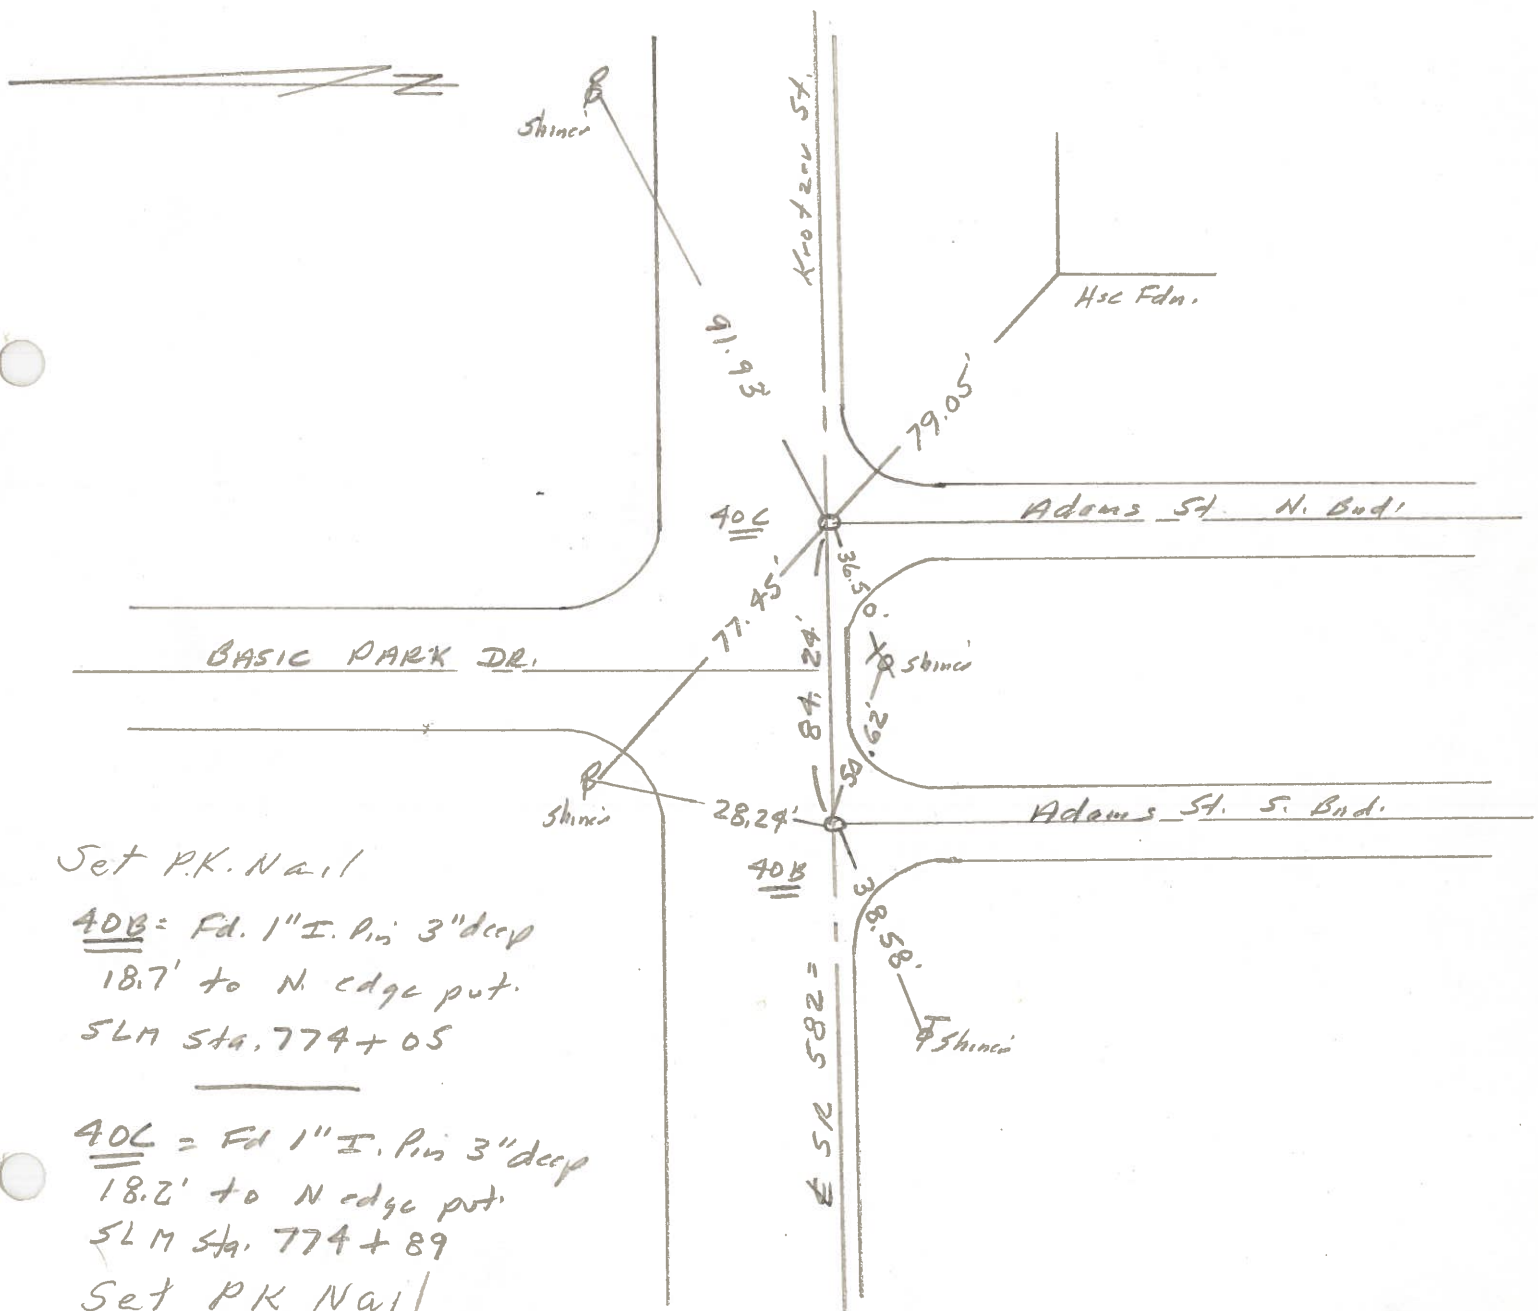REF. NO. 40B & 40C

PERSONNEL TITLE PERSONNEL TITLE


COUNTY WoodDATE April 12 1968MorrisonBowersHolcombeEern.S. R. #382WEATHER ClearSEC. Luckey.TEMP. +60°DESCRIPTION Ties to Control Points.

JOB NO. _____

LEFT

CENTER LINE

RIGHT

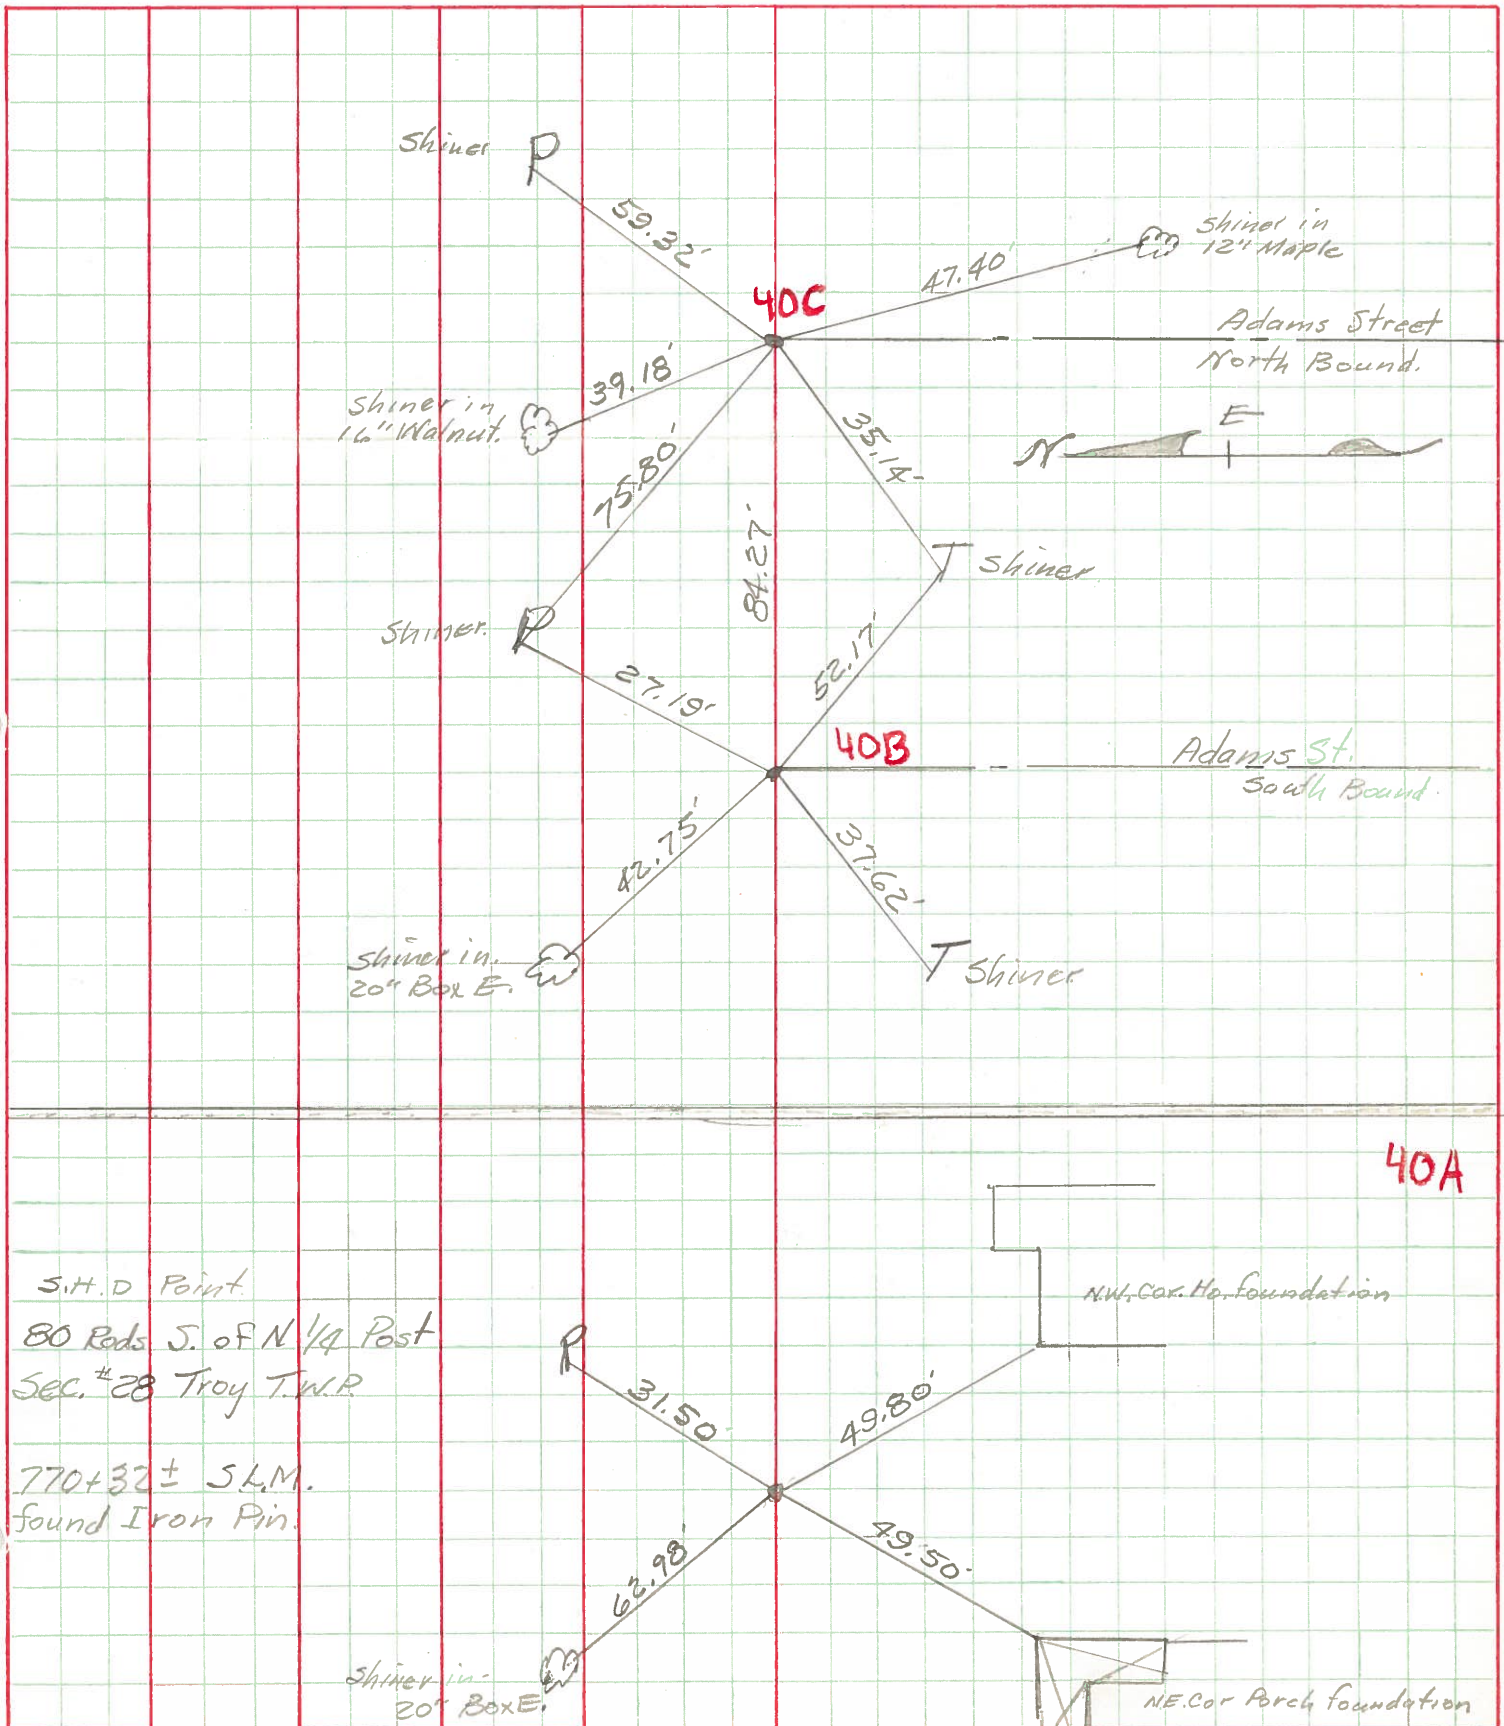

QD.O.T. DISTRICT 2 SURVEY OFFICE

SHEET 27 OF

County Wood S.R. 582

Township Troy

Section 28

T_N, R_E

Personnel 10 Stone

P. Neuse


R. Michaels

D. Curtis

Date 13 July 83

Weather Warm

Temp. 87°

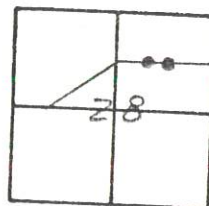

SLM STA.

REF. NO. 40B & 40C

