

NOTE: ORIGIN UNKNOWN
 SET PK/WASHER
 11-07-90 MB

RESET MAG/WASHER
 NEWREF A41, 7-08-10 DO

DIST. 41-41A=53.00'

FD SHI SE/S

64.89'

SR 582

41

36.65'

47.05'

37.85'

FD SHI NE/S

FD SHI W/S

SET SHI W/S

FD SHI W/S

LEMAYNE RD.

PAV'T

O.D.O.T. DISTRICT 2 SURVEY OFFICE

PERSONNEL

REFERENCE NO. 41

SHEET OF

NOTES LOEHRKE

H.C. Hoffman

R.C. BARNHISEL

DATE 7-26-90

WEATHER pt. Cloudy

TEMP. 77°

ROUTE 582

COUNTY WOOD

TOWNSHIP TROY

SECTION 28

T 6 N R 12 E


TYPE MONUMENT Sm R.R. Spike

ON SURFACE - BELOW yes

~~LEFT~~ - PAV'T. - RIGHT 6.6'


TO EDGE PAVEMENT 13.6 W & Lem. Rd


S.L.M. 797 + 25

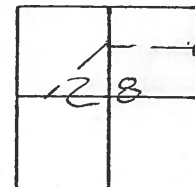

NOTE: ORIGIN
UNKNOWN


Set P.R./Washer
11-7-90
YMB

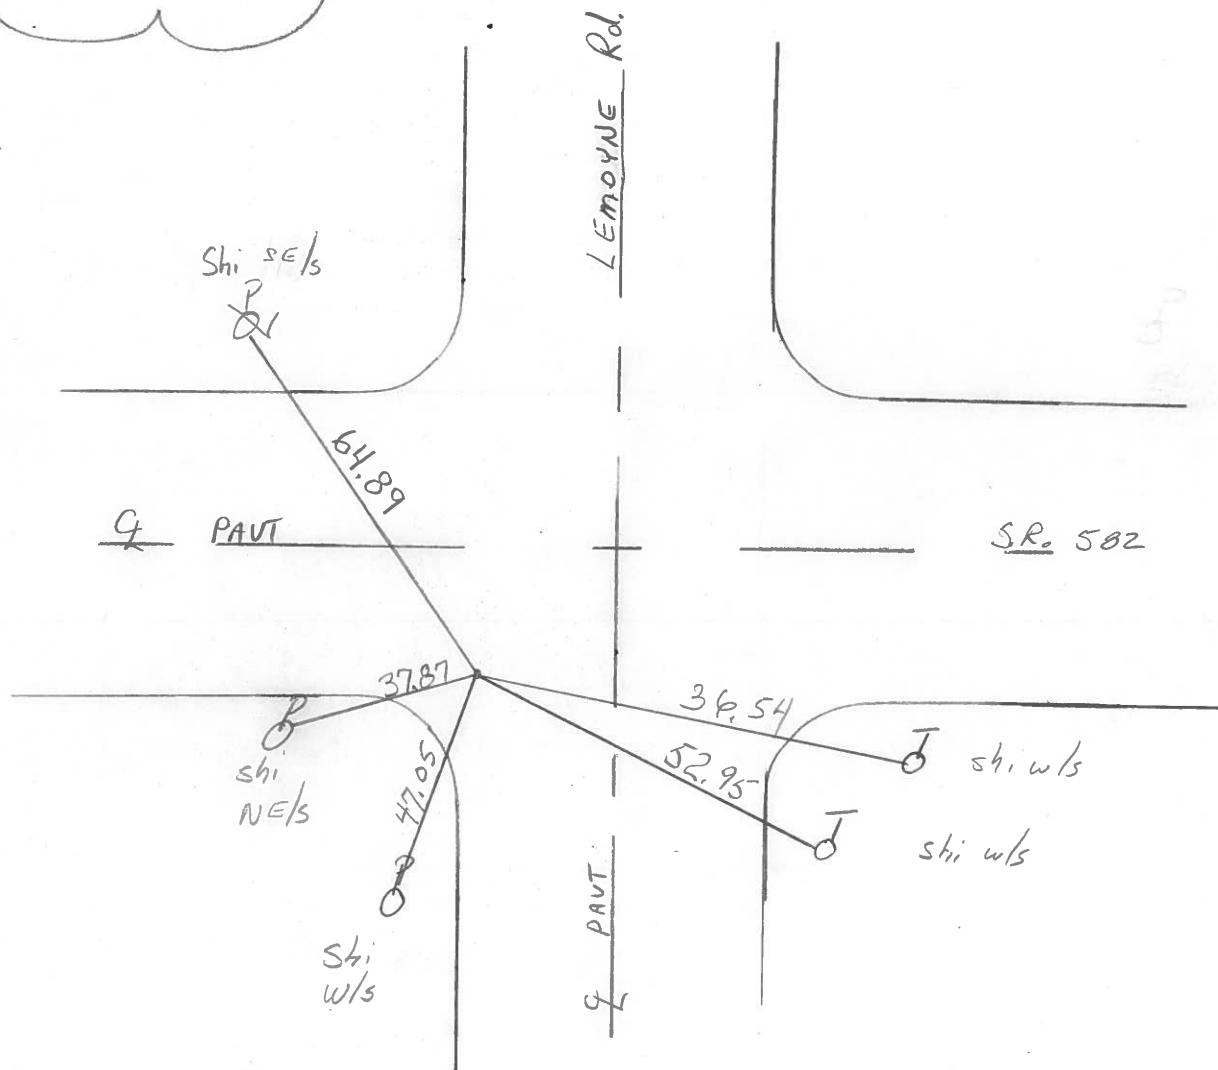

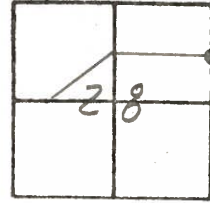County Wood S.R. 582Township TroySection 28T N, R EPersonnel I. StoneP. NeuseR. MichalakD. CurtisDate 13 July 83Weather WarmTemp. 88°

SLM STA. 797+81

REF. NO. 41

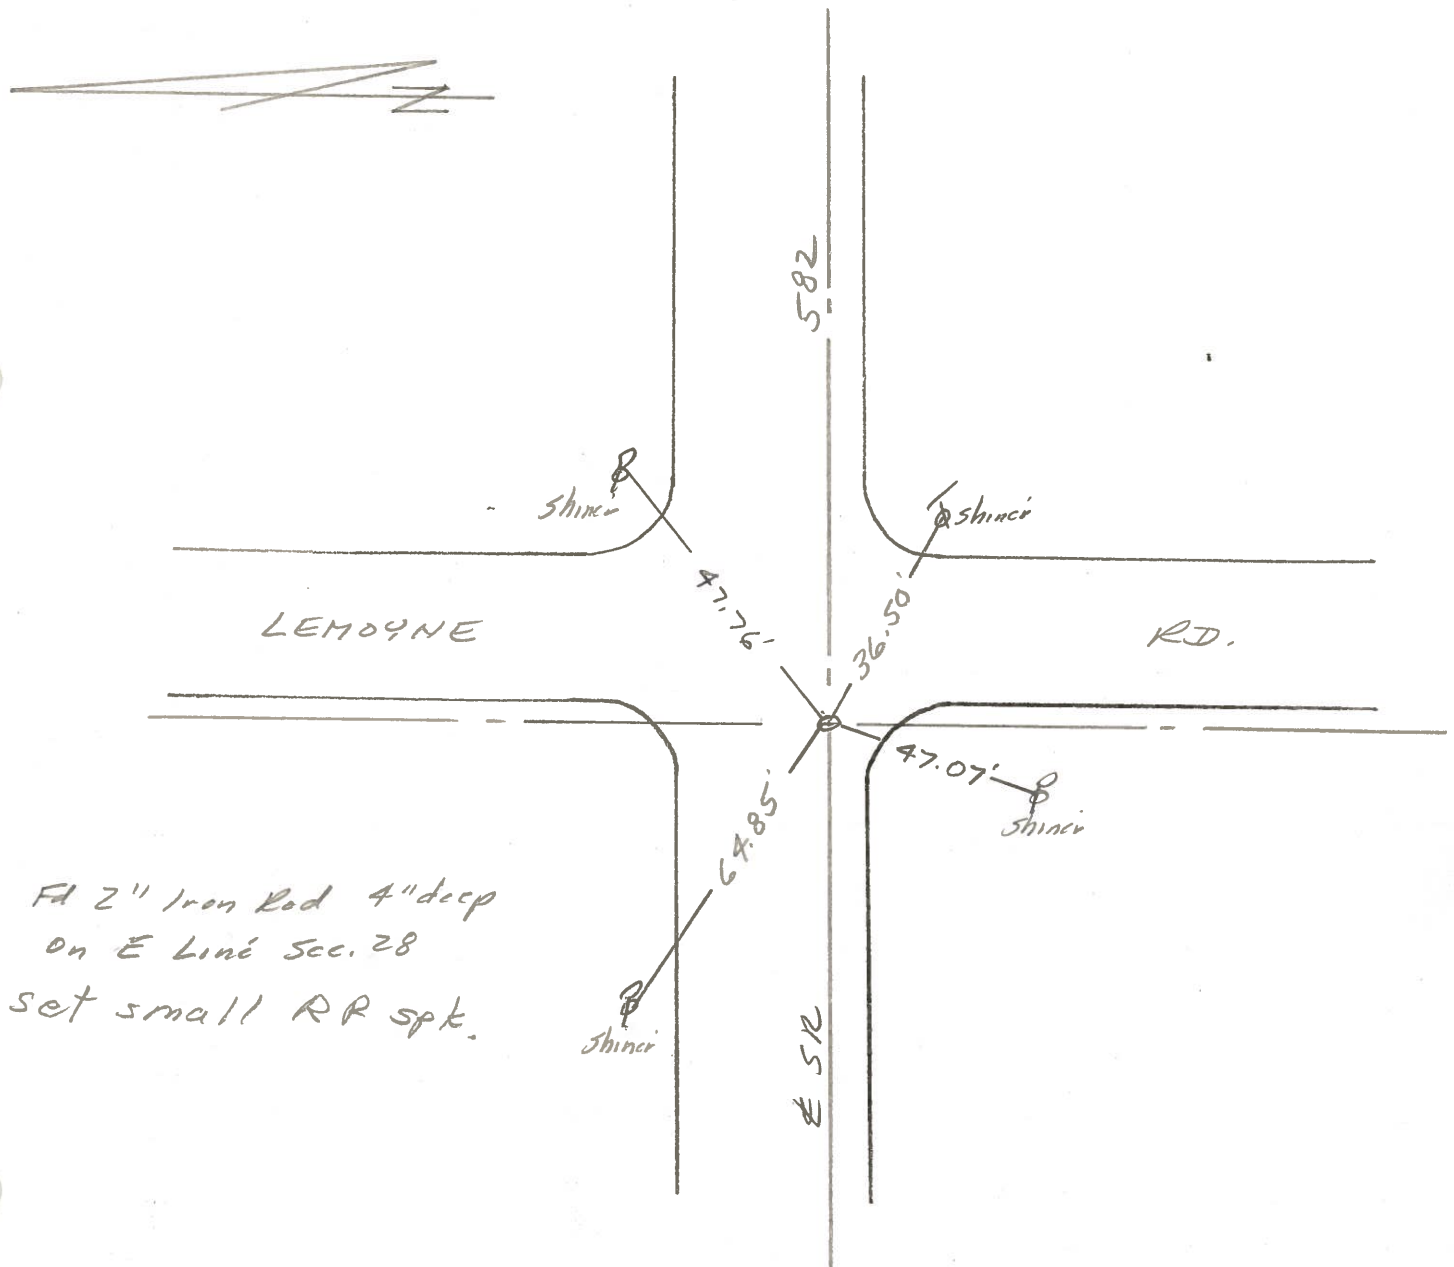

Q.D.O.T. DISTRICT 2 SURVEY OFFICE

SHEET 31 OF

County Wood S.R. 582

Township Troy

Section 28

T N, R E

Personnel I. Stone

P. Neusev


R. Michalak

D. Curtis

Date 13 July 83

Weather Warm

Temp. 88°

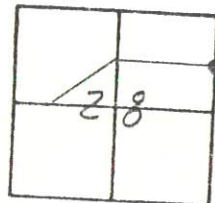

SLM STA. 797+81

REF. NO. 41

