

O.D.O.T. DISTRICT 2 SURVEY OFFICE (USE ONLY)

PERSONNEL

REFERENCE NO. 43

SHEET 18 OF 25

NOTES MILLER

DATE 8/6/24

ROUTE SR 582

H.C. MILLER

WEATHER CLOUDY

COUNTY WOOD

R.C. BARRIERE

TEMP. 75°

TOWNSHIP TROY

BLUBAUGH

SECTION 27

DWG BY BARRIERE

PID 107717

T 6 N R 12 E

TYPE MONUMENT MAG/WASHER

ON SURFACE - BELOW ON

OFFSET $\mathcal{Q}$ PAVEMENT 1.3' LT

TO EDGE PAVEMENT

STATION: 849+53.17

HORIZ.DATUM: NAD83 (2011)


GEOID: 18

GRID: NORTHING: 652457.852


EASTING: 1707050.669

LDP: NORTHING: 475020.390

EASTING: 217830.837

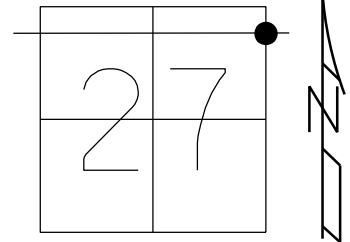

RECORD:
 SET PK/WASHER
 11-07-90 MB
 RESET MAG/WASHER
 NEWREF43 7-9-10 DCH
 FD SHANK HOLE
 RESET SQ NAIL
 REF43
 12/9/22, TDN
 FD SHANK HOLE
 REF43
 7/25/24, TDN

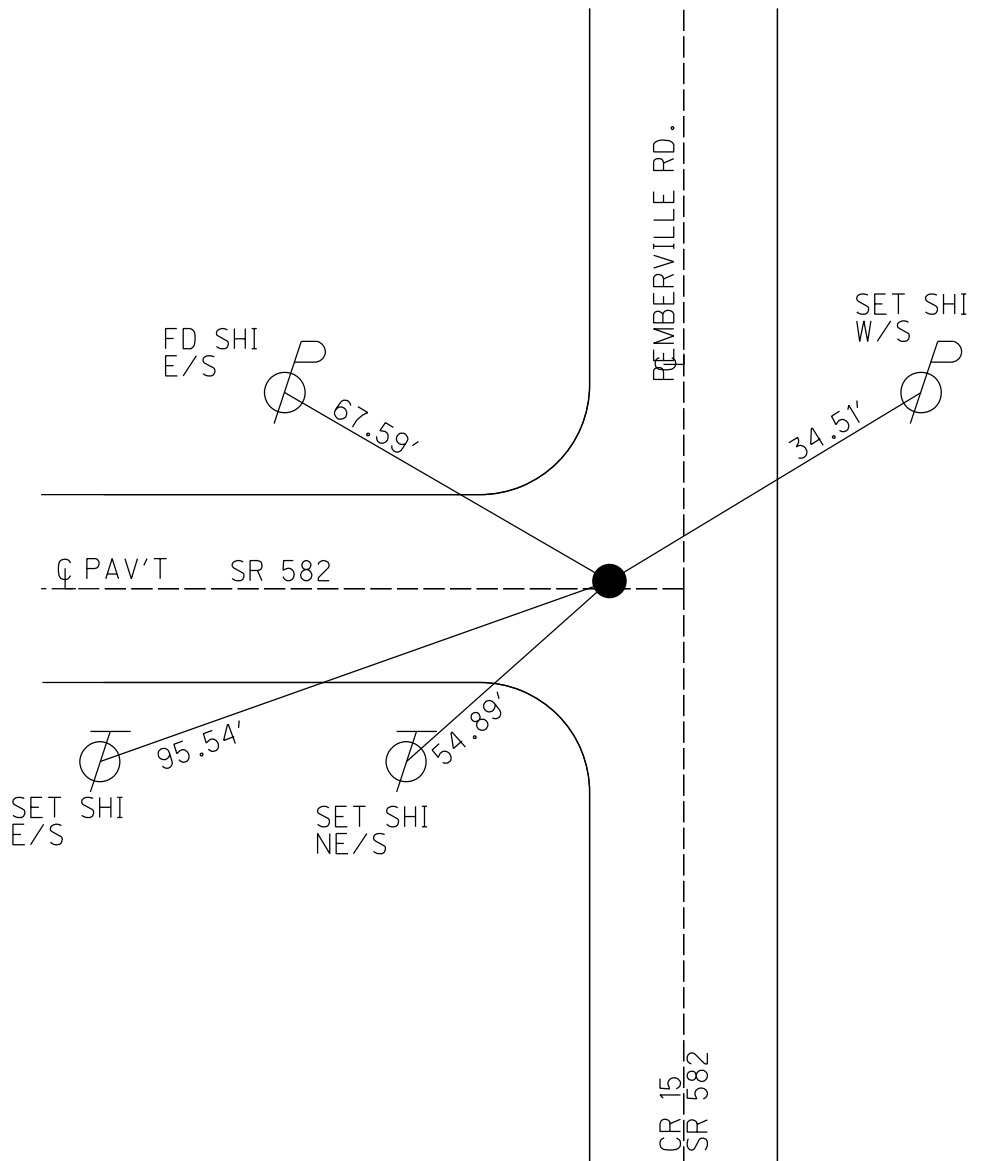

O.D.O.T. DISTRICT 2 SURVEY OFFICE

PERSONNEL

REFERENCE NO. 43

SHEET 24 OF 29

NOTES HOMAN

DATE 4-27-10

ROUTE SR 582

H.C. HOMAN

WEATHER SUNNY

COUNTY WOOD

R.C. ROUSOS

TEMP. 50°

TOWNSHIP TROY

SECTION 27

T 6 N R 12 E

TYPE MONUMENT PK NAIL



ON SURFACE - ~~BELOW~~ On Surface

LEFT - ~~C PAV'T~~ - RIGHT 1.3'

TO EDGE PAVEMENT

S.L.M. 849+53.17, 13.2' W OF C PEMBERVILLE RD.

GRID: NORTHING: 652457.952 EASTING: 1707050.552

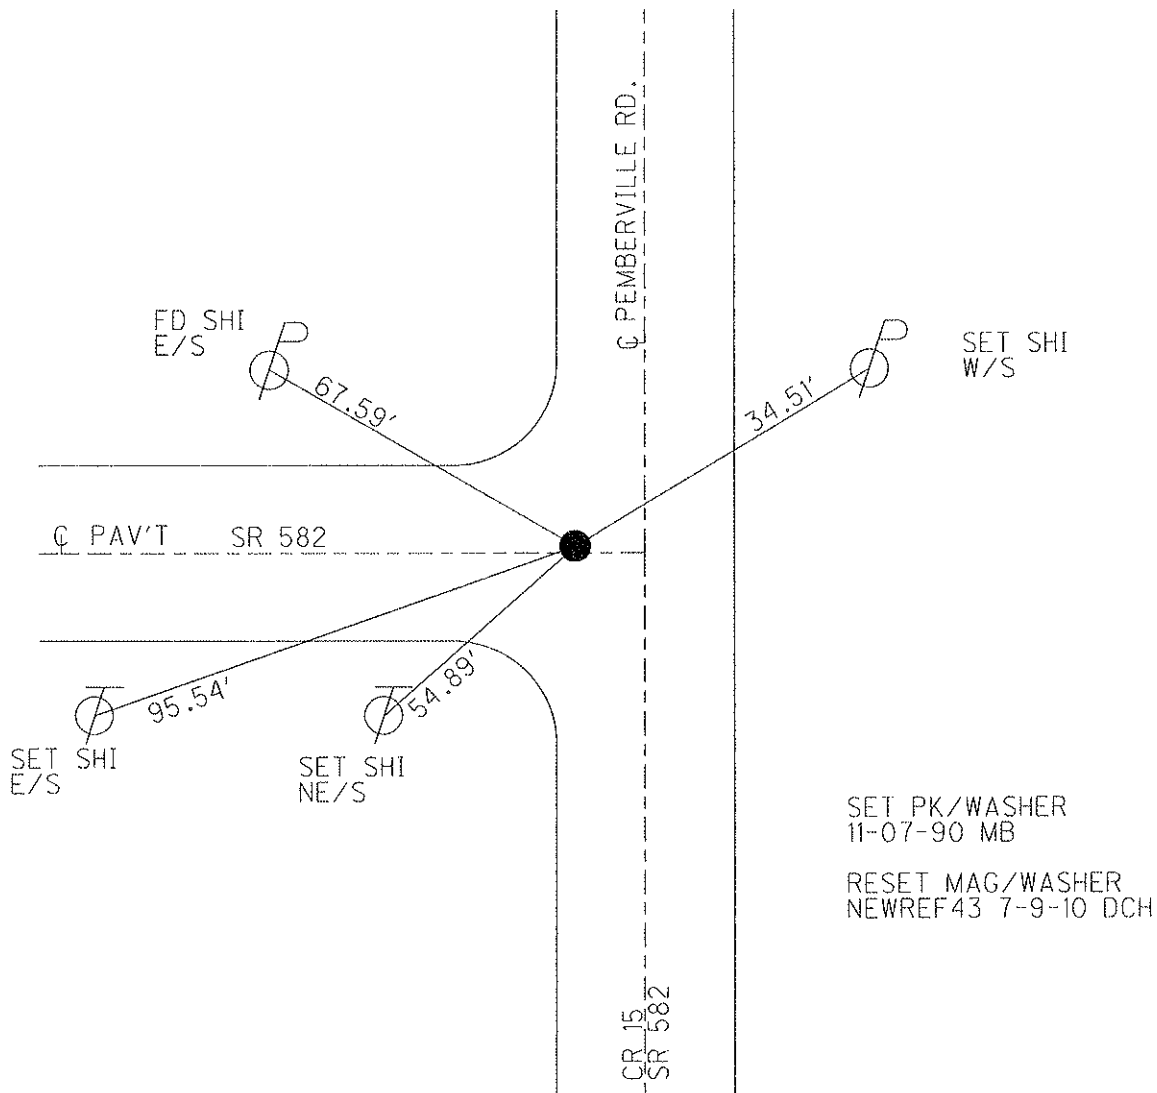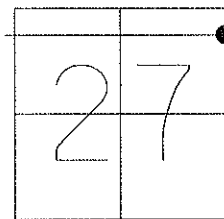

O.D.O.T. DISTRICT 2 SURVEY OFFICE

PERSONNEL

REFERENCE NO. 43

SHEET OF

NOTES LOEHRKE

H.C. LOEHRKE

R.C. BARNHISEL

DATE 7-26-90

WEATHER Cloudy

TEMP. +85

ROUTE 582

COUNTY WOOD

TOWNSHIP TROY

SECTION 27

T 4 N R 12 E

TYPE MONUMENT sm RR Spike w/ cross

ON SURFACE - BELOW yes

LEFT - 1 PAV'T. - RIGHT 1.3


TO EDGE PAVEMENT 13.3 w/ 1/4 Pem. Rd

S.L.M. 850 + 50

SR 582	
27	



Set P.K. / Washer
11-7-90
MB

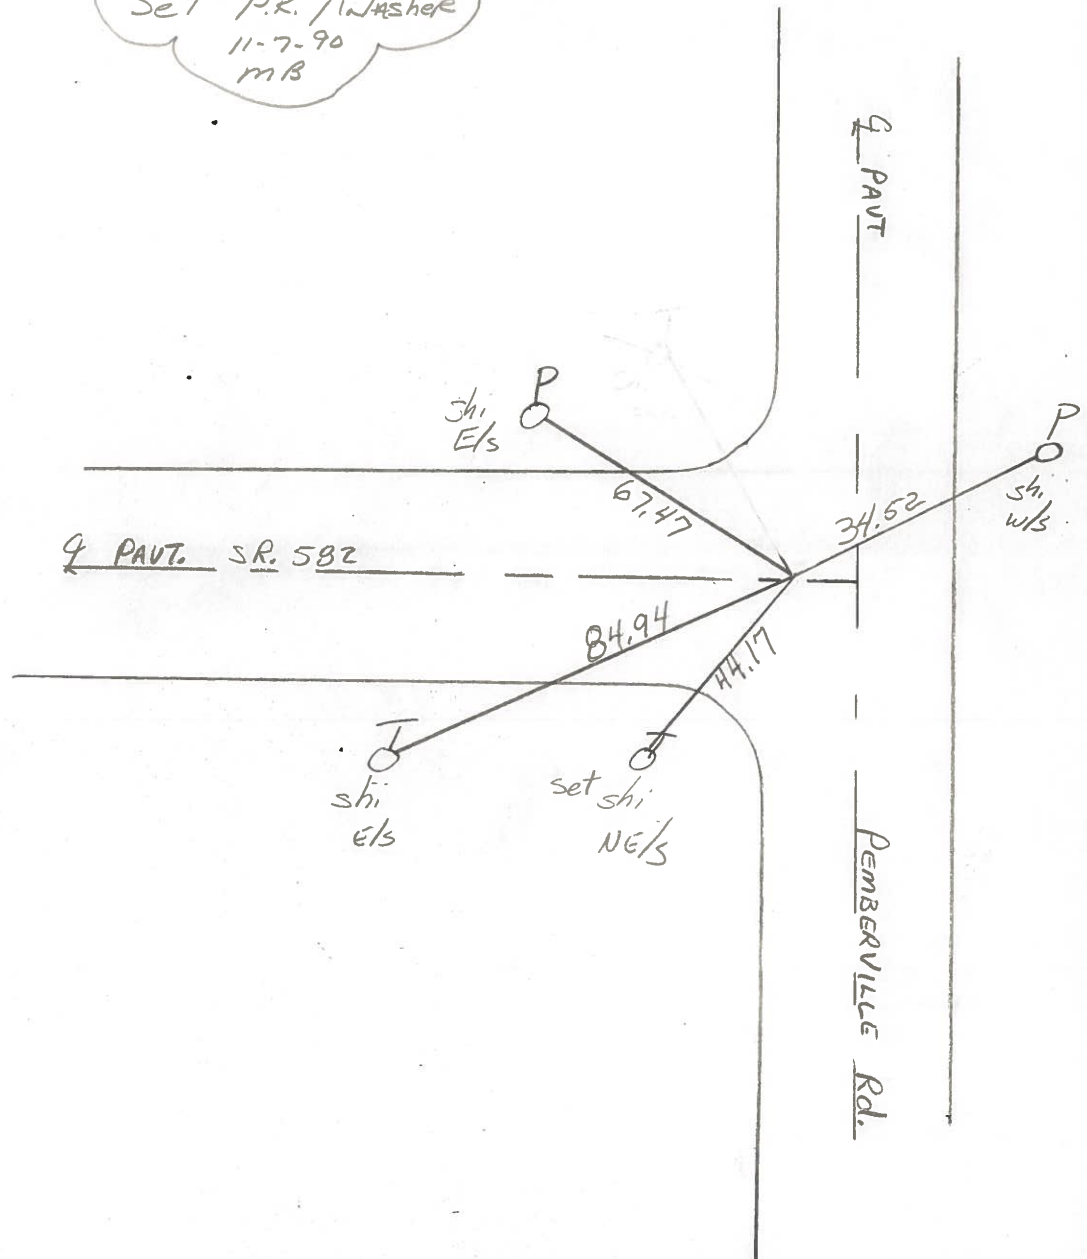

County Wood S.R. 582

Township Troy

Section 27

T N, R E

Personnel I. Stone

P. Neuser


R. Michalak

D. Curtis

Date 13 July 83

Weather Warm

Temp. 89°

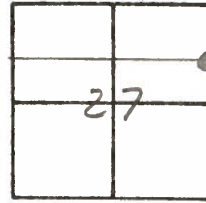

SLM STA. 850+41

REF. NO. 43

