

O.D.O.T. DISTRICT 2 SURVEY OFFICE (USE ONLY)

PERSONNEL

REFERENCE NO. 44

SHEET 18 OF 25

NOTES NIESE
H.C. NIESE
R.C. PRESTON-COLVIN

DATE 10/10/24
WEATHER SUNNY
TEMP. 51°

ROUTE SR 582
COUNTY WOOD
TOWNSHIP TROY
SECTION 27

DWG BY BARRIERE PID 107717

T 6 N R 12 E

TYPE MONUMENT MAG/WASHER

ON SURFACE - BELOW ON

OFFSET Q PAVEMENT 9' RT

TO EDGE PAVEMENT

STATION: 862+90.02

HORIZ.DATUM: NAD83 (2011)


GEOID: 18

GRID: NORTHING: 651121.018


EASTING: 1707039.224

LDP: NORTHING: 473683.432

EASTING: 217837.043

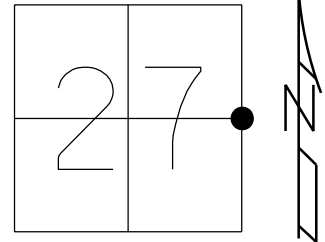

RECORD:
SET P.K./WASHER
11-07-90, MB
SET MAG/WASHER
NEWREF44
7-09-10, DCH
FD MAG/WASHER
REF44
7-31-18, JLL
SET MAG/WASHER
2" DOWN
8-20-19, JFO
FD MAG/WASH
1 1/2" DOWN
REF44
7/24/24, TDN
SET MAG/WASH
10/10/24, TDN

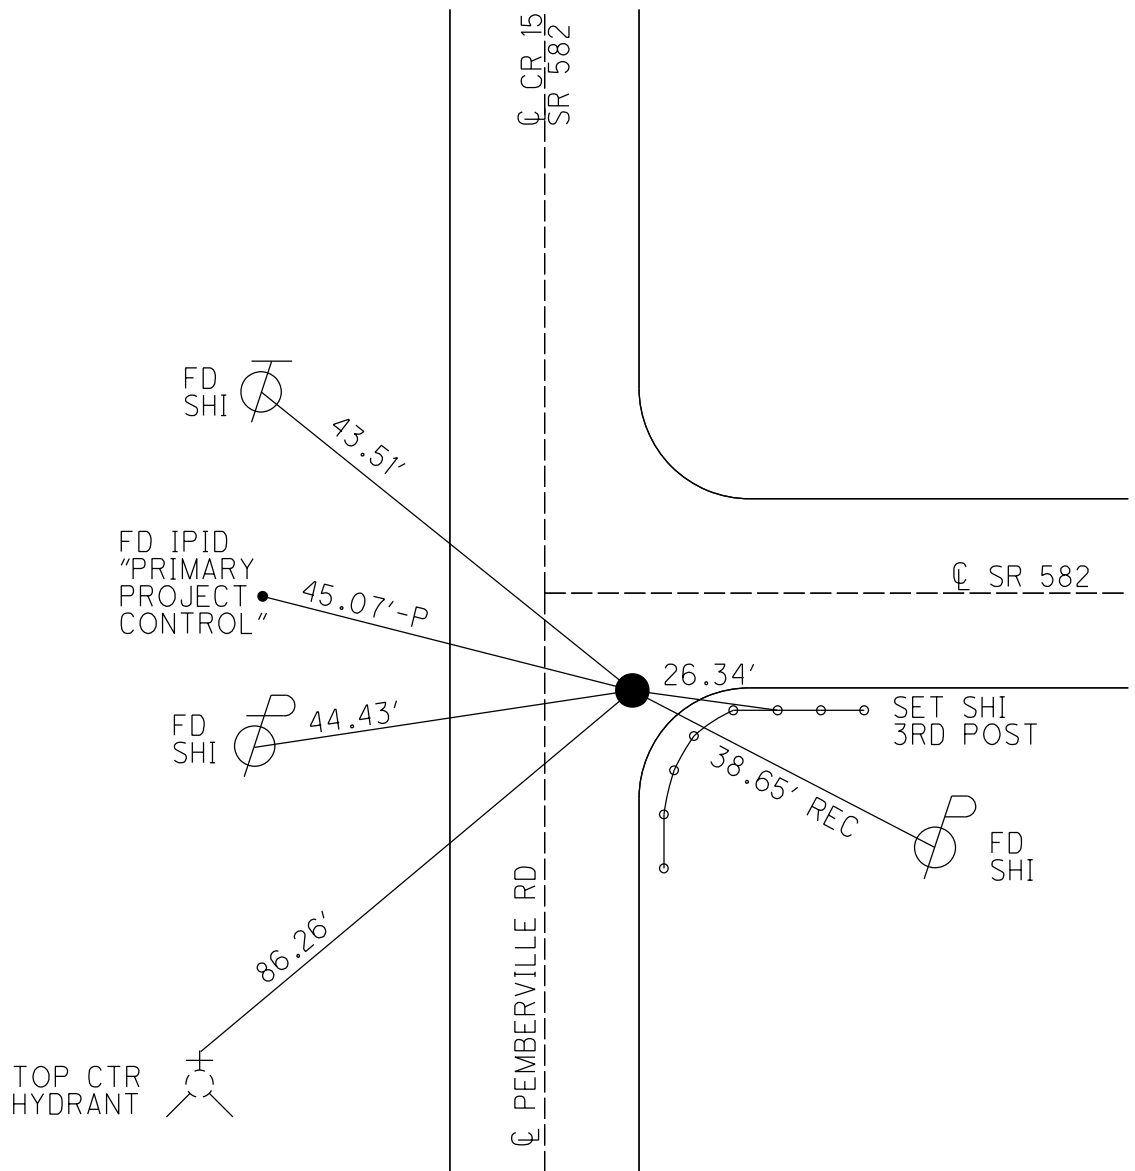

O.D.O.T. DISTRICT 2 SURVEY OFFICE (USE ONLY)

PERSONNEL

REFERENCE NO. 44

SHEET 25 OF 29

NOTES RHOADES

DATE 8-20-19

ROUTE SR 582

H.C. O'DONNELL

WEATHER SUNNY

COUNTY WOOD

R.C. AUBLE

TEMP. 70°

TOWNSHIP TROY

NIESE

SECTION 27

DWG BY NIESE PID NO PID

T 6 N R 12 E

TYPE MONUMENT MAG/WASHER

ON SURFACE - ~~BELOW~~ ON

OFFSET Q PAVEMENT 9.0' ~~LT~~ : RT

- TO - EDGE PAVEMENT 14.9' LT Q S.


STATION: 862+90.02

HORZ.DATUM: NAD83(2011)


GEOID: 2012A

GRID: NORTHING: 651121.026

EASTING: 1707039.234

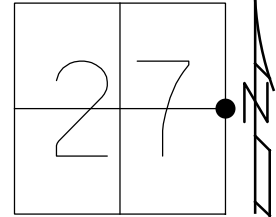

RECORD:
SET P.K./WASHER
11-07-90, MB
SET MAG/WASHER
NEWREF44
7-09-10, DCH
FD MAG/WASHER
REF44
7-31-18, JLL
SET MAG/WASHER
2" DOWN
8-20-19, JFO

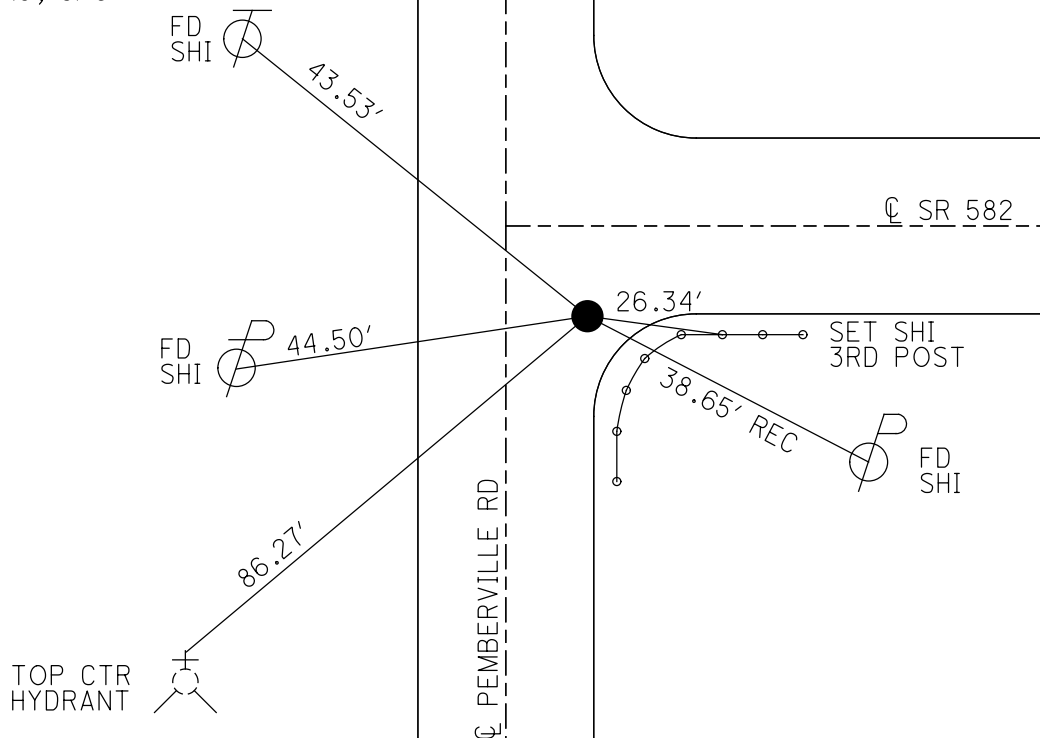

O.D.O.T. DISTRICT 2 SURVEY OFFICE

PERSONNEL

REFERENCE NO. 44

SHEET 25 OF 29

NOTES HOMAN

DATE 4-28-10

ROUTE SR 582

H.C. HOMAN

WEATHER SUNNY

COUNTY WOOD

R.C. ROUSOS

TEMP. 35°

TOWNSHIP TROY

SECTION 27

T 6 N R 12 E

TYPE MONUMENT MAG NAIL


ON SURFACE - ~~BELOW~~ On Surface

~~LEFT~~ - Q PAV'T - RIGHT 9.0' Q EAST

TO EDGE PAVEMENT


S.L.M. 862+90.02, 14.9' LT. Q SOUTH

GRID: NORTHING: 651121.050 EASTING: 1707039.203

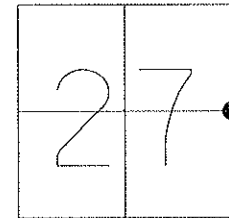

SET PK/WASHER
11-07-90 MB

SET MAG/WASHER
NEWREF44 7-09-10 DCH

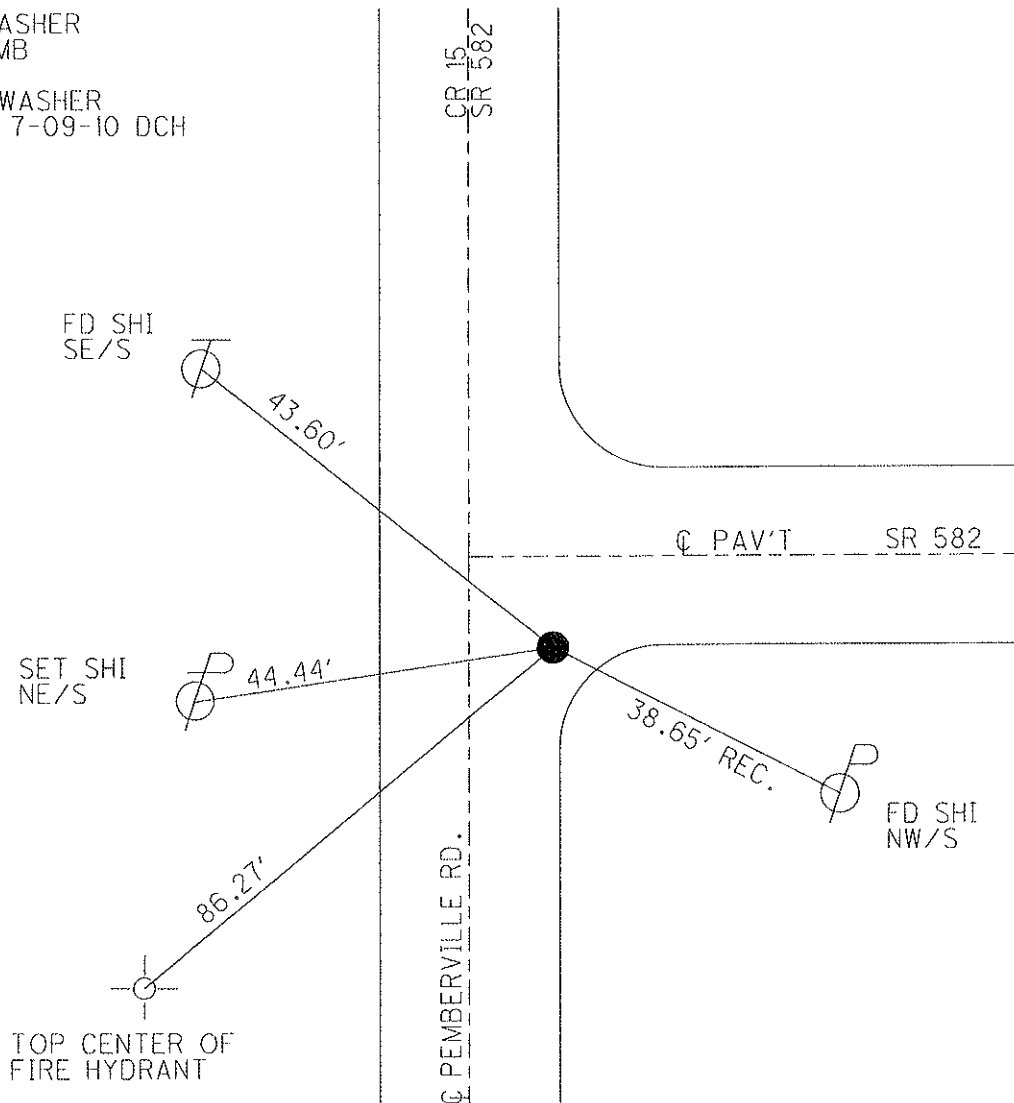

TOP CENTER OF
FIRE HYDRANT

O.D.O.T. DISTRICT 2 SURVEY OFFICE

PERSONNEL _____

REFERENCE NO. 44

SHEET _____ OF _____

NOTES LOEHRKE

H.C. LOEHRKE

R.C. BARNHISEL

DATE 7-26-90

WEATHER CLOUDY

TEMP. +85

ROUTE 582


COUNTY WOOD

TOWNSHIP TROY


SECTION 27

T 6 N R 12 E

TYPE MONUMENT 1/2" IRON PIN
 ON SURFACE - BELOW 1 1/2"
 LEFT - ~~C~~ PAV'T. - RIGHT 9.0' EAST
 — TO — EDGE PAVEMENT 14.9 L~~ft~~ South
 S.L.M. 864+05

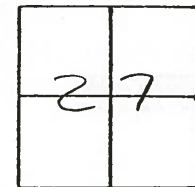

Set P.K. / Washer
11-7-90
MB

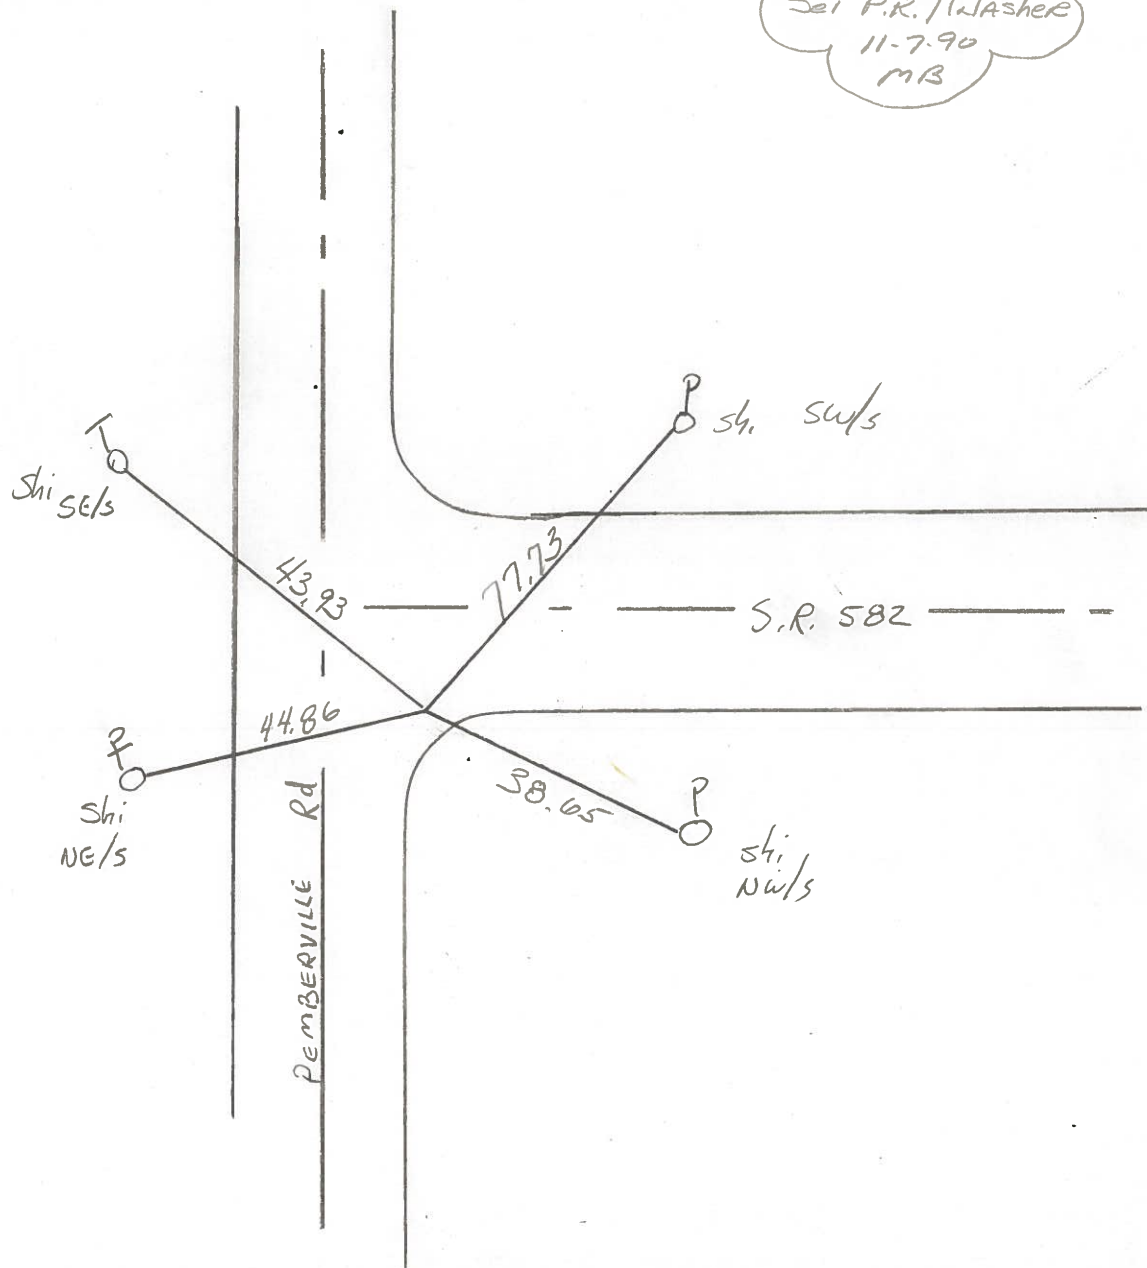

Q.D.O.T. DISTRICT 2 SURVEY OFFICE

SHEET 34 OF

County Wood S.R. 582

Date 13 July 83

Township Troy

Weather Warm

Section 27

Temp. 89°


T N, R E

Personnel I. Stone

P. Neuser


R. Michalak

D. Curtis

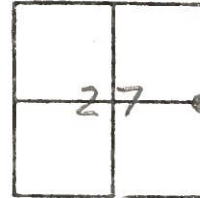

SLM STA. 863+91

REF. No. 44

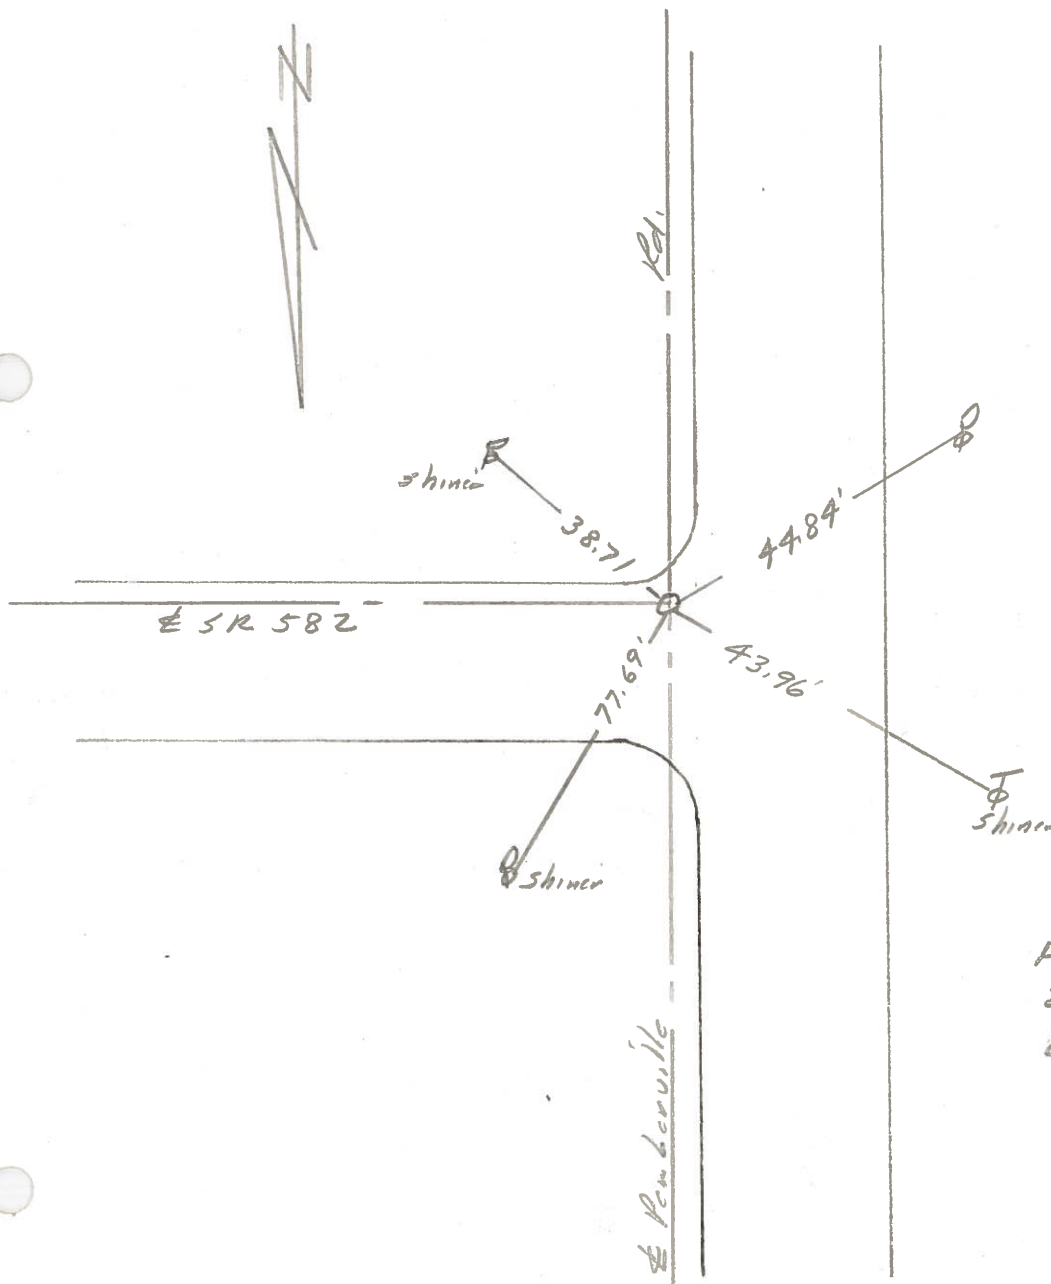

Fd. Small Iron pin 1/2"
25.9' to W. edge pvt.
E 1/4 Cor. Sec. 27

County Wood S.R. 582

Township Troy

Section 26

T6N, R12E

Personnel HOFFMAN

Loehrke


Householder

#44

Date 5-6-82

Weather clear - windy



Temp. +80°

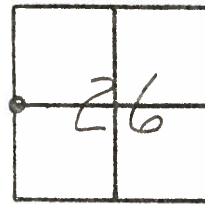

Fd. I. Rod @ surface
1/2" DIA.

15.0' E. of & PAUT Pemberville Rd

7.9' S. of & PAUT S.R. 582

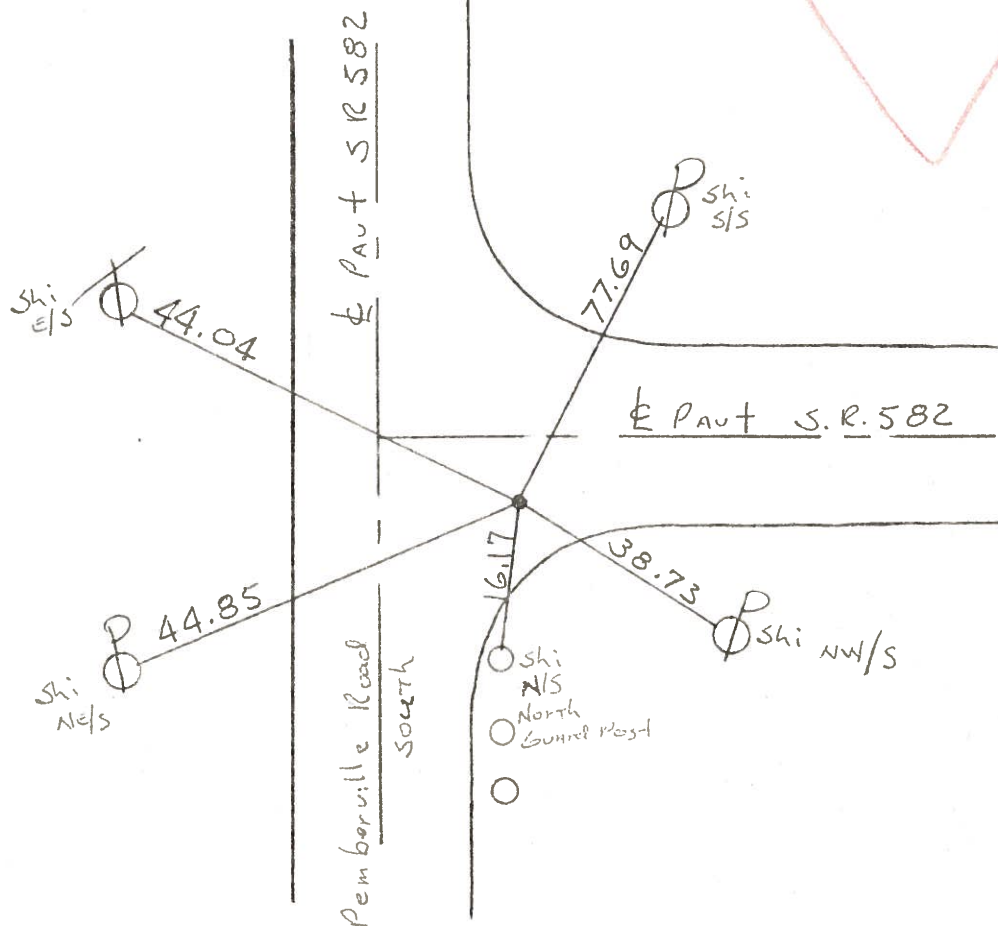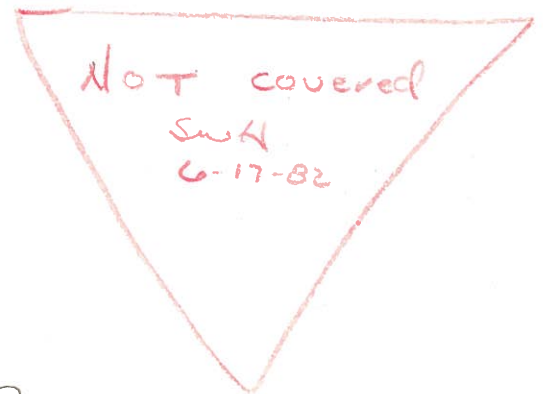

County Wood S.R. 582

Township Troy

Section 26

T6N, R12E

Personnel HOFFMAN

Loehrke


Householder

#44

Date 5-6-82


Weather clear - windy

Temp. +80°

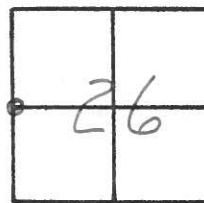

Fd. I. Rod @ surface
1/2" DIA.

15.0' E. of & PAUT Pemberville Rd
7.9' S. of & PAUT S.R. 582

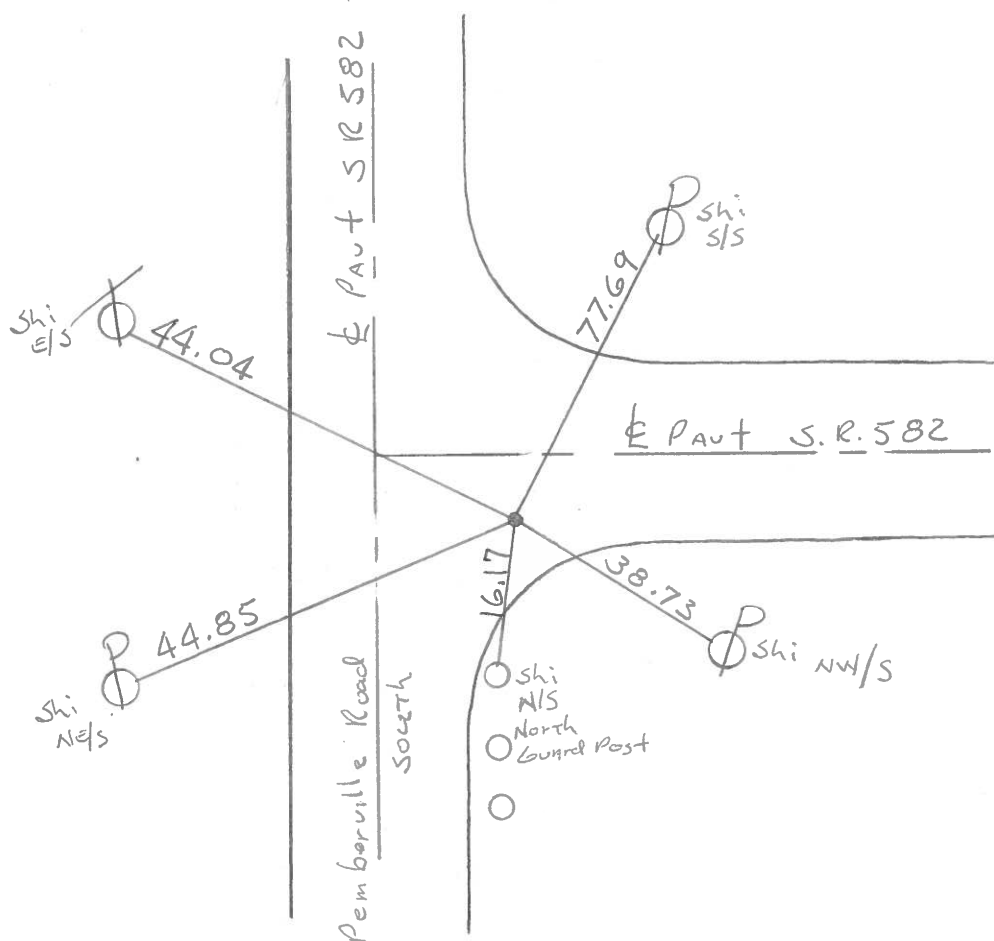

Town 6 N Range 12 E.

INT. Corner of Sections 26 71202

Kind of Monument	Remarks
BOLT	


FOUND
SET 12-14-1970 BY

N. & S. Road _____ F. B. _____ P

E. & W. Road 57. RT. 582 F. B. P

Date Checked:

Date Checked:

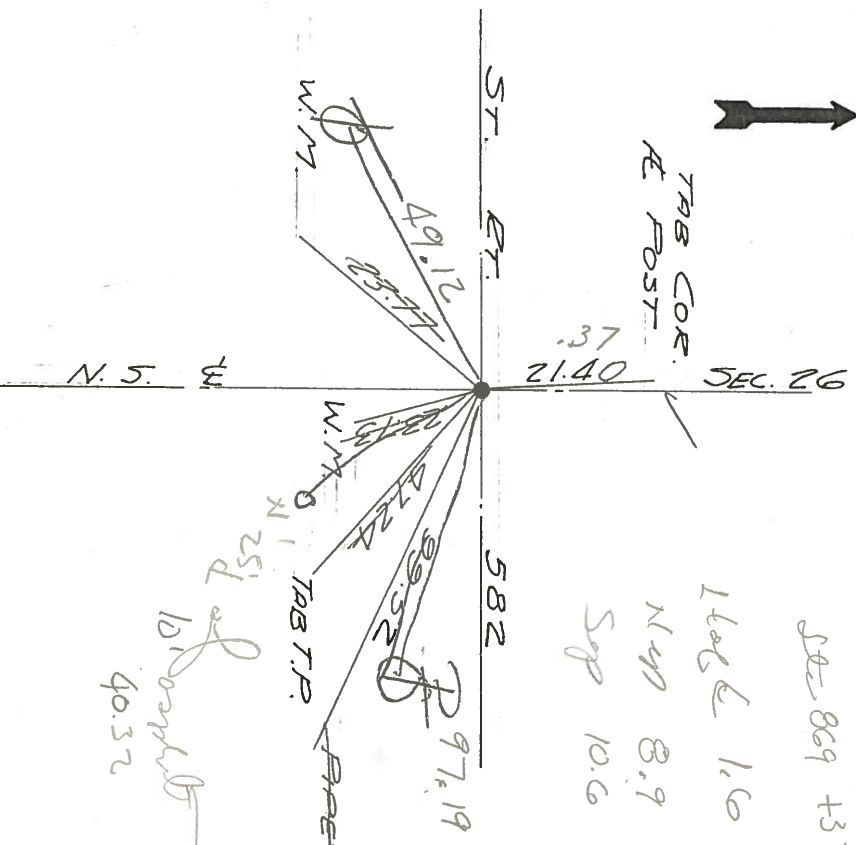

869 + 32

160
160
160

TAB COR.
At Post

Up 8.9
Sep 10.6

40.32