

O.D.O.T. DISTRICT 2 SURVEY OFFICE (USE ONLY)

PERSONNEL

REFERENCE NO. 16C

NOTES MILLER
H.C. O'DONNELL
R.C. -----

DATE 4/25/24
WEATHER SUNNY
TEMP. 40°


ROUTE SR 795
COUNTY WOOD
TOWNSHIP LAKE
SECTION 20
T 7 N R 12 E

DWG BY BARRIERE PID 101149

TYPE MONUMENT IPIN

ON SURFACE - BELOW 2.5' BELOW

OFFSET $\varnothing$ PAVEMENT 257.626' RT

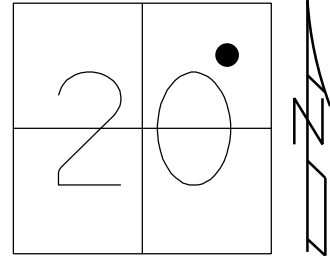

STATION: 379+22.39

HORIZ.DATUM: NAD 83 ('11) GEOID: 12A

GRID: NORTHING: 689678.946 EASTING: 1695550.135

LDP: NORTHING: ----- EASTING: -----

RECORD: P.I.
FD IPIN 1" DOWN
REFC16
5/23/19, JFO

