

O.D.O.T. DISTRICT 2 SURVEY OFFICE (USE ONLY)

PERSONNEL

REFERENCE NO. 22

SHEET 22 OF 22

NOTES LOEHRKE

DATE 7/18/88

ROUTE SR 795

H.C. REED

WEATHER HAZY/HUMID

COUNTY WOOD

R.C. BARNHISEL

TEMP. 85°

TOWNSHIP LAKE

HOFFMAN

SECTION 22

DWG BY NIESE PID _____

T 7 N R 12 E

TYPE MONUMENT MONBOX

~~ON SURFACE~~ - BELOW _____


OFFSET CL PAVEMENT 10.0' LT : ~~RT~~

- TO - EDGE PAVEMENT


STATION: 479+39

HORIZ.DATUM: _____ GEOID: _____

GRID: NORTHING: _____ EASTING: _____

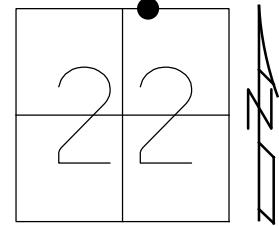

RECORD:
FD MONBOX
BELOW SURFACE
7/18/88, CAL

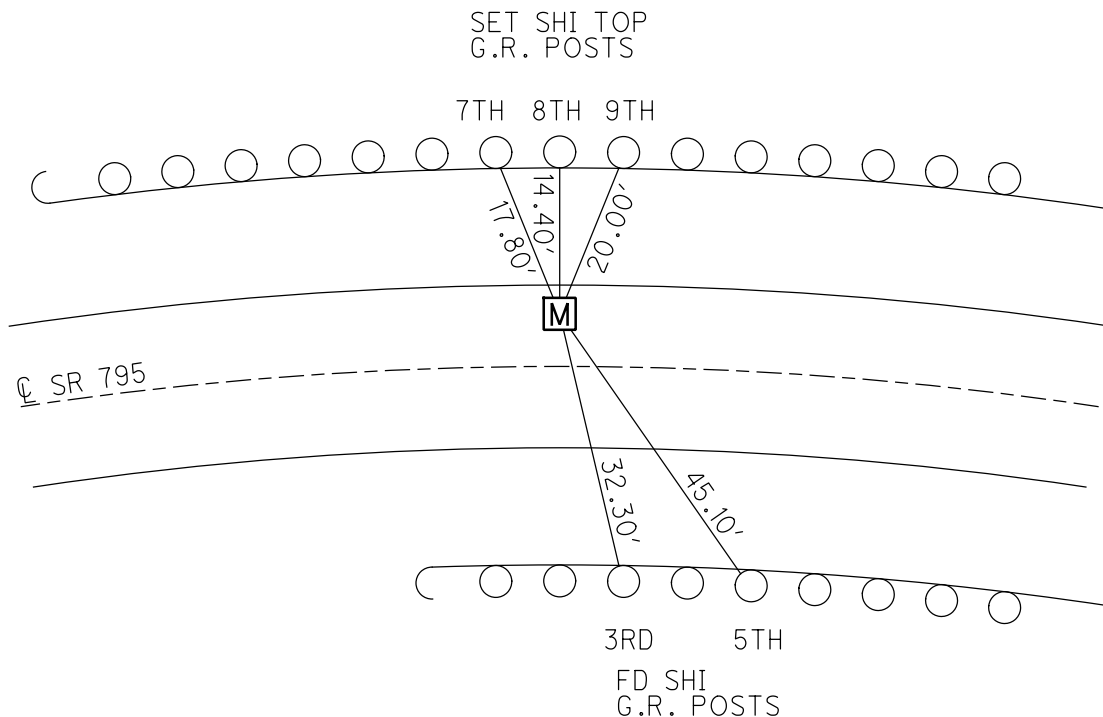

O.D.O.T. DISTRICT 2 SURVEY OFFICE

PERSONNEL

REFERENCE NO. 22

SHEET _____ OF _____

NOTES LOCHKE

H.C. Reed

R.C. KADWISL

H. P. L. M.

DATE 7-18-88

WEATHER Heavy Rain

TEMP. +85

ROUTE SR 795

COUNTY LUOCO

TOWNSHIP LAKE

SECTION 22

T7 N R 12 E



TYPE MONUMENT Mon. Box

ON SURFACE - BELOW BELOW

LEFT & PAV'T. - RIGHT DO LEFT

LT TO NORTH EDGE PAVEMENT

S.L.M. 479+39

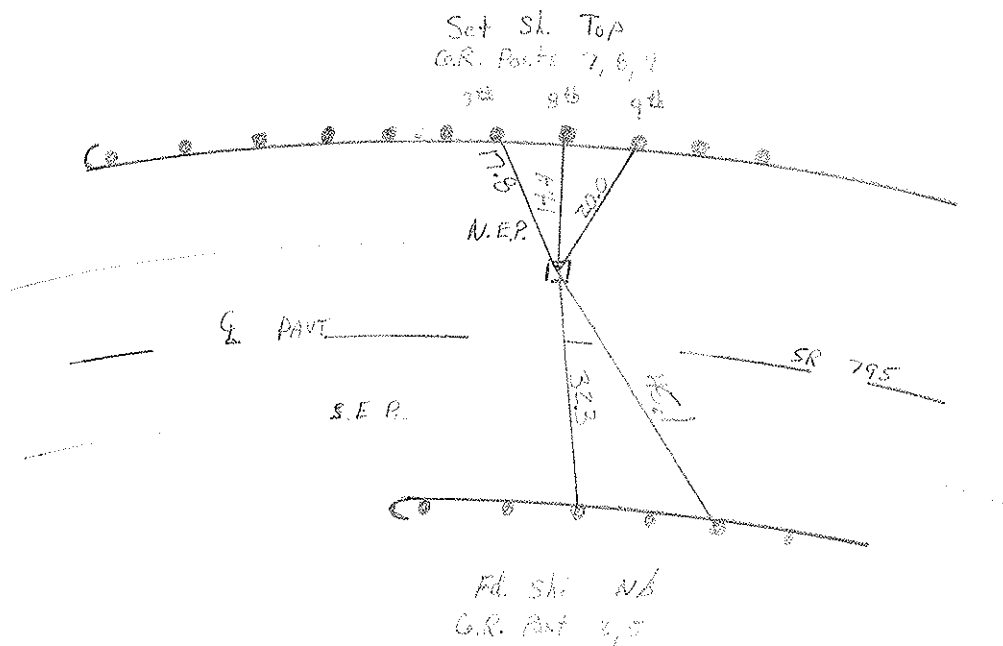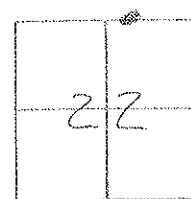

Fd. MON BOX
BELOW SURFACE

to N.E.P.

to Q. PAVT

PERSONNEL	TITLE	PERSONNEL	TITLE	COUNTY	DATE	WEATHER	TEMP.
Stane	Notes			Wood	13 Sept. 71		
Michalak	H.C.			S. R. 795		Cool	
Farr	R.C.			SEC. I-280 - East			68°

DESCRIPTION References to Control Points JOB NO. _____

LEFT CENTER LINE RIGHT

(22)

Ed. Mon. Box to Surface
 .54 Mile East of
 Lemoyne Rd. = P.I.
 2.5' to N. Edge Pnt.
 21.1' to S. Edge Pnt.

Guard rail

Guard Rail

45.00'
 32.10'
 35.69'

shines in
 guard post

E. Const. SR-285

RAMP TO EXP.

CON.

RAMP FROM EXP.

(23)

Ed. Mon. Box. To Surface
 .80 Mile East of Lemoyne
 Rd. = P.I.

to N. Edge Pnt.
 to S. Edge Pnt.

E SR-795

DRIVE TO REST.

PERSONNEL	TITLE	PERSONNEL	TITLE	COUNTY	DATE	WEATHER	TEMP.
Stear	Notes			Wood	13 Sept. 71		
Michaelak	H.C.			S. R. 795		Cool	
Farr	R.C.			SEC. I-280 - East			68°

DESCRIPTION References to Control Points LEFT CENTER LINE RIGHT JOB NO.

