

O.D.O.T. DISTRICT 2 SURVEY OFFICE (USE ONLY)

PERSONNEL

REFERENCE NO. 25 A

SHEET 5 OF 11

NOTES HUSS

DATE 4/13/12

ROUTE SR 795

H.C. CANTERBURY

WEATHER CLEAR

COUNTY WOOD

R.C. HUSS

TEMP. 59°

TOWNSHIP LAKE

SECTION 23

T 7 N R 12 E

TYPE MONUMENT SM.R.R.SPIKE


ON SURFACE - ~~BELOW~~ ON

~~LEFT~~ - CL PAV'T - RIGHT 3.8'

5.3' TO RT EDGE PAVEMENT

S.L.M. 537+42.63

Grid: Northing: 690738.344 Easting: 1712397.365

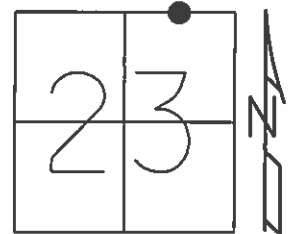


RECORD: 1988
FD R.R.SPIKE, 7/18/88
RESET SM.R.R.SPIKE, 9/28/88
SLM: 542+05

FD SM.R.R.SPIKE
12/16/10
GPS, REFA25
12/17/10, MC

SET MAG/WASHER
10/22/12, SAH
GPS, NEWREFA25
4/17/13, SDC

SET "+" IN
TOP OF ROCK
12' N.OF N.E.B.

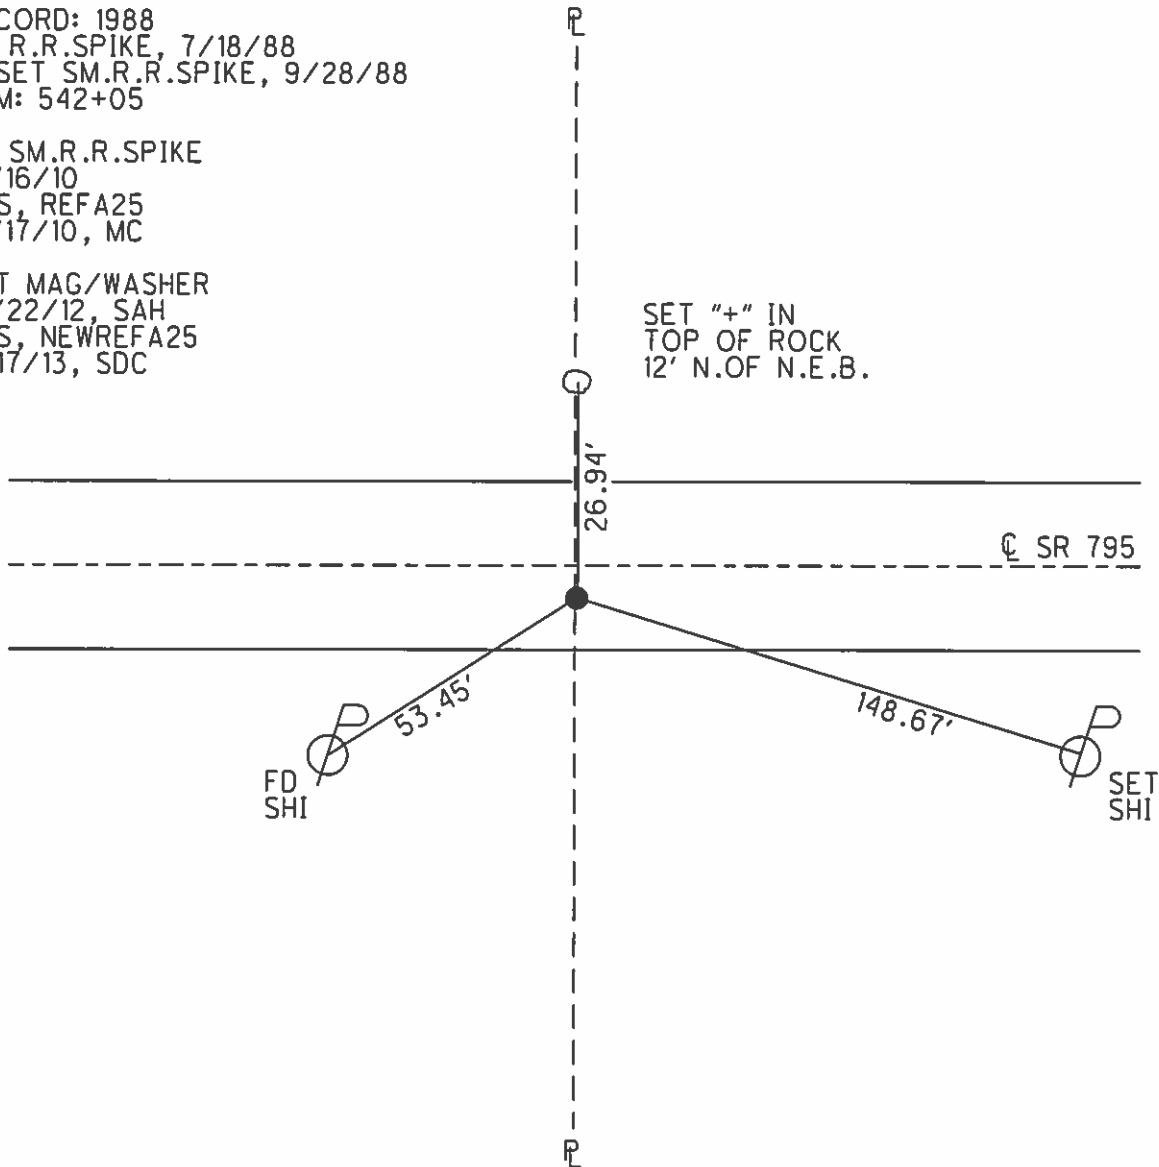

O.D.O.T. DISTRICT 2 SURVEY OFFICE

PERSONNEL

REFERENCE NO. 26-A

SHEET _____ OF _____

NOTES LOEHRKE
H.C. REED
R.C. BARDHISEL
Hoffman

DATE 7-18-88
WEATHER HAZY
TEMP. +82



Reset Sm R.R Spike
9-28-88
C.I.

ROUTE S.R. 795
COUNTY WOOD
TOWNSHIP LAKE
SECTION 23
T 7 N R 12 E

TYPE MONUMENT RR Spike
ON SURFACE - BELOW 2" Rebar
~~LEFT~~ & PAW'T. - RIGHT 3.3
7/16 TO RT EDGE PAVEMENT
S.L.M. 542+05 551+76

25-A

26-A

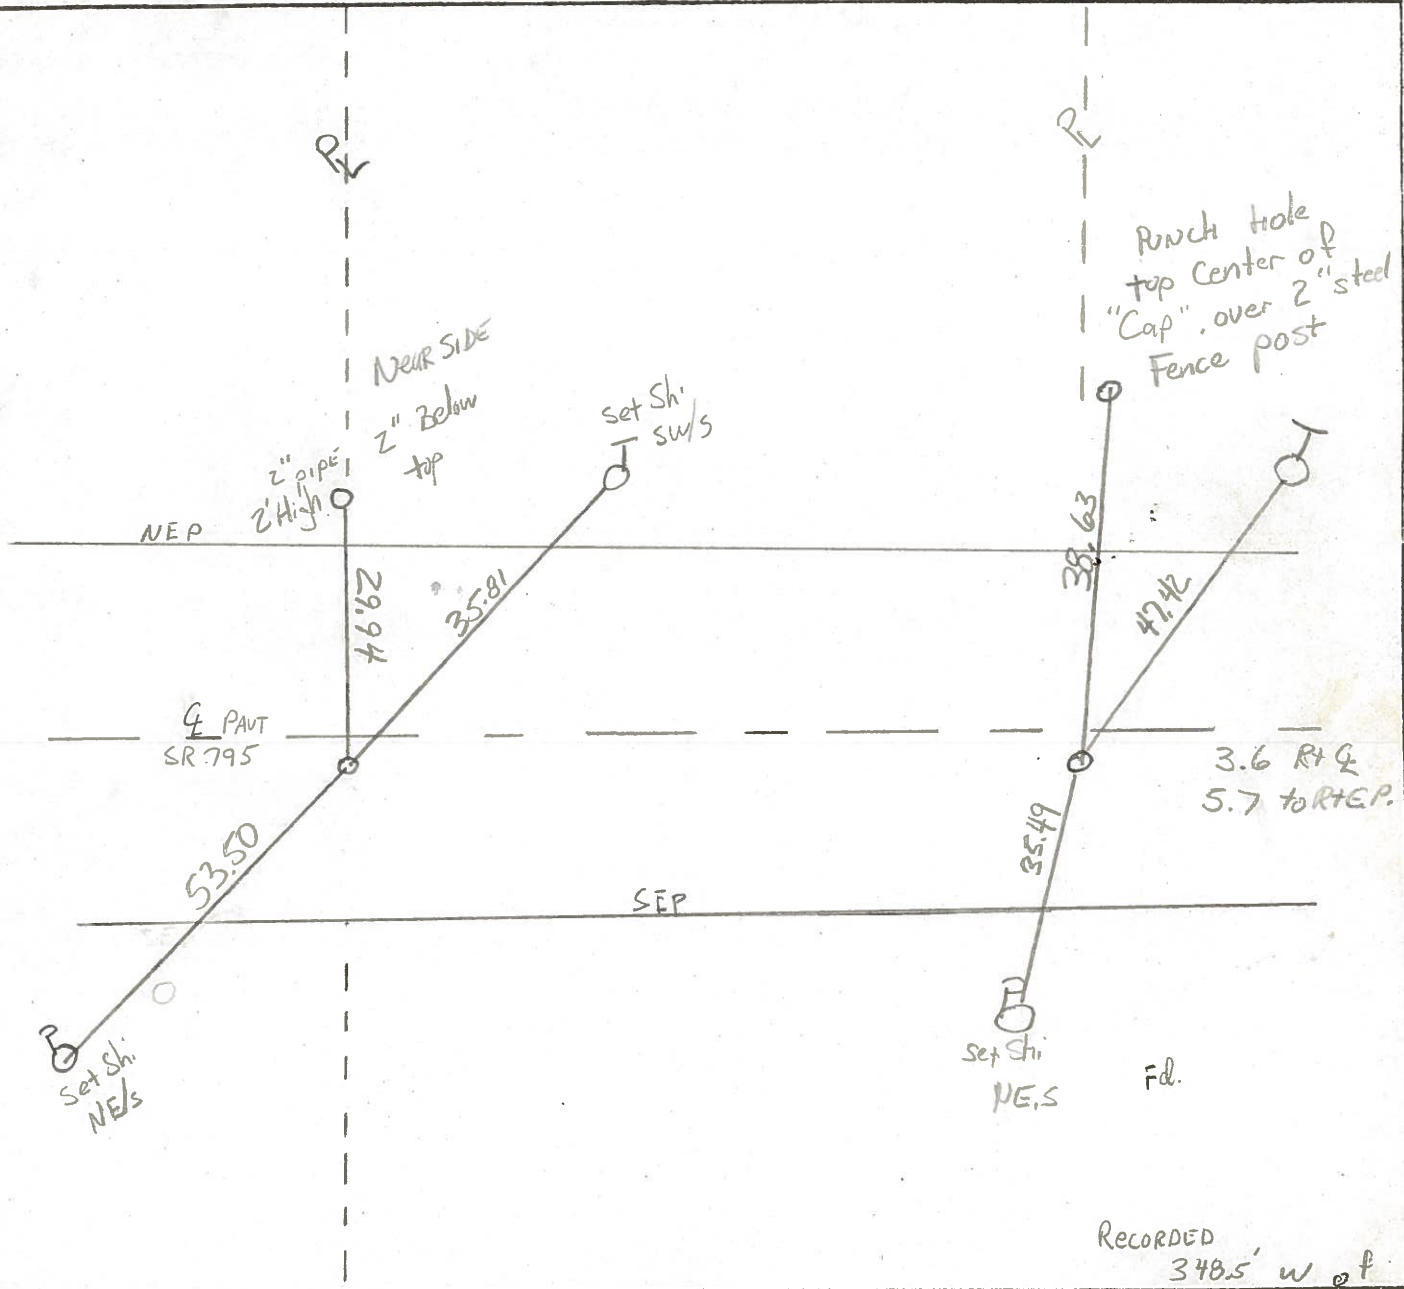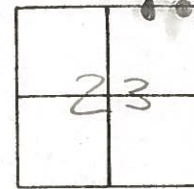

RECORDED
348.5' w of
INT. BRADNER Rd

PERSONNEL TITLE PERSONNEL TITLE

COUNTY Wood

DATE 1-11-72

S. R. 795

WEATHER

SEC.

TEMP.


DESCRIPTION Extra ties between Bradner Rd & Schwalder

JOB NO.

LEFT

CENTER LINE

RIGHT

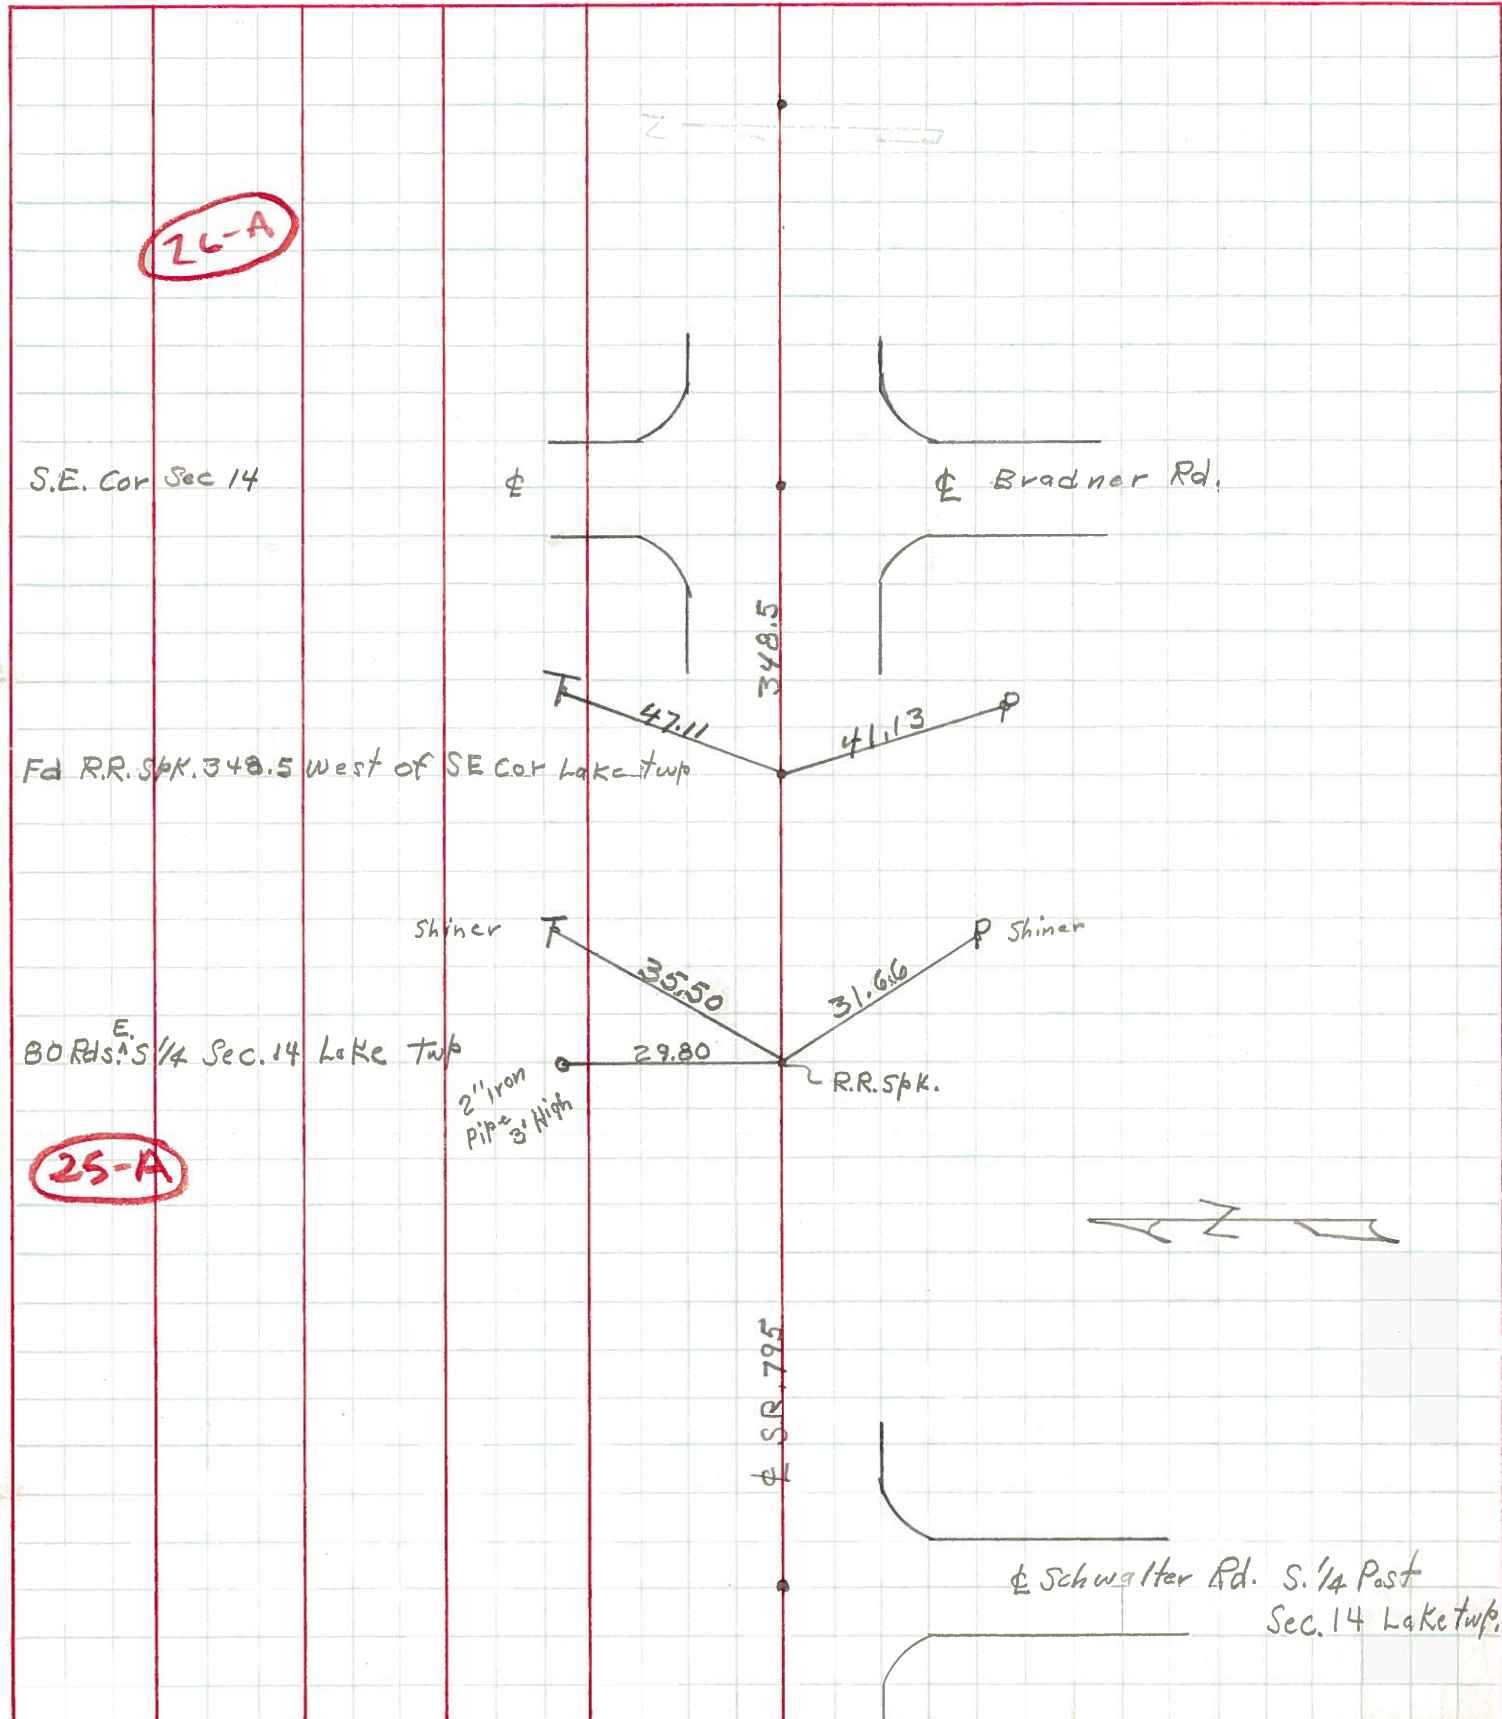

PERSONNEL	TITLE	PERSONNEL	TITLE
1	2	3	4
5	6	7	8
9	10	11	12
13	14	15	16
17	18	19	20
21	22	23	24
25	26	27	28
29	30	31	32
33	34	35	36
37	38	39	40
41	42	43	44
45	46	47	48
49	50	51	52
53	54	55	56
57	58	59	60
61	62	63	64
65	66	67	68
69	70	71	72
73	74	75	76
77	78	79	80
81	82	83	84
85	86	87	88
89	90	91	92
93	94	95	96
97	98	99	100

COUNTY Wood

DATE 1-11-72

S. R. 795

WEATHER

SEC.

TEMP.

DESCRIPTION Extra ties between Bradner Rd & Schwalder

JOB NO.

LEFT

CENTER LINE

RIGHT

