


O.D.O.T. DISTRICT 2 SURVEY OFFICE (USE ONLY)


PERSONNEL _____ REFERENCE NO. A SHEET 1 OF 17
 NOTES BURNSIDE DATE 9/28/70 ROUTE OLD US 6
 H.C. SMITH WEATHER _____ COUNTY WOOD
 R.C. HOFFMAN TEMP. _____ TOWNSHIP PLAIN
 DWG BY RHOADES PID _____ SECTION 27
 T 5 N R 10 E

TYPE MONUMENT P.K.NAIL
 ON SURFACE - ~~BELOW~~ ON _____
 OFFSET \odot PAVEMENT ON _____ LT : RT _____
 - TO - EDGE PAVEMENT _____
 STATION: 479+87.20

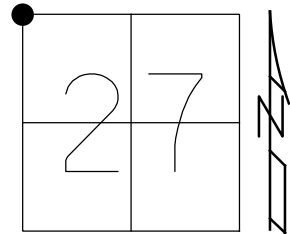

HORZ.DATUM: _____ GEOID: _____
 GRID: NORTHING: _____ EASTING: _____


RECORD:
 $\Delta = 0^\circ 32' \text{ LT}$
 STA. 479+94+5
 FD R.R.SPIKE
 SET IPIN
 1960
 FD BRASS MON.
 2/21/68
 9/28/70
 SET P.K.NAIL
 9/28/70, SH

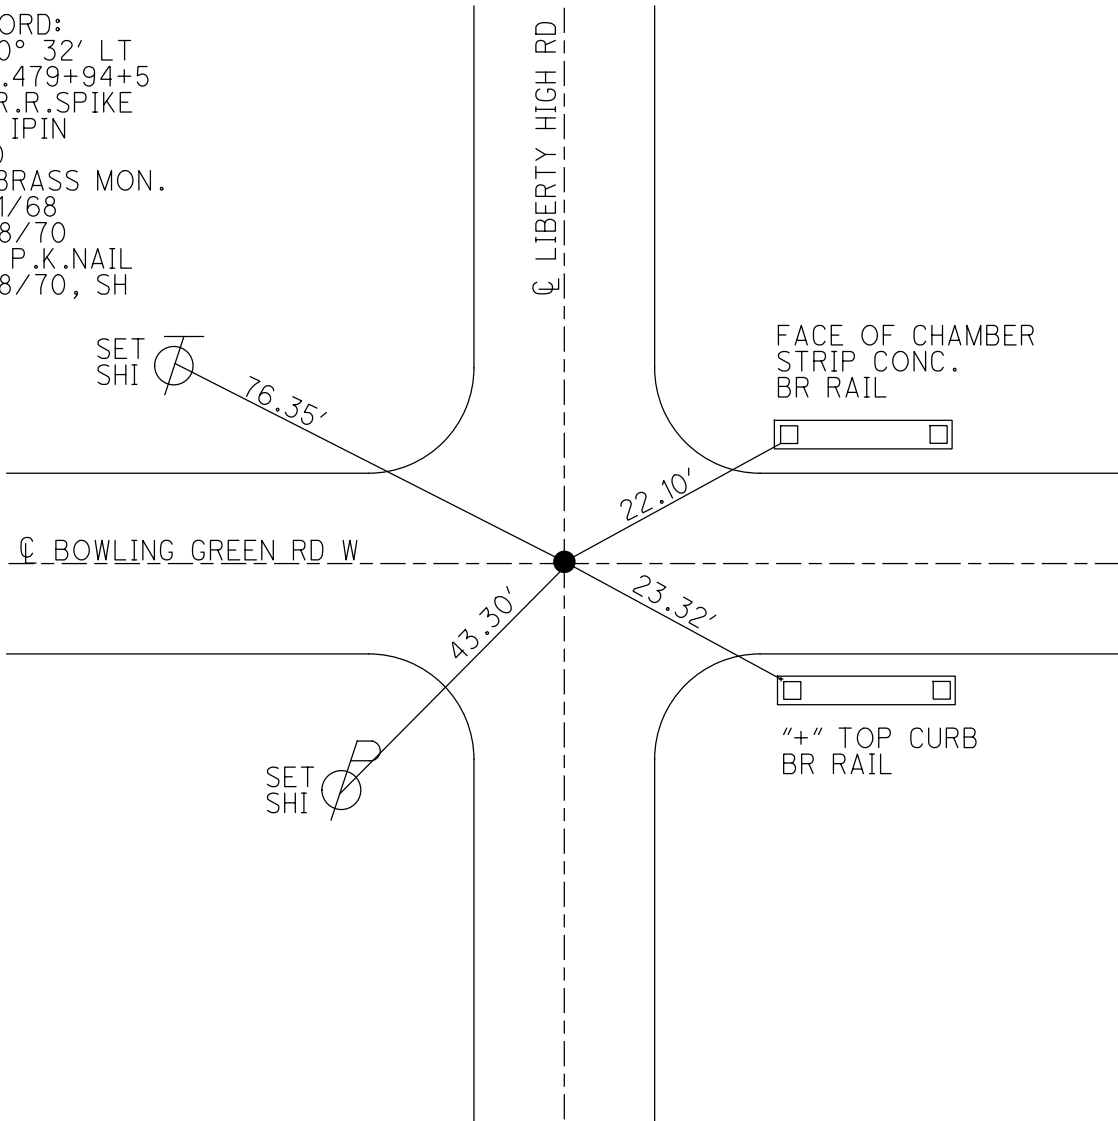

O.D.O.T. DISTRICT 2 SURVEY OFFICE (USE ONLY)


PERSONNEL _____ REFERENCE NO. B SHEET 2 OF 17
 NOTES BURNSIDE DATE 9/28/70 ROUTE OLD US 6
 H.C. SMITH WEATHER _____ COUNTY WOOD
 R.C. HOFFMAN TEMP. _____ TOWNSHIP PLAIN
 DWG BY RHOADES PID _____ SECTION 27
 T 5 N R 10 E

TYPE MONUMENT P.K.NAIL
 ON SURFACE - ~~BELOW~~ ON
 OFFSET ☐ PAVEMENT ON _____ LT : RT
 _____ TO _____ EDGE PAVEMENT
 STATION: 506+40.30

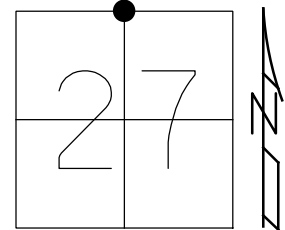

HORZ.DATUM: _____ GEOID: _____
 GRID: NORTHING: _____ EASTING: _____

RECORD:
 $\Delta = 1^\circ 22' RT$
 STA. 506+46.38
 SET R.R.SPIKE
 1960
 FD BRASS MON.
 2/21/68
 $\Delta = 1^\circ 20' RT$
 9/28/70
 SET P.K.NAIL
 9/28/70, SH

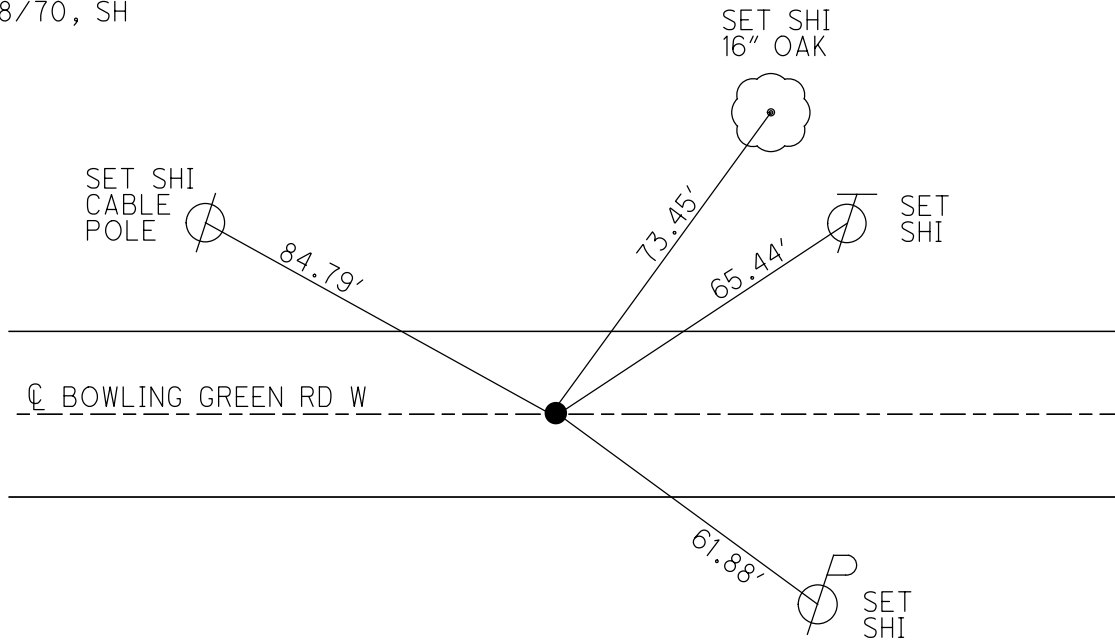

O.D.O.T. DISTRICT 2 SURVEY OFFICE (USE ONLY)

PERSONNEL _____ REFERENCE NO. C SHEET 3 OF 17

NOTES BURNSIDE DATE 11/3/70 ROUTE OLD US 6
 H.C. SMITH WEATHER _____ COUNTY WOOD
 R.C. BOWERS TEMP. _____ TOWNSHIP PLAIN
 HOLCOMBE SECTION 26

DWG BY RHOADES PID _____ T 5 N R 10 E

TYPE MONUMENT P.K.NAIL

ON SURFACE - ~~BELOW~~ ON _____


OFFSET C PAVEMENT ON _____ LT : RT

- TO - EDGE PAVEMENT


STATION: 533+06.11

HORIZ.DATUM: _____ GEOID: _____

GRID: NORTHING: _____ EASTING: _____

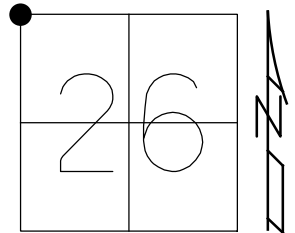


RECORD:
 $\Delta = 0^\circ 16' \text{ RT}$
 STA .533+12.9
 SET R.R.SPIKE
 1960
 FD BRASS MON.
 2/21/68
 $\Delta = 0^\circ 15' \text{ RT}$
 11/3/70
 SET P.K.NAIL
 11/3/70, SH

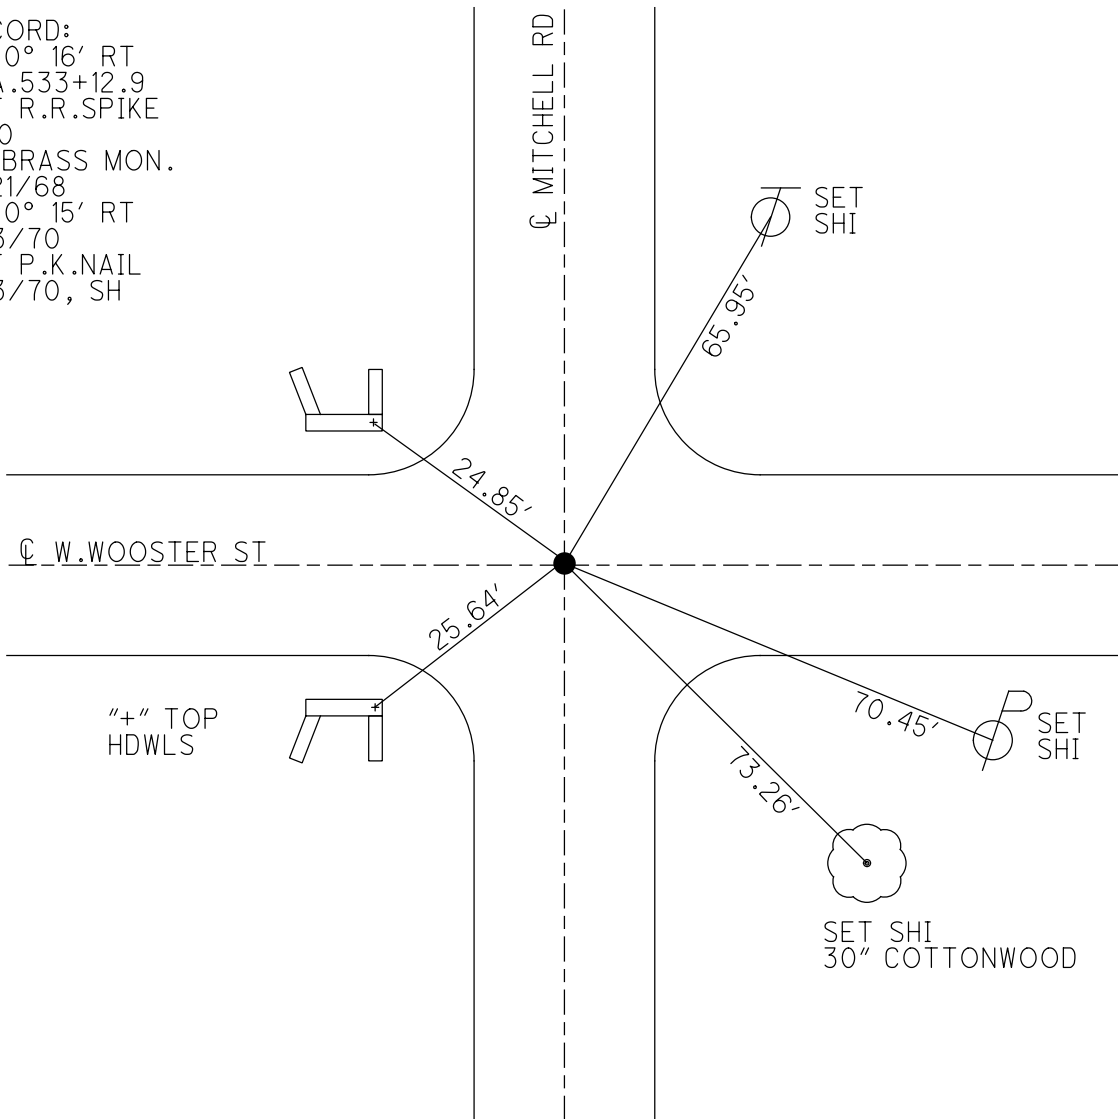


O.D.O.T. DISTRICT 2 SURVEY OFFICE (USE ONLY)

PERSONNEL _____ REFERENCE NO. D SHEET 4 OF 17
 NOTES BURNSIDE DATE 11/3/70 ROUTE OLD US 6
 H.C. SMITH WEATHER _____ COUNTY WOOD
 R.C. HOLCOMBE TEMP. _____ TOWNSHIP PLAIN
 BOWERS SECTION 26
 DWG BY RHOADES PID _____ T 5 N R 10 E
 TYPE MONUMENT P.K.NAIL
 ON SURFACE - ~~BELOW~~ _____ ON _____
 OFFSET ☉ PAVEMENT ON _____ LT : RT
 _____ TO _____ EDGE PAVEMENT
 STATION: 560+06.78
 HORZ.DATUM: _____ GEOID: _____
 GRID: NORTHING: _____ EASTING: _____

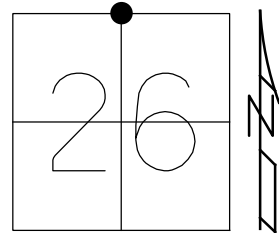


RECORD:
 Δ= 0° 50' LT
 STA. 560+13.75
 SET R.R.SPIKE
 1960
 FD BRASS MON.
 2/21/68
 Δ= 0° 51' LT
 11/3/70
 SET P.K.NAIL
 11/3/70, SH

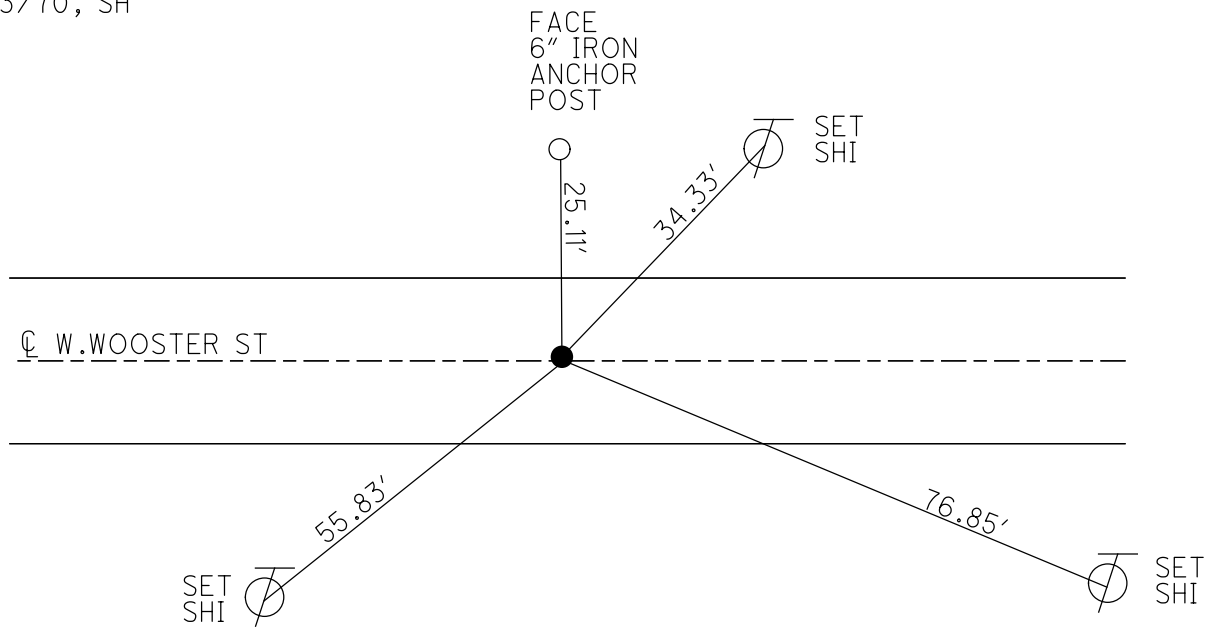

O.D.O.T. DISTRICT 2 SURVEY OFFICE (USE ONLY)

PERSONNEL _____ REFERENCE NO. E SHEET 5 OF 17
 NOTES BURNSIDE DATE 11/3/70 ROUTE OLD US 6
 H.C. SMITH WEATHER _____ COUNTY WOOD
 R.C. HOLCOMBE TEMP. _____ TOWNSHIP PLAIN
 _____ BOWERS _____ SECTION 26
 DWG BY RHOADES PID _____ T 5 N R 10 E

TYPE MONUMENT P.K.NAIL
 ON SURFACE - ~~BELOW~~ ON _____
 OFFSET \odot PAVEMENT ON _____ LT : RT
 - TO - EDGE PAVEMENT
 STATION: 569+73.93

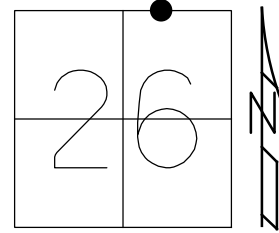

HORZ.DATUM: _____ GEOID: _____
 GRID: NORTHING: _____ EASTING: _____

SET SHI
30" BOXELDER



91.35'

SET SHI



40.80'

\odot W.WOOSTER ST

18.33'




SET SHI

23.57'



SET SHI

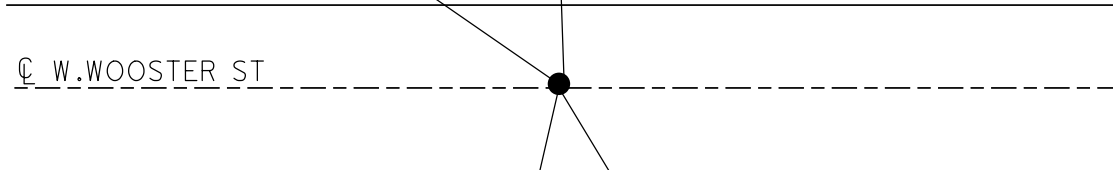

O.D.O.T. DISTRICT 2 SURVEY OFFICE (USE ONLY)

PERSONNEL

REFERENCE NO. F

SHEET 6 OF 17

NOTES BURNSIDE

DATE 11/3/70

ROUTE OLD US 6

H.C. SMITH

WEATHER _____

COUNTY WOOD

R.C. HOFFMAN

TEMP. _____

TOWNSHIP PLAIN

DWG BY RHOADES

PID _____

SECTION 23

T 5 N R 10 E

TYPE MONUMENT CMON

ON SURFACE - ~~BELOW~~ ON _____

OFFSET \odot PAVEMENT ON _____ LT : RT

_____ TO _____ EDGE PAVEMENT


STATION: 573+97.07

HORZ. DATUM: _____


GEOID: _____

GRID: NORTHING: _____

EASTING: _____

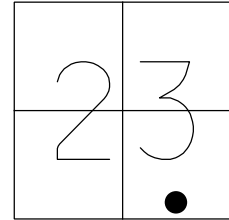

RECORD:
STA. 573+97.07
FD CMON
11/3/70, SH

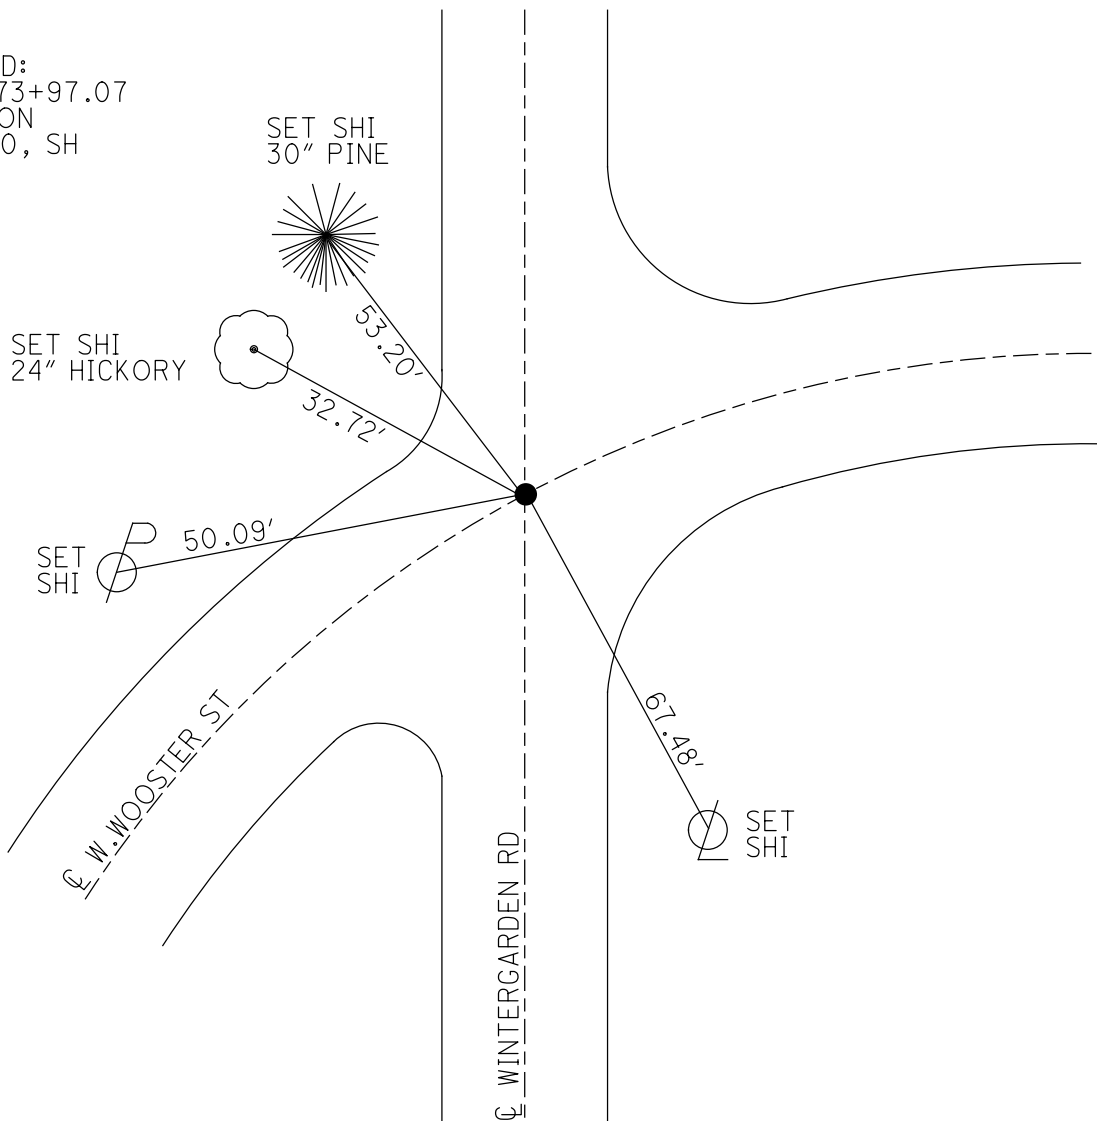

O.D.O.T. DISTRICT 2 SURVEY OFFICE (USE ONLY)

PERSONNEL

REFERENCE NO. G

SHEET 7 OF 17

NOTES BURNSIDE

DATE 11/3/70

ROUTE OLD US 6

H.C. SMITH

WEATHER _____

COUNTY WOOD

R.C. HOFFMAN

TEMP. _____

TOWNSHIP PLAIN

DWG BY RHOADES PID _____

SECTION 23

T 5 N R 10 E

TYPE MONUMENT P.K.NAIL

ON SURFACE - ~~BELOW~~ ON _____


OFFSET \odot PAVEMENT ON _____ LT : RT

_____ TO _____ EDGE PAVEMENT


STATION: 581+03

HORZ.DATUM: _____ GEOID: _____

GRID: NORTHING: _____ EASTING: _____

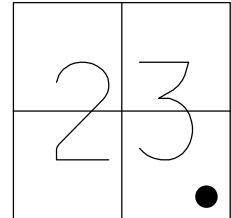

RECORD:
 $\Delta = 12^\circ 15' \text{ LT}$
 STA. 581+03
 FD P.K.NAIL
 2/23/68
 SET P.K.NAIL
 11/3/70, SH

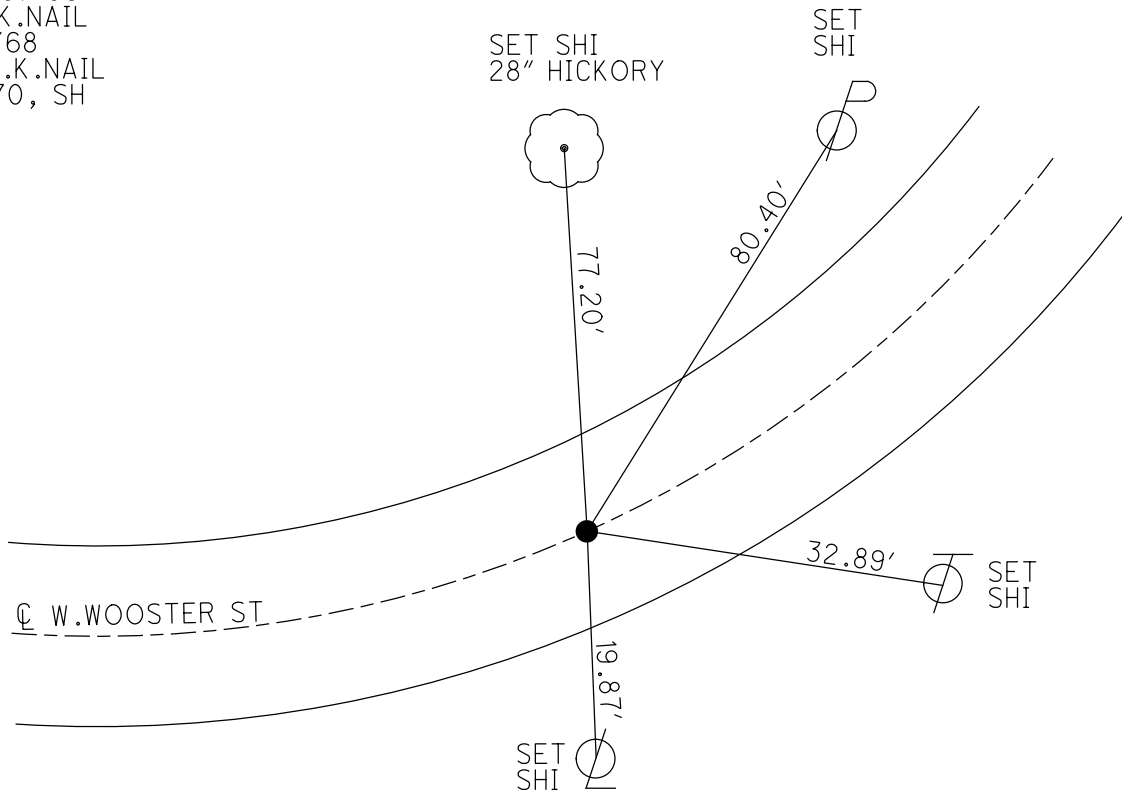


O.D.O.T. DISTRICT 2 SURVEY OFFICE (USE ONLY)


PERSONNEL _____ REFERENCE NO. H SHEET 8 OF 17
 NOTES BURNSIDE DATE 11/3/70 ROUTE OLD US 6
 H.C. SMITH WEATHER _____ COUNTY WOOD
 R.C. HOFFMAN TEMP. _____ TOWNSHIP BOWLING GREEN
 DWG BY RHOADES PID _____ SECTION 23
 T 5 N R 10 E

TYPE MONUMENT P.K.NAIL
 ON SURFACE - ~~BELOW~~ ON _____
 OFFSET Q PAVEMENT ON _____ LT : RT
 - _____ TO - _____ EDGE PAVEMENT
 STATION: 587+49.58

HORZ.DATUM: _____ GEOID: _____
 GRID: NORTHING: _____ EASTING: _____

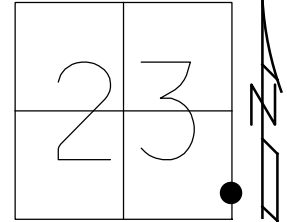


RECORD:
 BOWLING GREEN
 CORP. LINE
 STA. 587+49.58
 FD P.K.NAIL
 2/23/68
 11/3/70, SH

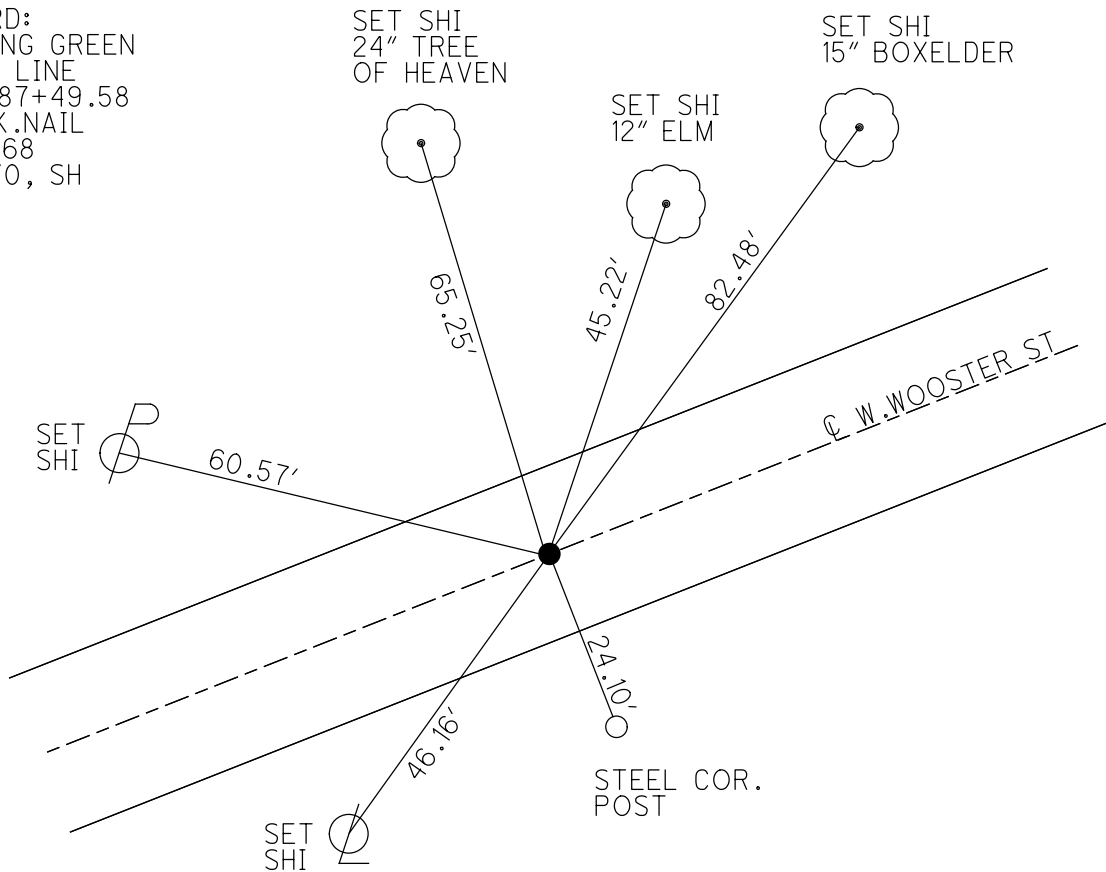


O.D.O.T. DISTRICT 2 SURVEY OFFICE (USE ONLY)

PERSONNEL _____ REFERENCE NO. 1 SHEET 9 OF 17
 NOTES BURNSIDE DATE 11/3/70 ROUTE OLD US 6
 H.C. SMITH WEATHER _____ COUNTY WOOD
 R.C. HOFFMAN TEMP. _____ TOWNSHIP BOWLING GREEN
 DWG BY RHOADES PID _____ SECTION 24
 TYPE MONUMENT P.K.NAIL T 5 N R 10 E
 ON SURFACE - ~~BELOW~~ ON _____
 OFFSET ϕ PAVEMENT ON _____ LT : RT
 - TO - EDGE PAVEMENT
 STATION: 587+85.04
 HORZ.DATUM: _____ GEOID: _____
 GRID: NORTHING: _____ EASTING: _____

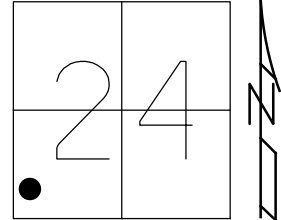


RECORD:
 $\Delta = 11^\circ 26' \text{ LT}$
 STA. 587+85.04
 FD P.K.NAIL
 2/23/68
 11/3/70, SH

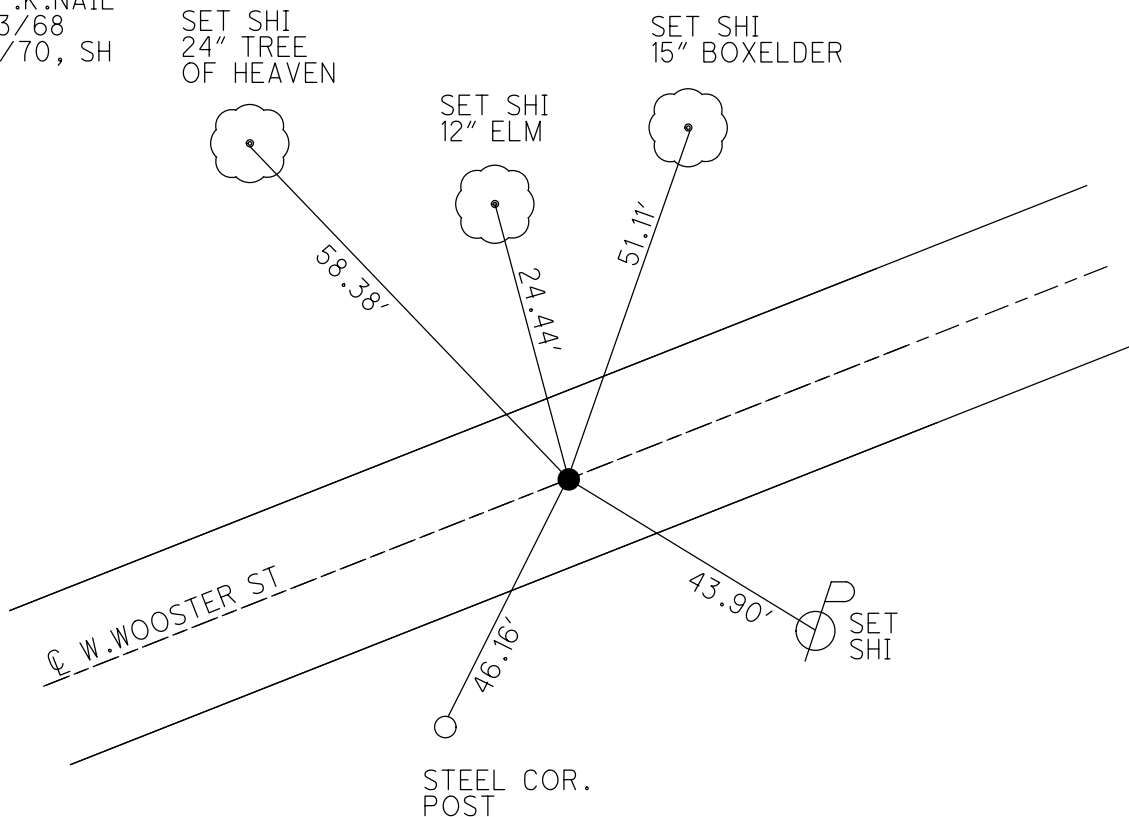


O.D.O.T. DISTRICT 2 SURVEY OFFICE (USE ONLY)

PERSONNEL _____ REFERENCE NO. J SHEET 10 OF 17
 NOTES BURNSIDE DATE 5/14/70 ROUTE OLD US 6
 H.C. SMITH WEATHER _____ COUNTY WOOD
 R.C. HOFFMAN TEMP. _____ TOWNSHIP BOWLING GREEN
 _____ SECTION 24
 DWG BY RHOADES PID _____ T 5 N R 10 E
 TYPE MONUMENT P.K.NAIL
 ON SURFACE - ~~BELOW~~ ON _____
 OFFSET \odot PAVEMENT ON _____ LT : RT
 - TO - EDGE PAVEMENT
 STATION: 592+89.12
 HORZ.DATUM: _____ GEOID: _____
 GRID: NORTHING: _____ EASTING: _____

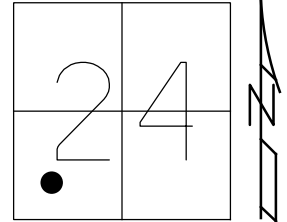

RECORD:
 STA. 592+89.12
 FD R.R.SPIKE
 2/23/68
 FD P.K.NAIL
 5/14/70, SH

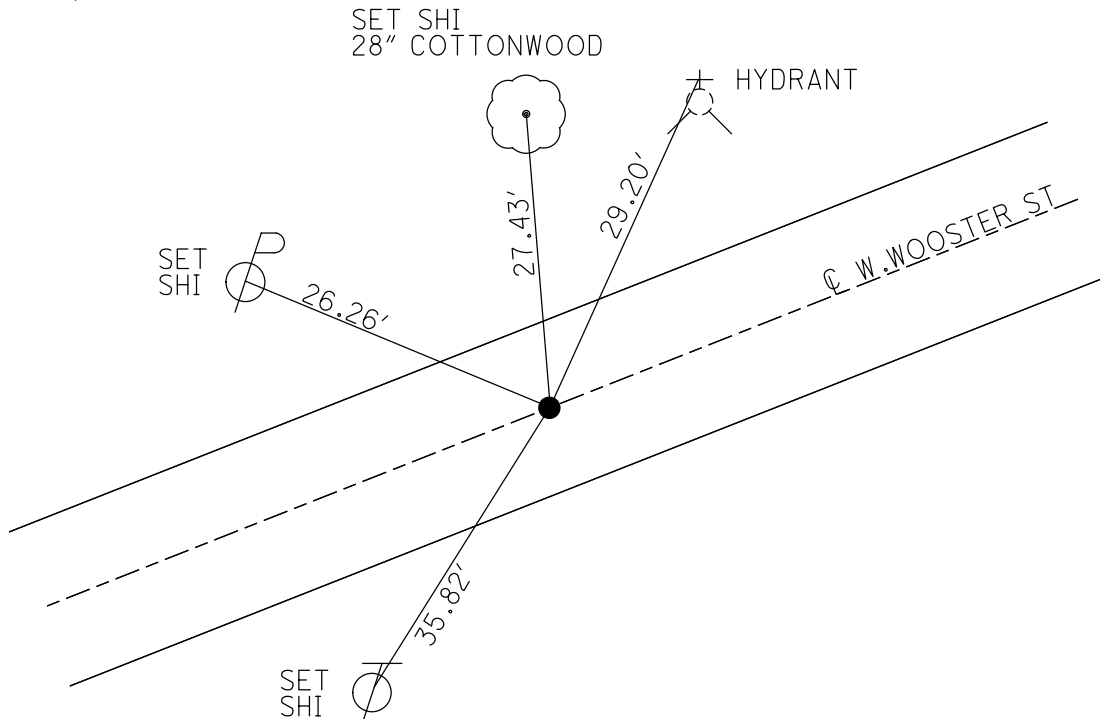

O.D.O.T. DISTRICT 2 SURVEY OFFICE (USE ONLY)

PERSONNEL _____

REFERENCE NO. K

SHEET 11 OF 17

NOTES BURNSIDE

DATE 5/14/70

ROUTE OLD US 6

H.C. SMITH

WEATHER _____

COUNTY WOOD

R.C. HOFFMAN

TEMP. _____

TOWNSHIP BOWLING GREEN

DWG BY RHOADES

PID _____

SECTION 24

T 5 N R 10 E

TYPE MONUMENT 1" IPIN

~~ON SURFACE~~ - BELOW 1"

OFFSET $\text{\textcircled{C}}$ PAVEMENT 2.15' LT : ~~RT~~

 - TO - EDGE PAVEMENT


STATION: 595+78.60

HORIZ.DATUM: _____


GEOID: _____

GRID: NORTHING: _____

EASTING: _____

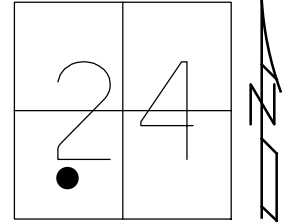

RECORD:
 $\Delta = 5^{\circ} 57' \text{ RT}$
 STA. 595+78.60
 5/14/70, SH

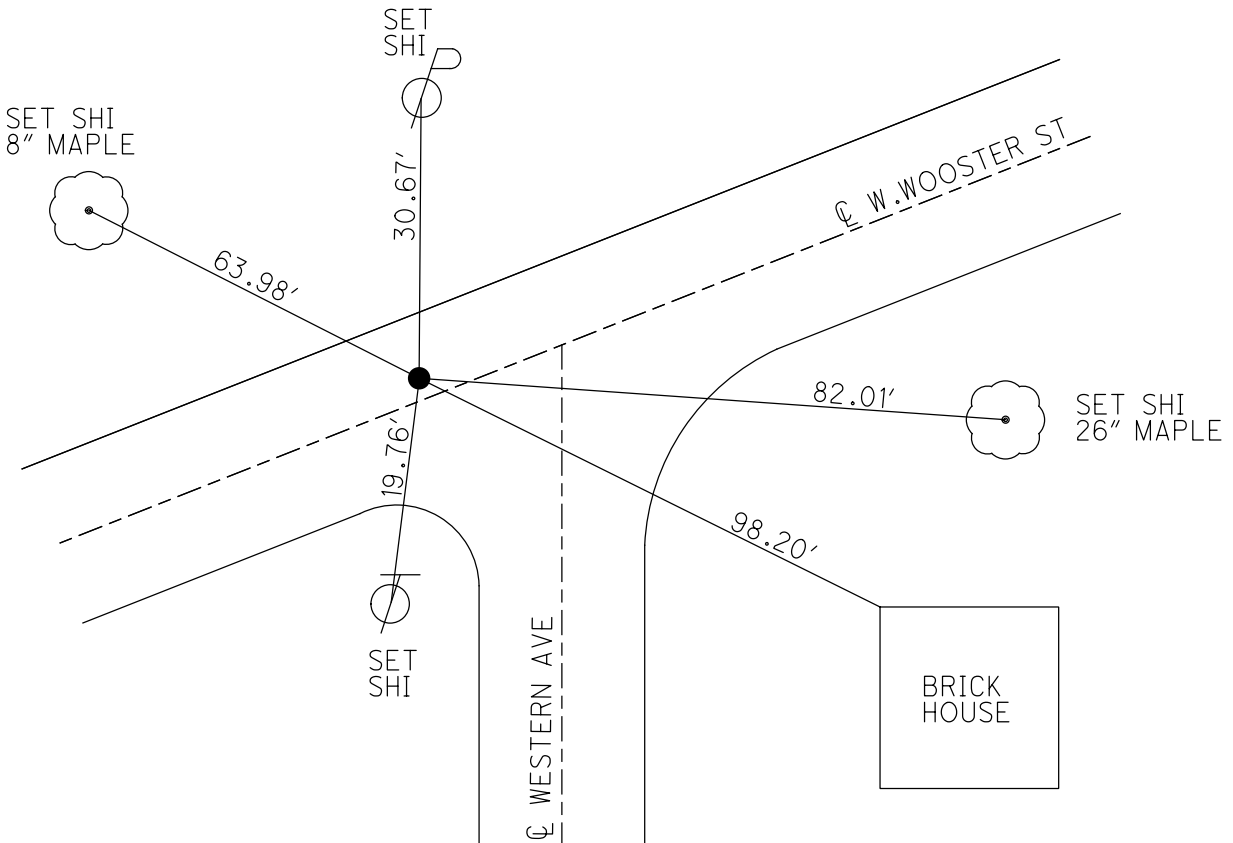

O.D.O.T. DISTRICT 2 SURVEY OFFICE (USE ONLY)

PERSONNEL _____

REFERENCE NO. L

SHEET 12 OF 17

NOTES BURNSIDE

DATE 5/14/70

ROUTE OLD US 6

H.C. SMITH

WEATHER _____

COUNTY WOOD

R.C. HOFFMAN

TEMP. _____

TOWNSHIP BOWLING GREEN

DWG BY RHOADES PID _____

SECTION 24

T 5 N R 10 E

TYPE MONUMENT P.K.NAIL

ON SURFACE - ~~BELOW~~ ON

OFFSET $\text{\textcircled{C}}$ PAVEMENT ON LT : RT

 - TO - EDGE PAVEMENT


STATION: 601+48

HORZ.DATUM: _____


GEOID: _____

GRID: NORTHING: _____

EASTING: _____

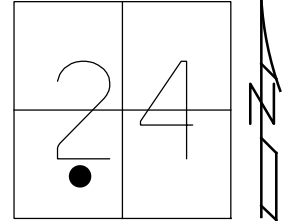

RECORD:
 STA. 601+48
 FD P.K.NAIL
 5/14/70, SH

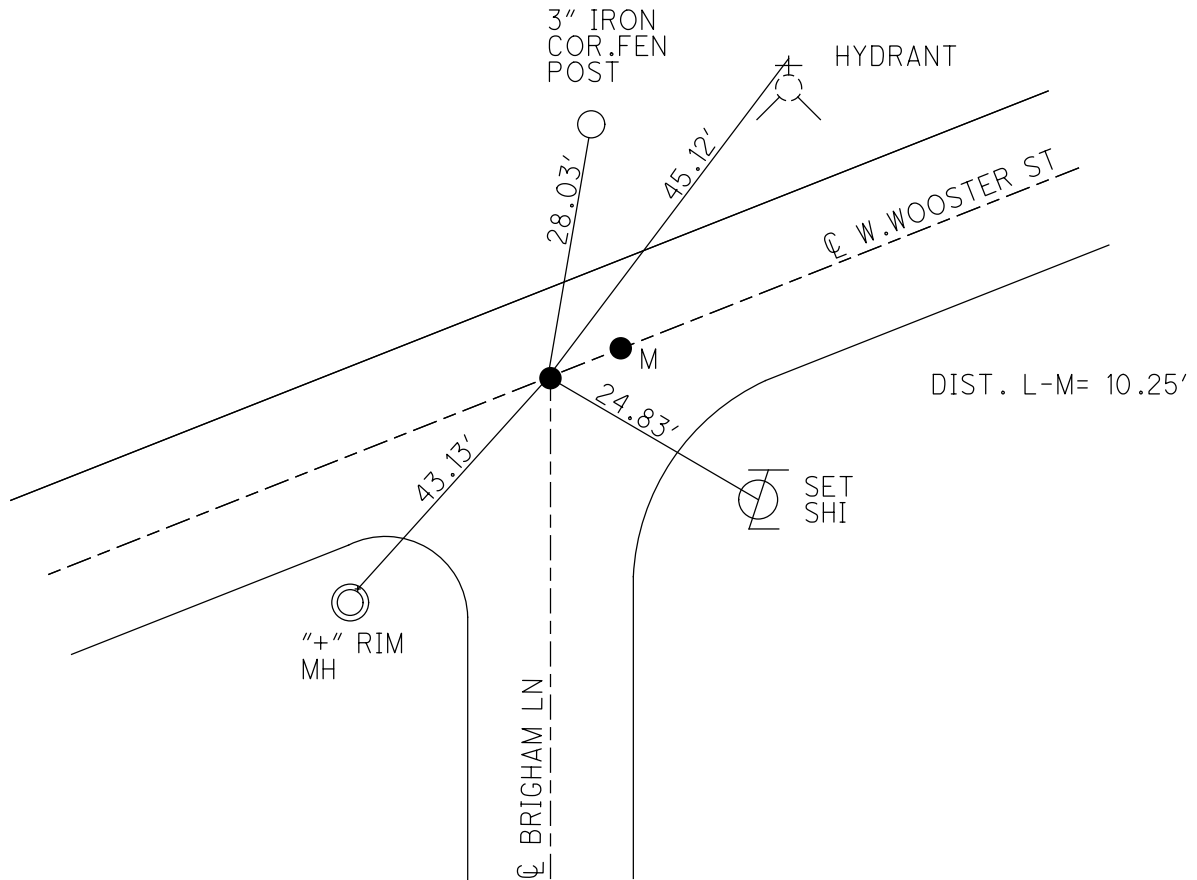

O.D.O.T. DISTRICT 2 SURVEY OFFICE (USE ONLY)

PERSONNEL _____ REFERENCE NO. M SHEET 13 OF 17

NOTES BURNSIDE DATE 5/14/70 ROUTE OLD US 6

H.C. SMITH WEATHER _____ COUNTY WOOD

R.C. HOFFMAN TEMP. _____ TOWNSHIP BOWLING GREEN

DWG BY RHOADES PID _____ SECTION 24

T 5 N R 10 E

TYPE MONUMENT P.K.NAIL

ON SURFACE - ~~BELOW~~ ON


OFFSET \varnothing PAVEMENT ON LT : RT

 - TO - EDGE PAVEMENT


STATION: 601+58.25

HORZ.DATUM: _____ GEOID: _____

GRID: NORTHING: _____ EASTING: _____

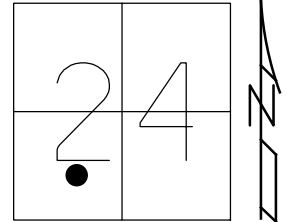

RECORD:
 STA.601+58.25
 STONE
 MON. SET
 FD P.K.NAIL
 6/22/70, SH

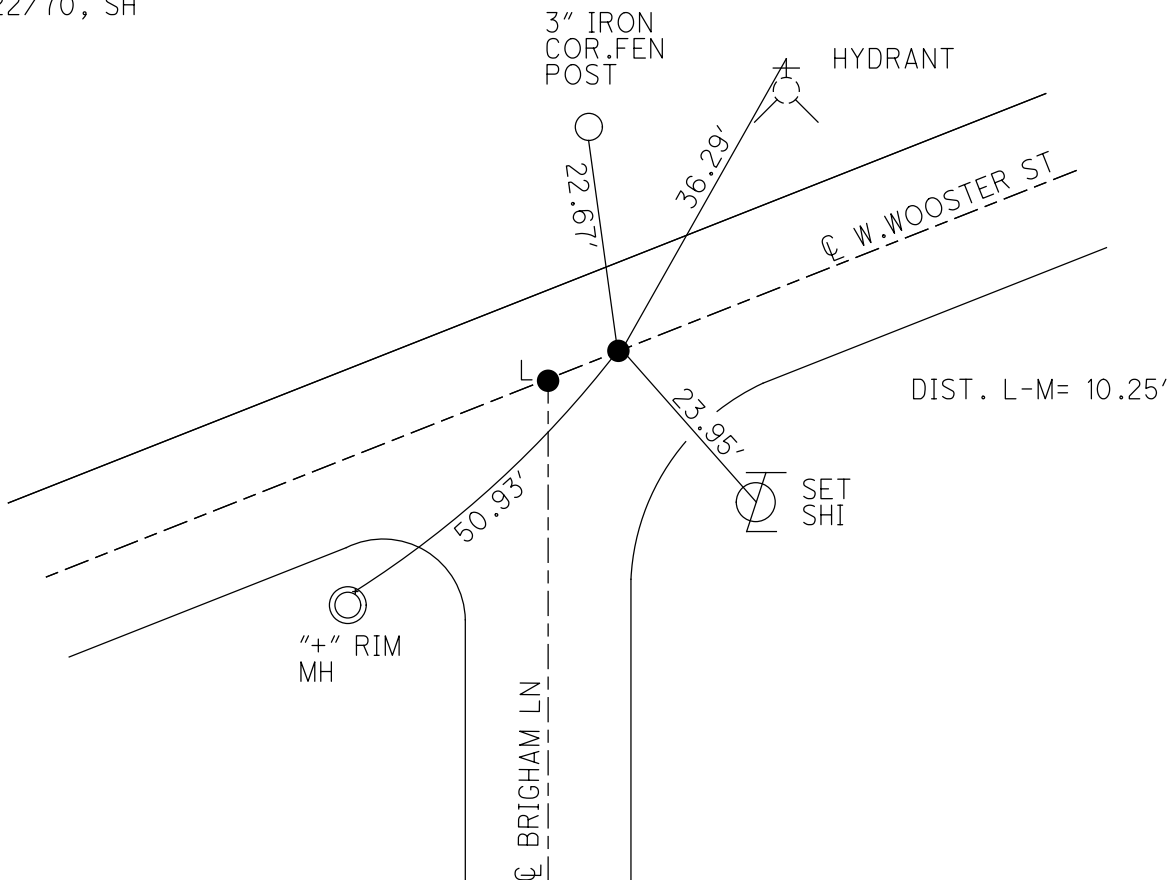

O.D.O.T. DISTRICT 2 SURVEY OFFICE (USE ONLY)

PERSONNEL

REFERENCE NO. N

SHEET 14 OF 17

NOTES BURNSIDE

DATE 6/22/70

ROUTE OLD US 6

H.C. BURNSIDE

WEATHER _____

COUNTY WOOD

R.C. HOFFMAN

TEMP. _____

TOWNSHIP BOWLING GREEN

DWG BY RHOADES PID _____

SECTION 24

T 5 N R 10 E

TYPE MONUMENT P.K.NAIL


ON SURFACE - ~~BELOW~~ ON

OFFSET ☉ PAVEMENT ON _____ LT : RT
- TO - EDGE PAVEMENT


STATION: 605+06.70

HORIZ.DATUM: _____ GEOID: _____

GRID: NORTHING: _____ EASTING: _____

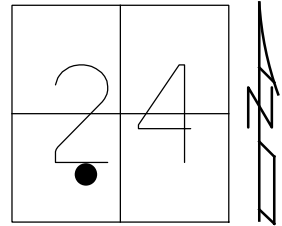

RECORD:
 $\Delta = 5^\circ 46' \text{ LT}$
 STA. 605+06.70
 FD P.K.NAIL
 6/22/70, SH

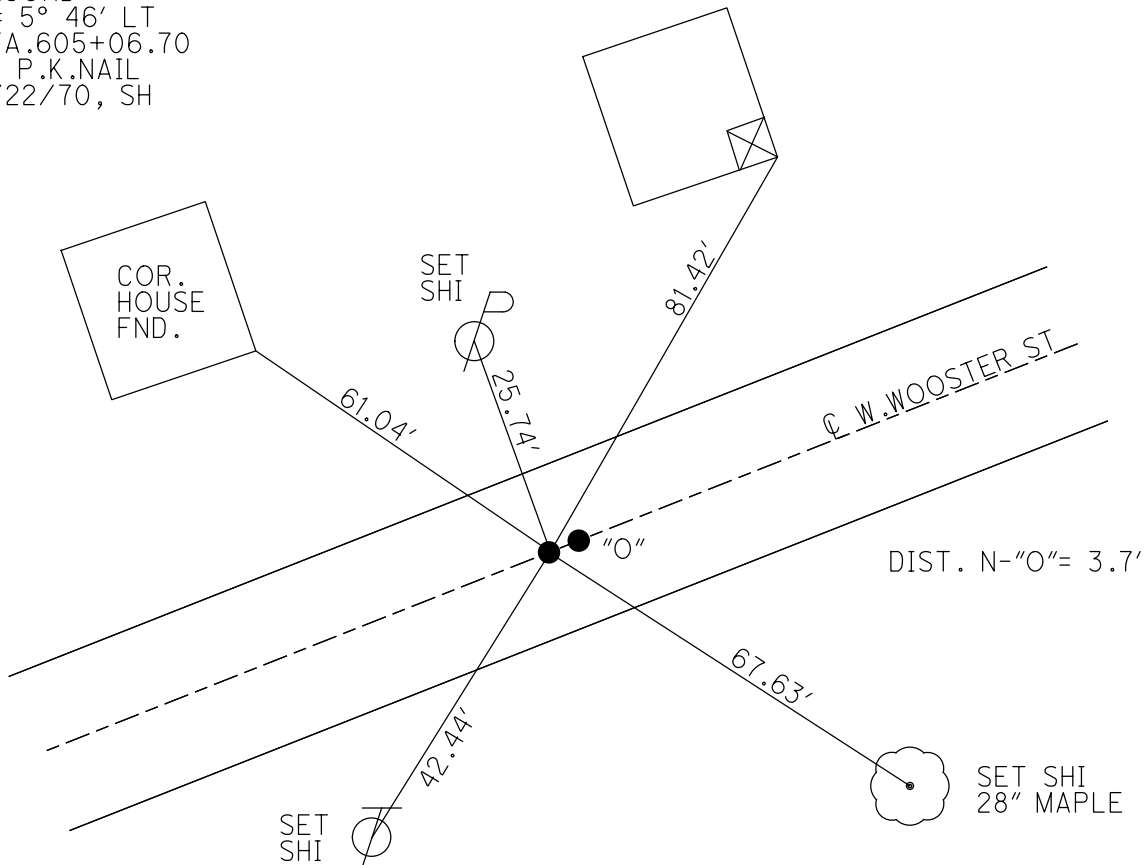

O.D.O.T. DISTRICT 2 SURVEY OFFICE (USE ONLY)

PERSONNEL _____

REFERENCE NO. "0" _____

SHEET 15 OF 17

NOTES BURNSIDE

DATE 6/22/70

ROUTE OLD US 6

H.C. BURNSIDE

WEATHER _____

COUNTY WOOD

R.C. HOFFMAN

TEMP. _____

TOWNSHIP BOWLING GREEN

SECTION 24

DWG BY RHOADES

PID _____

T 5 N R 10 E

TYPE MONUMENT P.K.NAIL

ON SURFACE - ~~BELOW~~ ON _____

OFFSET Q PAVEMENT ON _____ LT : RT

- TO - EDGE PAVEMENT


STATION: 605+10.4

HORZ.DATUM: _____


GEOID: _____

GRID: NORTHING: _____

EASTING: _____

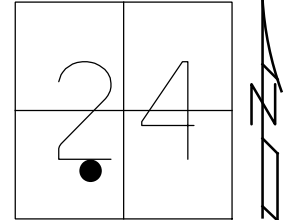

RECORD:
STA. 605+10.4
MON SET
FD P.K.NAIL
6/22/70, SH

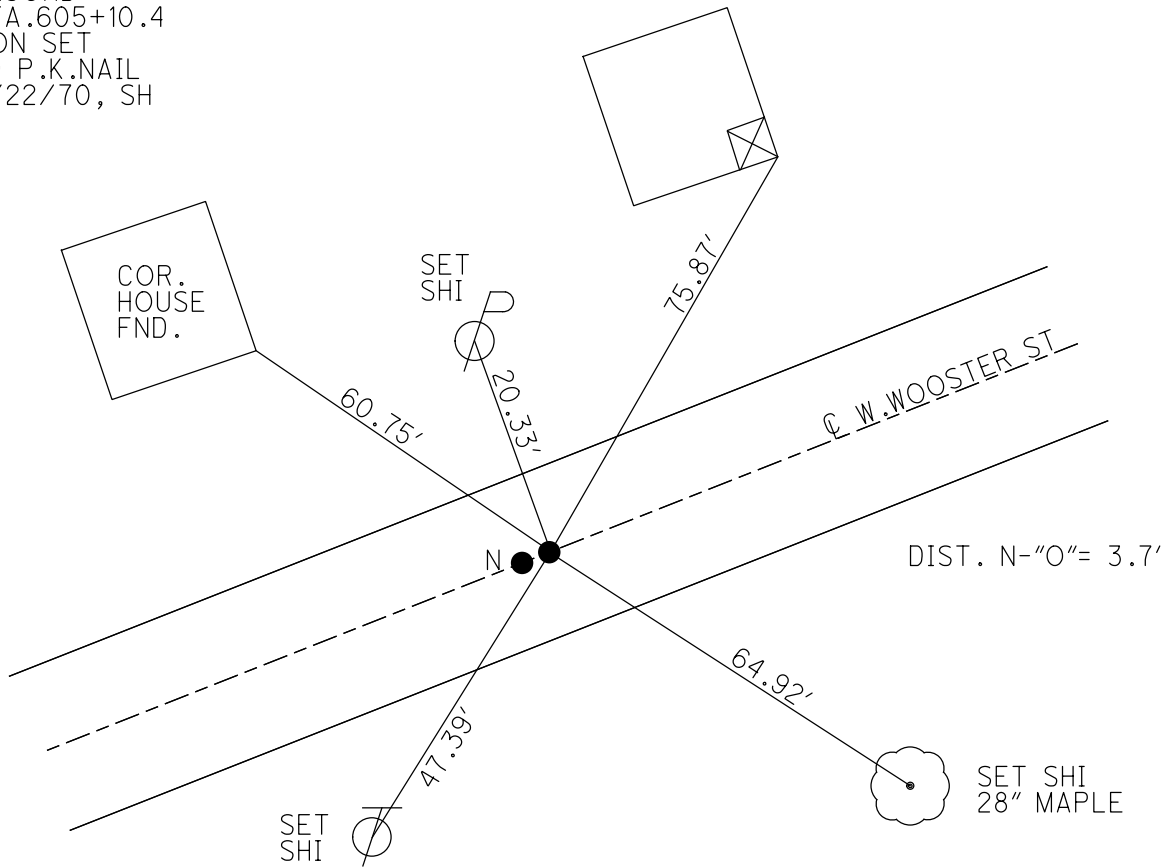

O.D.O.T. DISTRICT 2 SURVEY OFFICE (USE ONLY)

PERSONNEL _____

REFERENCE NO. P

SHEET 16 OF 17

NOTES BURNSIDE

DATE 6/22/70

ROUTE OLD US 6

H.C. BURNSIDE

WEATHER _____

COUNTY WOOD

R.C. HOFFMAN

TEMP. _____

TOWNSHIP BOWLING GREEN

SECTION 24

DWG BY RHOADES

PID _____

T 5 N R 10 E

TYPE MONUMENT P.K.NAIL

ON SURFACE - ~~BELOW~~ ON _____

OFFSET ☉ PAVEMENT ON _____ LT : RT

- TO - EDGE PAVEMENT


STATION: 610+78.47

HORIZ.DATUM: _____


GEOID: _____

GRID: NORTHING: _____

EASTING: _____

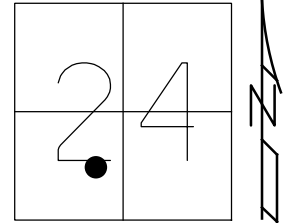

RECORD:
STA. 610+78.47
MON SET
FD P.K.NAIL
6/22/70, SH

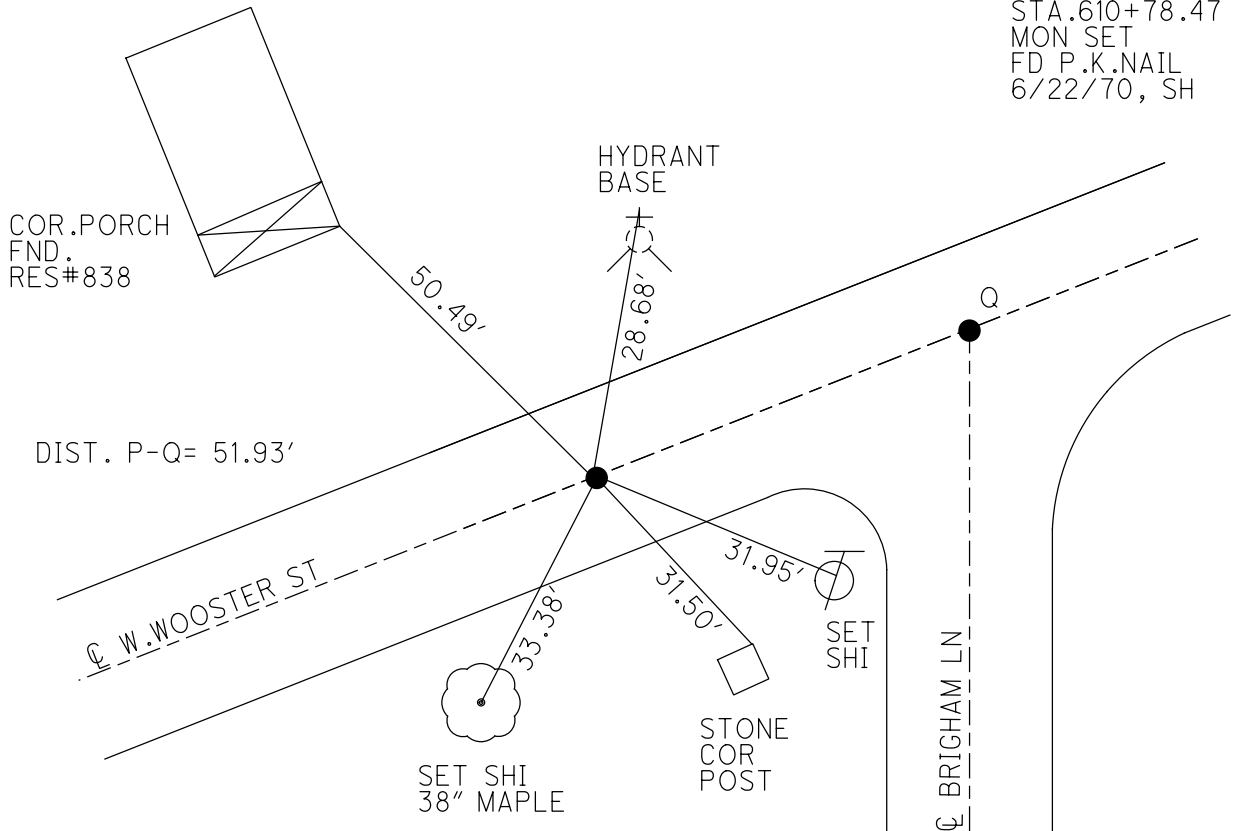

O.D.O.T. DISTRICT 2 SURVEY OFFICE (USE ONLY)

PERSONNEL

REFERENCE NO. Q

SHEET 17 OF 17

NOTES BURNSIDE
 H.C. BURNSIDE
 R.C. HOFFMAN

DATE 6/22/70
 WEATHER _____
 TEMP. _____

ROUTE OLD US 6
 COUNTY WOOD
 TOWNSHIP BOWLING GREEN
 SECTION 24
 T 5 N R 10 E

DWG BY RHOADES PID _____

TYPE MONUMENT P.K.NAIL


ON SURFACE - ~~BELOW~~ ON

OFFSET \odot PAVEMENT ON LT : RT
 - TO - EDGE PAVEMENT

STATION: 611+30.40

HORZ.DATUM: _____ GEOID: _____

GRID: NORTHING: _____ EASTING: _____

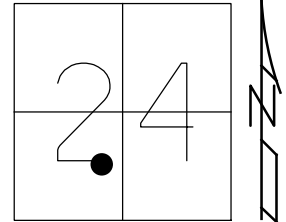

RECORD:
 STA. 611+30.40
 MON SET
 FD P.K.NAIL
 6/22/70, SH

