

O.D.O.T. DISTRICT 2 SURVEY OFFICE (USE ONLY)

PERSONNEL

REFERENCE NO. D

SHEET 4 OF 17

NOTES BURNSIDE

DATE 11/3/70

ROUTE OLD US 6

H.C. SMITH

WEATHER

COUNTY WOOD

R.C. HOLCOMBE

TEMP.

TOWNSHIP PLAIN

BOWERS

SECTION 26

DWG BY RHOADES PID

T 5 N R 10 E

TYPE MONUMENT P.K.NAIL

ON SURFACE - ~~BELOW~~ ON

OFFSET Q PAVEMENT ON LT : RT

- TO - EDGE PAVEMENT


STATION: 560+06.78

HORIZ.DATUM:

GEOID:

GRID: NORTHING:

EASTING:

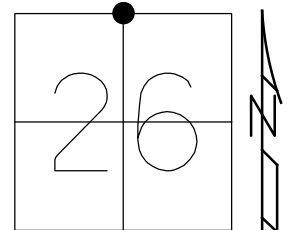

RECORD:

$\Delta = 0^\circ 50' \text{ LT}$

STA. 560+13.75

SET R.R.SPIKE

1960

FD BRASS MON.


2/21/68

$\Delta = 0^\circ 51' \text{ LT}$

11/3/70

SET P.K.NAIL

11/3/70, SH

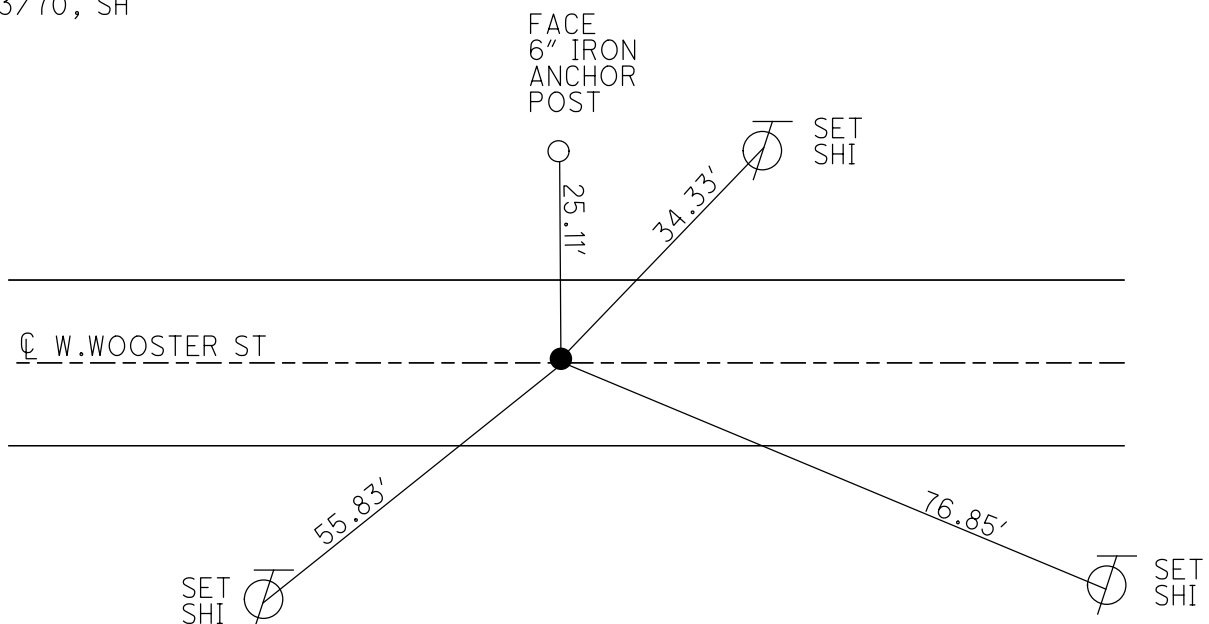

PERSONNEL	TITLE	PERSONNEL	TITLE
BURNSIDE			
SMITH			
HOLCOMBE			
BOWERS			

COUNTY WOOD DATE 11-3-70
 OLD U.S. #6
 S. R. NEW BOWLING GREEN R. WEATHER _____
 SEC. _____ TEMP. _____

DESCRIPTION CONTROL TIES JOB NO. _____


LEFT

CENTER LINE

RIGHT

E

STA. 569+73.93
 966.75' E. OF N¹/₄
 Post SEC. 26
 PLAIN TWP.
 T-5-N R-10-E
 MON SET
 SET P.K.

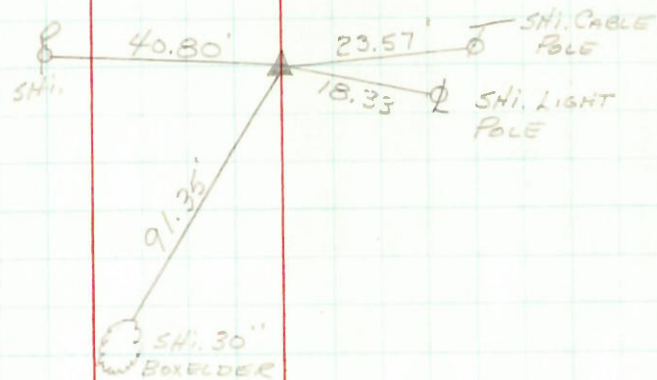

D

STA. 560+06.78
 N¹/₄ Post SEC. 26
 PLAIN TWP.
 T-5-N R-10-E
 Δ = 1° 51' LT. FWD.
 BRASS MON
 SET. P.K.

