

O.D.O.T. DISTRICT 2 SURVEY OFFICE (USE ONLY)

PERSONNEL

REFERENCE NO. F

SHEET 6 OF 17

NOTES BURNSIDE

DATE 11/3/70

ROUTE OLD US 6

H.C. SMITH

WEATHER

COUNTY WOOD

R.C. HOFFMAN

TEMP.

TOWNSHIP PLAIN

DWG BY RHOADES

PID

SECTION 23

T 5 N R 10 E

TYPE MONUMENT CMON

ON SURFACE - ~~BELOW~~ ON

OFFSET Q PAVEMENT ON LT : RT

- TO - EDGE PAVEMENT


STATION: 573+97.07

HORZ.DATUM:


GEOID:

GRID: NORTHING:

EASTING:

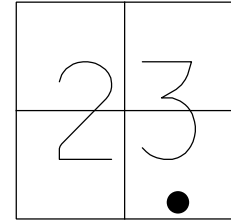

RECORD:
STA.573+97.07
FD CMON
11/3/70, SH

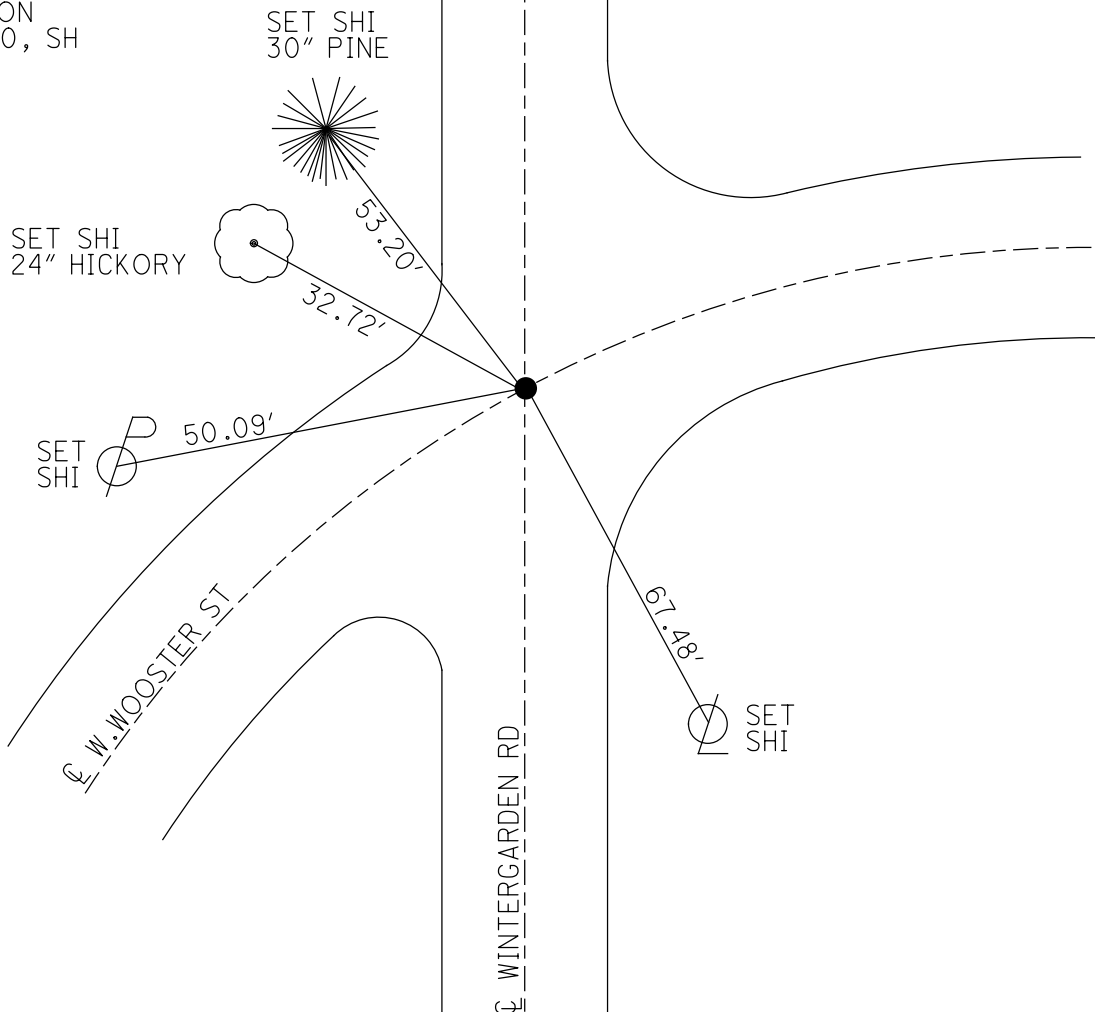

PERSONNEL TITLE PERSONNEL TITLE

COUNTY WoodDATE 11-3-70BURNSIDESMITHHOFFMANS. R. BOWLING GREEN RD. WEATHER

SEC. TEMP.

DESCRIPTION CON-ROL TIES

JOB NO.



LEFT

CENTER LINE

RIGHT

G

STA. 581+03
 P.I. $\Delta = 12^\circ 15' LT$
 SET. P.K.

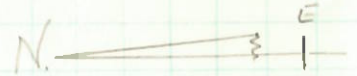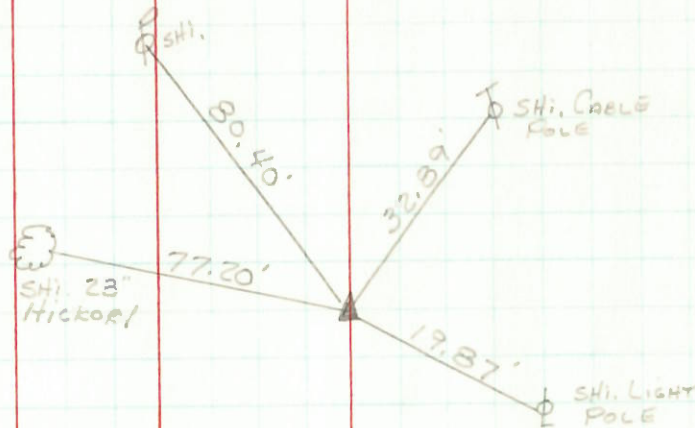

F

STA. 573+97.07
 BOWLING GREEN RD.
 WINTERGARDEN RD.
 CONC. MONUMENT

