

O.D.O.T. DISTRICT 2 SURVEY OFFICE (USE ONLY)

PERSONNEL

REFERENCE NO. M

SHEET 13 OF 17

NOTES BURNSIDE

DATE 5/14/70

ROUTE OLD US 6

H.C. SMITH

WEATHER

COUNTY WOOD

R.C. HOFFMAN

TEMP.

TOWNSHIP BOWLING GREEN

SECTION 24

DWG BY RHOADES

PID

T 5 N R 10 E

TYPE MONUMENT P.K.NAIL

ON SURFACE - ~~BELOW~~ ON

OFFSET Q PAVEMENT ON LT : RT

 - TO - EDGE PAVEMENT


STATION: 601+58.25

HORIZ.DATUM:


GEOID:

GRID: NORTHING:

EASTING:

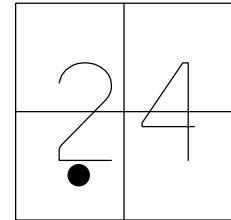

RECORD:
STA. 601+58.25
STONE
MON. SET
FD P.K.NAIL
6/22/70, SH

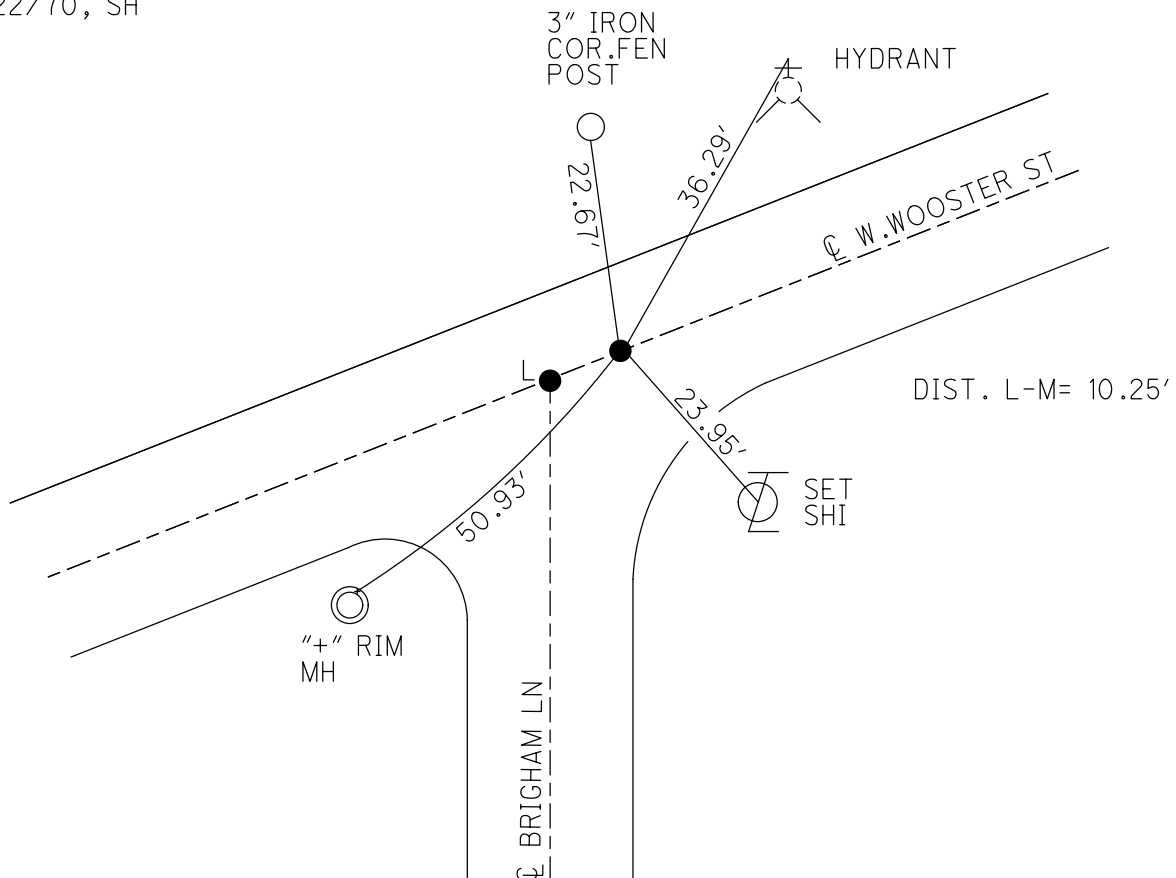

PERSONNEL TITLE PERSONNEL TITLE

BURNSIDE
HOFFMANCOUNTY WOODDATE OK 6-22-70S. R. OLD U.S. #6WEATHER CLEARSEC. BOWLING GREENTEMP. +73°

DESCRIPTION

CONTROL POINTS

LEFT


CENTER LINE

RIGHT


JOB NO.

STA. 605+10.4
Mort. SET. - FD. P.K.

#792

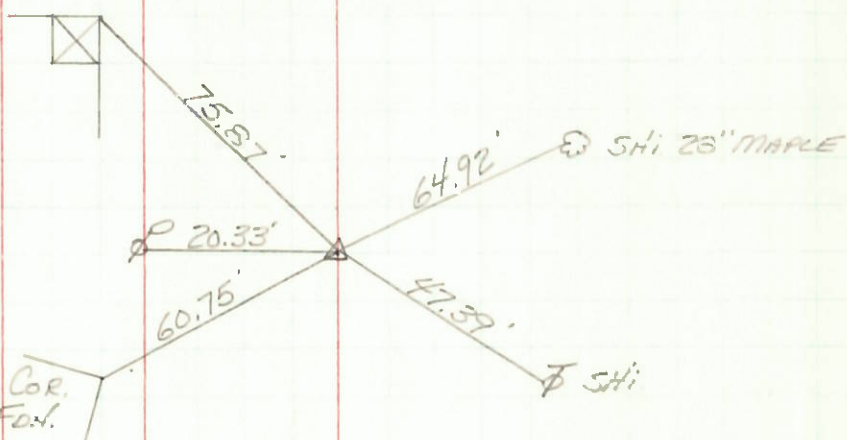S.E. COR.
Ho. FDN.STA. 605+06.70
P.I. $\Delta = 5^\circ 46' LT.$
FD. P.K.

#791

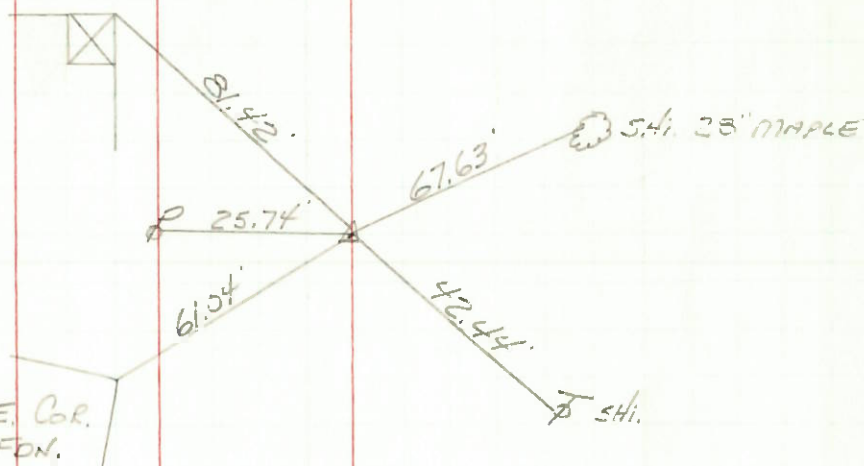S.E. COR.
Ho. FDN.STA. 601+58.25
COR. STONE MON. SET.
FD. P.K.

#790

BASE HYD.

IRON POST
NORTH